


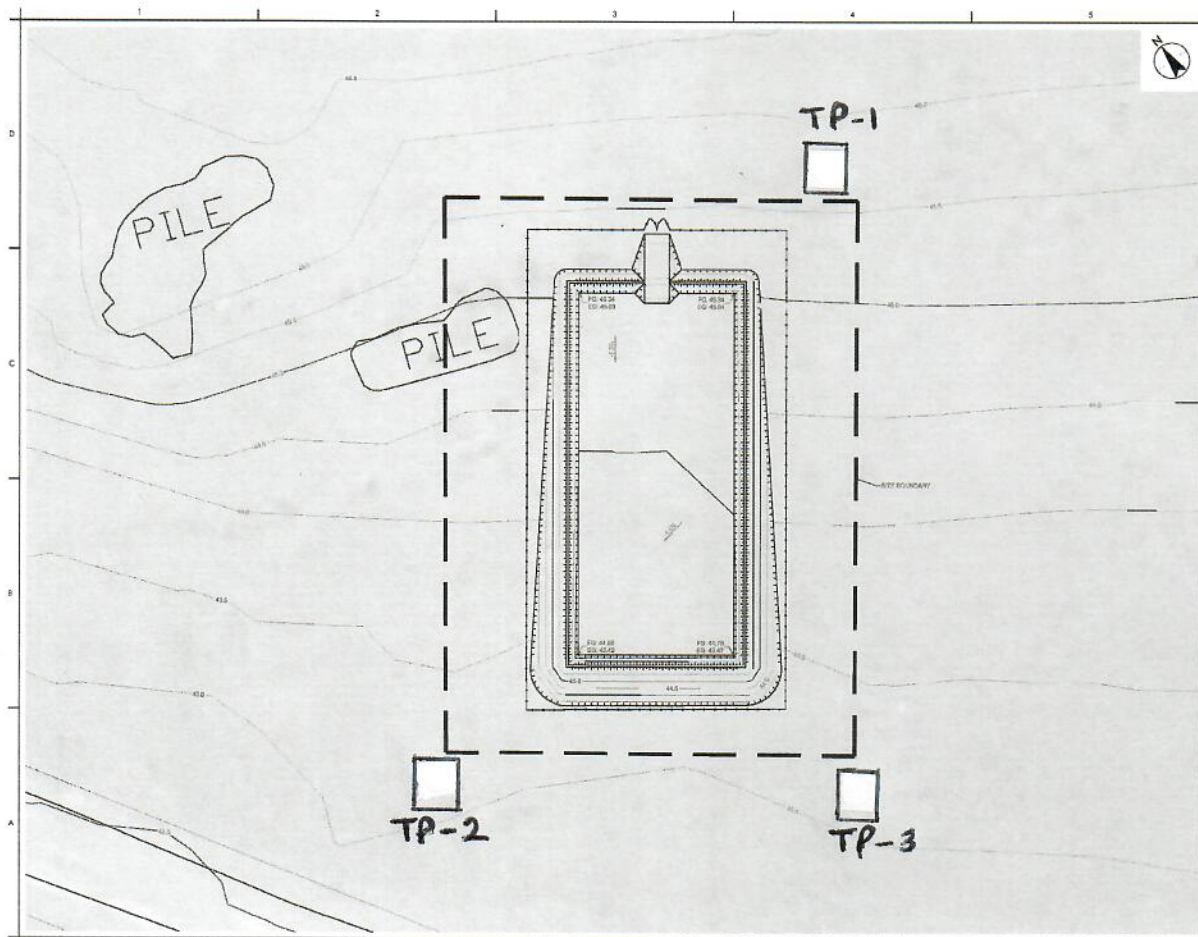

www.stantec.com

Copyright Reserved

The Contractor shall verify and be responsible for all dimensions, lot lines, and the

Notes


Permit/Plan



Client/Project Logo



GULLIO ENERGY CORPORATION

BAKER LAKE LANDFARM

BAKER LAKE, NU

Site
CIVIL
GRADING PLAN

Project No. 14472012
Scale 1:100
Revision 8/0
Sheet 2 of 4
Drawing No. C-101