




	CONTENTS		AUG. 13, 2013 WEATHER: 10°C, OVERCAS
PAGE	REFERENCE	DATE	MODERNIEUM WINDY
			THERMISTORS
			PIC
	7.3		3 -7 COGGER WILL CUT-H LABEL
			3 - PCABLE (UT-4 LABEL
			10-21/1-2
			A-2/000 RD
	8		5 -7 CABCE
,			5 -7 CABLE  7 -7 VT - 3  8 -7 LOCGER
	77		7-7vt-3
	N.S. C.		
			9 -> CABLIZ
			11 - LOGGER
7			12-PCABLE (VT-1 LABEL?)
1			
			"Attain

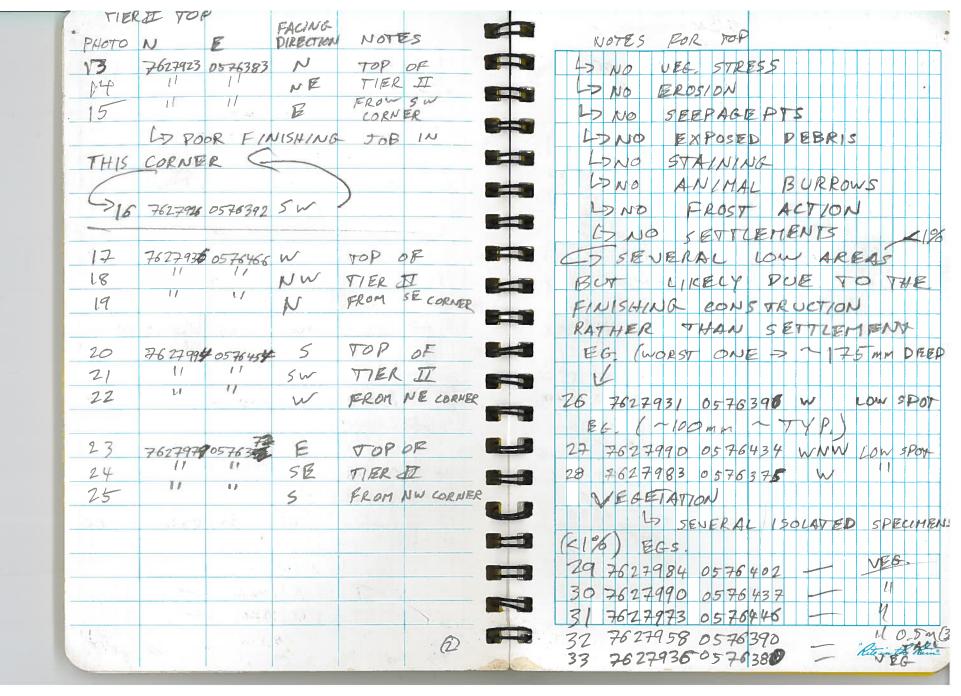


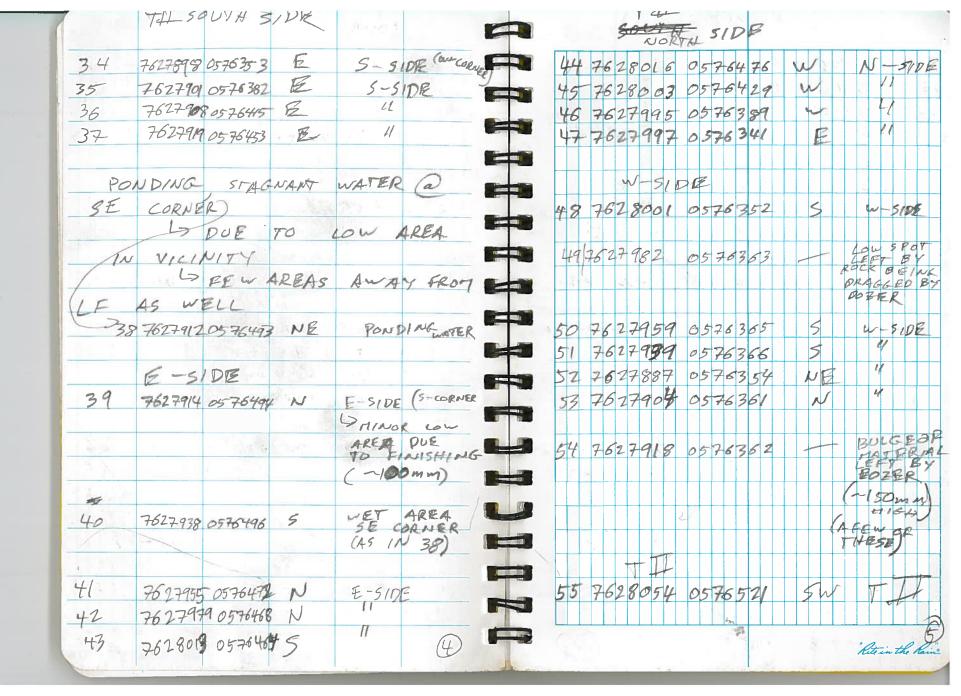


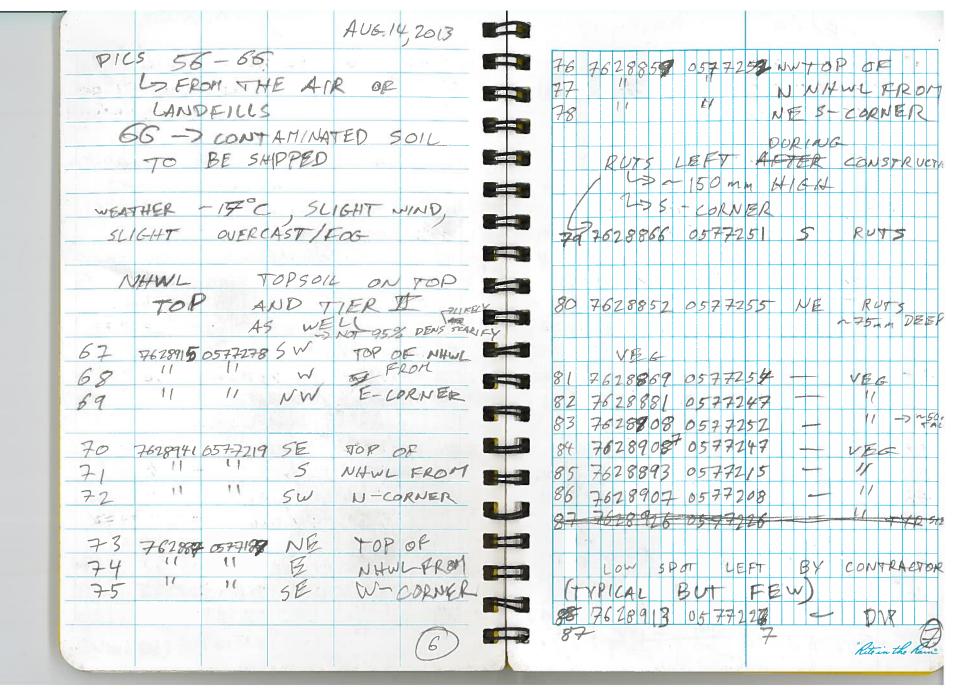


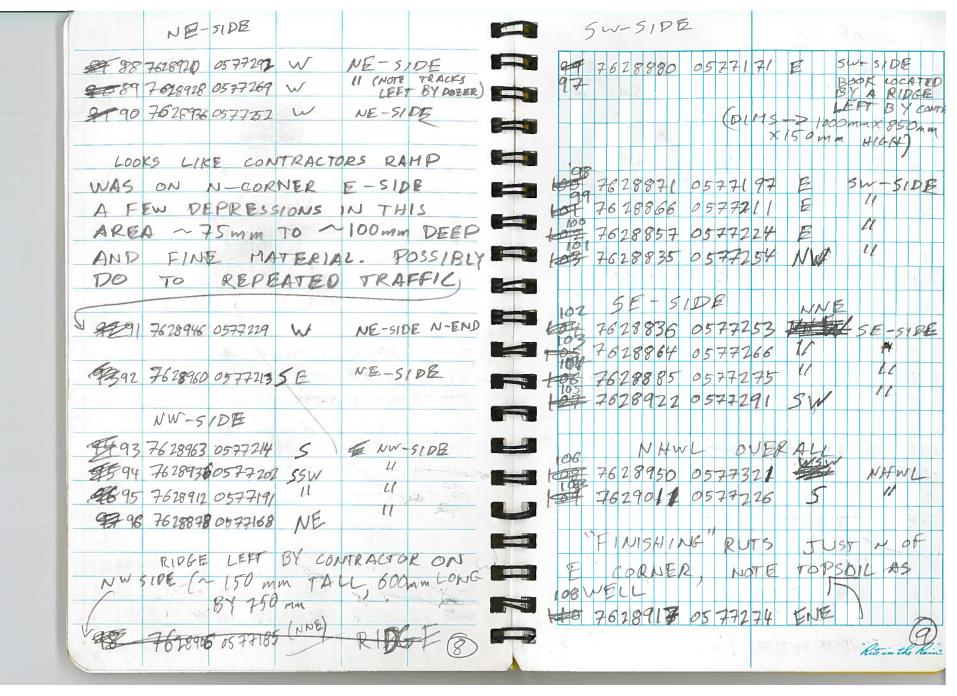

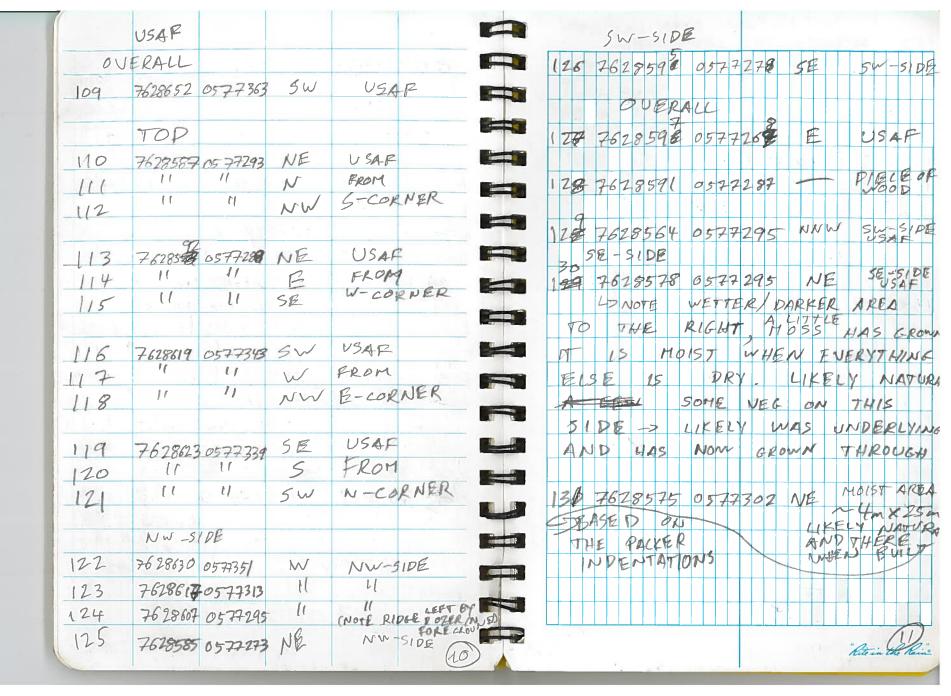

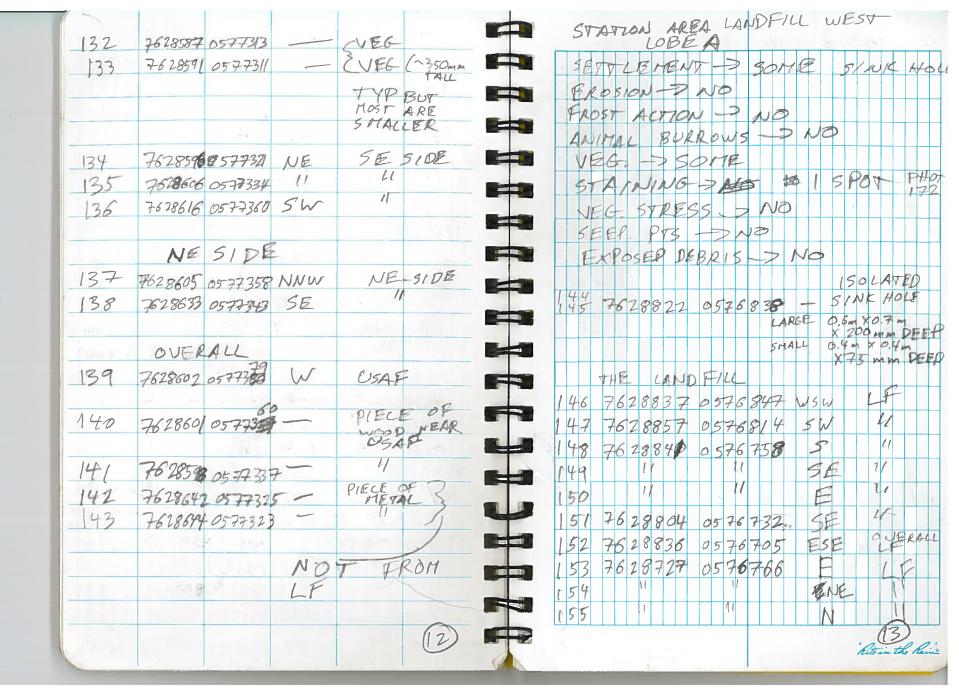

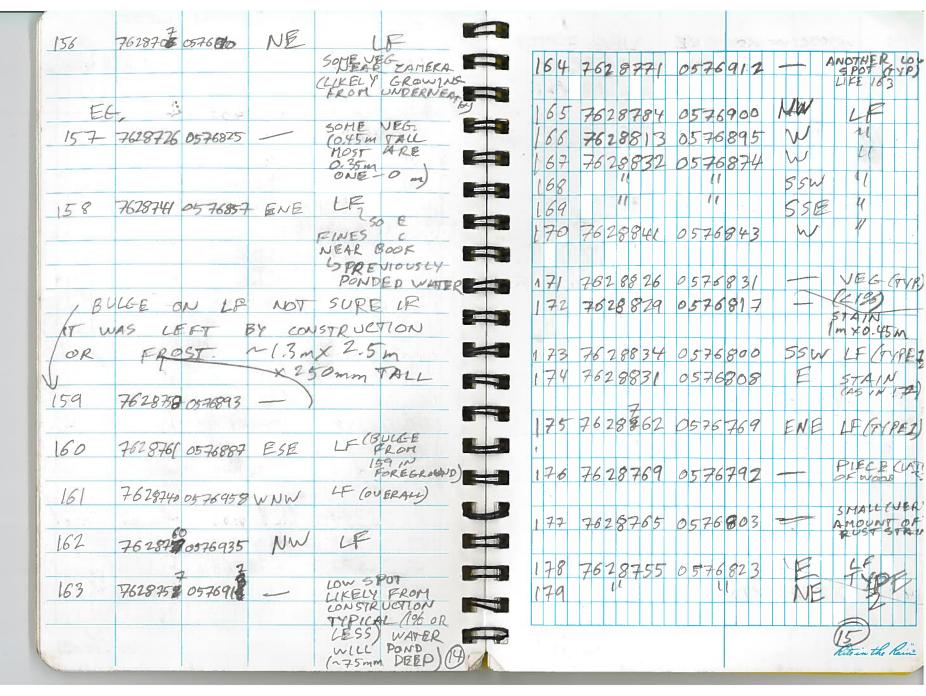

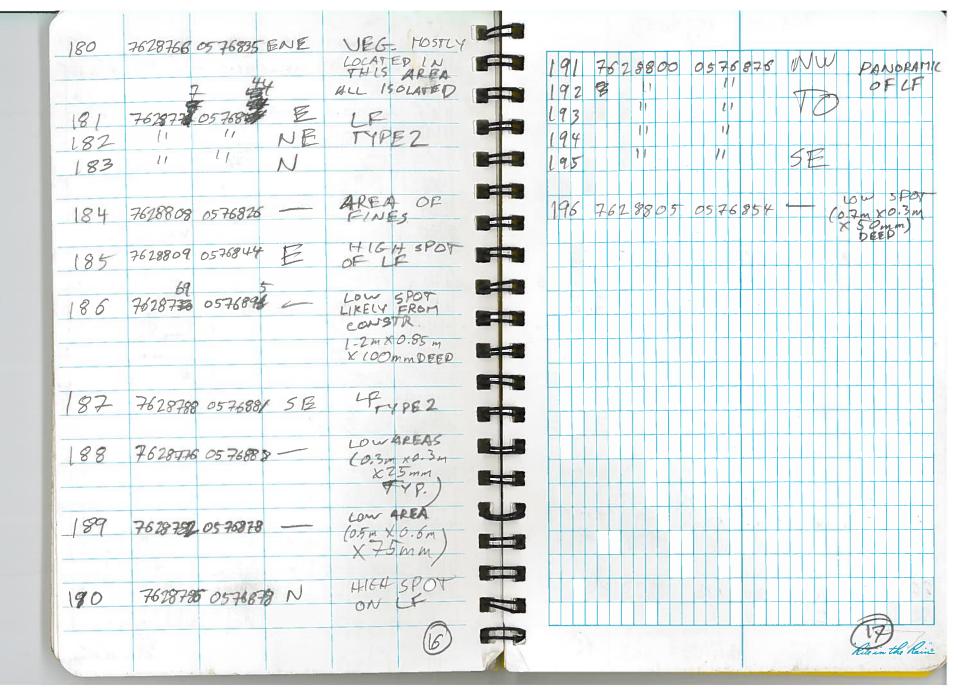

AUG 15,2013 197-199 > FROM P165 SPOT THE ALR MORE NORTH PORTION EUI DENCE SITE UARIATION OF GOVETRUCTION THAT HAS WEATHER: OVERCAST, WINDY ~700 END ON THE AIRSTRIP CAND FILL LOBE 10w B VEG- - ESPECIALLY EDGES URRENTI ON LO LIBELY GROWING #ROSLON N-SIDE 40W SPOT - POSS, SINK 204 7677938 0576910 58 NEG STRESS NO TIN CAN 7627938 0576911 FROST ACTION 705 SEEP. OF LF 206 7627908 0576965 WAW EXP. DEBRIS NO STAINING NO E-SIUE ANIMAL BURROWS 20 7 7 62 791 \$ 057696 DK COLOR SOUTH SIDE 7617887,0576984 NW MATERIAL 200 OFIL CF 7627882 0576943 762708 057690 201 900 OFLE DE 762789 0576950 202 76279050576905 NE 11 7627936 05 76915 3 mm with LOC DRAW MAP

