


Path: S:\AutoCad\acad-Prj\2005\50-714 DEW Cambridge\1B-Draft-Oct2005\ Plotted on: Oct 21, 2005-3:06pm Edited by: Public

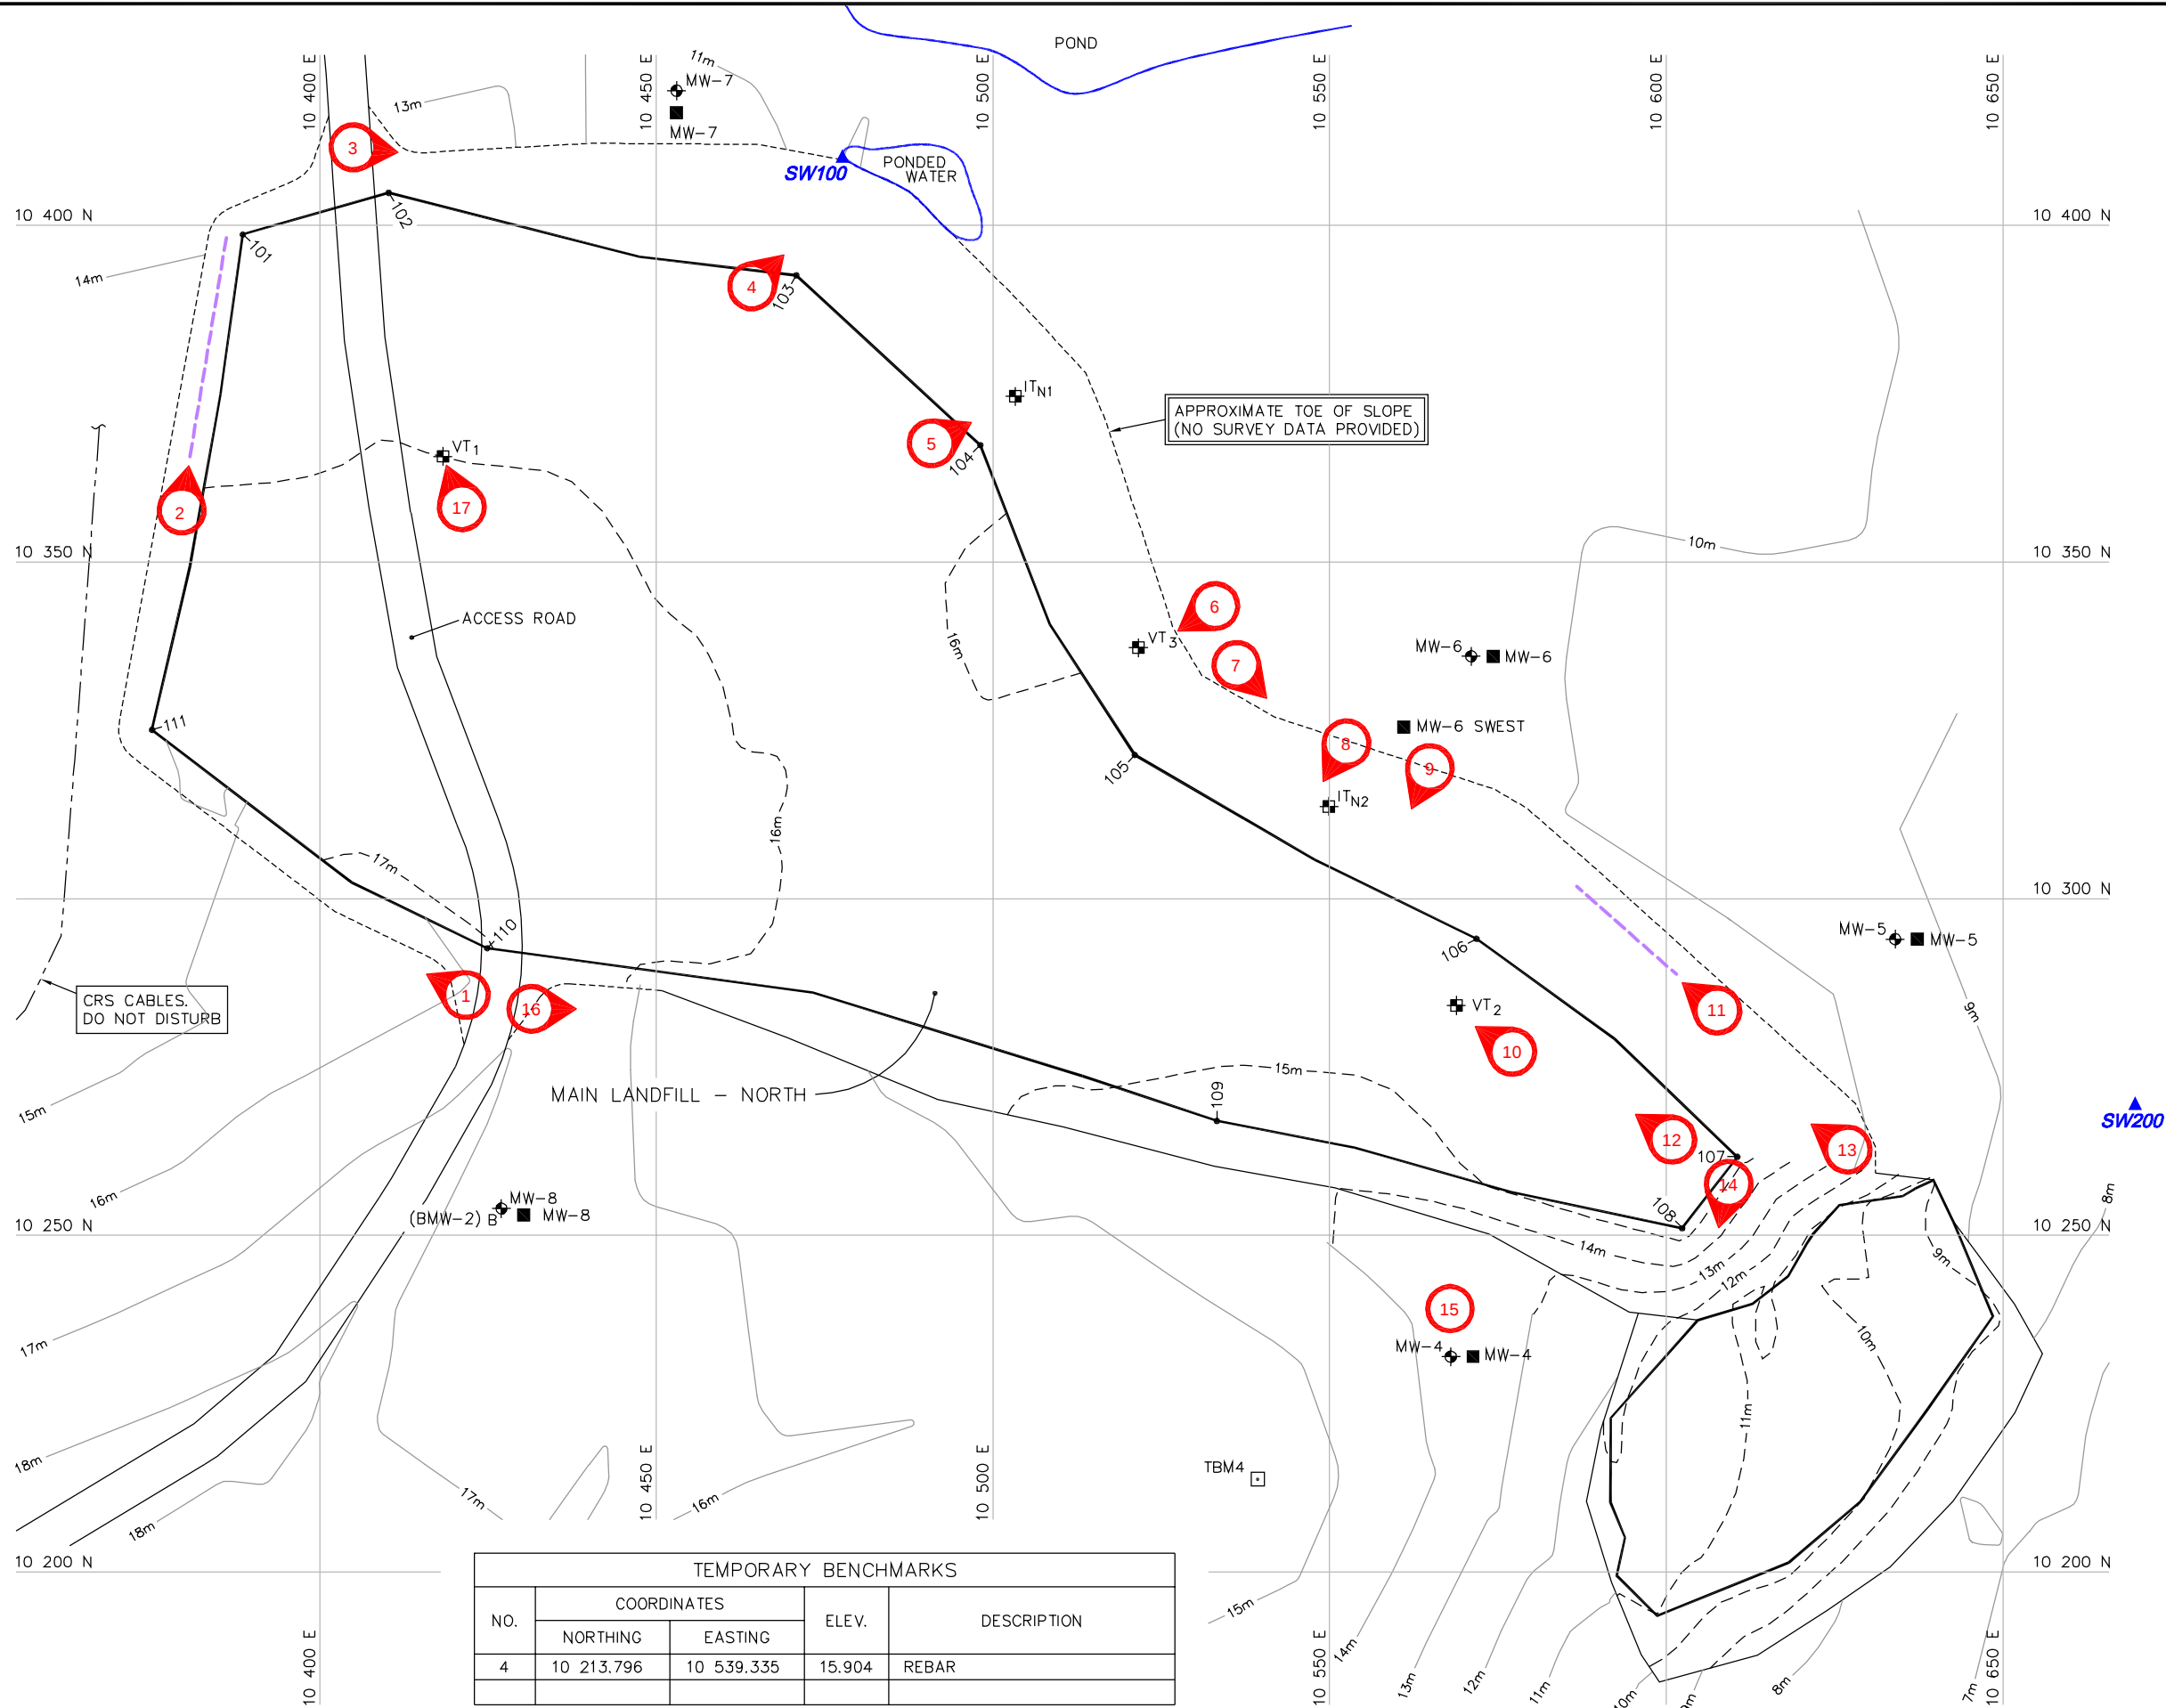

TEMPORARY BENCHMARKS				
NO.	COORDINATES		ELEV.	DESCRIPTION
	NORTHING	EASTING		
4	10 213.796	10 539.335	15.904	REBAR

LEGEND:


- TBM4 □ TEMPORARY BENCHMARK
- ⊕ MONITORING WELL LOCATION
- VT ⊕ VERTICAL THERMISTOR
- IT ⊕ INCLINED THERMISTOR
- 101-● COORDINATE POINT
- ▲ SW100 SURFACE WATER MONITOR LOCATION
- MONITORING SOIL SAMPLE LOCATION
- 3 2005 PHOTOGRAPH NUMBER AND LOCATION (3 = MLFN3)
- - - SURFACE CRACK

MONITORING WELLS			
NO.	COORDINATES		GROUND ELEV.
	NORTHING	EASTING	
MW-4	10 232	10 568	14.0
MW-5	10 294	10 634	8.9
MW-6	10 336	10 571	10.0
MW-7	10 420	10 453	10.9
MW-8	10 254	10 427	16.5

THERMISTORS			
NO.	COORDINATES		GROUND ELEV.
	NORTHING	EASTING	
ITN1	10 374.6	10 503.3	13.11
ITN2	10 313.7	10 549.9	12.23
VT1	10 365.7	10 418.3	15.68
VT2	10 284.2	10 568.8	15.27
VT3	10 337.2	10 521.6	13.73

COORDINATE POINTS			
NO.	COORDINATES		ELEV.
	NORTHING	EASTING	
101	10 398.7	10 388.6	15.4
102	10 404.9	10 410.3	15.0
103	10 392.6	10 470.8	15.6
104	10 367.4	10 498.1	15.9
105	10 321.4	10 521.1	15.6
106	10 294.1	10 571.8	15.2
107	10 261.7	10 610.6	15.4
108	10 251.1	10 602.4	15.5
109	10 267.0	10 533.3	14.8
110	10 292.7	10 424.9	17.0
111	10 325.1	10 375.1	16.6

DATA SOURCES:
DRAWING BY UMA
CM-RD02.DWG
DATED: APRIL, 2002
DEW LINE CLEAN UP LANDFILL MONITORING
PLAN CAM-M - CAMBRIDGE BAY MAIN
LANDFILL NORTH FIGURE CAM-M.2

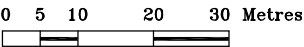

SCALE 1:1000

REVIEWED BY : DL/AK
PREPARED BY : PW/NT0
DATE ISSUED : OCTOBER, 2005
PROJECT NO. : 50-714
FILE NAME : 50714-1B-01.dwg
REVISION : 0

Project: DEW Line Monitoring
Location: Cambridge Bay, Nunavut
Client: Defence Construction Canada

MAIN LANDFILL NORTH



Figure No. A-1