


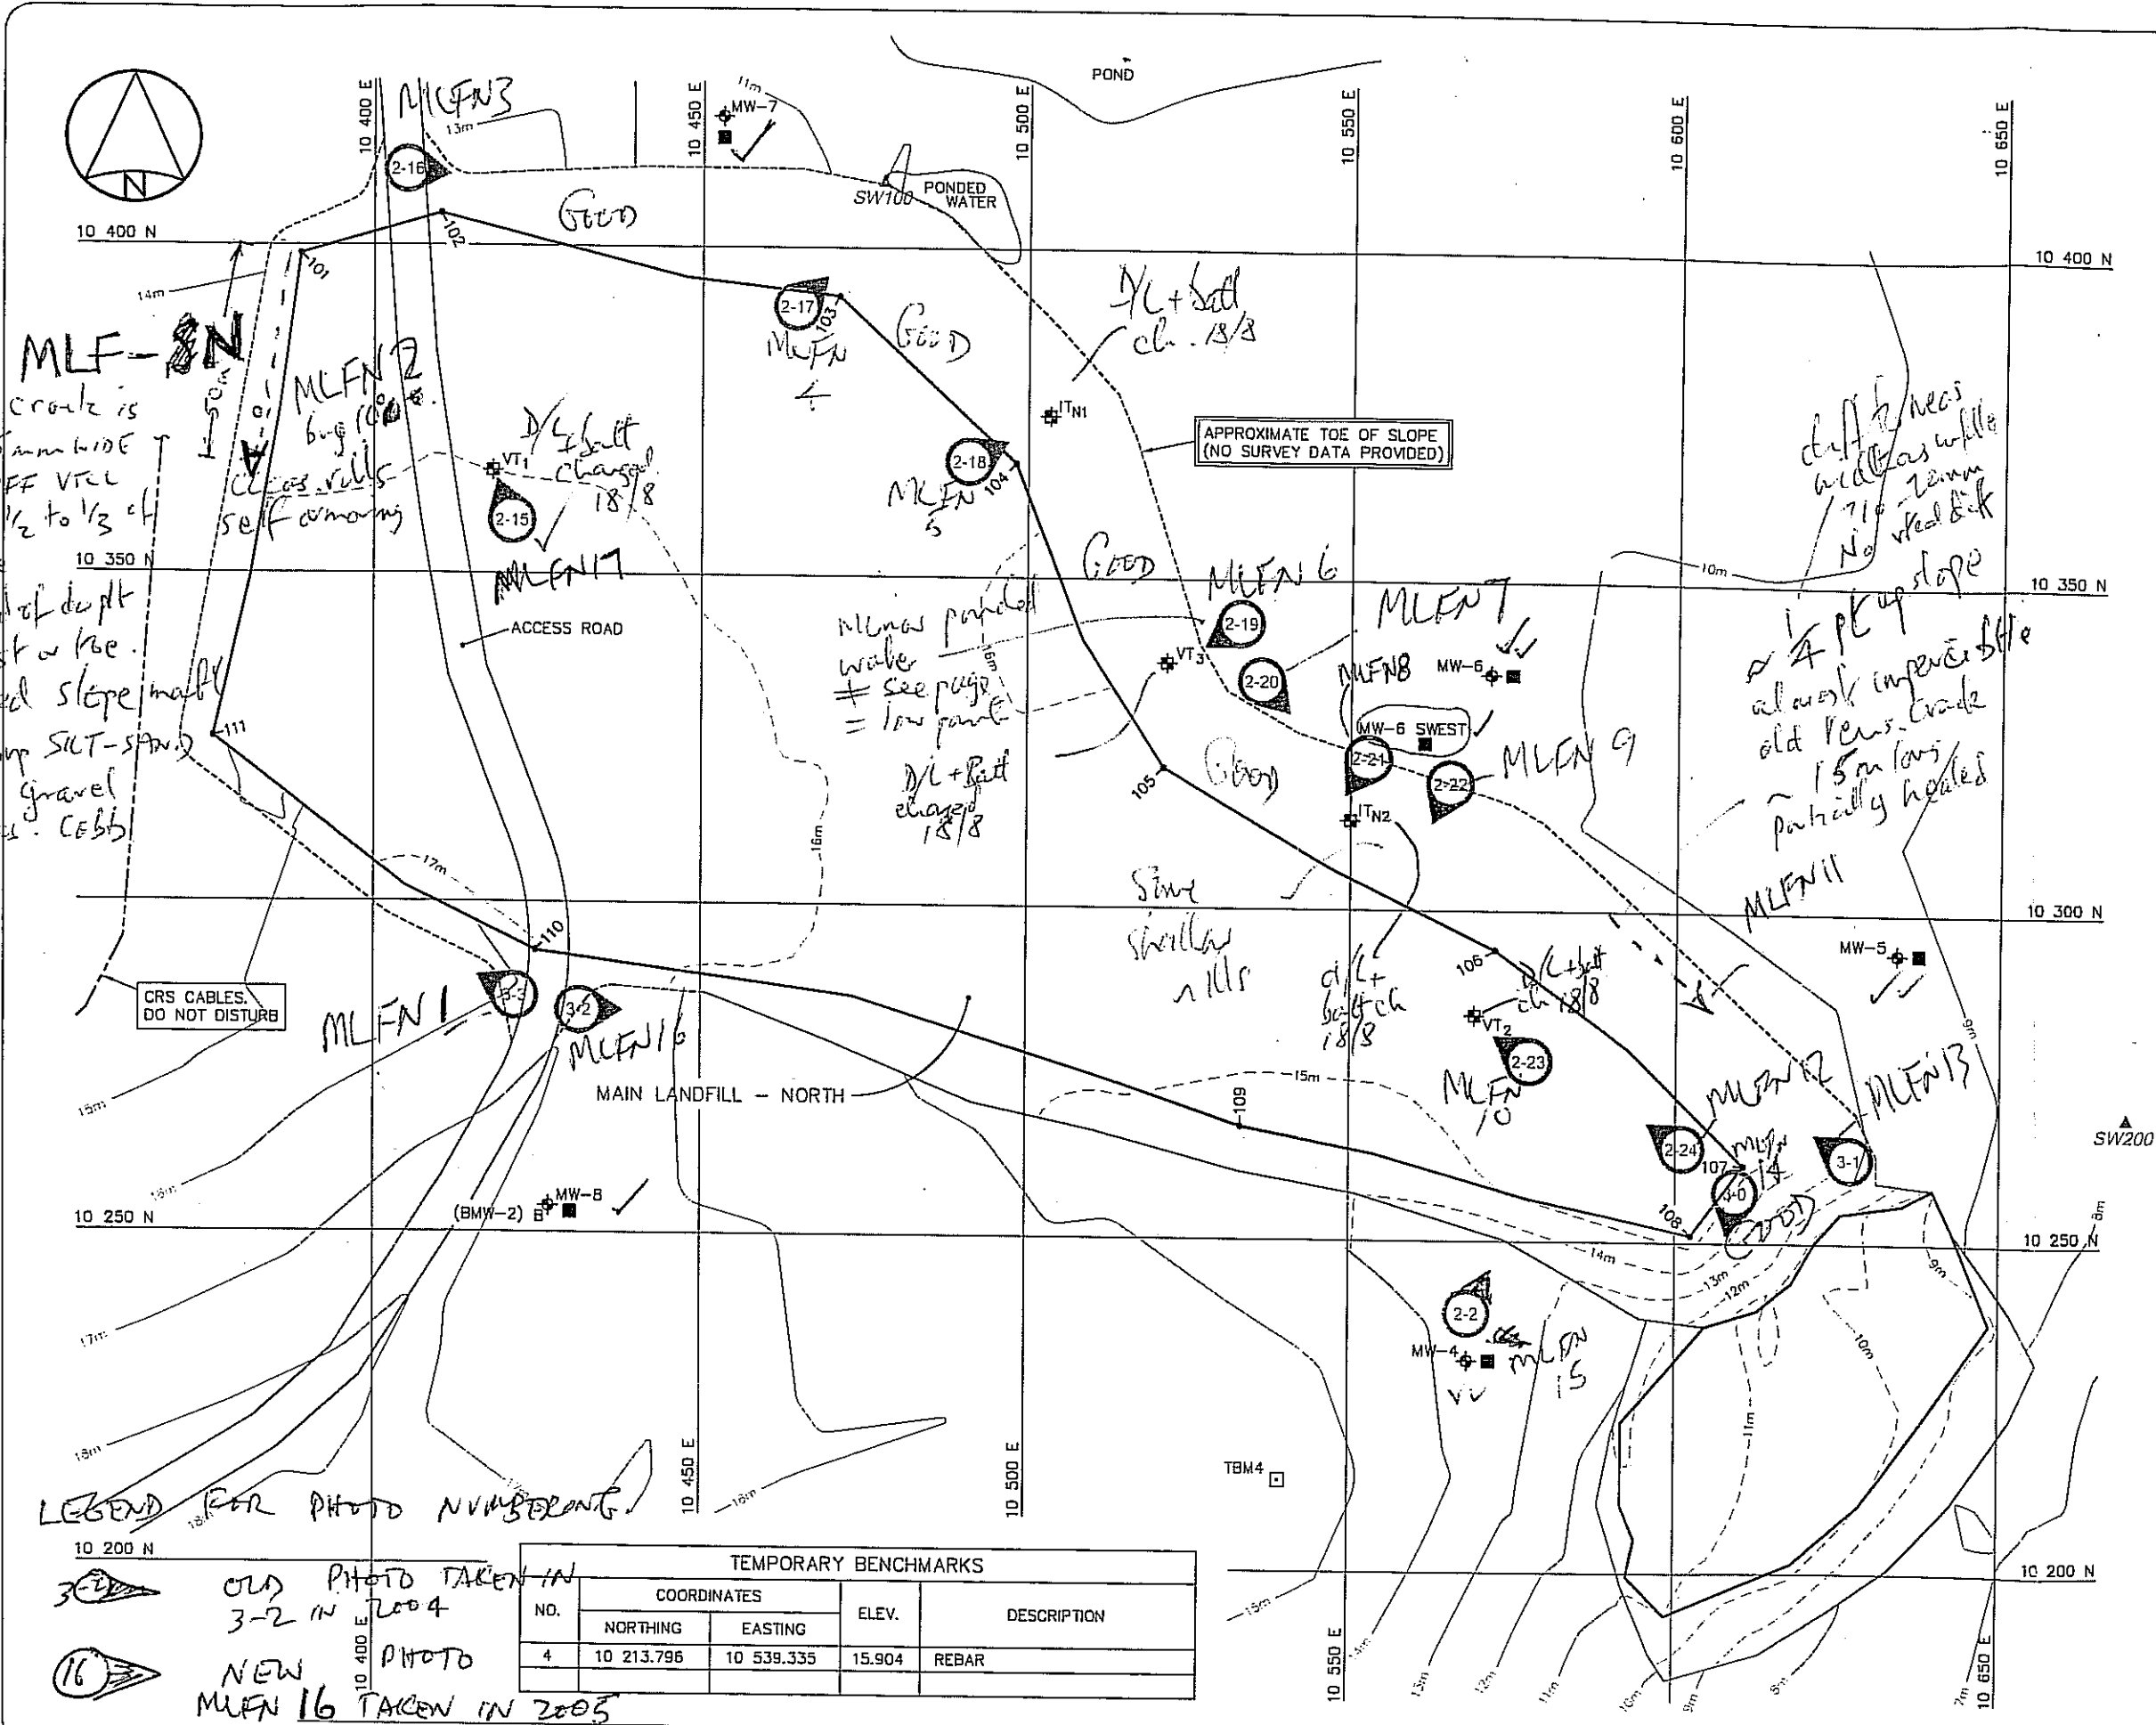

**LEGEND**

TBM4 □ TEMPORARY BENCHMARK

⊕ MONITORING WELL LOCATION

VT ⊕ VERTICAL THERMISTOR

IT ⊕ INCLINED THERMISTOR

101- COORDINATE POINT

FORMER SOIL SAMPLE LOCATION (2003)

■ MONITORING SOIL SAMPLE LOCATION

2-4 PHOTOGRAPH NUMBER AND LOCATION


▲ SW100 SURFACE WATER MONITOR LOCATION

| MONITORING WELLS |             |         |              |
|------------------|-------------|---------|--------------|
| NO.              | COORDINATES |         | GROUND ELEV. |
|                  | NORTHING    | EASTING |              |
| MW-4             | 10 232      | 10 568  | 14.0         |
| MW-5             | 10 294      | 10 634  | 8.9          |
| MW-6             | 10 336      | 10 571  | 10.0         |
| MW-7             | 10 420      | 10 453  | 10.9         |
| MW-8             | 10 254      | 10 427  | 16.5         |

| THERMISTORS |             |          |              |
|-------------|-------------|----------|--------------|
| NO.         | COORDINATES |          | GROUND ELEV. |
|             | NORTHING    | EASTING  |              |
| ITN1        | 10 374.6    | 10 503.3 | 13.11        |
| ITN2        | 10 313.7    | 10 549.9 | 12.23        |
| VT1         | 10 365.7    | 10 418.3 | 15.68        |
| VT2         | 10 284.2    | 10 568.8 | 15.27        |
| VT3         | 10 337.2    | 10 521.6 | 13.73        |

| COORDINATE POINTS |             |          |       |
|-------------------|-------------|----------|-------|
| NO.               | COORDINATES |          | ELEV. |
|                   | NORTHING    | EASTING  |       |
| 101               | 10 398.7    | 10 388.6 | 15.4  |
| 102               | 10 404.9    | 10 410.3 | 15.0  |
| 103               | 10 392.6    | 10 470.8 | 15.6  |
| 104               | 10 367.4    | 10 498.1 | 15.9  |
| 105               | 10 321.4    | 10 521.1 | 15.6  |
| 106               | 10 294.1    | 10 571.8 | 15.2  |
| 107               | 10 261.7    | 10 610.6 | 15.4  |
| 108               | 10 251.1    | 10 602.4 | 15.5  |
| 109               | 10 267.0    | 10 533.3 | 14.8  |
| 110               | 10 292.7    | 10 424.9 | 17.0  |
| 111               | 10 325.1    | 10 375.1 | 16.6  |

Original baseplan - UMA Main Landfill North, Figure CAM-M.2 April, 2002

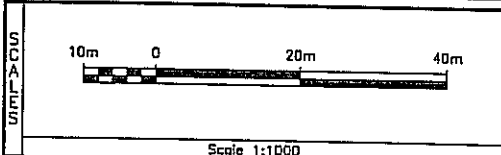

DEFENCE CONSTRUCTION CANADA

MAIN LANDFILL NORTH

Designed By: - Drawn By: JEP/JDM

Checked By: - Approved By: -

Date Issued: FEBRUARY 4, 2005 Project No.: 40-096

Gartner Lee

FIGURE A-1

**LEGEND FOR PHOTO NUMBERING**

3-2 OLD PHOTO TAKEN IN 3-2 IN 2004


16 NEW PHOTO TAKEN IN 2005

| TEMPORARY BENCHMARKS |             |            |        |             |
|----------------------|-------------|------------|--------|-------------|
| NO.                  | COORDINATES |            | ELEV.  | DESCRIPTION |
|                      | NORTHING    | EASTING    |        |             |
| 4                    | 10 213.796  | 10 539.335 | 15.904 | REBAR       |



SSLF

- LEGEND
- TBM20 □ TEMPORARY BENCHMARK
  - 130 → COORDINATE POINT
  - MONITORING SOIL SAMPLE LOCATION
  - 1-24 PHOTOGRAPH NUMBER AND LOCATION

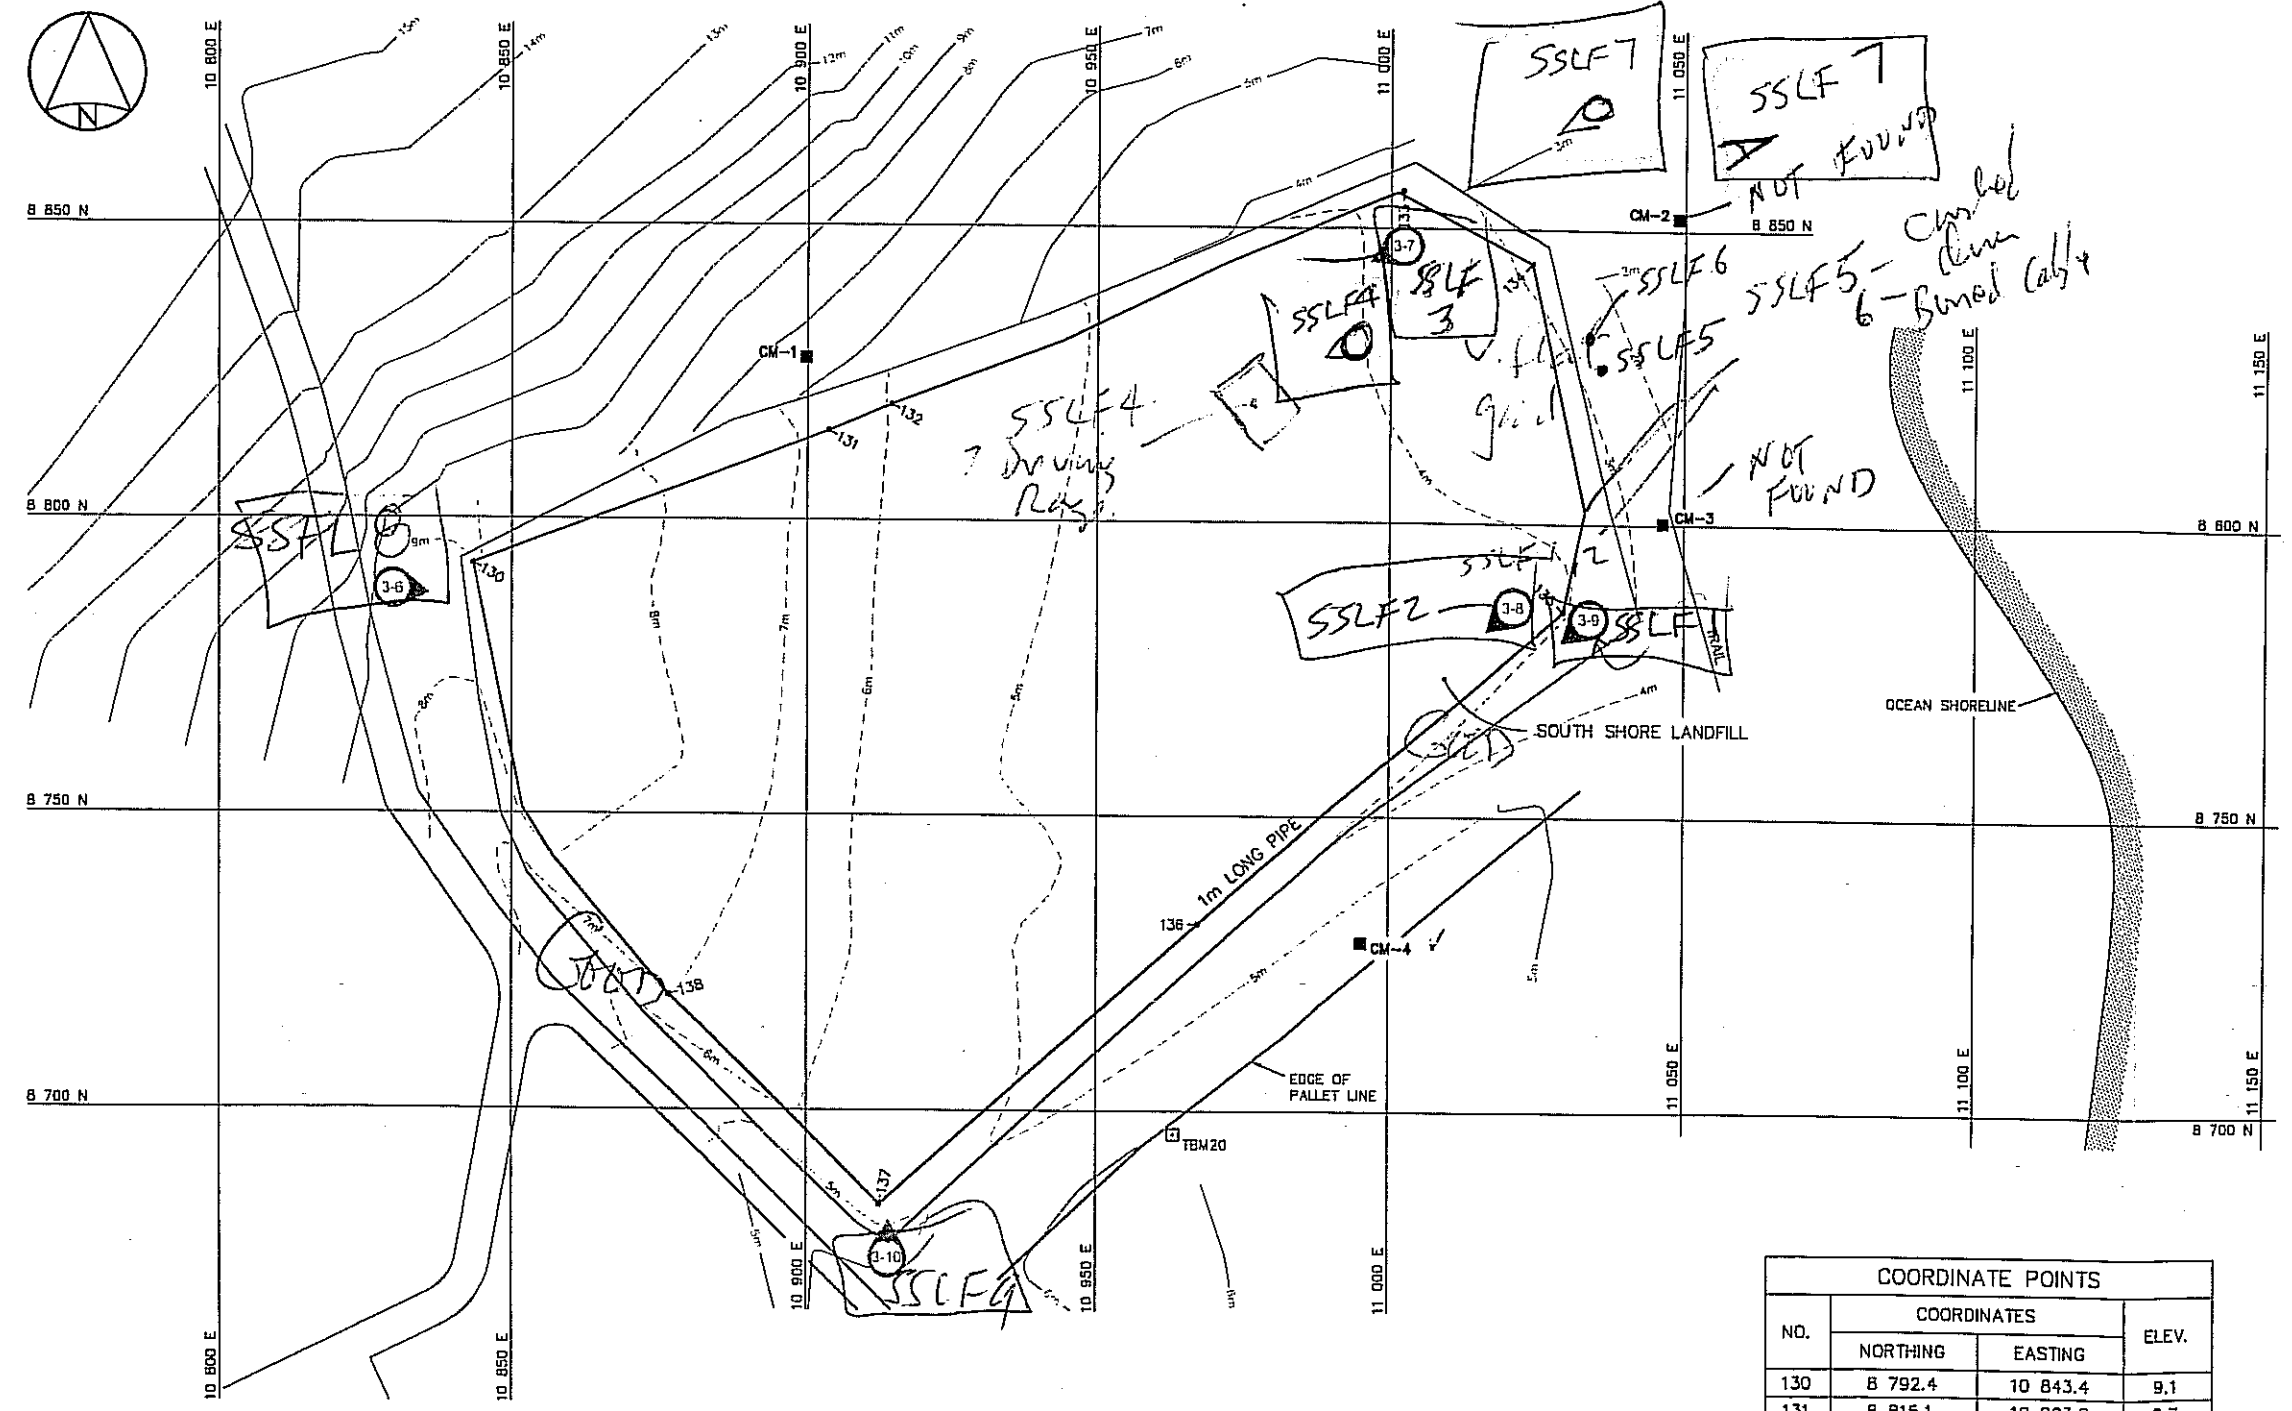

| TEMPORARY BENCHMARKS |             |            |       |             |
|----------------------|-------------|------------|-------|-------------|
| NO.                  | COORDINATES |            | ELEV. | DESCRIPTION |
|                      | NORTHING    | EASTING    |       |             |
| 20                   | 8 696.120   | 10 963.265 | 6.036 | REBAR       |

| COORDINATE POINTS |             |          |       |
|-------------------|-------------|----------|-------|
| NO.               | COORDINATES |          | ELEV. |
|                   | NORTHING    | EASTING  |       |
| 130               | 8 792.4     | 10 843.4 | 9.1   |
| 131               | 8 815.1     | 10 903.8 | 6.7   |
| 132               | 8 819.6     | 10 914.6 | 5.9   |
| 133               | 8 856.3     | 11 002.0 | 3.9   |
| 134               | 8 844.1     | 11 023.9 | 2.8   |
| 135               | 8 785.1     | 11 029.3 | 4.1   |
| 136               | 8 731.6     | 10 967.4 | 4.7   |
| 137               | 8 684.2     | 10 912.6 | 5.5   |
| 138               | 8 719.4     | 10 876.6 | 7.0   |

Original baseplan - UMA South Shore Landfill  
Figure CAM-M.4, April, 2002

10m 0 20m 40m

Scale 1:1250

DEFENCE CONSTRUCTION CANADA

SOUTH SHORE LANDFILL

|                               |                     |
|-------------------------------|---------------------|
| Designed By: --               | Drawn By: JEP/JDM   |
| Checked By: --                | Approved By: --     |
| Date Issued: FEBRUARY 4, 2005 | Project No.: 40-096 |


Gartner Lee

FIGURE C-1


WLF

| COORDINATE POINTS |             |         |       |
|-------------------|-------------|---------|-------|
| NO.               | COORDINATES |         | ELEV. |
|                   | NORTHING    | EASTING |       |
| 140               | 10 934.2    | 9 129.9 | 33.7  |
| 141               | 10 941.2    | 9 153.2 | 31.4  |
| 142               | 10 913.8    | 9 210.7 | 24.9  |
| 143               | 10 899.2    | 9 217.5 | 24.4  |
| 144               | 10 848.1    | 9 158.7 | 33.8  |


| TEMPORARY BENCHMARKS |             |           |        |             |
|----------------------|-------------|-----------|--------|-------------|
| NO.                  | COORDINATES |           | ELEV.  | DESCRIPTION |
|                      | NORTHING    | EASTING   |        |             |
| 6                    | 10 855.427  | 9 167.072 | 33.087 | REBAR       |

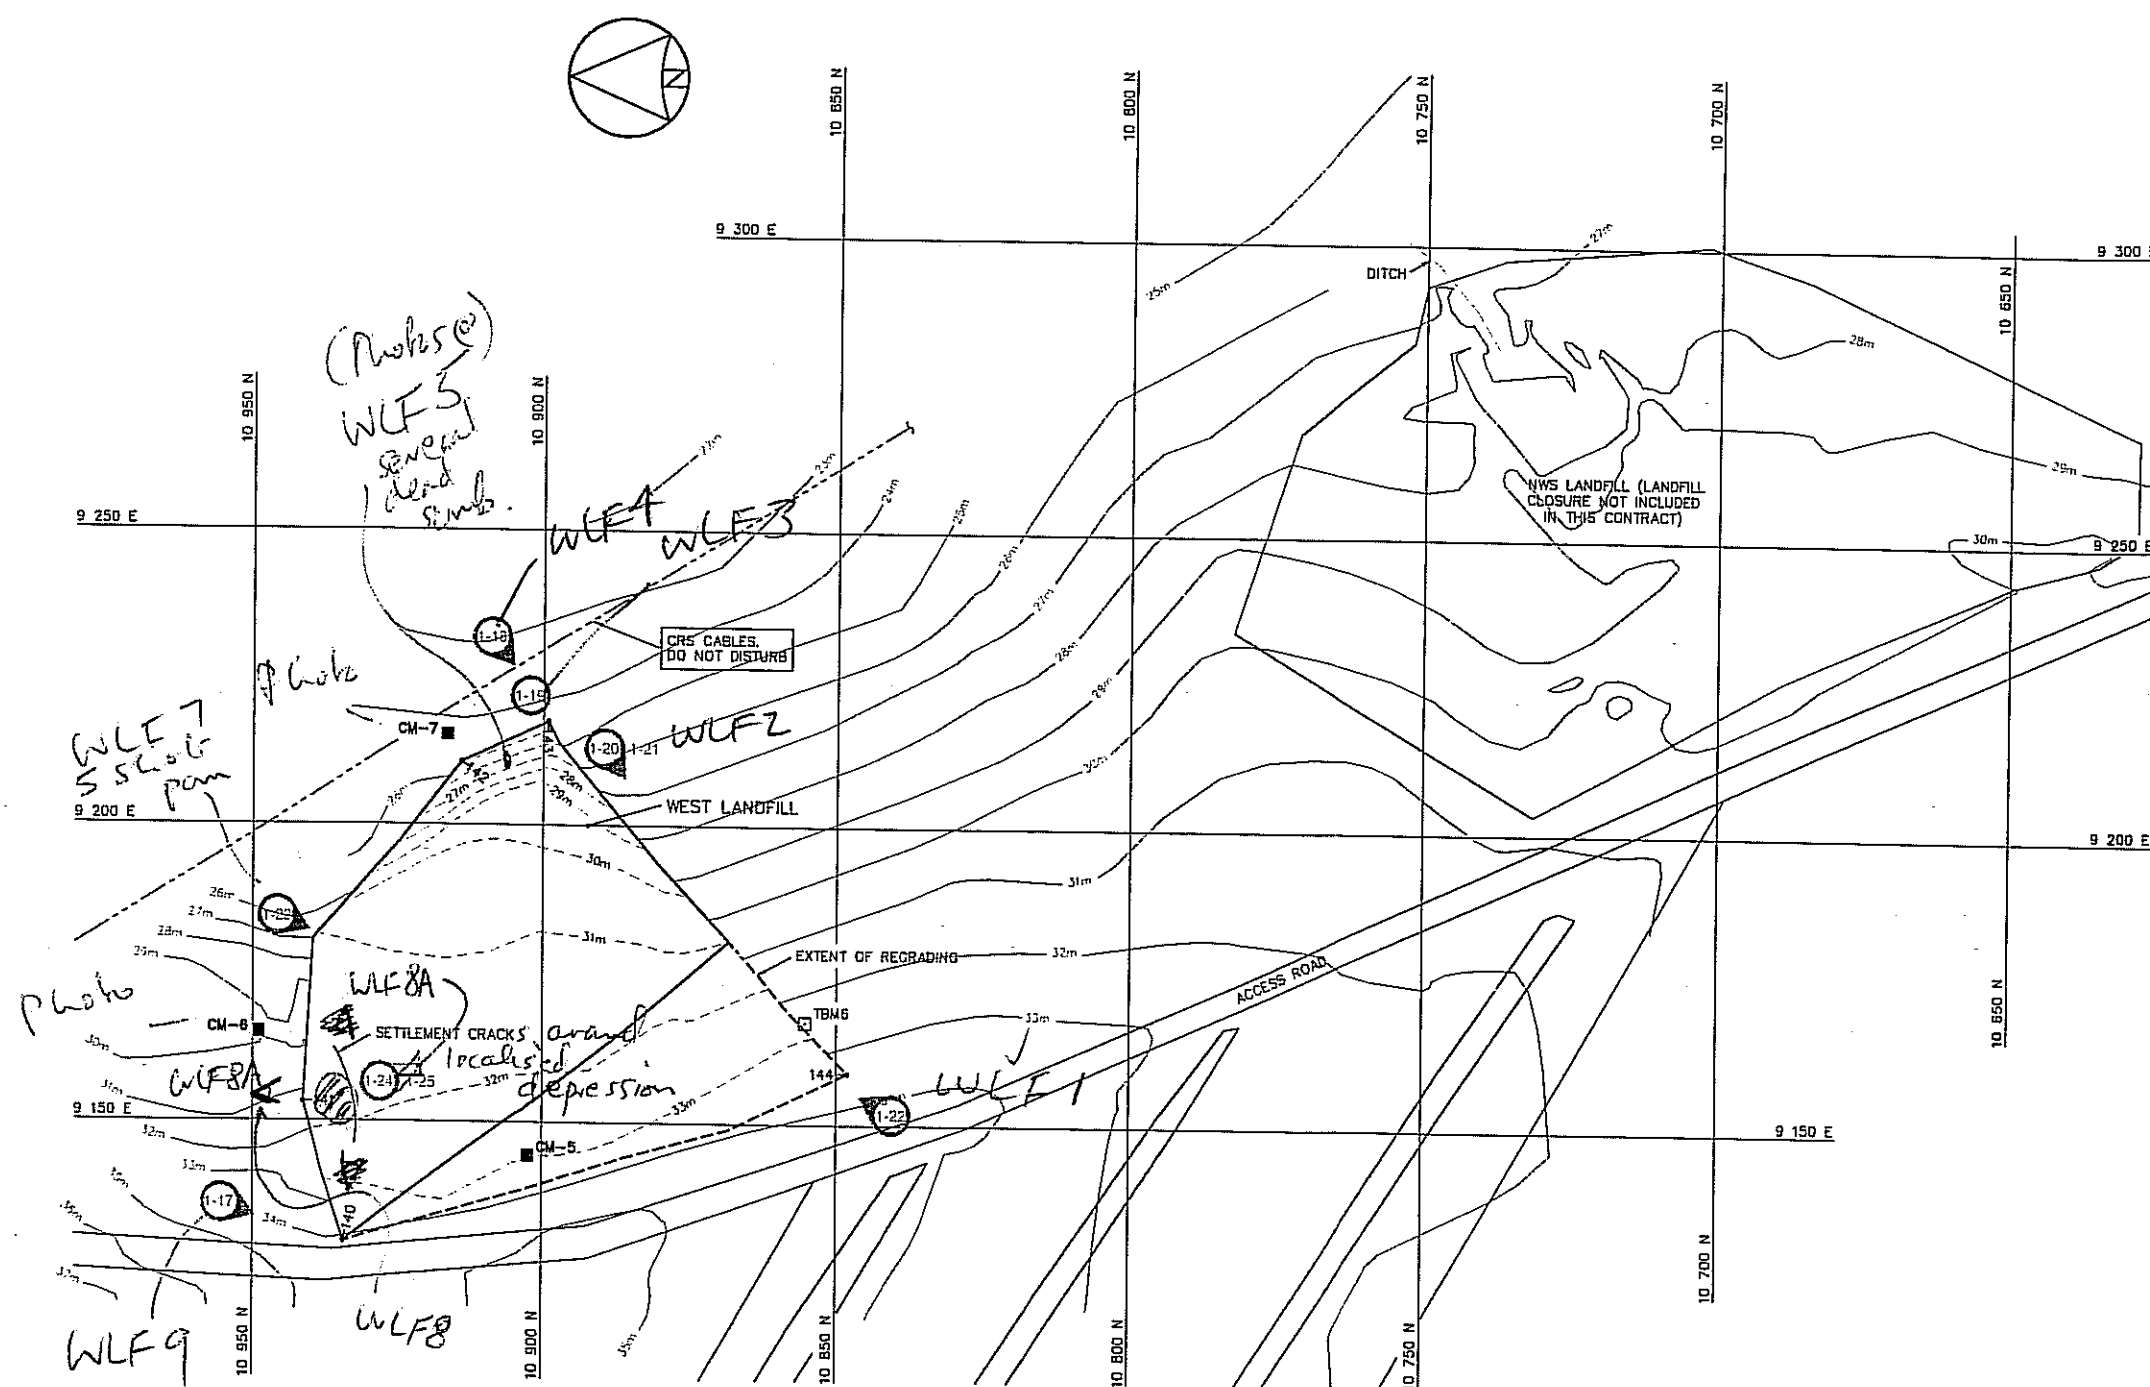

- LEGEND
- TBM6 □ TEMPORARY BENCHMARK
  - 140 → COORDINATE POINT
  - MONITORING SOIL SAMPLE LOCATION
  - 1-12 PHOTOGRAPH NUMBER AND LOCATION

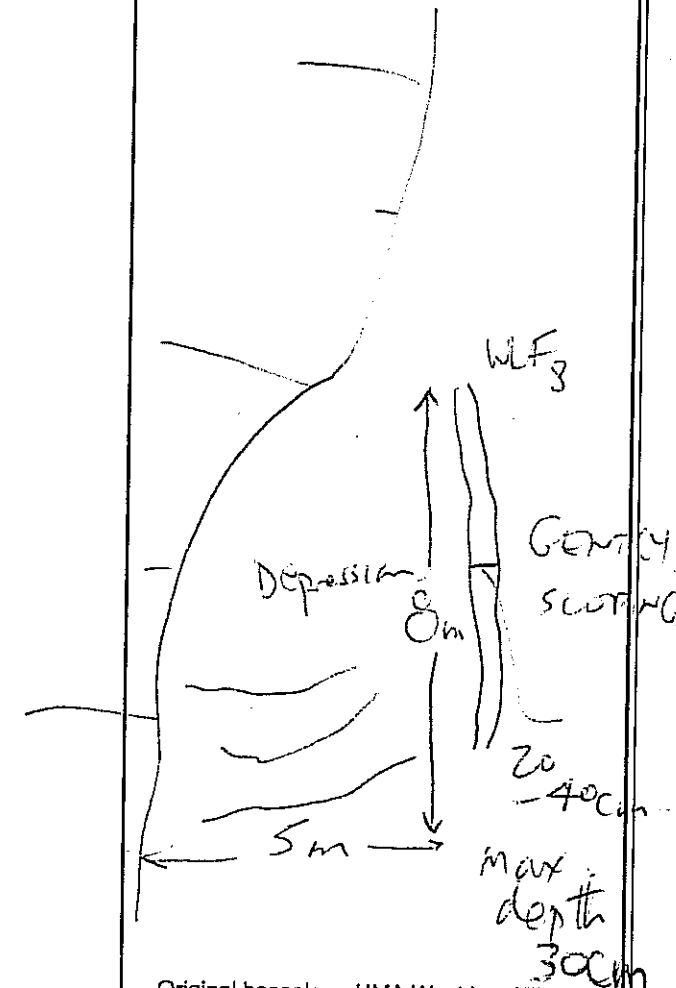

Original baseplan - UMA West Landfill and NWS Landfill  
Figure CAM-M.5  
April, 2002

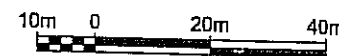

Scale 1:1250

DEFENCE CONSTRUCTION  
CANADA

WEST LANDFILL  
AND NWS LANDFILL

Designed By: — Drawn By: JEP/JDM  
Checked By: — Approved By: —  
Date issued: FEBRUARY 4, 2005 Project No.: 40-086

Gartner Lee


FIGURE  
D-1

ALF

SEE FIGURE CAM-M.7

| TEMPORARY BENCHMARKS |               |             |        |             |
|----------------------|---------------|-------------|--------|-------------|
| NO.                  | COORDINATES   |             | ELEV.  | DESCRIPTION |
|                      | NORTHING      | EASTING     |        |             |
| CAM100               | 7 666 792.639 | 493 351.663 | 25.022 | 13mm REBAR  |
| CAM101               | 7 666 837.920 | 492 961.411 | 23.044 | 13mm REBAR  |
| CAM102               | 7 666 798.700 | 492 793.867 | 19.344 | 13mm REBAR  |

UTM Zone 13N Nad83 CSRS

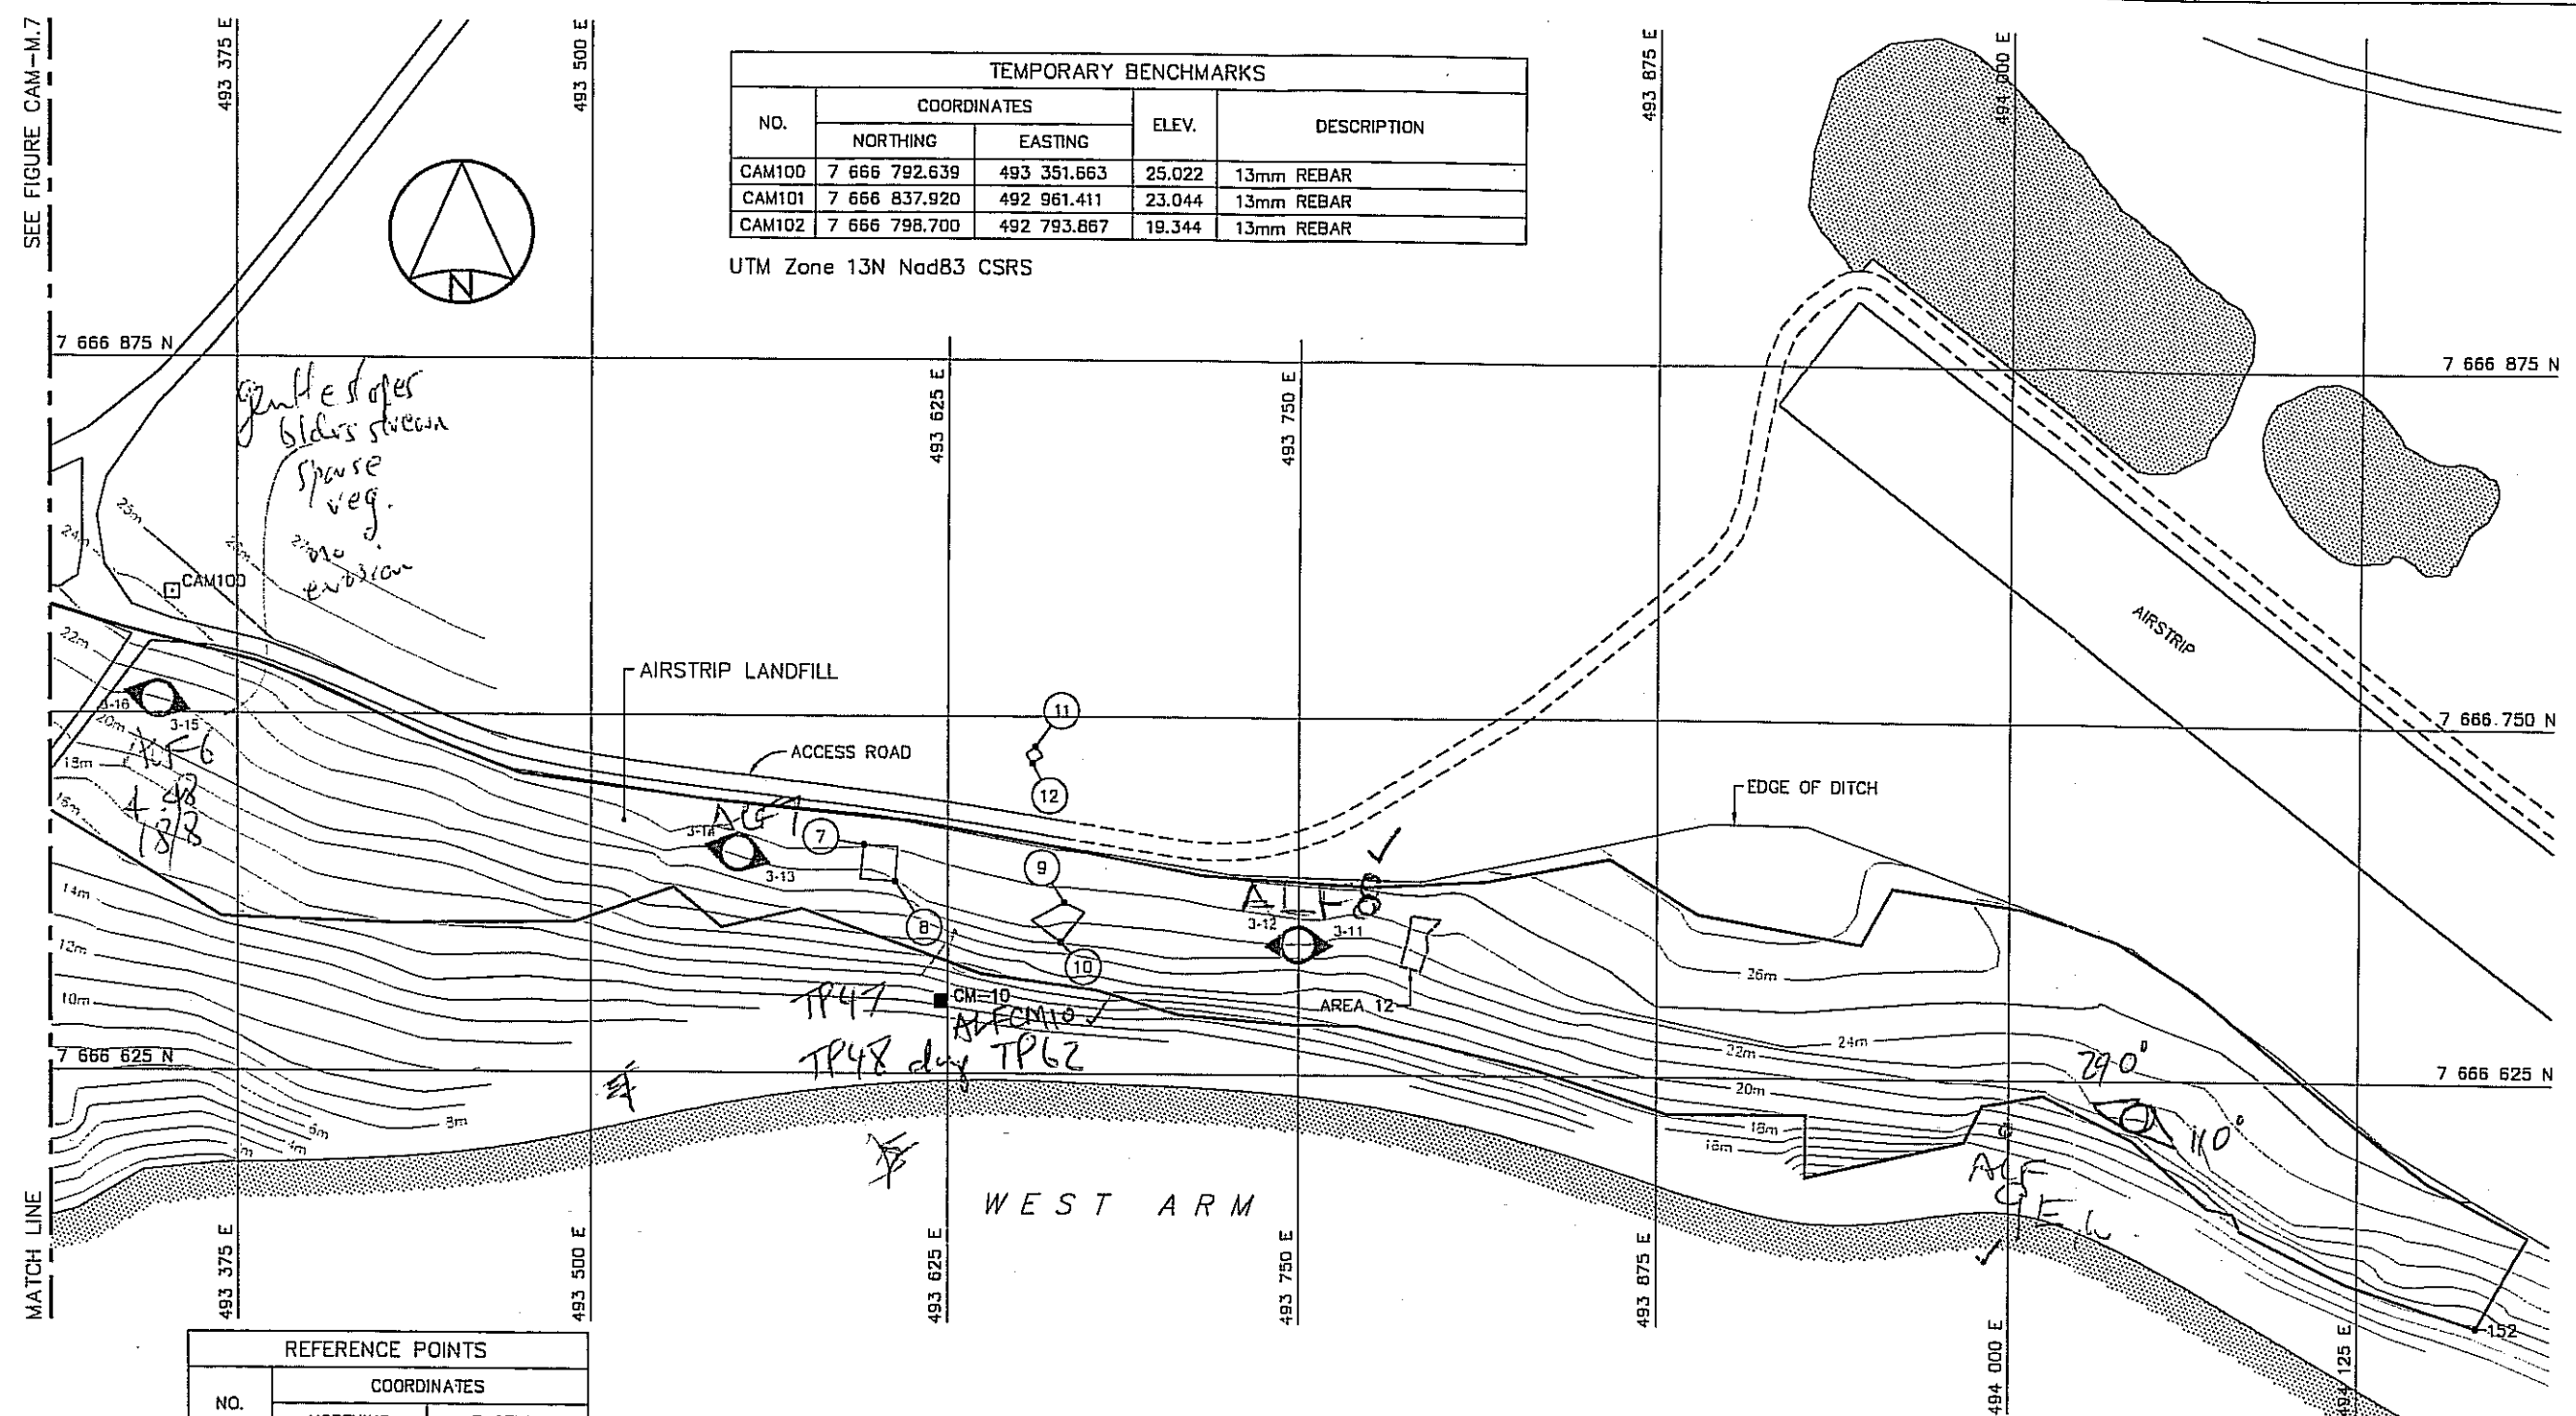

| REFERENCE POINTS |             |           |
|------------------|-------------|-----------|
| NO.              | COORDINATES |           |
|                  | NORTHING    | EASTING   |
| 7                | 7 666 704.9 | 493 595.6 |
| 8                | 7 666 692.3 | 493 606.4 |
| 9                | 7 666 685.0 | 493 666.2 |
| 10               | 7 666 670.9 | 493 665.0 |
| 11               | 7 666 739.5 | 493 655.9 |
| 12               | 7 666 733.7 | 493 654.8 |

| COORDINATE POINTS |             |           |
|-------------------|-------------|-----------|
| NO.               | COORDINATES |           |
|                   | NORTHING    | EASTING   |
| 152               | 7 666 539.5 | 494 167.6 |

| MONITORING LOCATIONS |             |           |
|----------------------|-------------|-----------|
| NO.                  | COORDINATES |           |
|                      | NORTHING    | EASTING   |
| CM10                 | 7 666 650.3 | 493 622.7 |

LEGEND

- TBM2400 TEMPORARY BENCHMARK
- 7 REFERENCE POINT
- 152 COORDINATE POINT
- 1-16 PHOTOGRAPH NUMBER AND LOCATION
- REGRADED AREAS
- FORMER CONTAMINATED SOIL AREAS
- MONITORING SOIL SAMPLE LOCATION

Original baseplan - UMA Existing Airstrip Landfill  
Figure CAM-M.8, July, 2004

Scale 1:2500

25m 0 50m 100m

DESIGNED BY: — CHECKED BY: — DATE ISSUED: FEBRUARY 4, 2005


DRAWN BY: JEP/JDM APPROVED BY: — PROJECT NO.: 40-098

DEFENCE CONSTRUCTION CANADA

EXISTING AIRPORT LANDFILL

Gartner Lee

FIGURE E-1

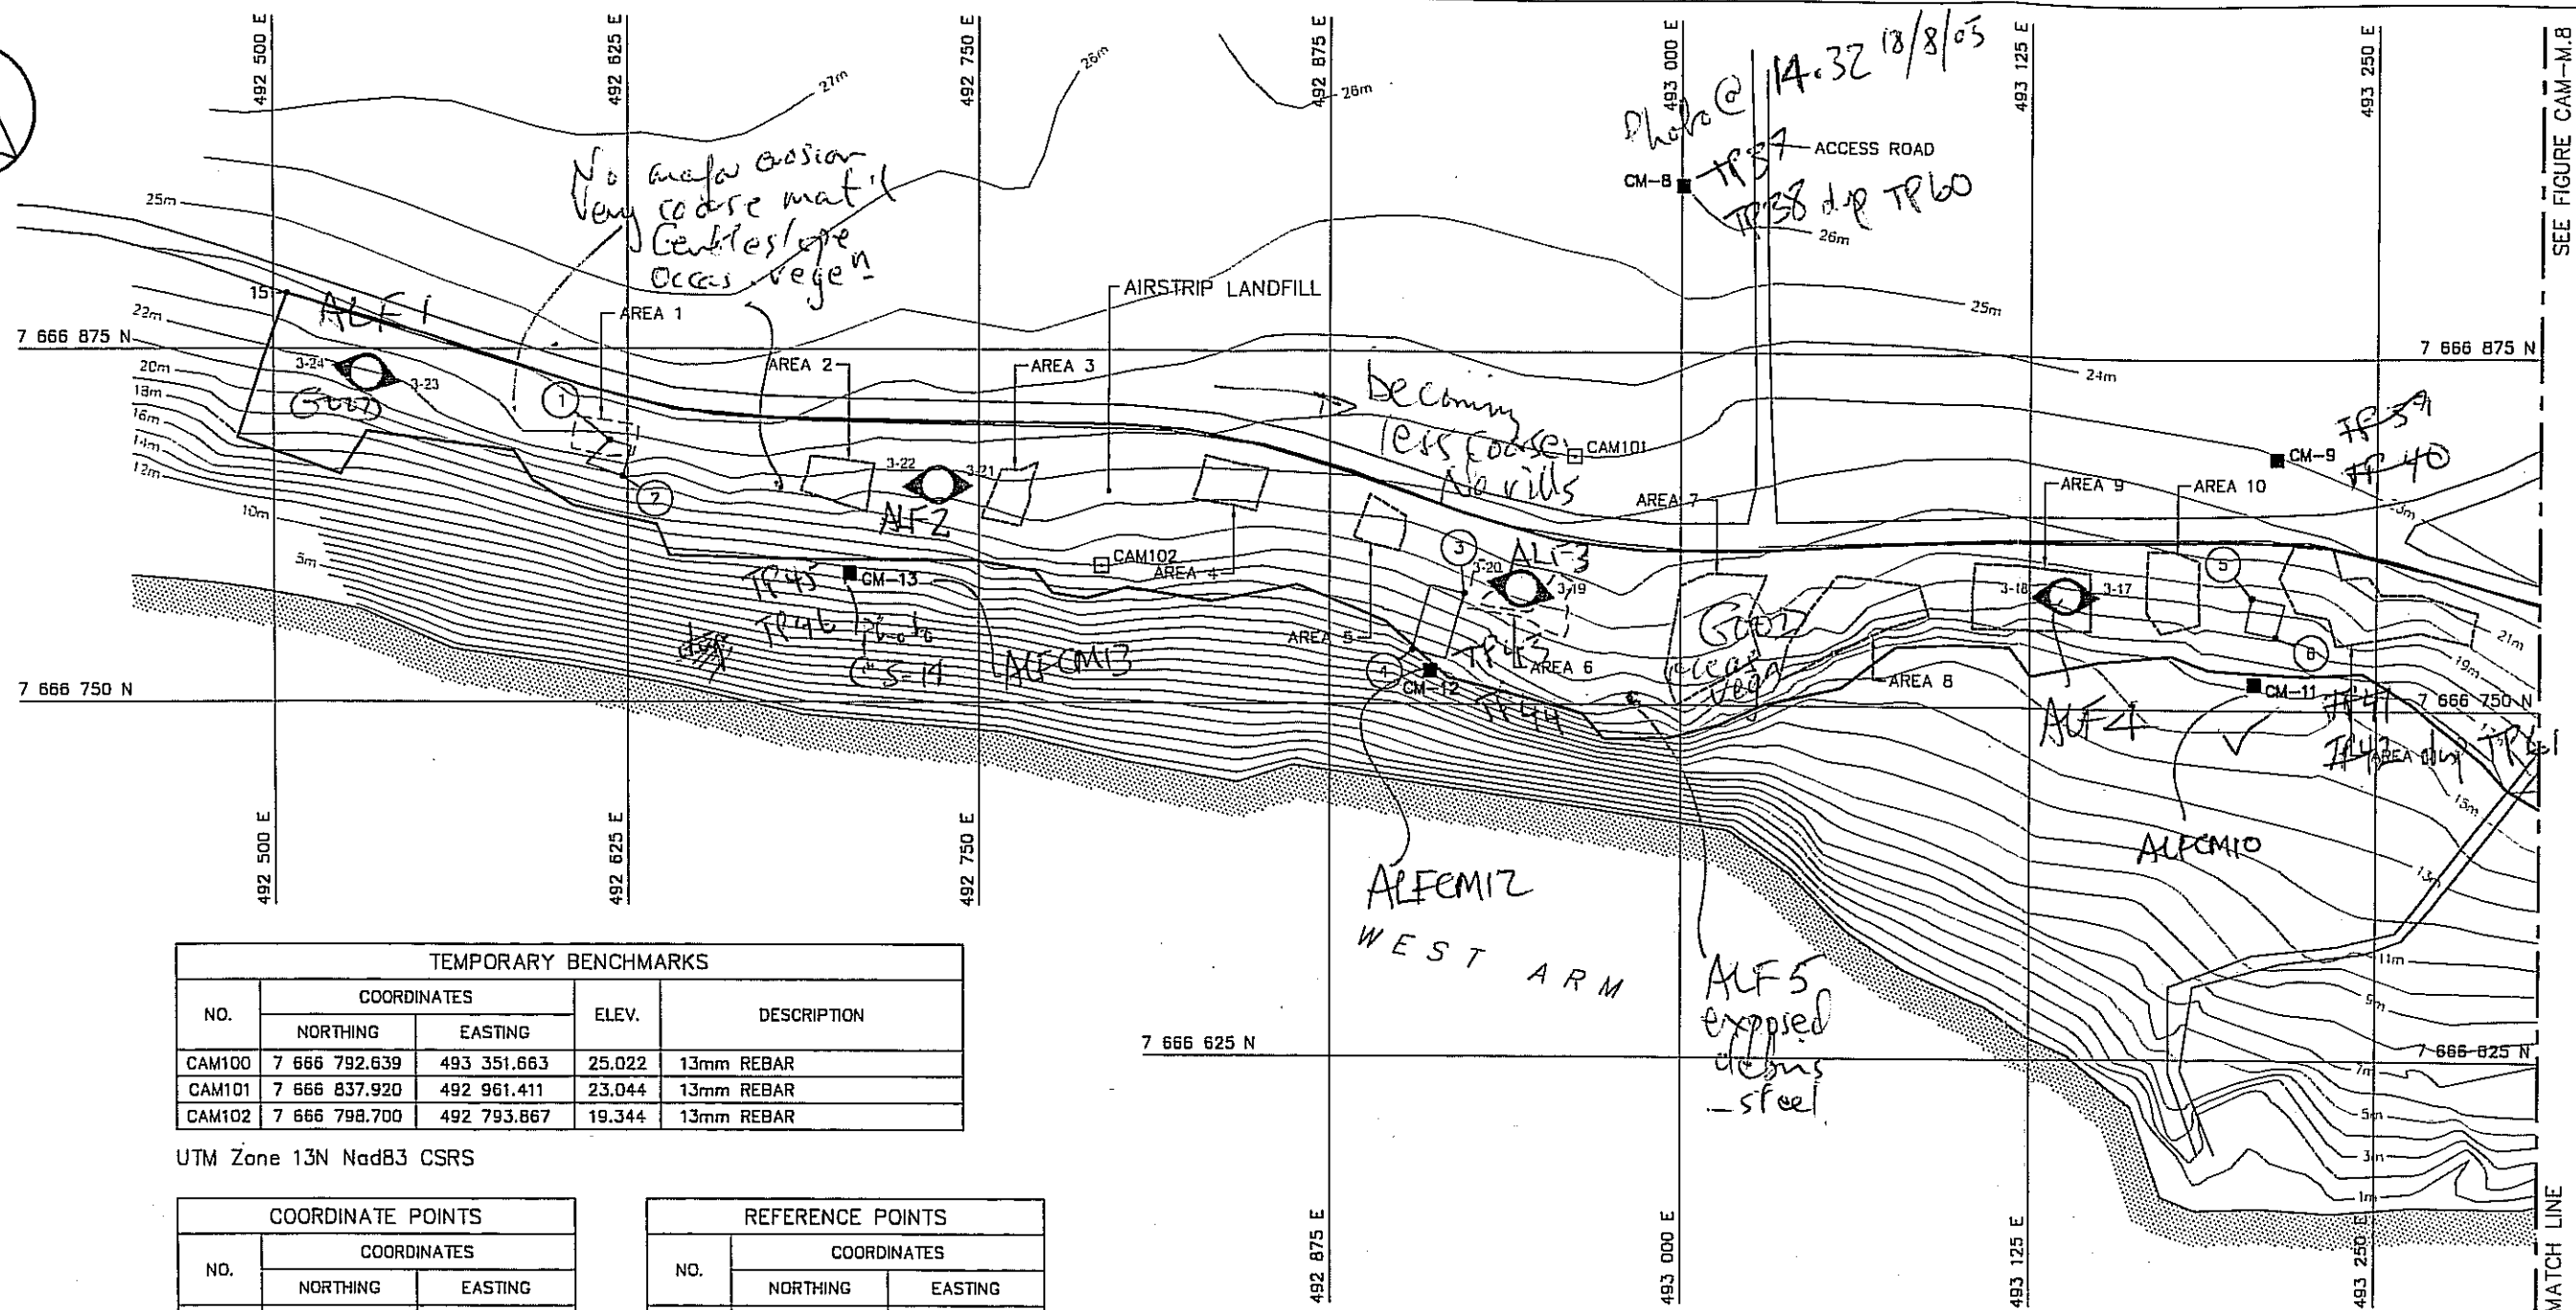

UTM Zone 13N Nad83 CSRS

| MONITORING LOCATIONS |             |           |
|----------------------|-------------|-----------|
| NO.                  | COORDINATES |           |
|                      | NORTHING    | EASTING   |
| CM8                  | 7 666 934.7 | 493 000.4 |
| CM9                  | 7 666 839.4 | 493 213.5 |
| CM11                 | 7 666 759.2 | 493 205.6 |
| CM12                 | 7 666 761.9 | 492 910.4 |
| CM13                 | 7 666 795.8 | 492 703.7 |

| REFERENCE POINTS |             |           |
|------------------|-------------|-----------|
| NO.              | COORDINATES |           |
|                  | NORTHING    | EASTING   |
| 1                | 7 666 842.6 | 492 618.8 |
| 2                | 7 666 829.9 | 492 623.3 |
| 3                | 7 666 789.3 | 492 922.2 |
| 4                | 7 666 769.3 | 492 904.0 |
| 5                | 7 666 790.1 | 493 204.8 |
| 6                | 7 666 776.2 | 493 213.4 |

### LEGEND

TBM2500 ☒ TEMPORARY BENCHMARK

① REFERENCE POINT

151 → COORDINATE POINT

1-12 PHOTOGRAPH NUMBER AND LOCATION

 REGRADED AREAS

[ ] EXCAVATED AREAS

 FORMER CONTAMINATED  
SOIL AREAS

MONITORING SOIL SAMPLE LOCATION

Original baseplan - UMA Existing Airstrip  
Landfill

Figure CAM-M.7, July, 2004

|     |          |      |         |
|-----|----------|------|---------|
|     |          |      |         |
|     |          |      |         |
| No. | Revision | Date | Initial |



Scale 1:2500

Designed By: —

Drawn By: JEP/JDM

Checked By: —

Approved By: -

|                               |                     |
|-------------------------------|---------------------|
| Date Issued: FEBRUARY 4, 2005 | Project No.: 40-098 |
|-------------------------------|---------------------|


DEFENCE CONSTRUCTION  
CANADA

EXISTING AIRPORT LANDFILL



Gartner Lee

FIGURE  
E-2

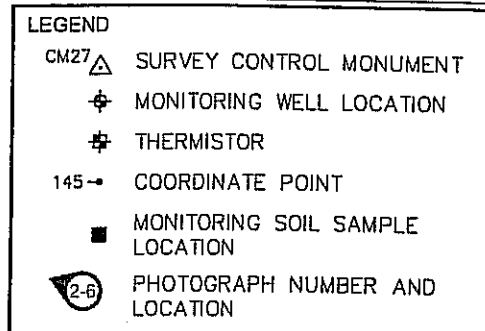

| THERMISTORS |             |         |       |
|-------------|-------------|---------|-------|
| NO.         | COORDINATES |         | ELEV. |
|             | NORTHING    | EASTING |       |
| TA1         | 12 007.3    | 8 993.5 | 43.8  |
| TA2         | 12 016.8    | 9 037.1 | 43.4  |
| TA3         | 12 066.6    | 8 984.7 | 43.0  |
| TA4         | 12 035.0    | 8 953.8 | 44.2  |

Original baseplan - UMA Tier 2 Soil  
Disposal Area  
Figure CAM-M.6, April, 2002

D.C.C. TIER II  
SOIL DISPOSAL AREA

 Gartner Lee