



Stantec
4910 - 53 Street PO Box 1777
Yellowknife, NT, Canada
X1A 2P4
Tel. 867.920.2882
Fax. 867.920.4319
www.stantec.com


Startec

Copyright Reserved

The Contractor shall verify and be responsible for all dimensions. DO NOT scale the drawing – any errors or omissions shall be reported to Stantec without delay.

The Copyrights to all designs and drawings are the property of Stantec. Reproduction or use for any purpose other than that authorized by Stantec is forbidden.

Consultants

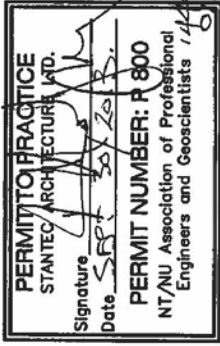

Notes

CONSTRUCTION OF LANDFARM EXPANSION
TO FOLLOW DESIGN REQUIREMENTS FROM
EXISTING CONTRACT DOCUMENTS

[illegible]

1	Record Drawing				13.10.01
X	Issued for Review				13.07.25
Issued		By	Appd.		YY MM DD

File Name: 144901145	E0	AJ	13.07.25
	Dwn.	Chkd.	YY.MM.DD
		Dsgn.	

Client/Project

FUEL STORAGE FACILITY UPGRADES

Chesterfield Inlet, NU

Title _____

Landfarm Expansion

Project No. 144901145	Scale 1:500
Drawing No.	Sheet
	Revision

SK01

1 of 10

ORIGINAL SHEET - ANSI D