



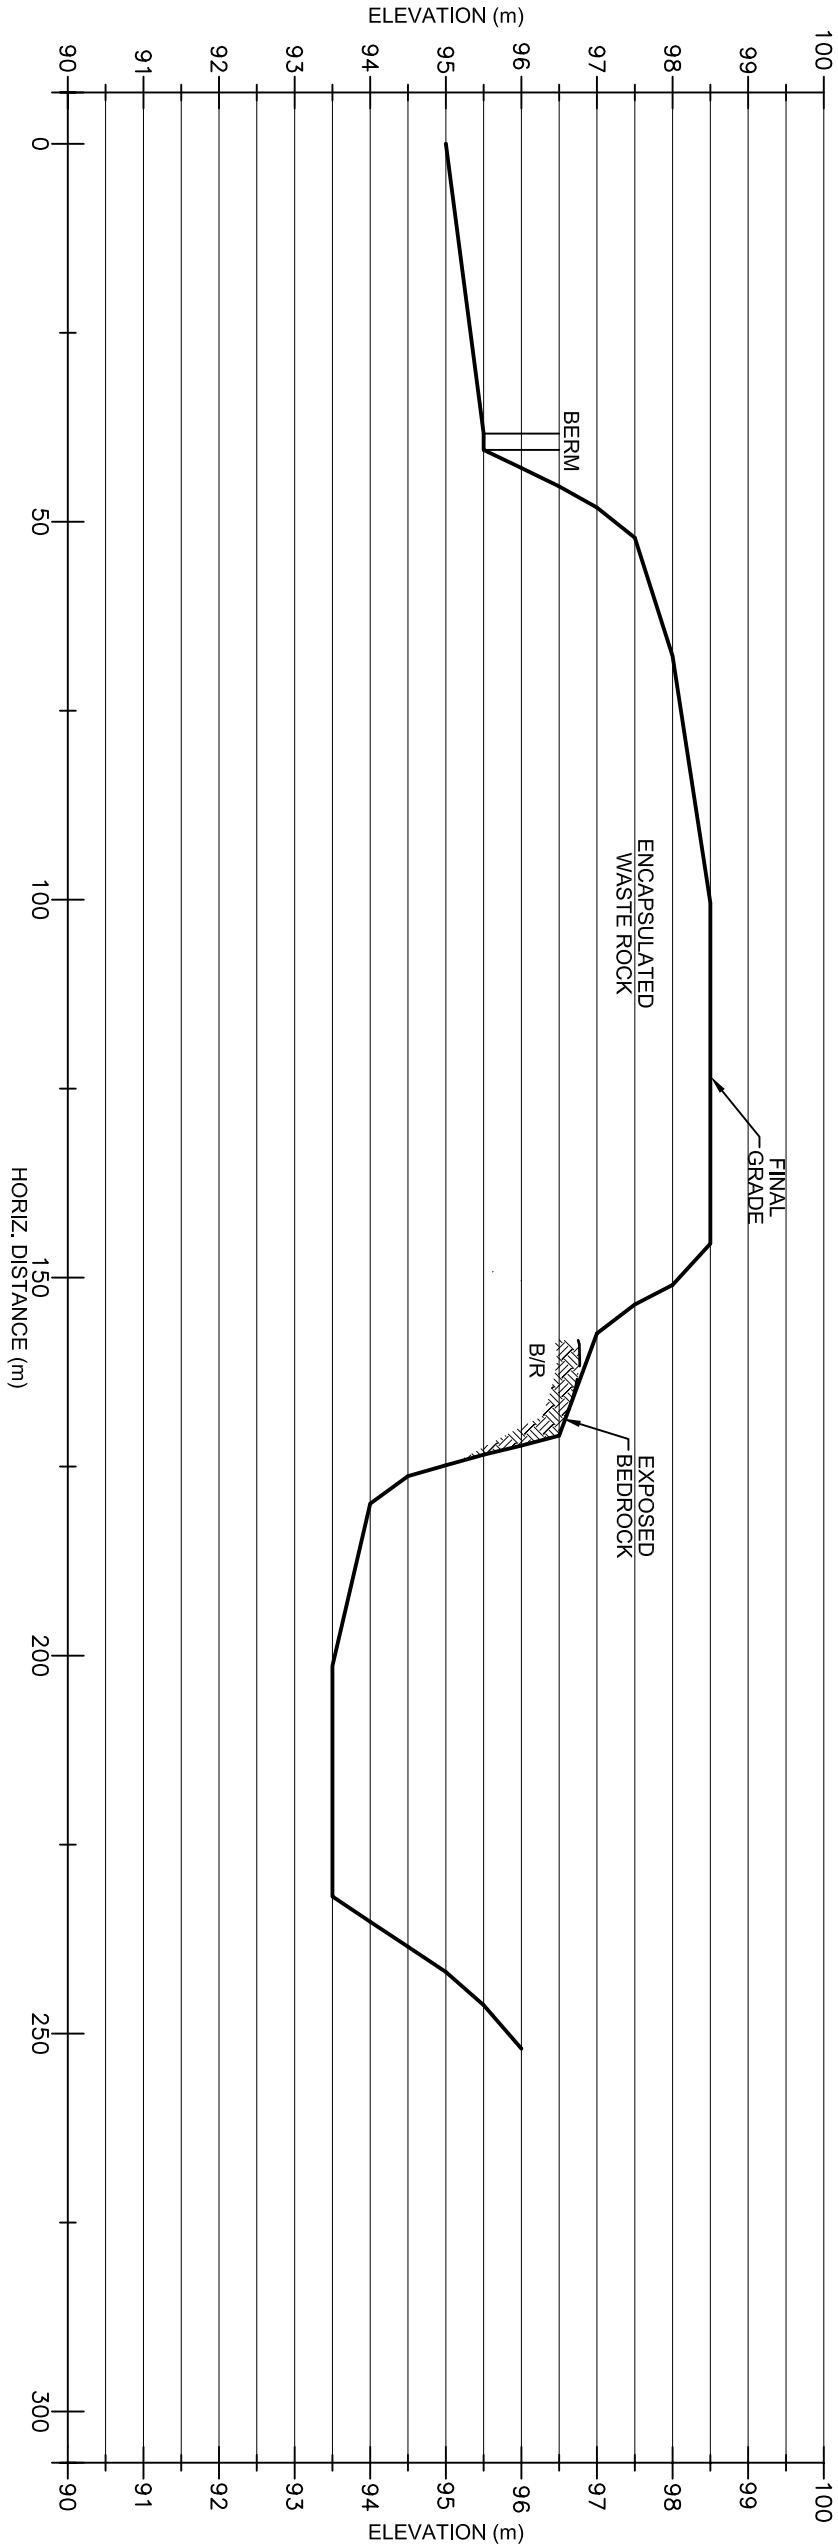

SECTION A-A

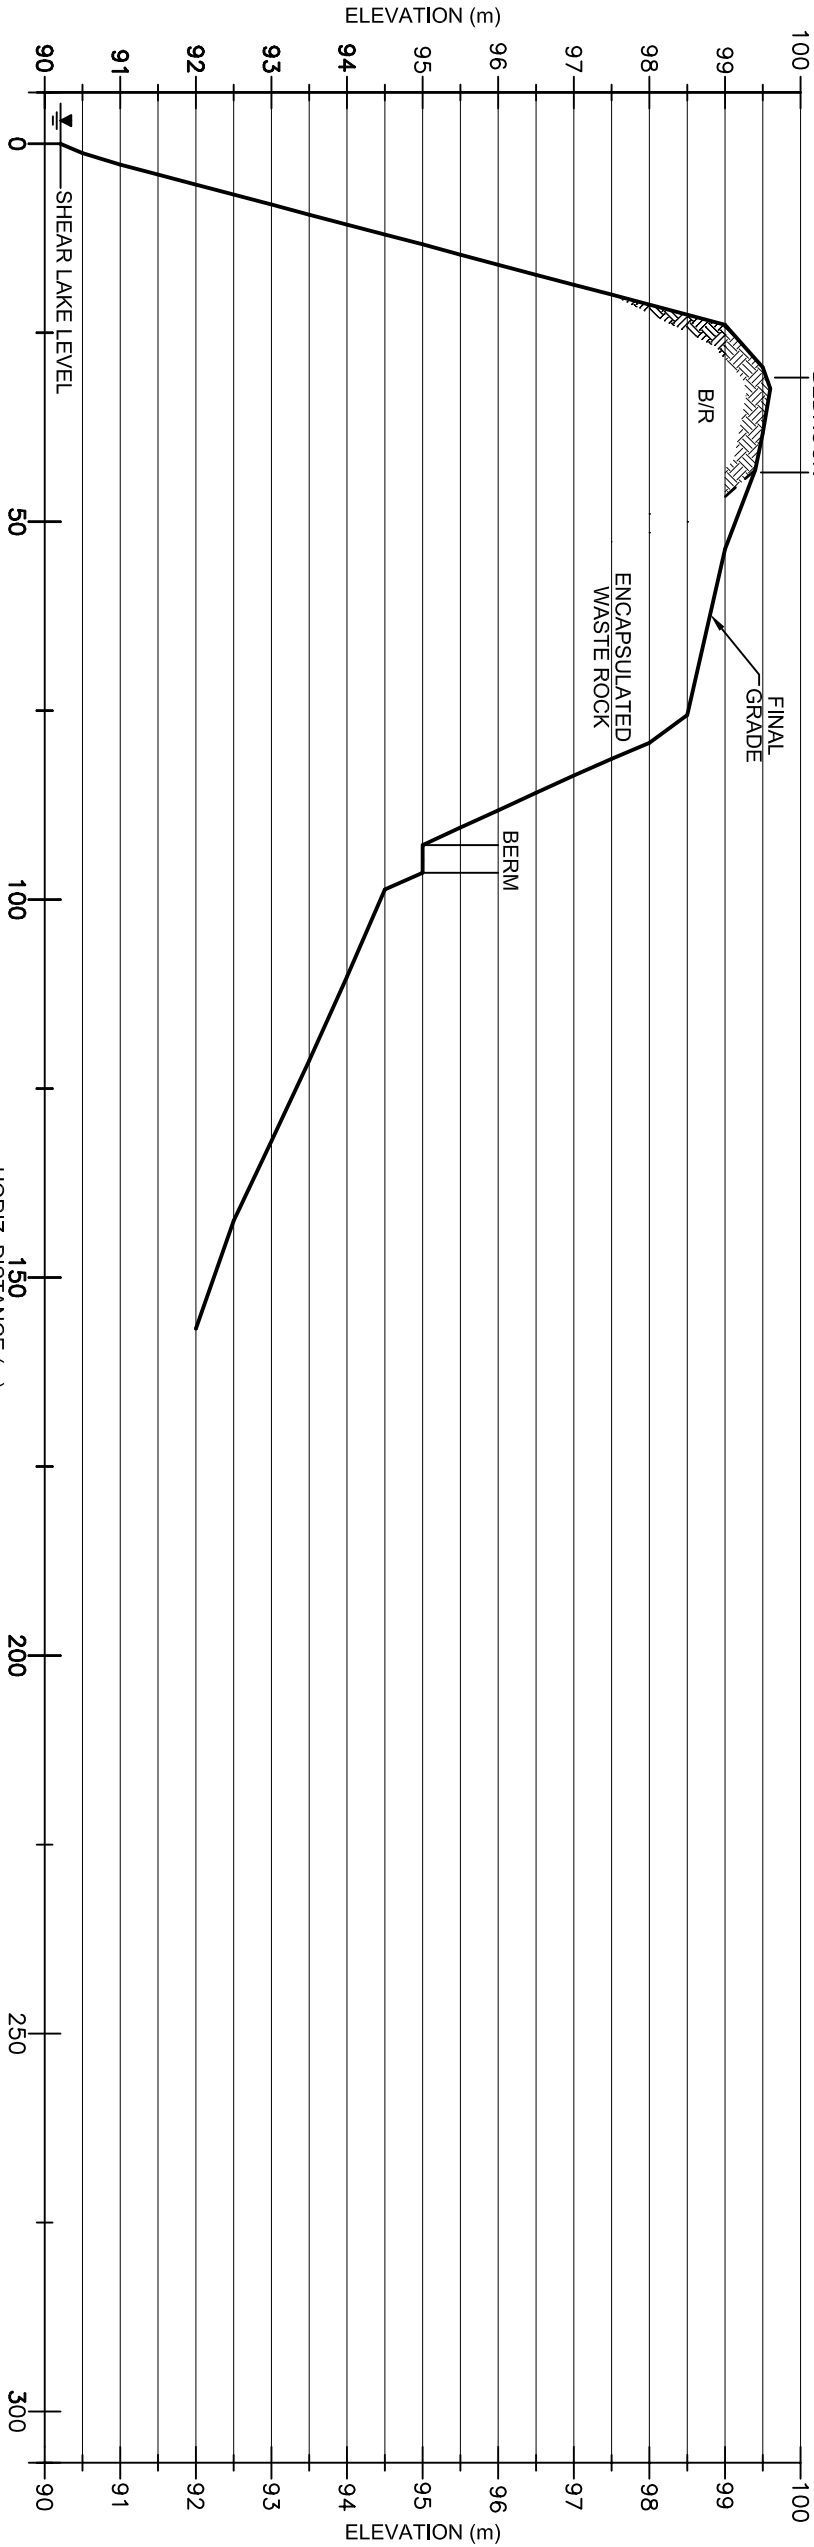

SECTION B-B



Trow Associates Inc.
Thunder Bay, Ontario

FIGURE
2

SECTIONS

Drainage Survey-Shear Lake Encapsulated Waste

Rock and Vicinity

Culliton Lake, NU

Barrick Gold Inc.

PROJECT NO.: F-90132-A/G

SCALE: 1:1000H/1:100V

DRAWN BY: DT

CHECKED BY: DG

DATE: NOV. 28, 2005