


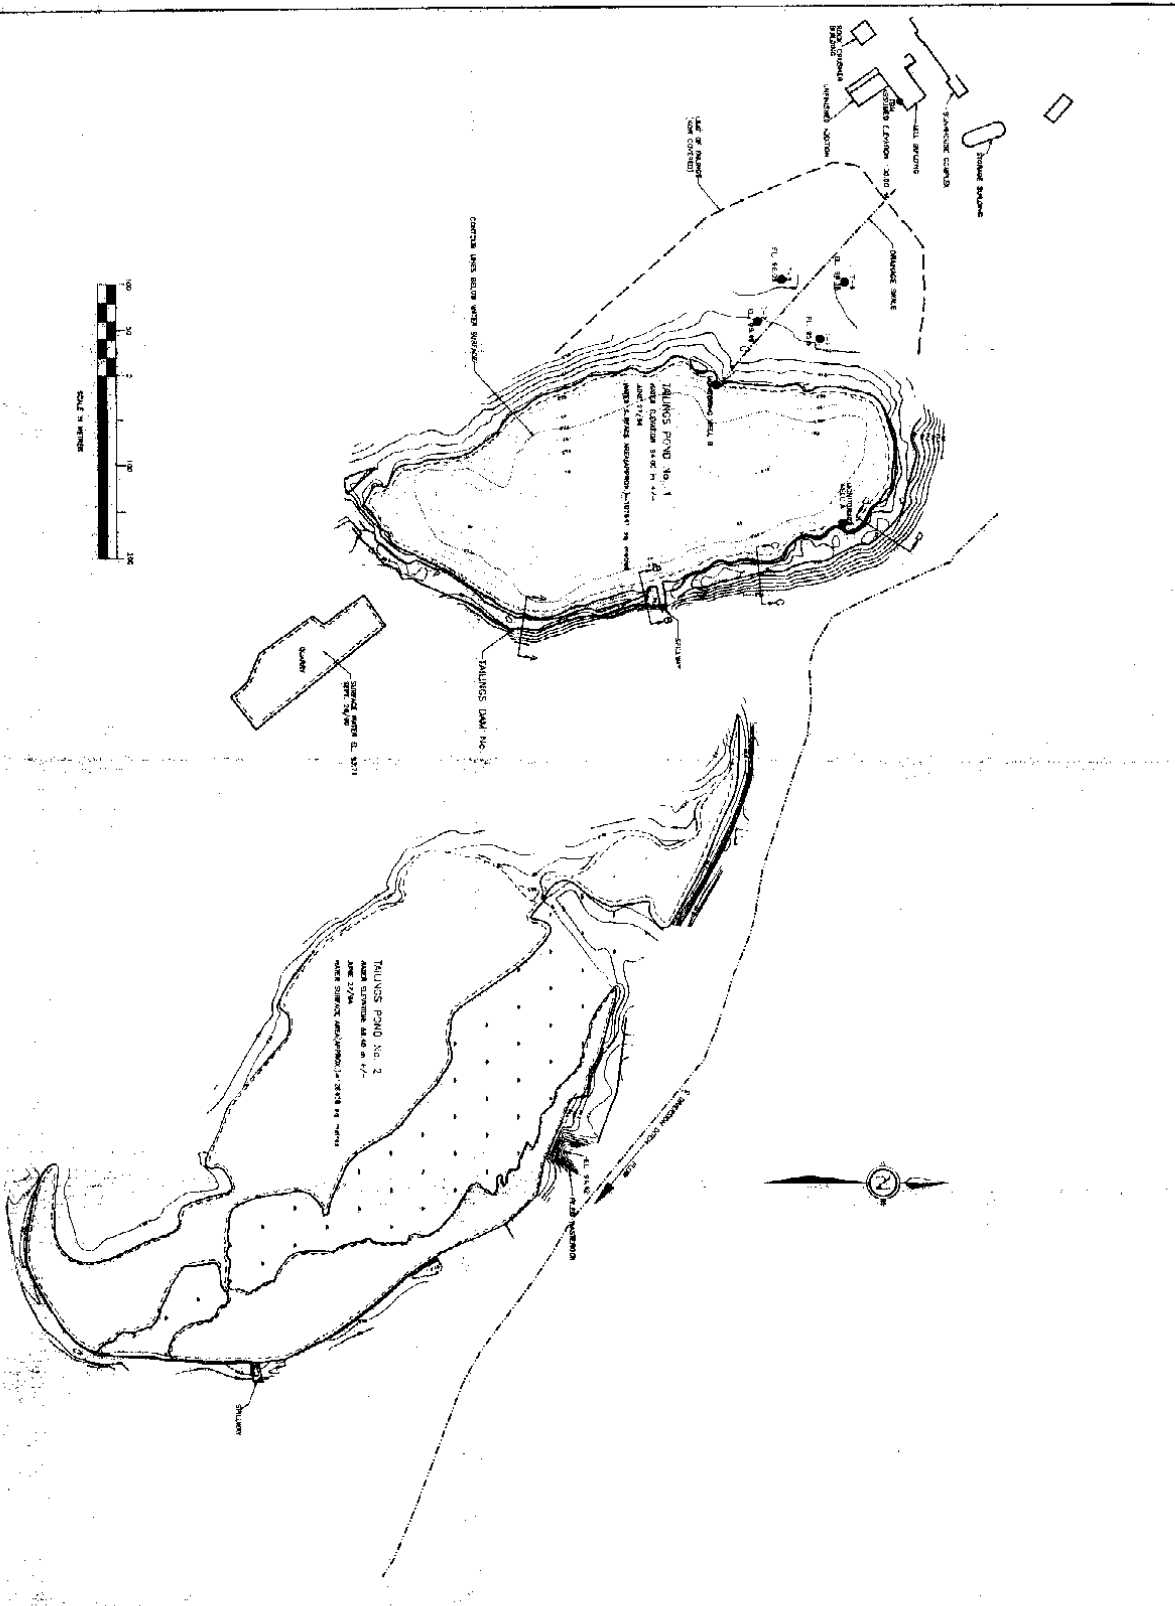

TROW CONSULTING ENGINEERS LTD.
Thunder Bay, Ontario, Canada

LEGEND

- MONITORING WELL
- BENCHMARK
- THERMISTERS

NOTES:

- DATA INTERPRETED FROM 1964 ENGINEERING SURVEY (22/24) AND SURVEY BY H.W. STOKES LTD./NOV. 10/1991
- BENCH MARK IS LOCATED ON CONCRETE BUILDING AT NORTH EAST CORNER OF MILL BUILDING ASSIGNED ELEVATION 100.00m
- ALL ELEVATIONS ARE SHOWN IN METRES

REVISIONS

NO.	DATE	REVISION




Project No. : Doc No. :
F-90132-4/5

Drawn By: PW/OT
Reviewed By: BK

Date: JANUARY 30, 1993

Scale: 1:2500