

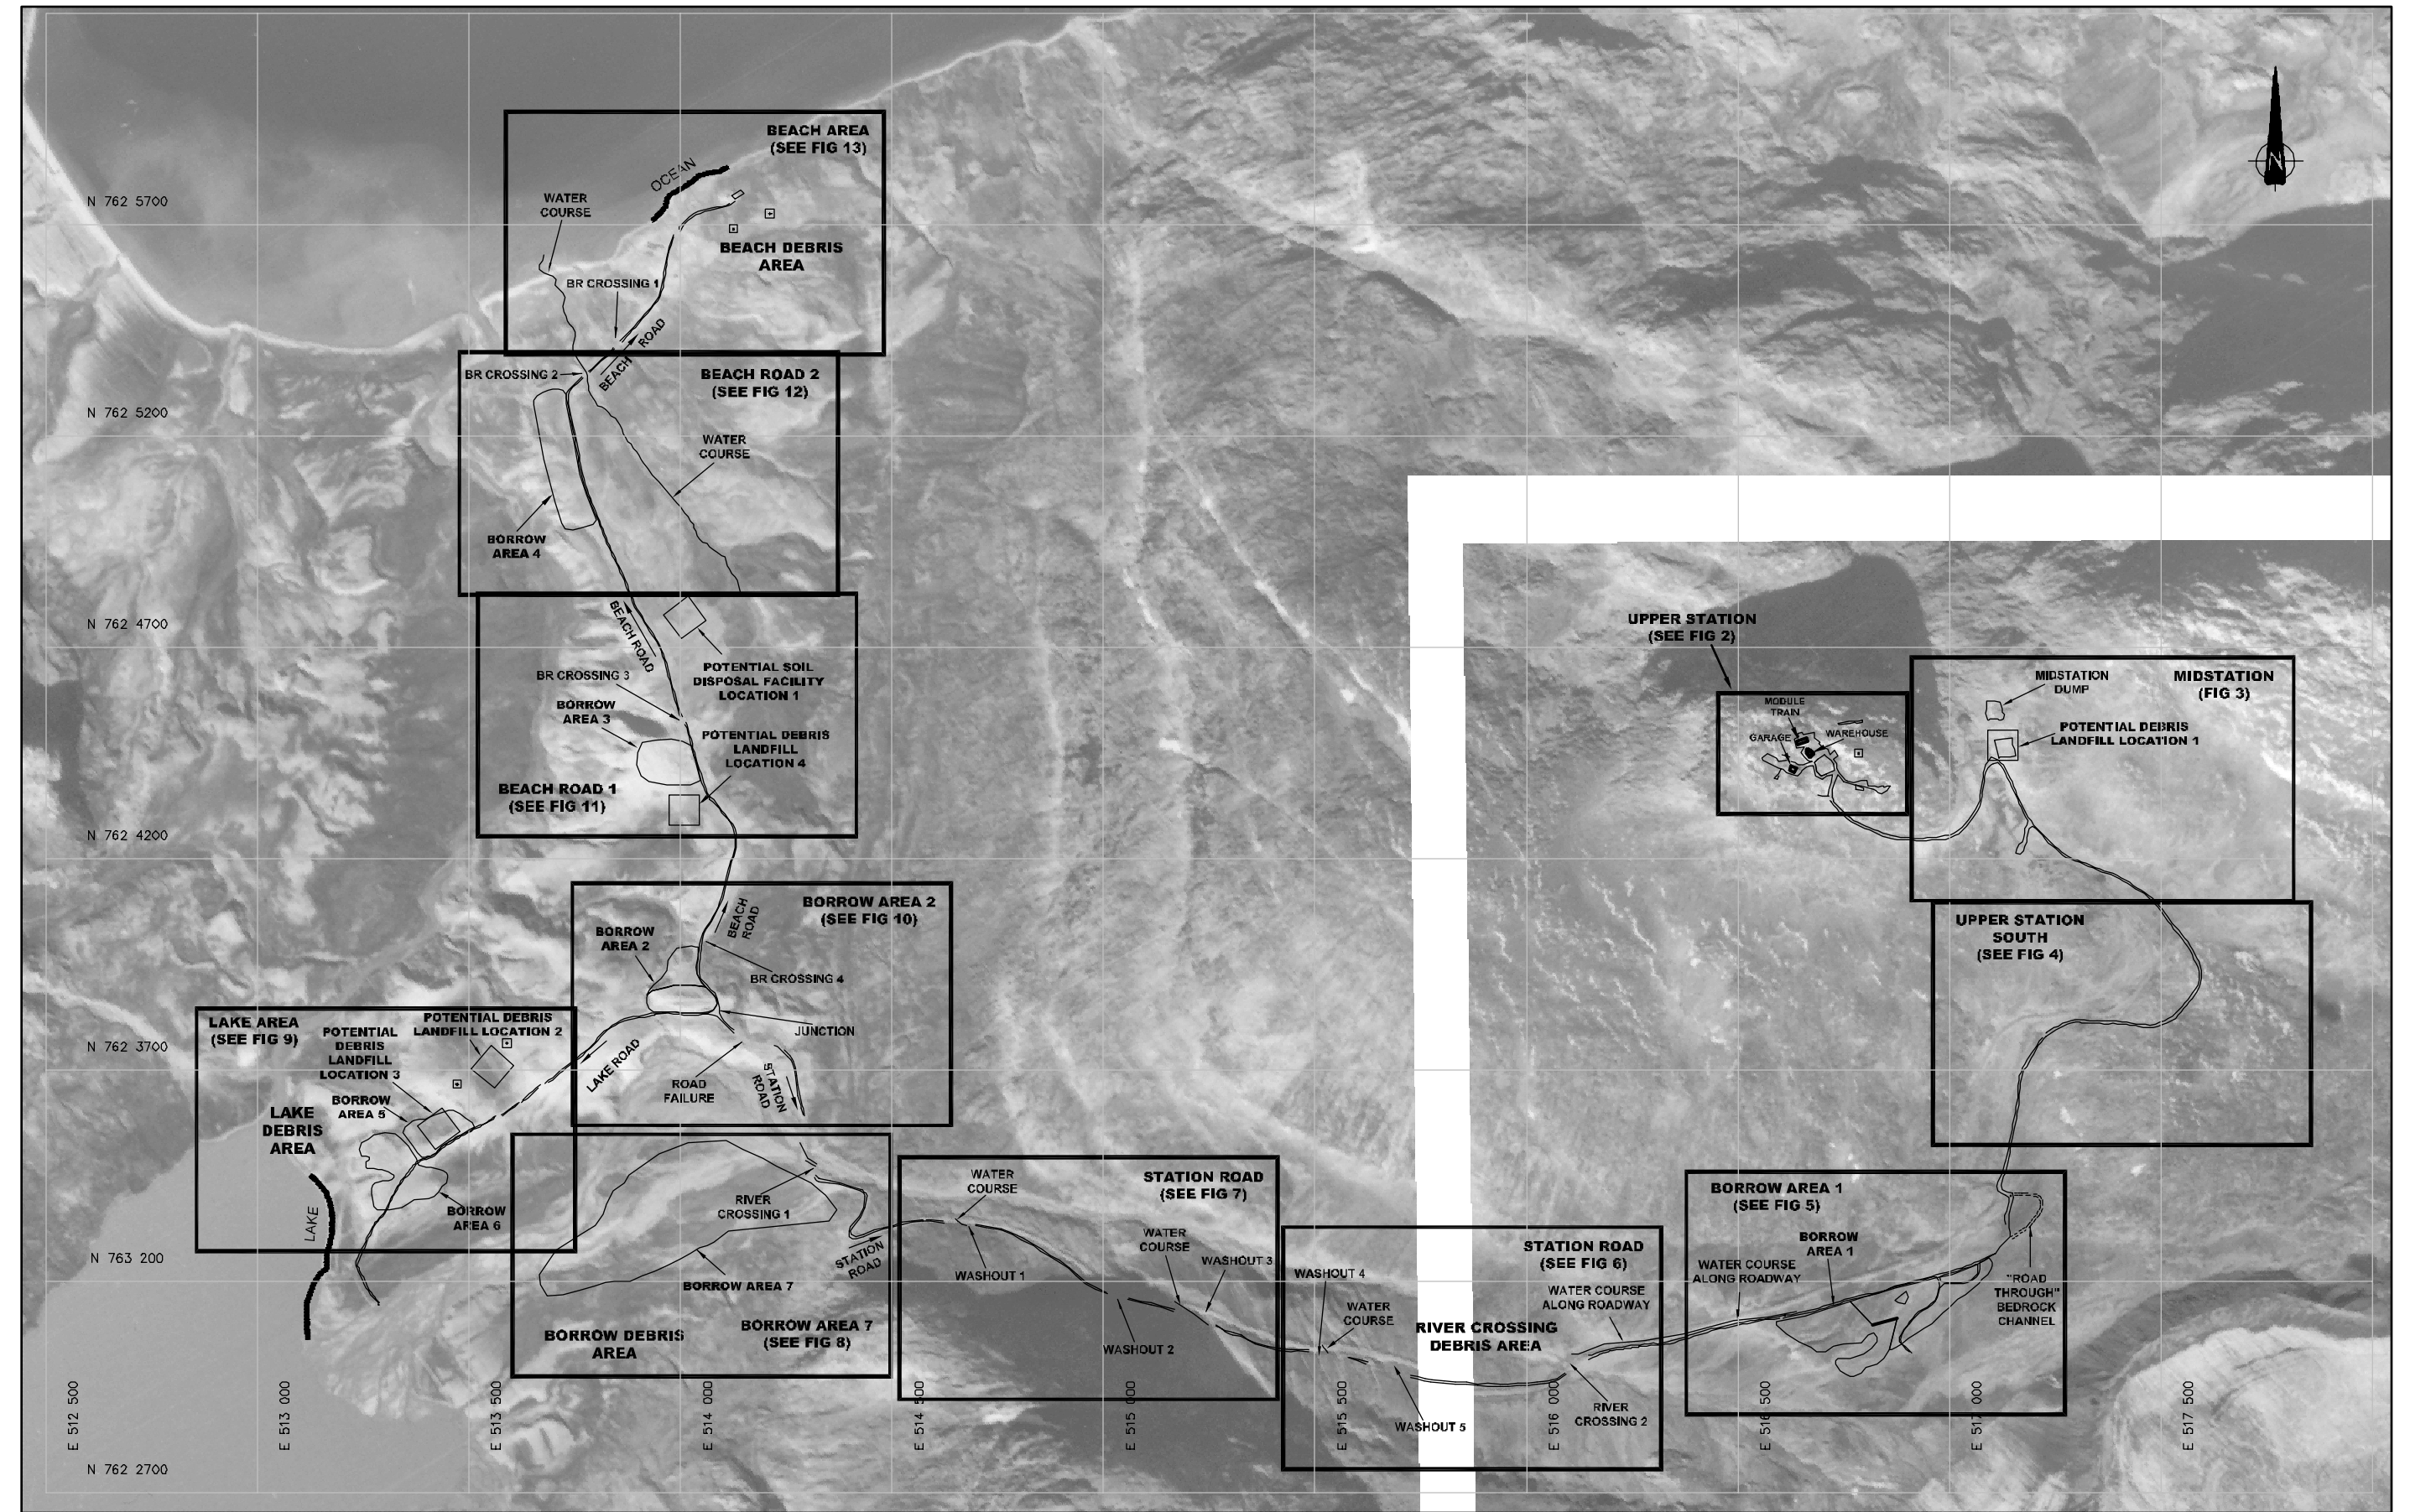


													
										DESIGNED BY: WTH/AB		PERMIT	
										DRAWN BY: DED		SEAL	
										DATE: 07/10/04			
										SCALE: AS SHOWN			
										PROJECT No.: 0101-04-1100065.DOT			
										ACAD FILENAME: 11000650010002.dwg			
												FOX-C EKALUGAD FJORD	
												OVERALL SITE PLAN	
												REVISION ISSUE	
												0	
												FIGURE	
												1	

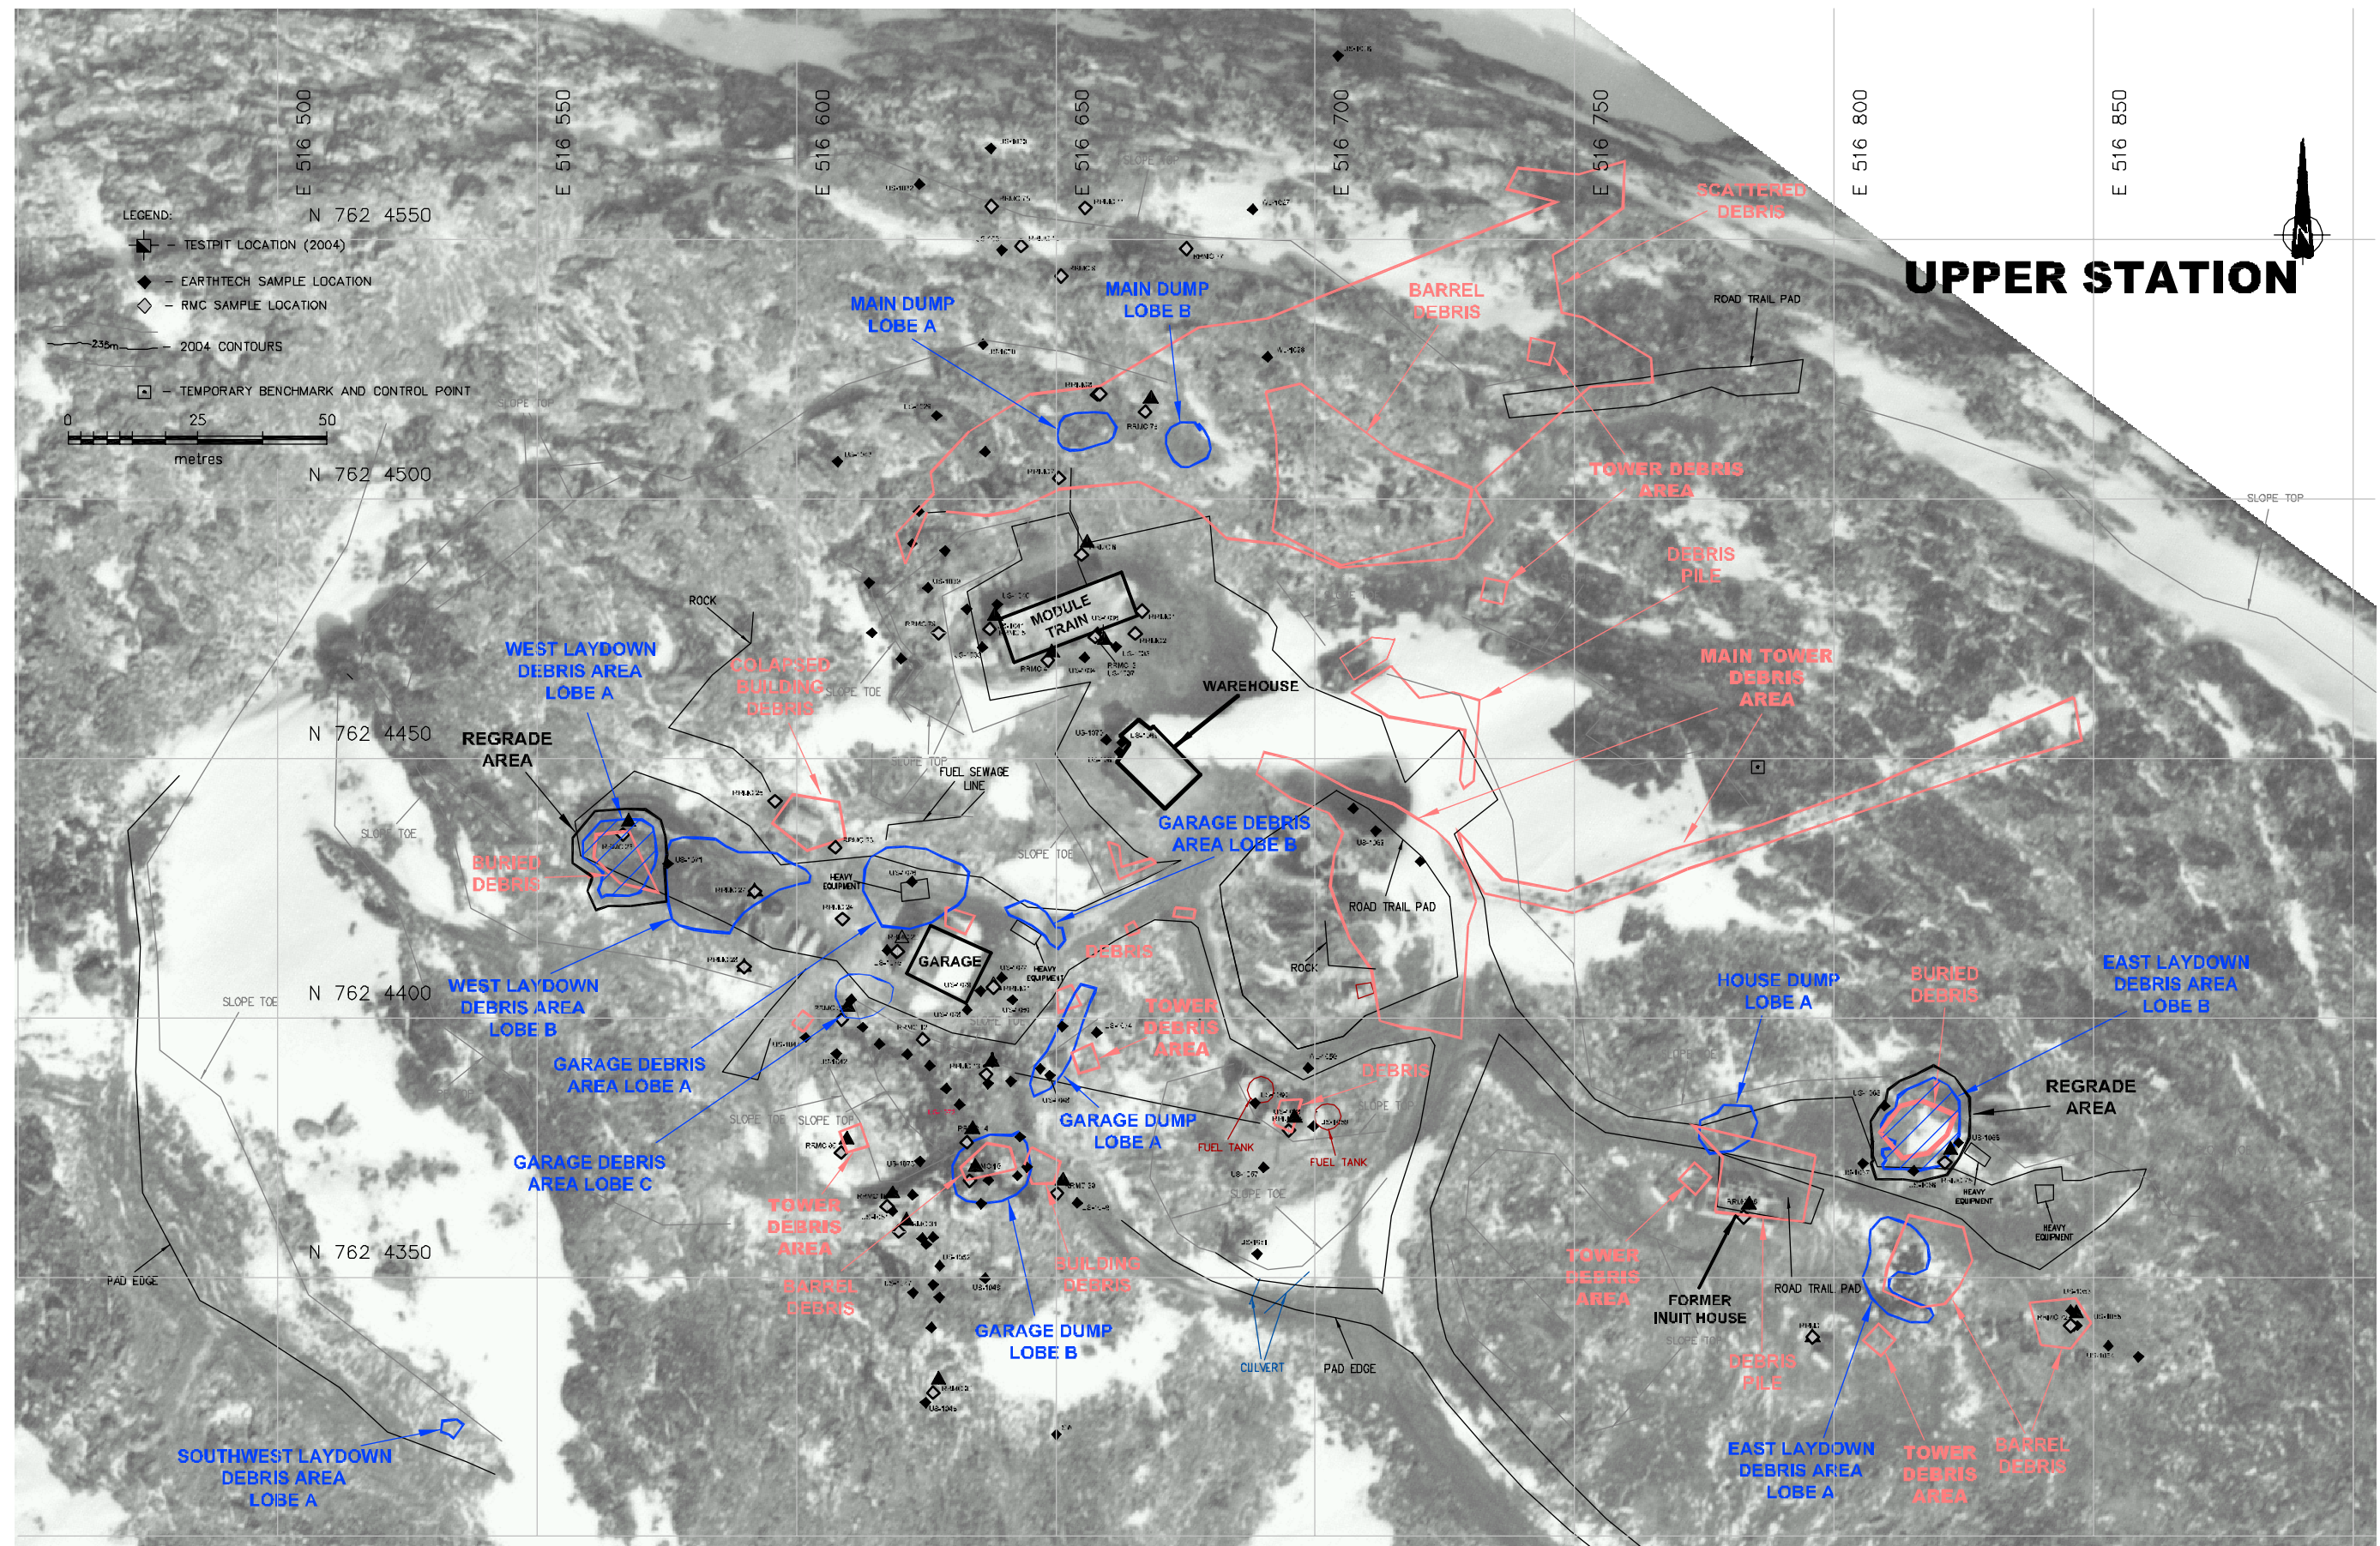

UPPER STATION


										 EBA Engineering Consultants Ltd.		 Public Works and Government Services Canada		Travaux publics et Services gouvernementaux Canada	
										DESIGNED BY: WTH/AB		PERMIT	SEAL	FDX-C EKALUGAD FJORD	
										DRAWN BY: DED				REVISION ISSUE	
										DATE: 07/10/04				0	
										SCALE: AS SHOWN					
										PROJECT No.: 0101-D4-1100065.DOT					
										ACAD FILENAME: 110006500100065.dwg					
														UPPER STATION	
														FIGURE	
														2A	

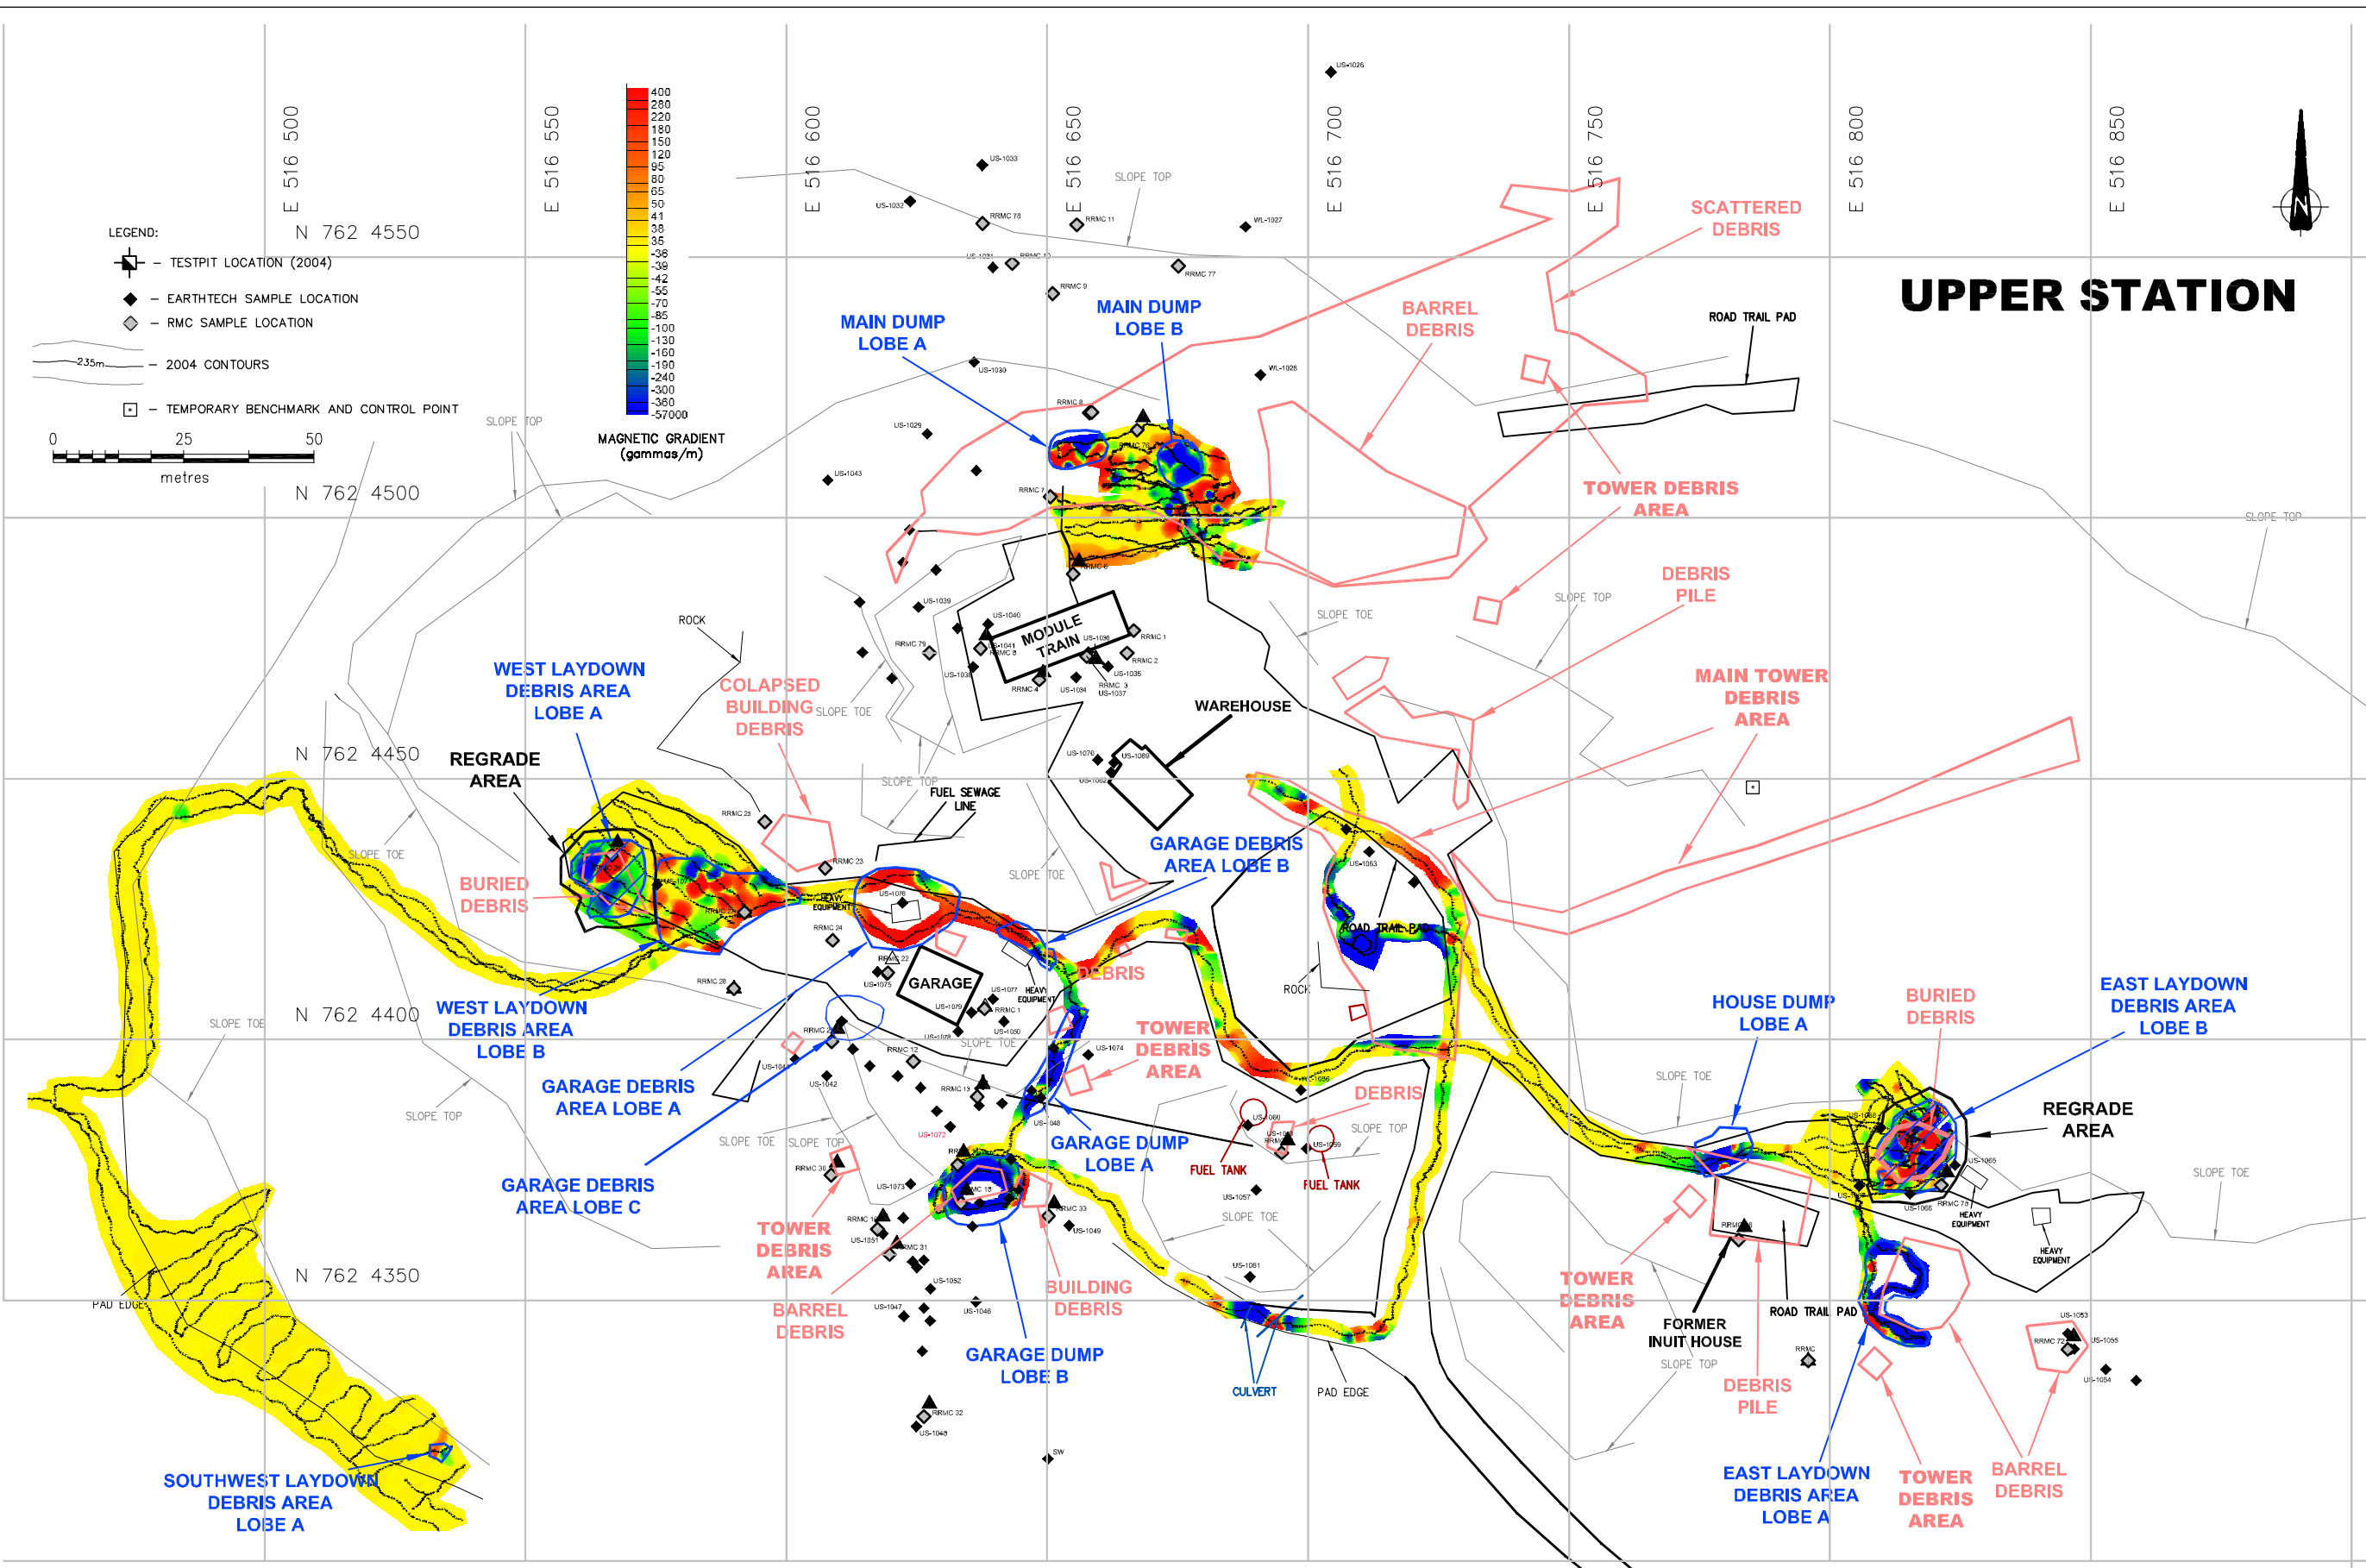

LEGEND:

- TESTPIT LOCATION (2004)
- EARTHTECH SAMPLE LOCATION
- RMC SAMPLE LOCATION
- 235m — 2004 CONTOURS
- TEMPORARY BENCHMARK AND CONTROL POINT

0 25 50 metres

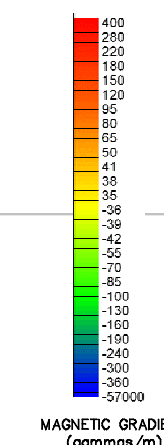


UPPER STATION

										 EBA Engineering Consultants Ltd.										 Public Works and Government Services Canada Travaux publics et Services gouvernementaux Canada	
										DESIGNED BY: <u>WH/AB</u>										PERMIT										SEAL										FOX-C EKALUGAD FJORD	
										DRAWN BY: <u>DBD</u>	
										DATE: <u>07/10/04</u>	
										SCALE: <u>AS SHOWN</u>	
										PROJECT No.: <u>0101-04-1100065.001</u>										UPPER STATION AREA 1 GRADIENT GEOPHYSICS	
										ACAD FILENAME: <u>1100065001Q04.dwg</u>	

EBA Engineering Consultants Ltd.

Public Works and Government Services Canada
Travaux publics et Services gouvernementaux Canada

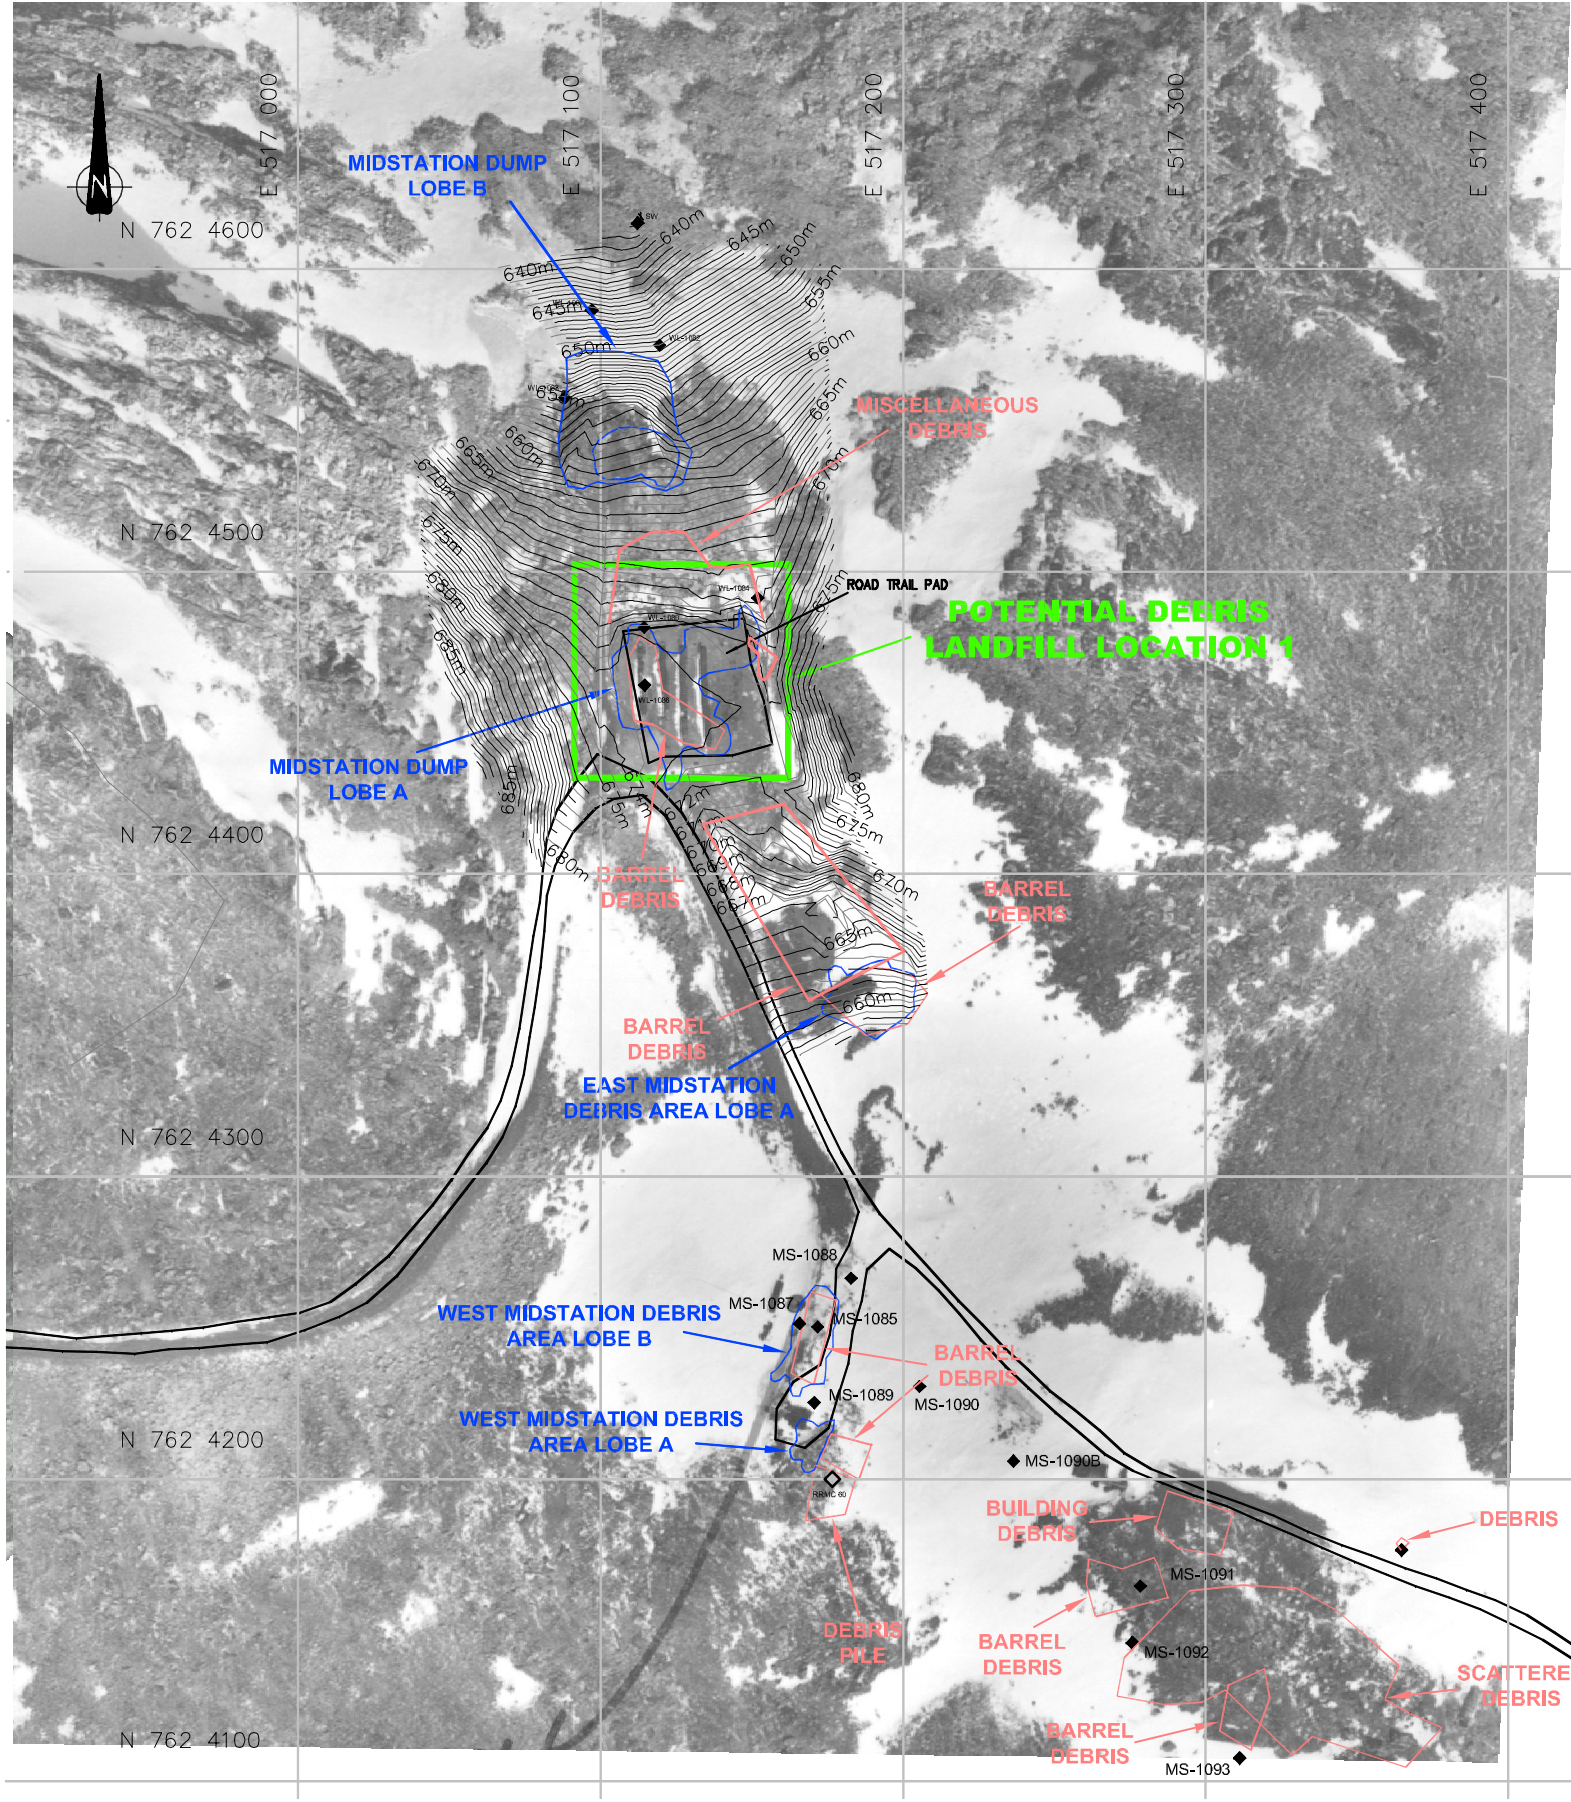

MIDSTATION

LEGEND:

- TESTPIT LOCATION (2004)
- EARTHTECH SAMPLE LOCATION
- RMC SAMPLE LOCATION
- 2004 CONTOURS
- TEMPORARY BENCHMARK AND CONTROL POINT

0 25 50 75 100 metres

										 EBA Engineering Consultants Ltd.			 Public Works and Government Services Canada Travaux publics et Services gouvernementaux Canada						
										DESIGNED BY: <u>WTH/AB</u>		PERMIT		SEAL		FOX-C EKALUGAD FJORD			
										DRAWN BY: <u>DBD</u>								REVISION ISSUE	
										DATE: <u>07/10/04</u>						0			
										SCALE: <u>AS SHOWN</u>						FIGURE			
										PROJECT No.: <u>0101-04-1100065.001</u>						3A			
										ACAD FILENAME: <u>1100065001003d.dwg</u>									
DRAWING No.		DRAWING TITLE			DATE	REV	No.	DESCRIPTION		DATE	APPROVED								
		REFERENCE DRAWINGS					REVISION												



E 517 000

E 517 100

E 517 200

E 517 300

E 517 400

E 517 500

E 517 600

E 517 700

E 517 800

N 762 4600

N 762 4500

N 762 4400

N 762 4300

N 762 4200

N 762 4100

MIDSTATION DUMP
LOBE B

MISCELLANEOUS
DEBRIS

POTENTIAL DEBRIS
LANDFILL LOCATION 1

MIDSTATION DUMP
LOBE A

BARREL
DEBRIS

BARREL
DEBRIS

EAST MIDSTATION
DEBRIS AREA LOBE A

WEST MIDSTATION DEBRIS
AREA LOBE B

WEST MIDSTATION DEBRIS
AREA LOBE A

MS-1088

MS-1087

MS-1085

MS-1089

MS-1090

MS-1090B

BUILDING
DEBRIS

MS-1091

BARREL
DEBRIS

MS-1092

BARREL
DEBRIS


MS-1093

DEBRIS

DEBRIS PILE

BARREL
DEBRIS


SCATTERED
DEBRIS

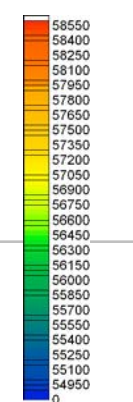

TOTAL MAGNETIC FIELD
(gammas)

LEGEND:

- TESTPIT LOCATION (2004)
- EARTHTECH SAMPLE LOCATION
- RMC SAMPLE LOCATION
- 2004 CONTOURS
- TEMPORARY BENCHMARK AND CONTROL POINT

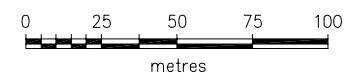

MIDSTATION

DESIGNED BY: WTH/AB										PERMIT		SEAL		FOX-C EKALUGAD FJORD	
DRAWN BY: DBD														REVISION 0	
DATE: 07/10/04														FIGURE 3D	
SCALE: AS SHOWN															
PROJECT No.: 0101-04-1100065.001															
ACAD FILENAME: 11000650010206.dwg															
ISSUED FOR REVIEW										29/10/04		WTH			
DRAWING No.										DATE		REV		No.	
REFERENCE DRAWINGS															
REVISION															



N 762 4000

N 762 3900

N 762 3800

N 762 3700

E 517 000

N 762 3600

E 517 100

E 517 200

E 517 300

E 517 400




E 517 500

E 517 600


E 517 700

E 517 800

UPPER STATION SOUTH

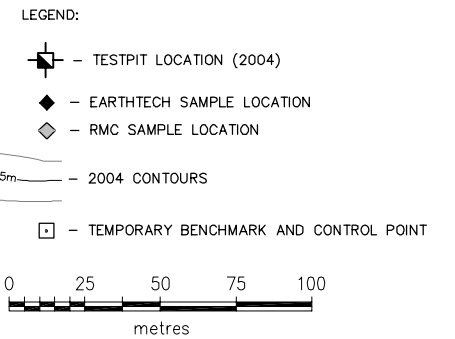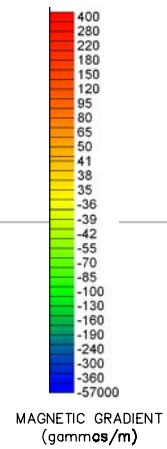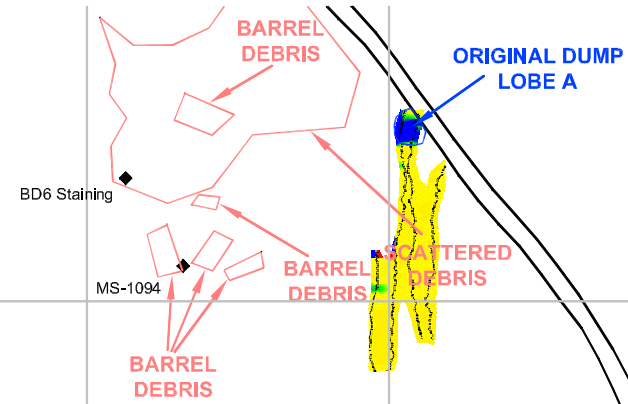

DESIGNED BY: WTH/AB										PERMIT		SEAL	
DRAWN BY: DBD													
DATE: 07/10/04													
SCALE: AS SHOWN													
PROJECT No.: 0101-04-1100065.001													
ACAD FILENAME: 11000650010204.dwg													
ISSUED FOR REVIEW										29/10/04		WTH	

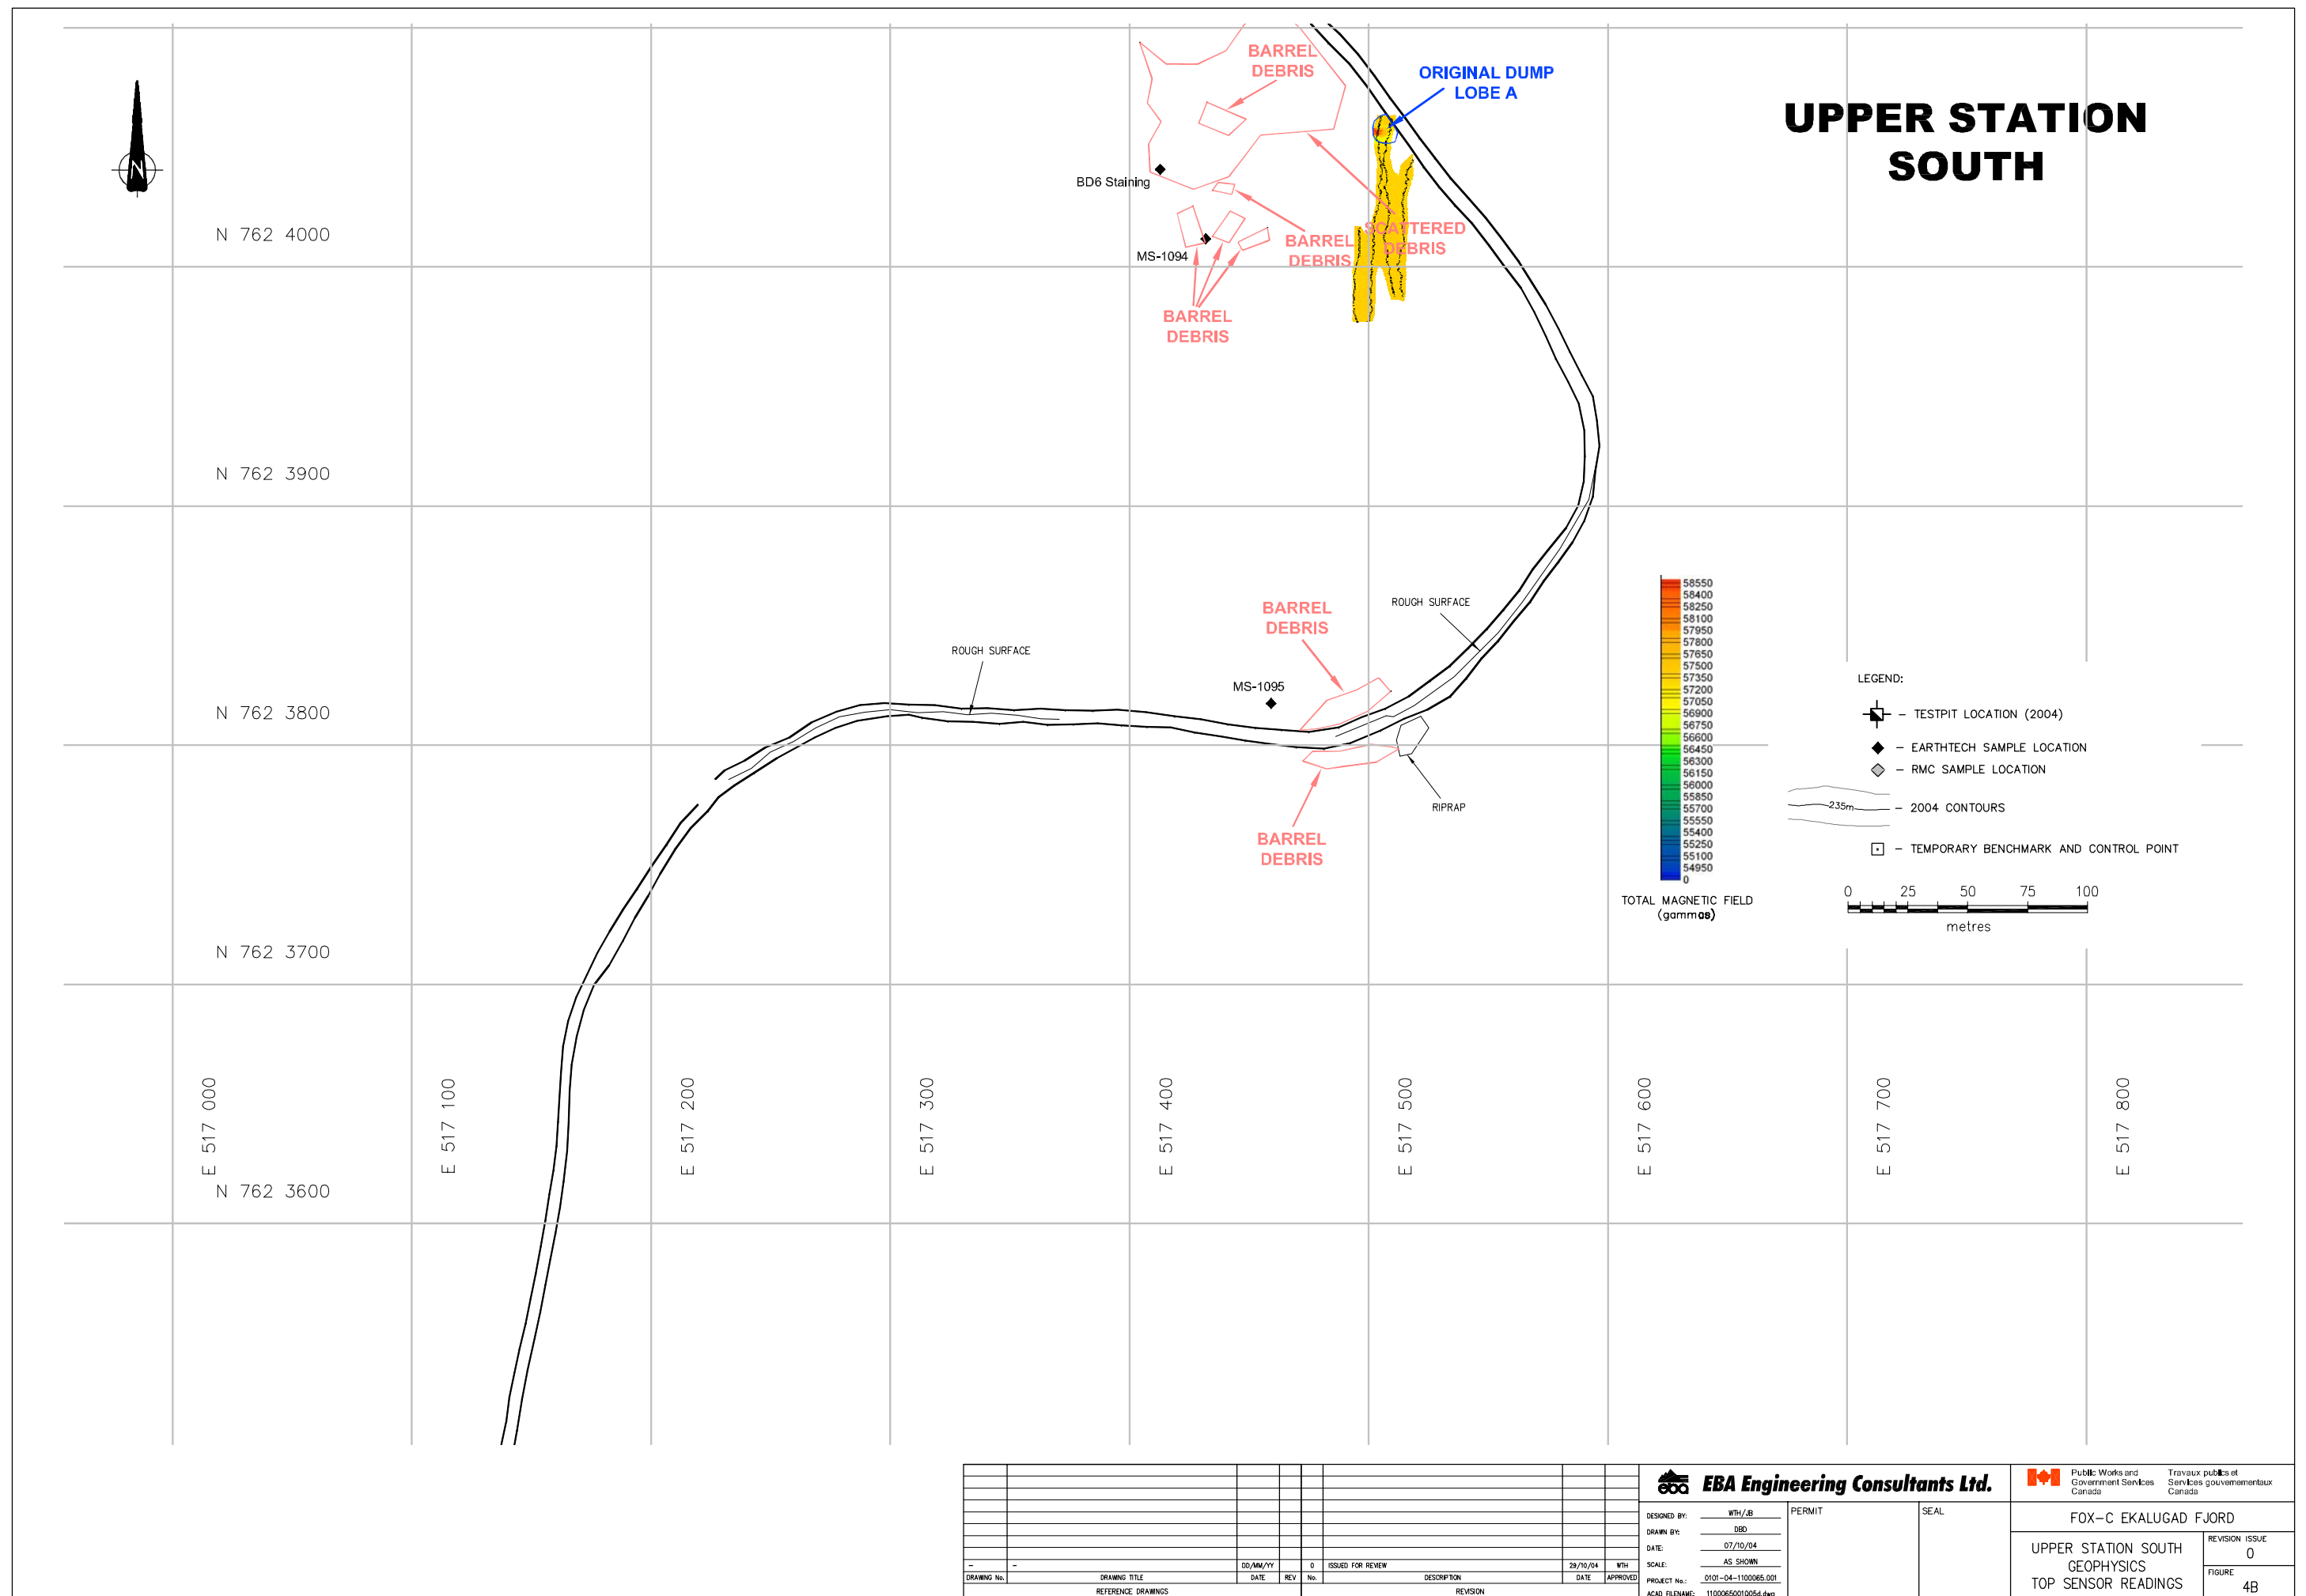



N 762 4000

N 762 3900

N 762 3800

N 762 3700

E 517 000

N 762 3600

E 517 100

E 517 200

E 517 300

E 517 400

E 517 500

E 517 600

E 517 700

E 517 800

BD6 Staining

MS-1094

BARREL
DEBRIS

BARREL
DEBRIS

MS-1095

BARREL
DEBRIS

ROUGH SURFACE


ROUGH SURFACE

RIPRAP

ORIGINAL DUMP
LOBE A


BARREL
DEBRIS

UPPER STATION SOUTH

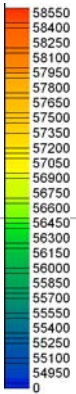


TOTAL MAGNETIC FIELD
(gamma)

- LEGEND:
- TESTPIT LOCATION (2004)
 - EARTHTECH SAMPLE LOCATION
 - RMC SAMPLE LOCATION
 - 2004 CONTOURS
 - TEMPORARY BENCHMARK AND CONTROL POINT

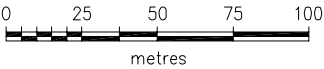

EBA Engineering Consultants Ltd.										Public Works and Government Services Canada Travaux publics et Services gouvernementaux Canada	
DESIGNED BY: WTH/AB DRAWN BY: DBD DATE: 07/10/04 SCALE: AS SHOWN PROJECT No.: 0101-04-1100065.001 ACAD FILENAME: 11000650010206.dwg										PERMIT	SEAL
FOX-C EKALUGAD FJORD										REVISION ISSUE	
UPPER STATION SOUTH GEOPHYSICS										0	
BOTTOM SENSOR READINGS										FIGURE 4C	

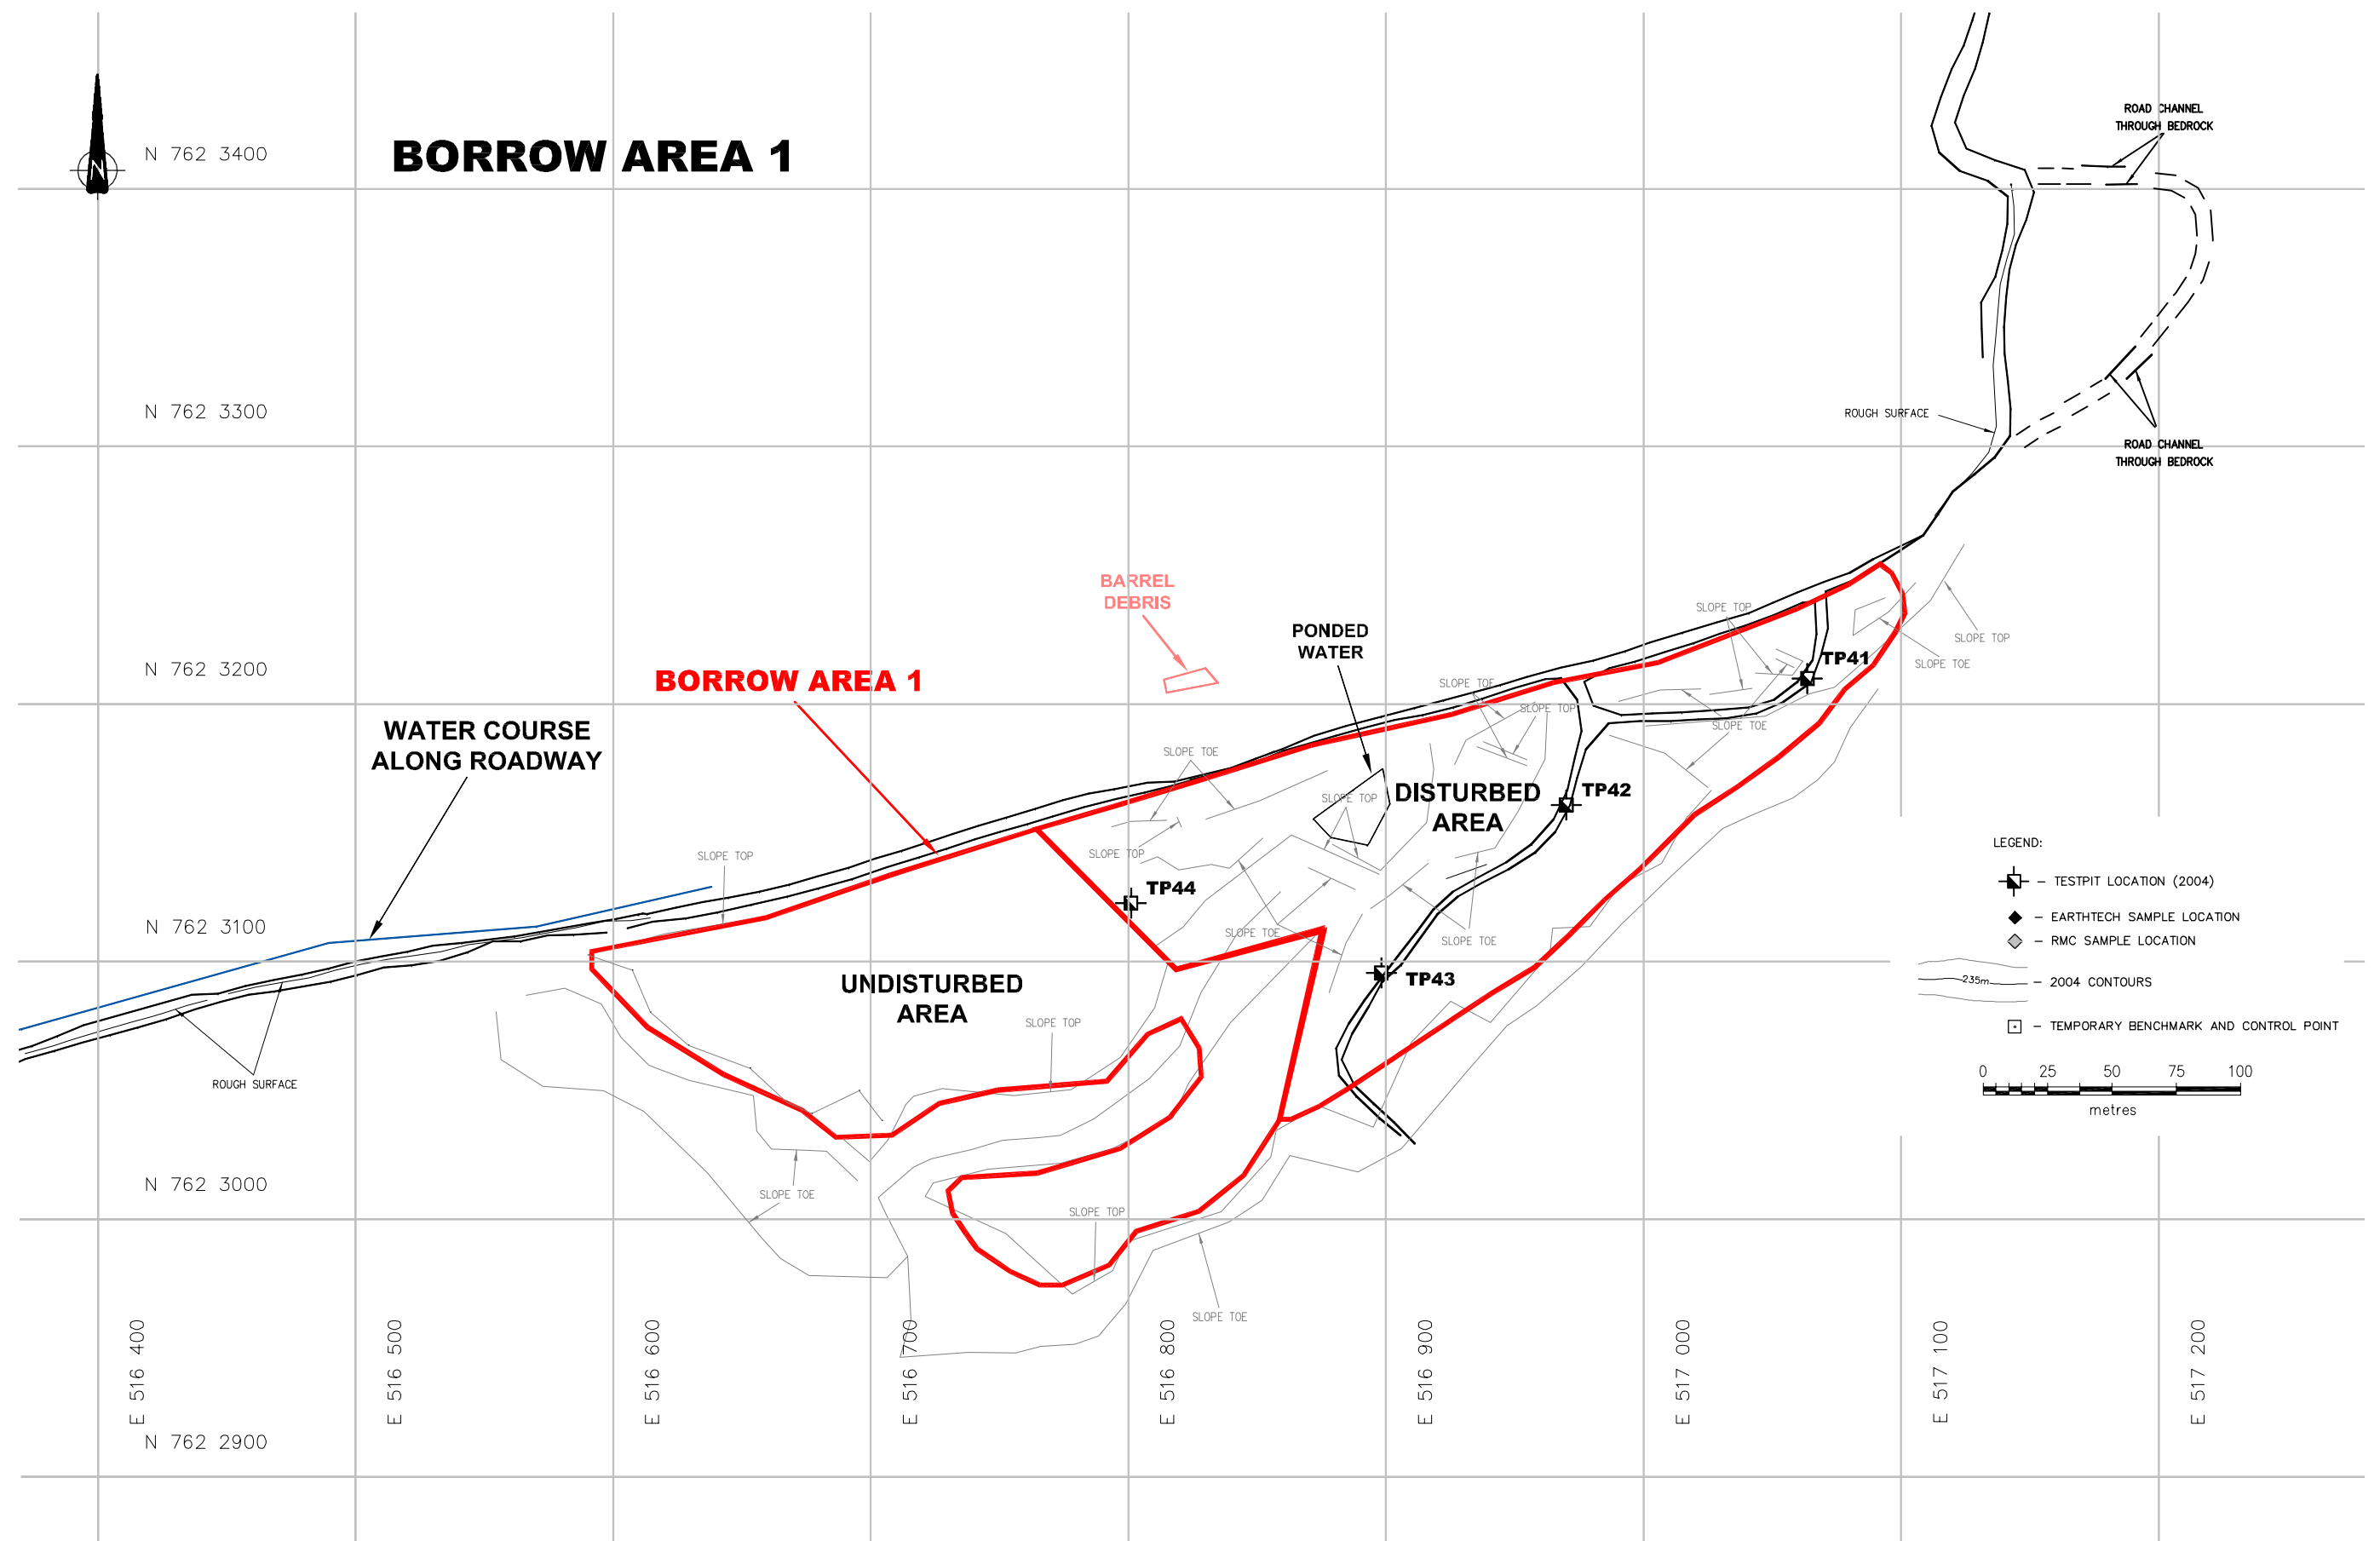

--	--	






N 762 3300

N 762 3200

STATION ROAD

- LEGEND:
- TESTPIT LOCATION (2004)
 - EARTHTECH SAMPLE LOCATION
 - RMC SAMPLE LOCATION
 - 2004 CONTOURS
 - TEMPORARY BENCHMARK AND CONTROL POINT

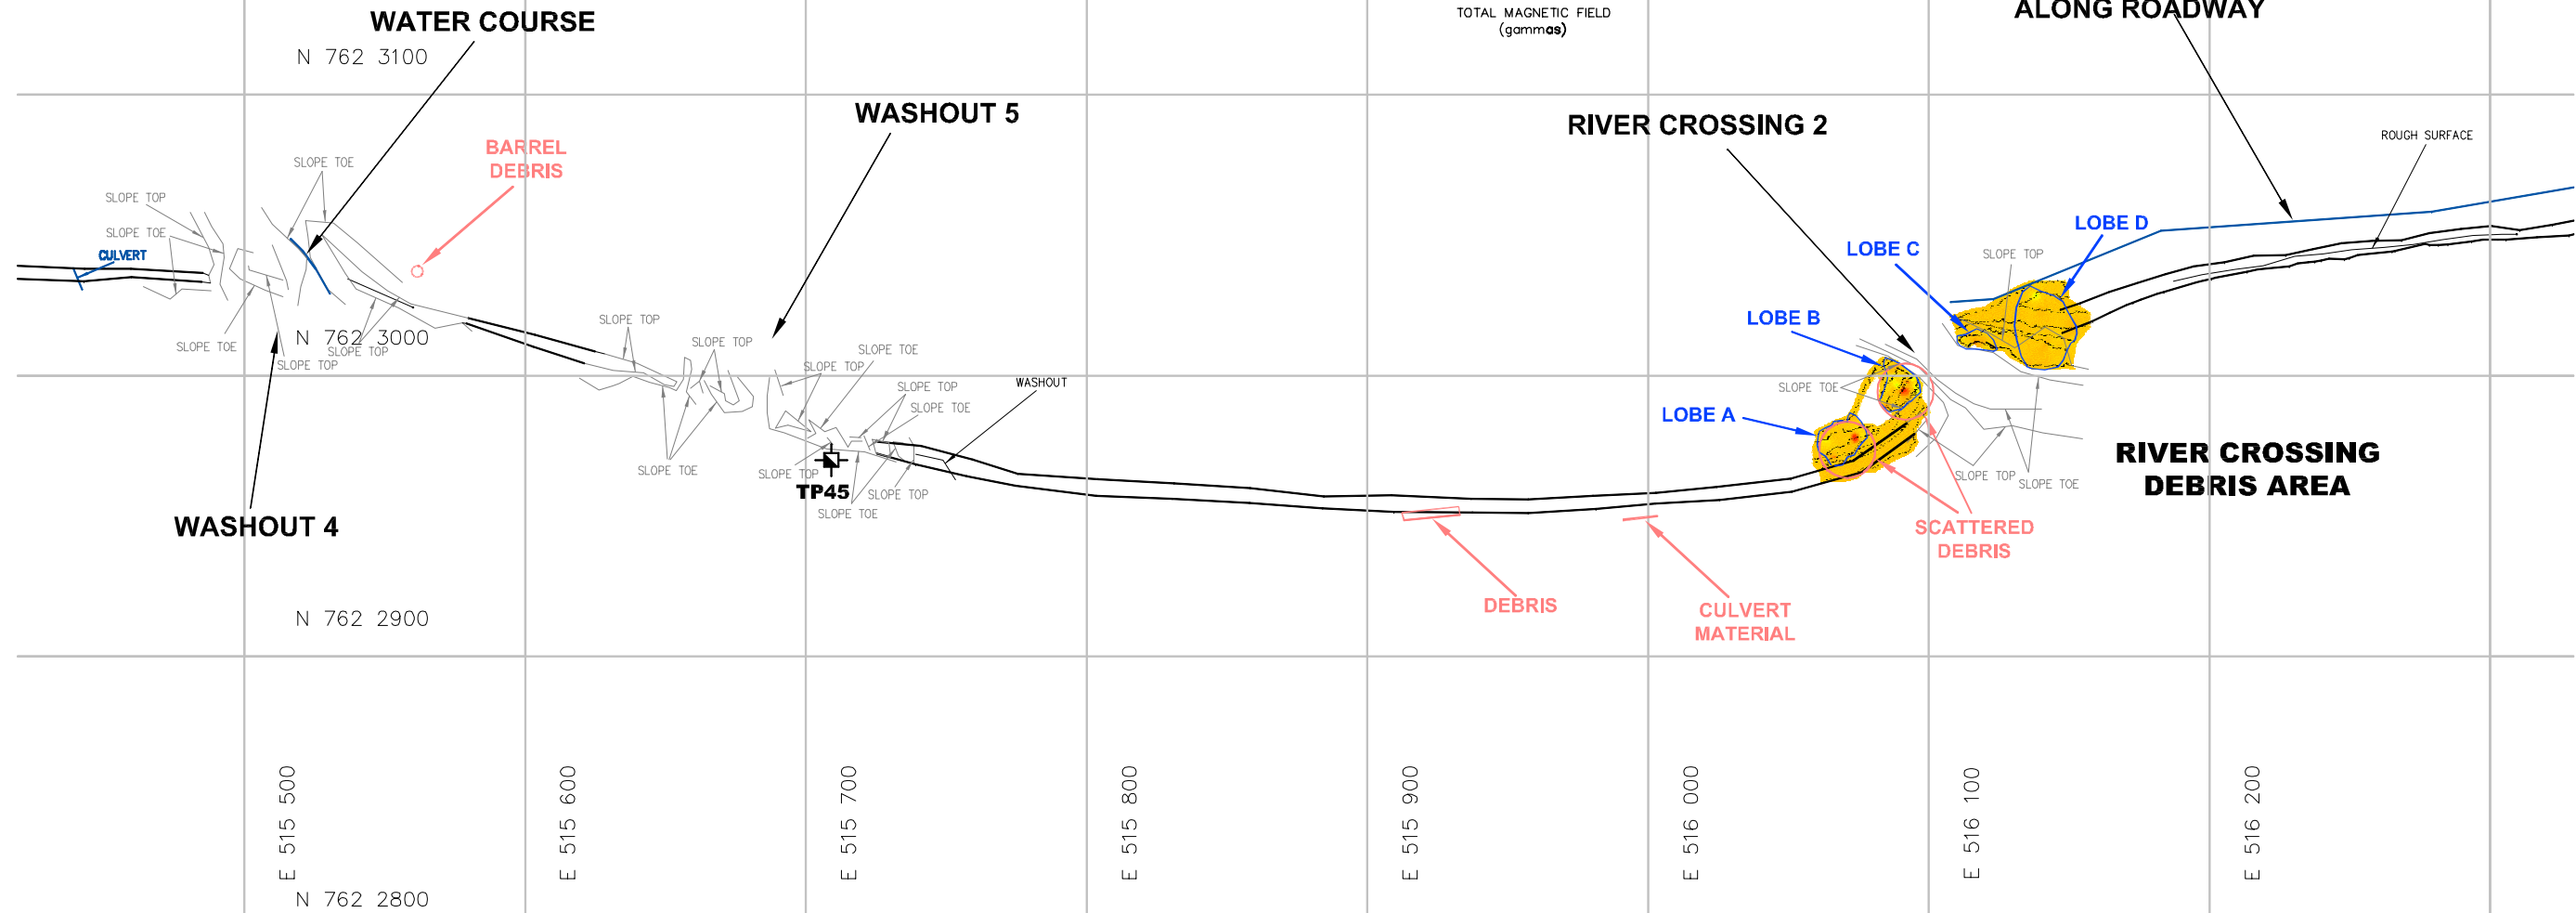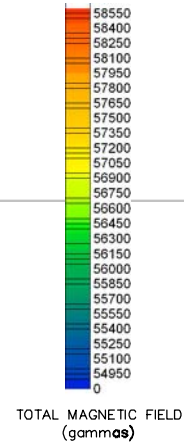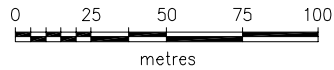

														Travaux publics et Services gouvernementaux Canada	
										EBA Engineering Consultants Ltd.				FOX-C EKALUGAD FJORD	
										DESIGNED BY: WTH/AB		PERMIT		SEAL	
										DRAWN BY: DBD					
										DATE: 07/10/04					
										SCALE: AS SHOWN					
										PROJECT No.: 0101-04-1100065.001					
										ACAD FILENAME: 1100065001Q05d.dwg					






N 762 3300

N 762 3200

STATION ROAD


- LEGEND:
- TESTPIT LOCATION (2004)
 - EARTHTECH SAMPLE LOCATION
 - RMC SAMPLE LOCATION
 - 2004 CONTOURS
 - TEMPORARY BENCHMARK AND CONTROL POINT

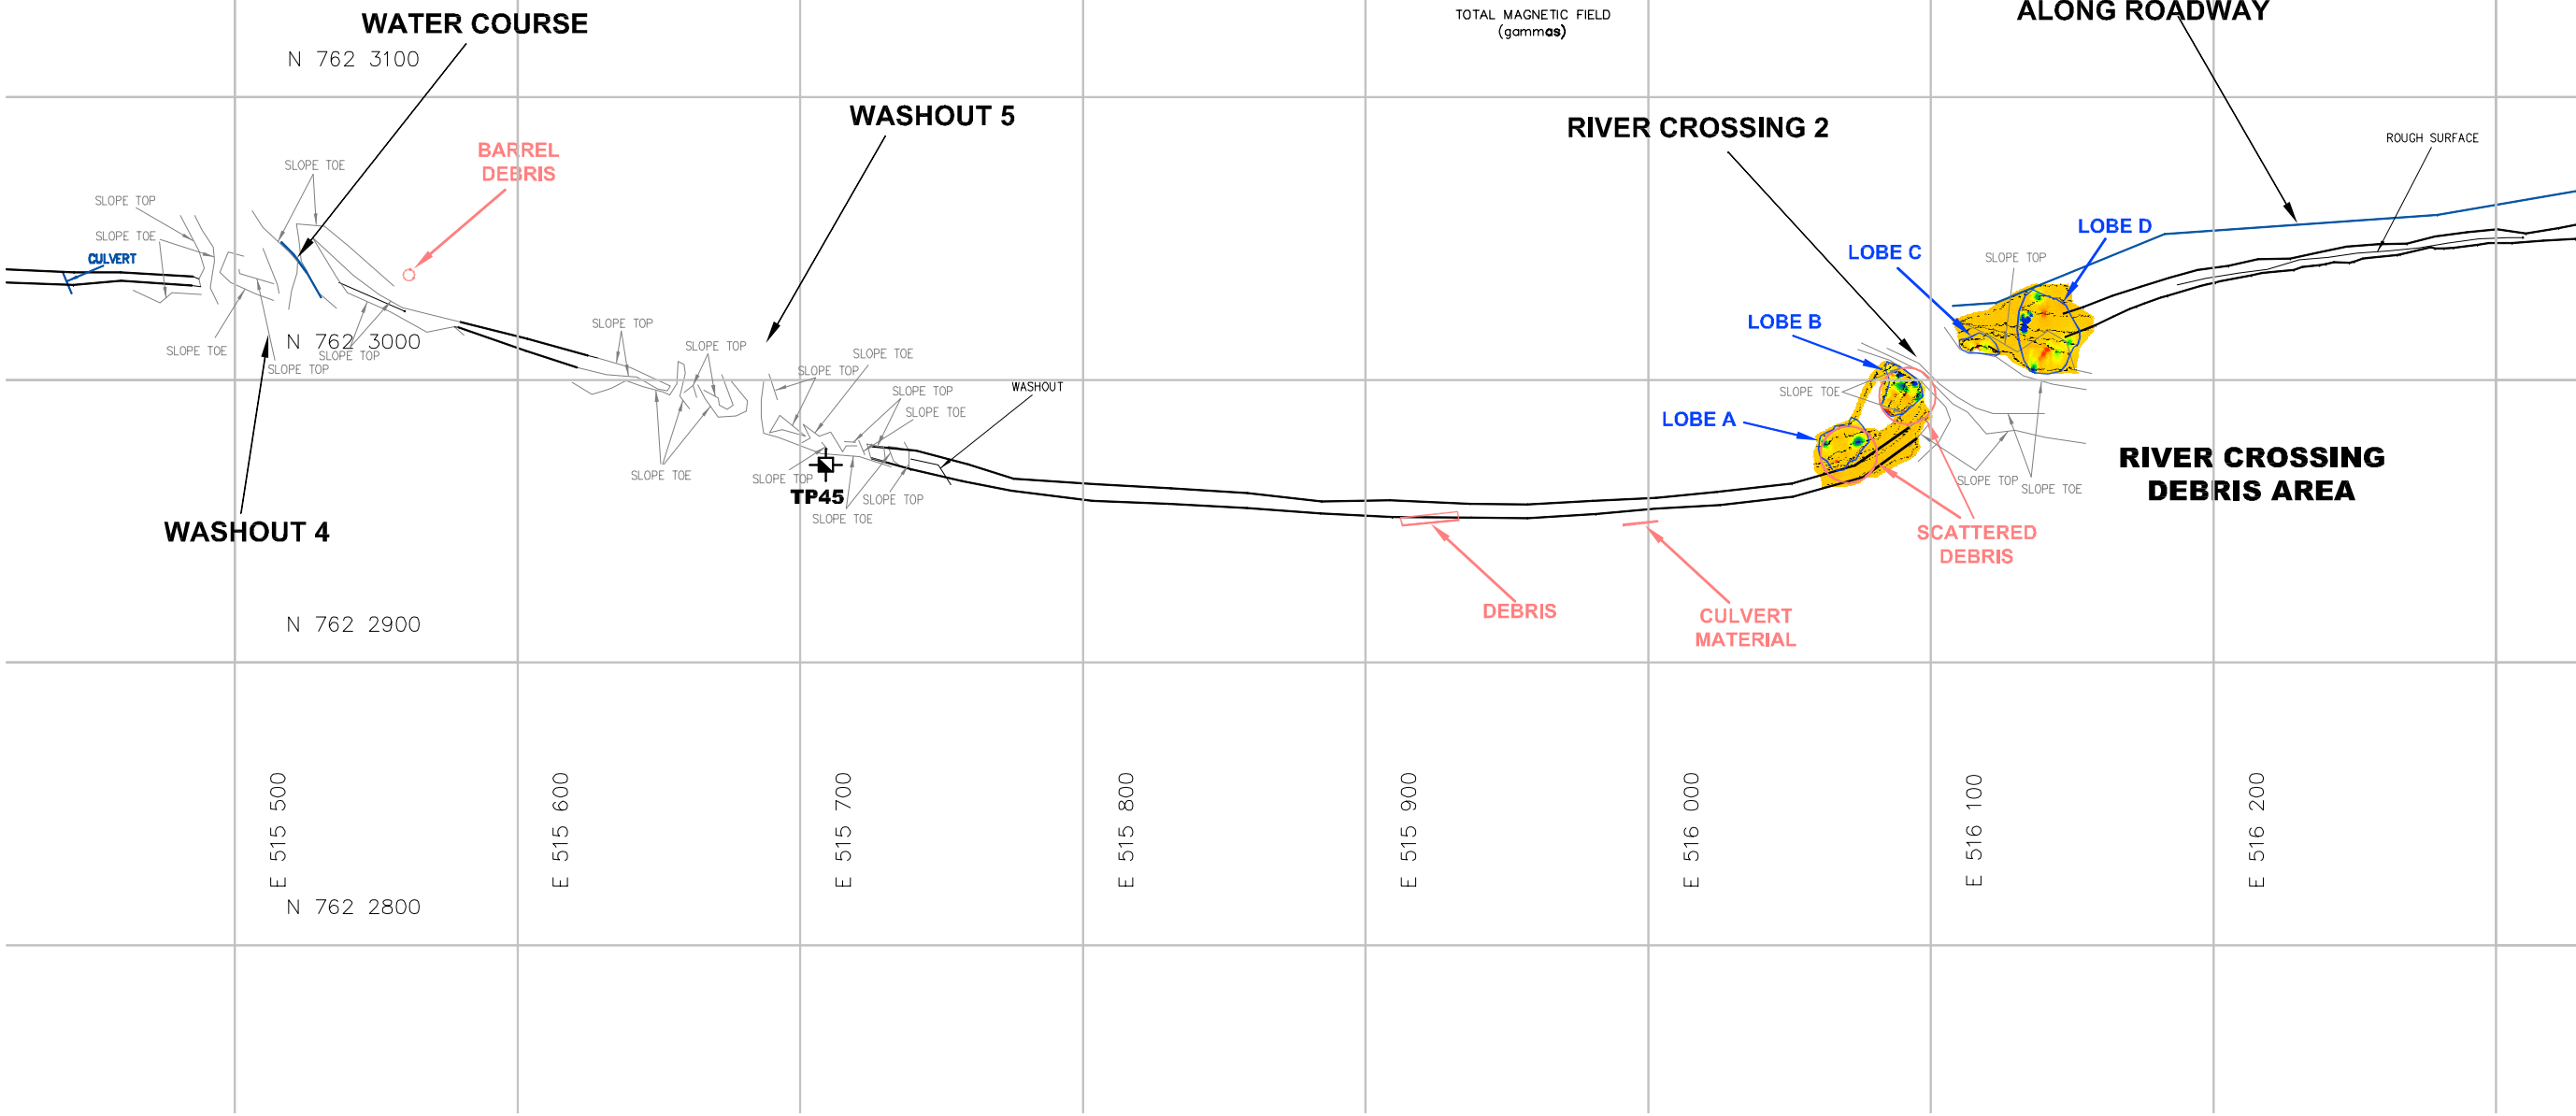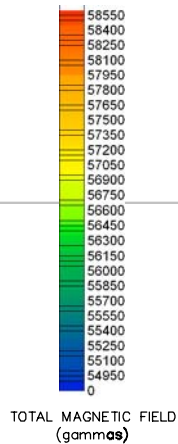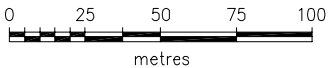


DESIGNED BY: WTH/AB										PERMIT		SEAL	
DRAWN BY: DBD													
DATE: 07/10/04													
SCALE: AS SHOWN													
PROJECT No.: 0101-04-1100065.001													
ACAD FILENAME: 11000650010206.dwg													
STATION ROAD 1 GEOPHYSICS BOTTOM SENSOR READINGS										REVISION 0		FIGURE 6C	




STATION ROAD

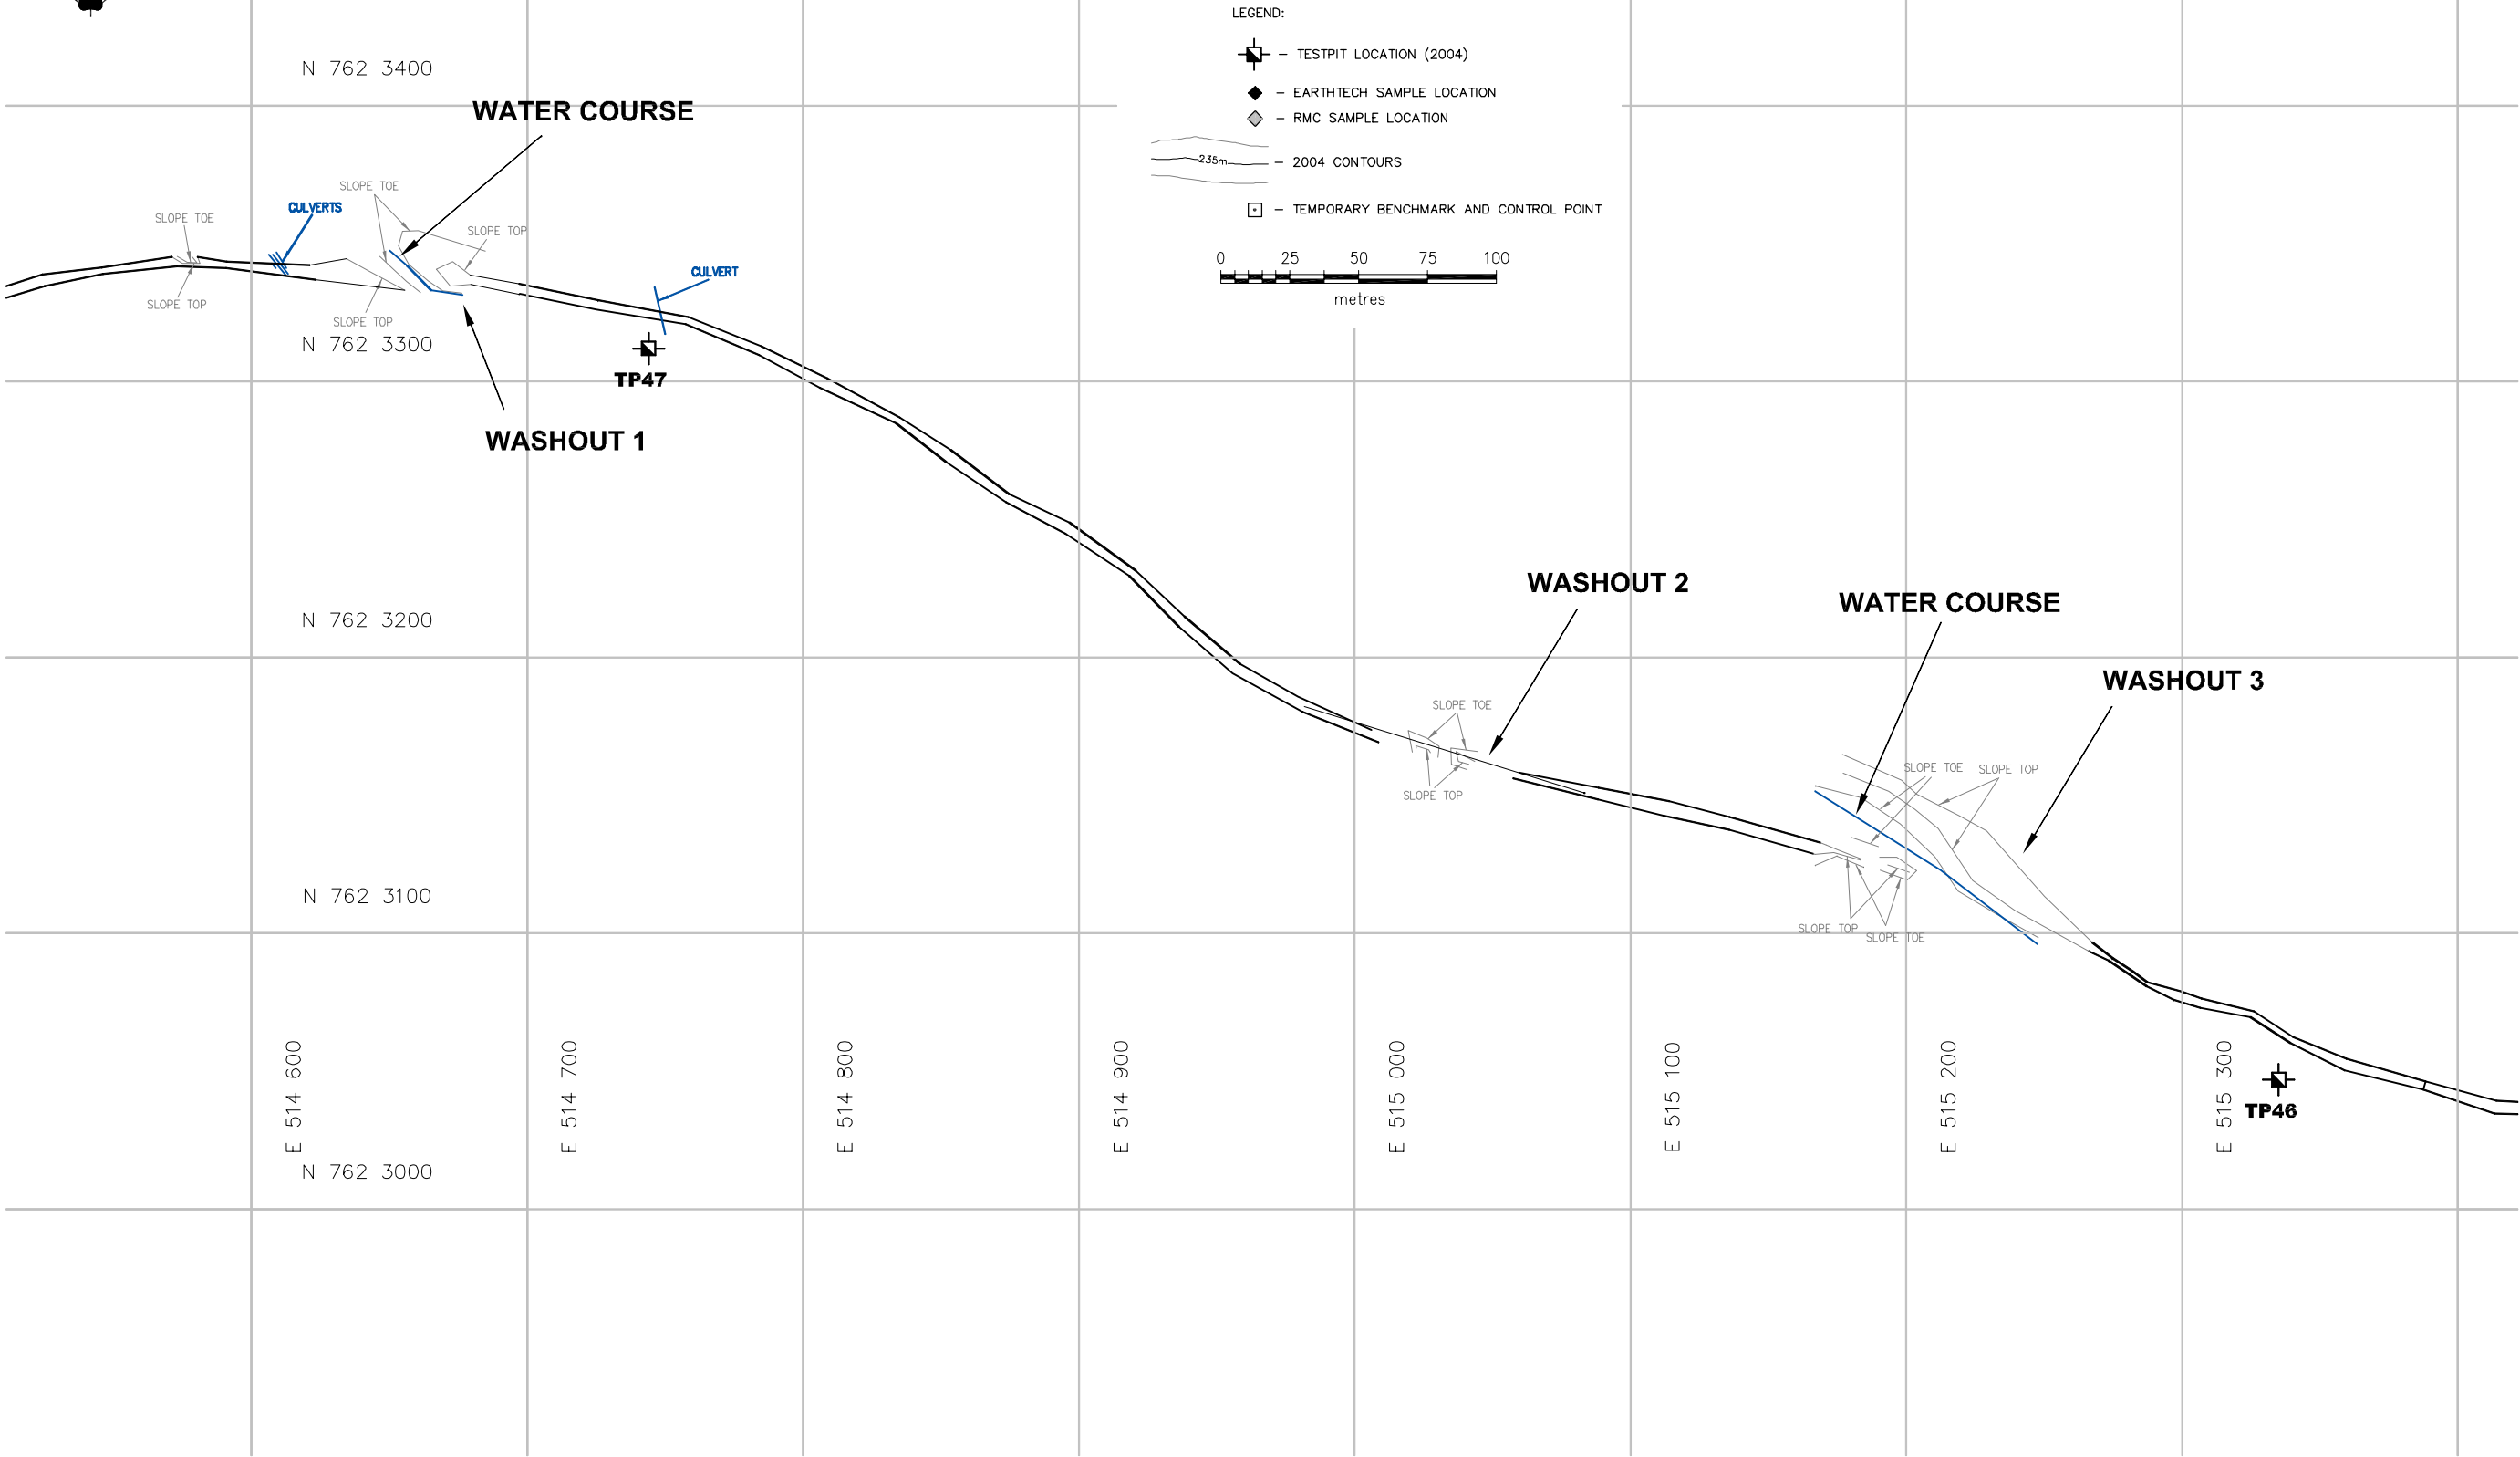

										 EBA Engineering Consultants Ltd.		 Public Works and Government Services Canada Travaux publics et Services gouvernementaux Canada			
										DESIGNED BY: <u>WTH/AB</u>		PERMIT	SEAL	FOX-C EKALUGAD FJORD	
										DRAWN BY: <u>DBD</u>					
										DATE: <u>07/10/04</u>					
										SCALE: <u>AS SHOWN</u>					
										PROJECT No.: <u>0101-04-1100065.001</u>		STATION ROAD 2	REVISION ISSUE 0		
										ACAD FILENAME: <u>1100065001003d.dwg</u>					
												FIGURE 7			

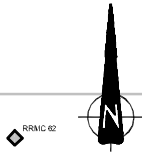

BORROW AREA 6

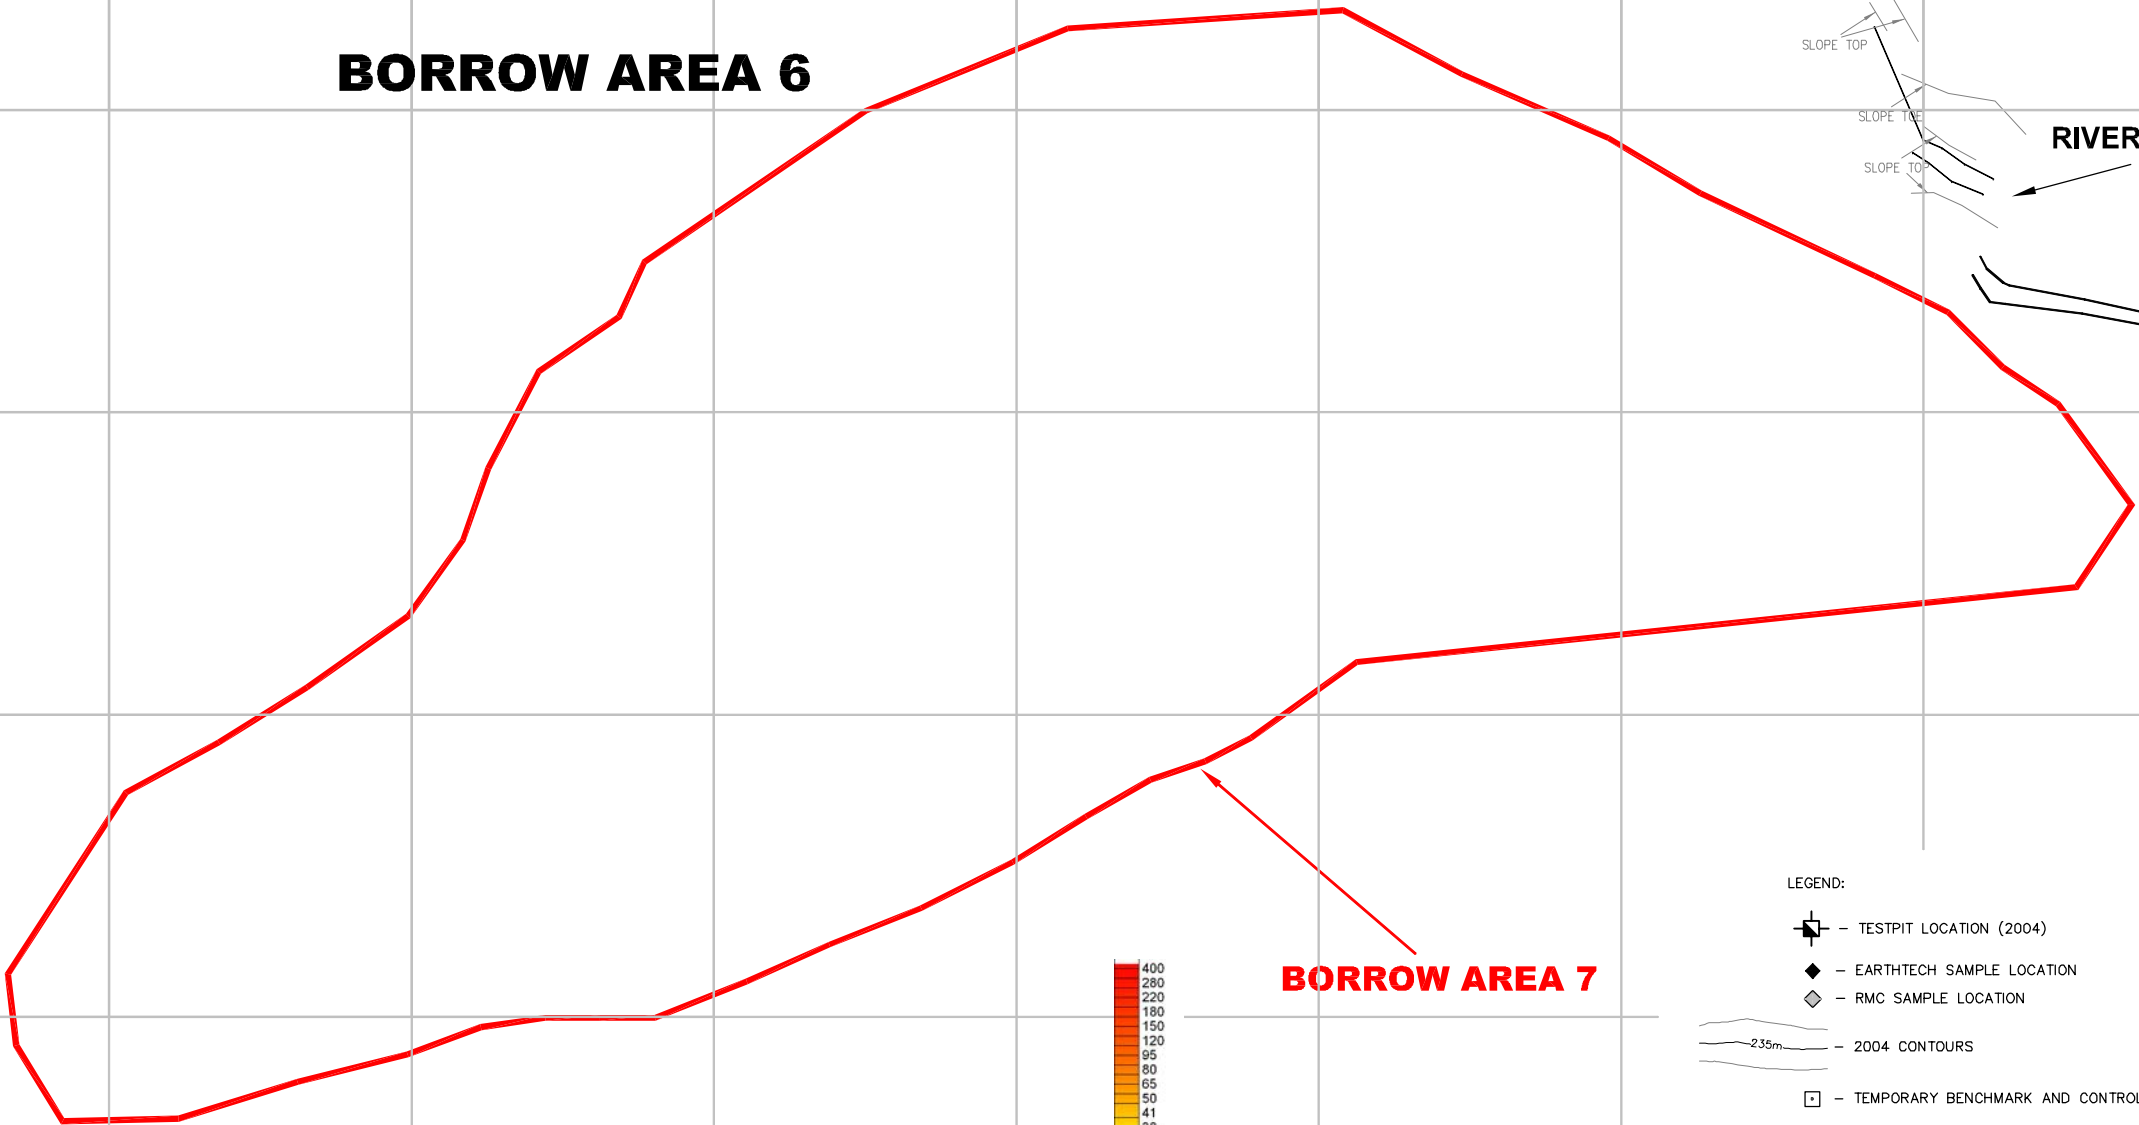


BORROW DEBRIS
AREA



BORROW AREA 7

DESIGNED BY: WTH/AB										PERMIT		SEAL	
DRAWN BY: DBD													
DATE: 07/10/04													
SCALE: AS SHOWN													
PROJECT No.: 0101-04-1100065.001													
ACAD FILENAME: 1100065001004.dwg													
ISSUED FOR REVIEW										29/10/04		WTH	
DATE										DATE		APPROVED	
REV										No.		REVISION	
REFERENCE DRAWINGS													
DESCRIPTION													
REVISION													

FOX-C EKALUGAD FJORD		REVISION		ISSUE	
BORROW AREA 6		0		0	
GRADIENT GEOPHYSICS		FIGURE		8A	

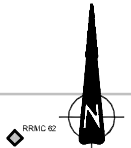

BORROW AREA 6

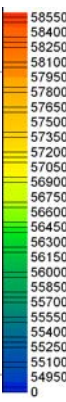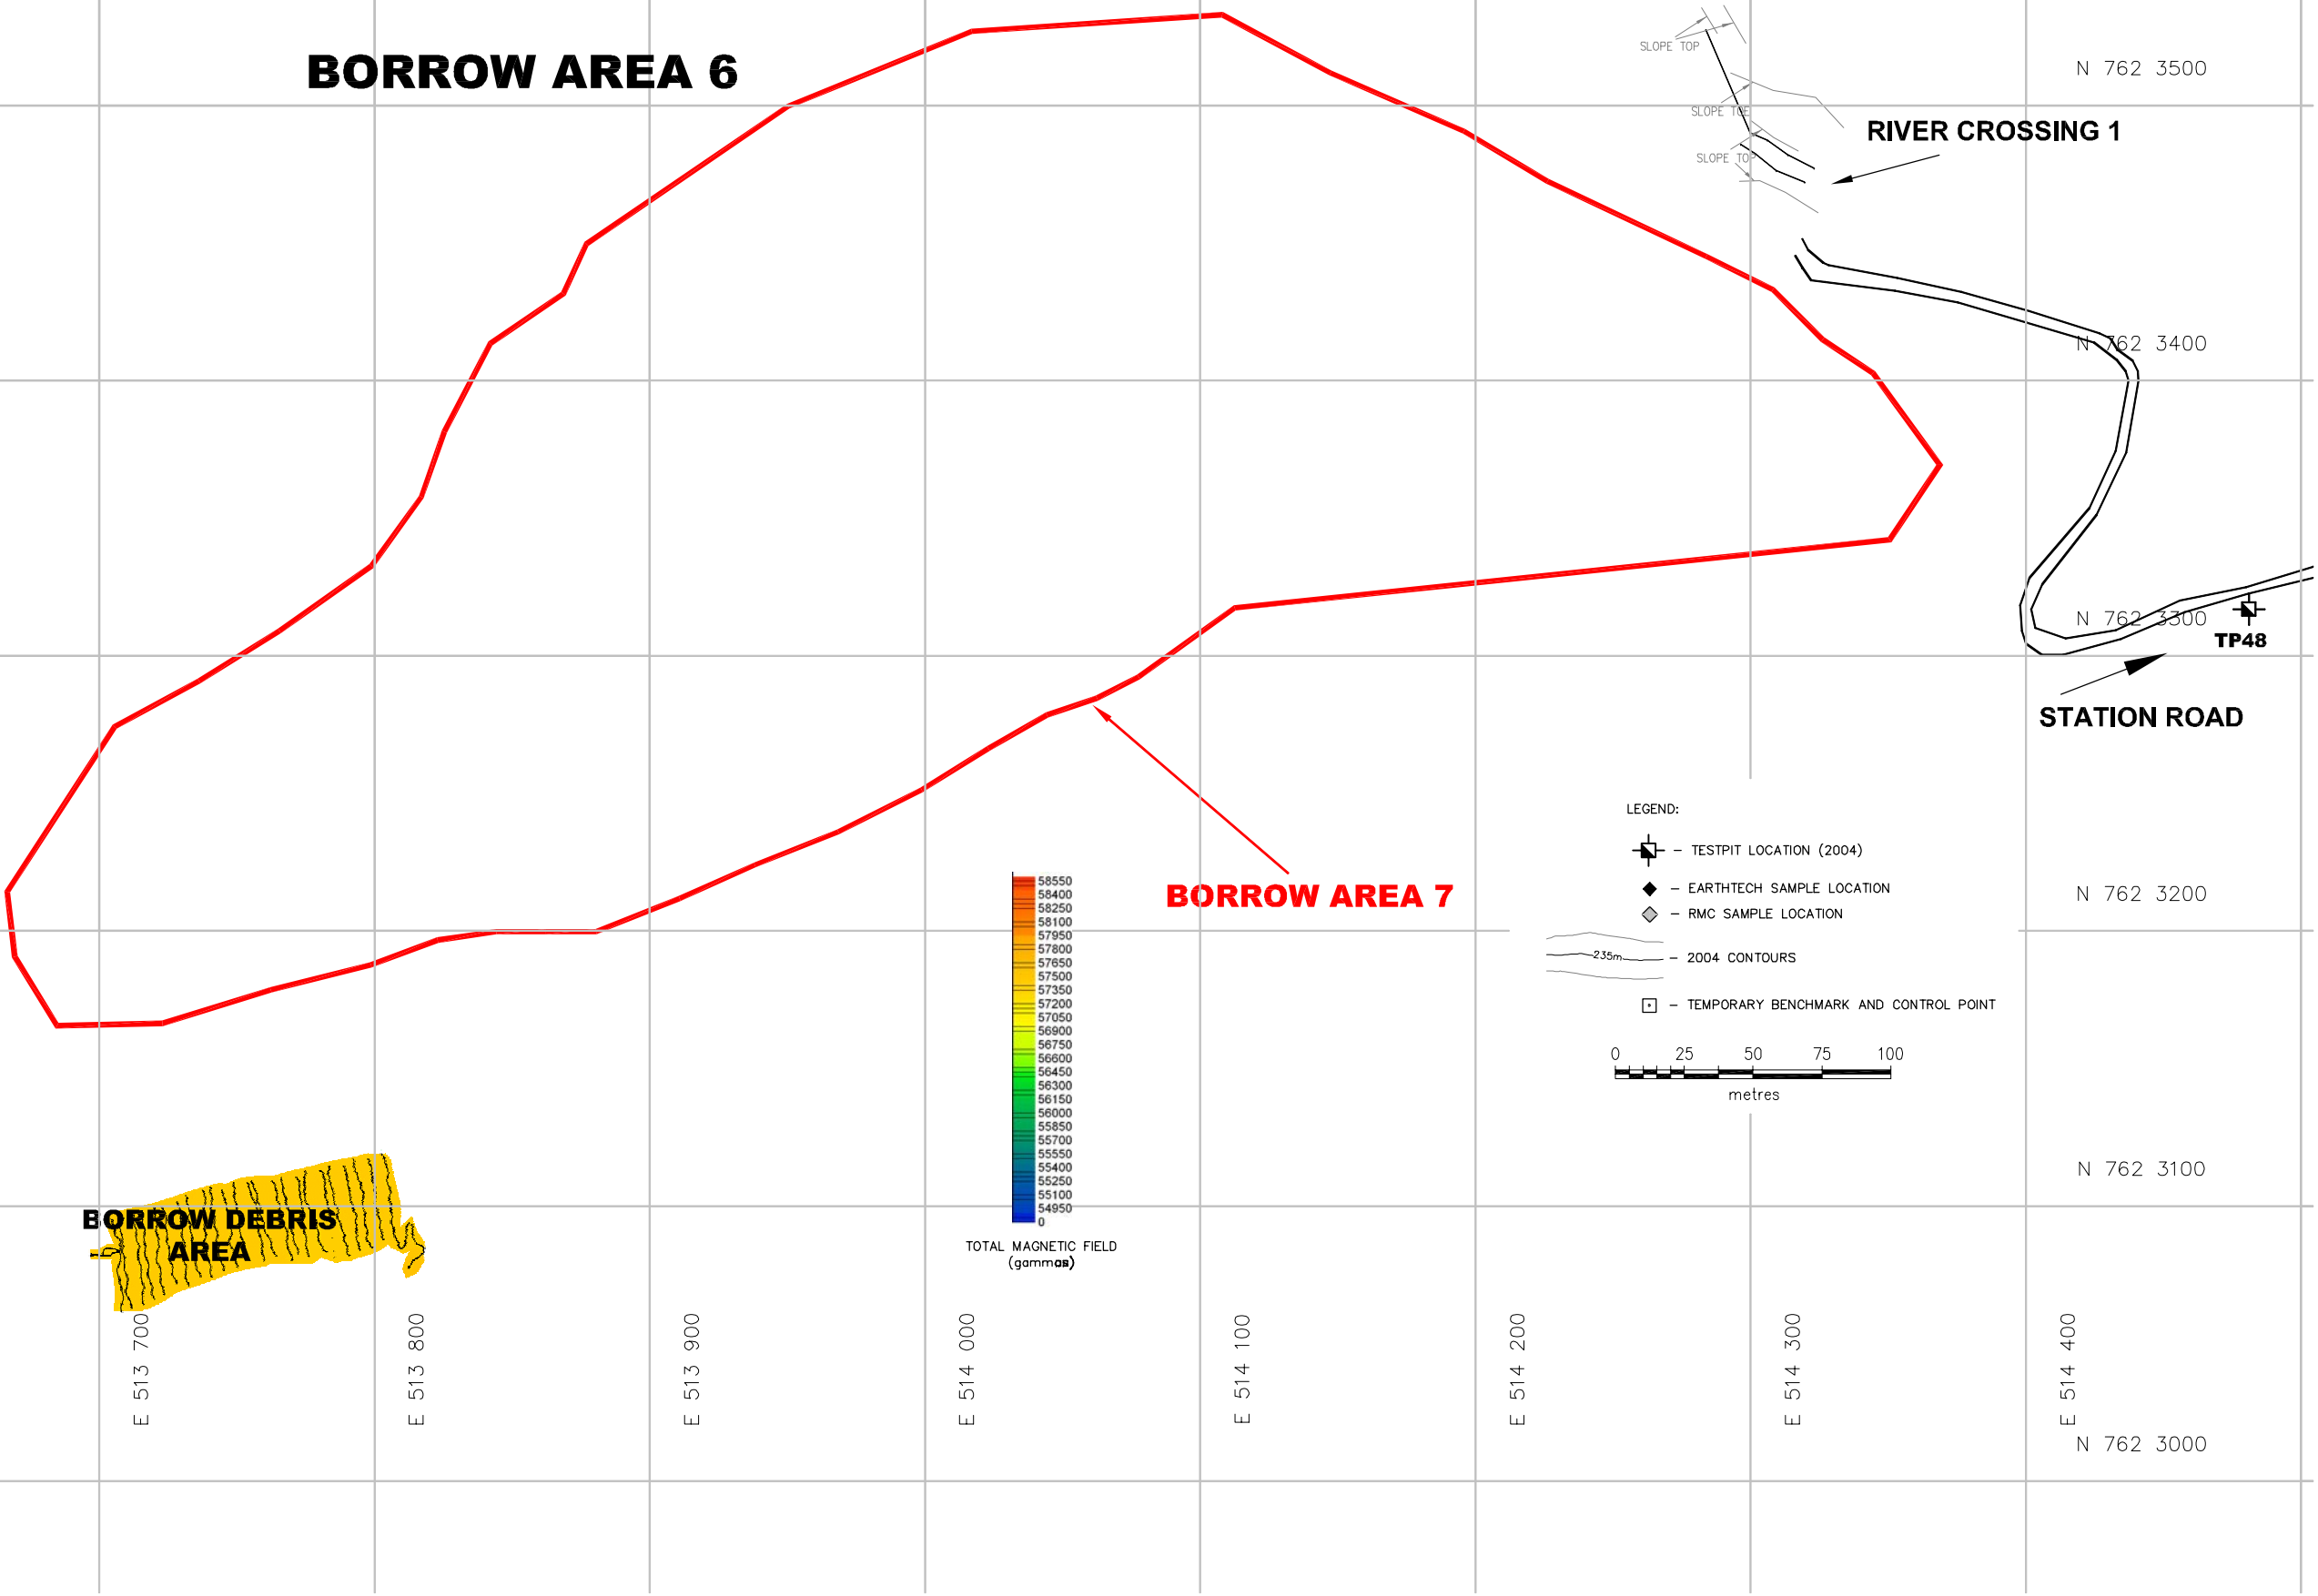


TOTAL MAGNETIC FIELD (gamma)

LEGEND:


- TESTPIT LOCATION (2004)
- EARTHTECH SAMPLE LOCATION
- RMC SAMPLE LOCATION
- 2004 CONTOURS
- TEMPORARY BENCHMARK AND CONTROL POINT

0 25 50 75 100 metres

EBA Engineering Consultants Ltd. Public Works and Government Services Canada Travaux publics et Services gouvernementaux Canada																							
<table><tr><td>DESIGNED BY:</td><td>WTH/AB</td></tr><tr><td>DRAWN BY:</td><td>DBD</td></tr><tr><td>DATE:</td><td>07/10/04</td></tr><tr><td>SCALE:</td><td>AS SHOWN</td></tr><tr><td>PROJECT No.:</td><td>0101-04-1100065.001</td></tr><tr><td>ACAD FILENAME:</td><td>11000650010205d.dwg</td></tr></table>						DESIGNED BY:	WTH/AB	DRAWN BY:	DBD	DATE:	07/10/04	SCALE:	AS SHOWN	PROJECT No.:	0101-04-1100065.001	ACAD FILENAME:	11000650010205d.dwg	PERMIT		SEAL		FOX-C EKALUGAD FJORD	
DESIGNED BY:	WTH/AB																						
DRAWN BY:	DBD																						
DATE:	07/10/04																						
SCALE:	AS SHOWN																						
PROJECT No.:	0101-04-1100065.001																						
ACAD FILENAME:	11000650010205d.dwg																						
<table><tr><td colspan="2">BORROW AREA 6 GEOPHYSICS TOP SENSOR READING</td><td>REVISION</td><td>ISSUE</td></tr><tr><td colspan="2"></td><td>0</td><td></td></tr></table>						BORROW AREA 6 GEOPHYSICS TOP SENSOR READING		REVISION	ISSUE			0		FIGURE		8B							
						BORROW AREA 6 GEOPHYSICS TOP SENSOR READING		REVISION	ISSUE														
		0																					

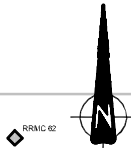

BORROW AREA 6

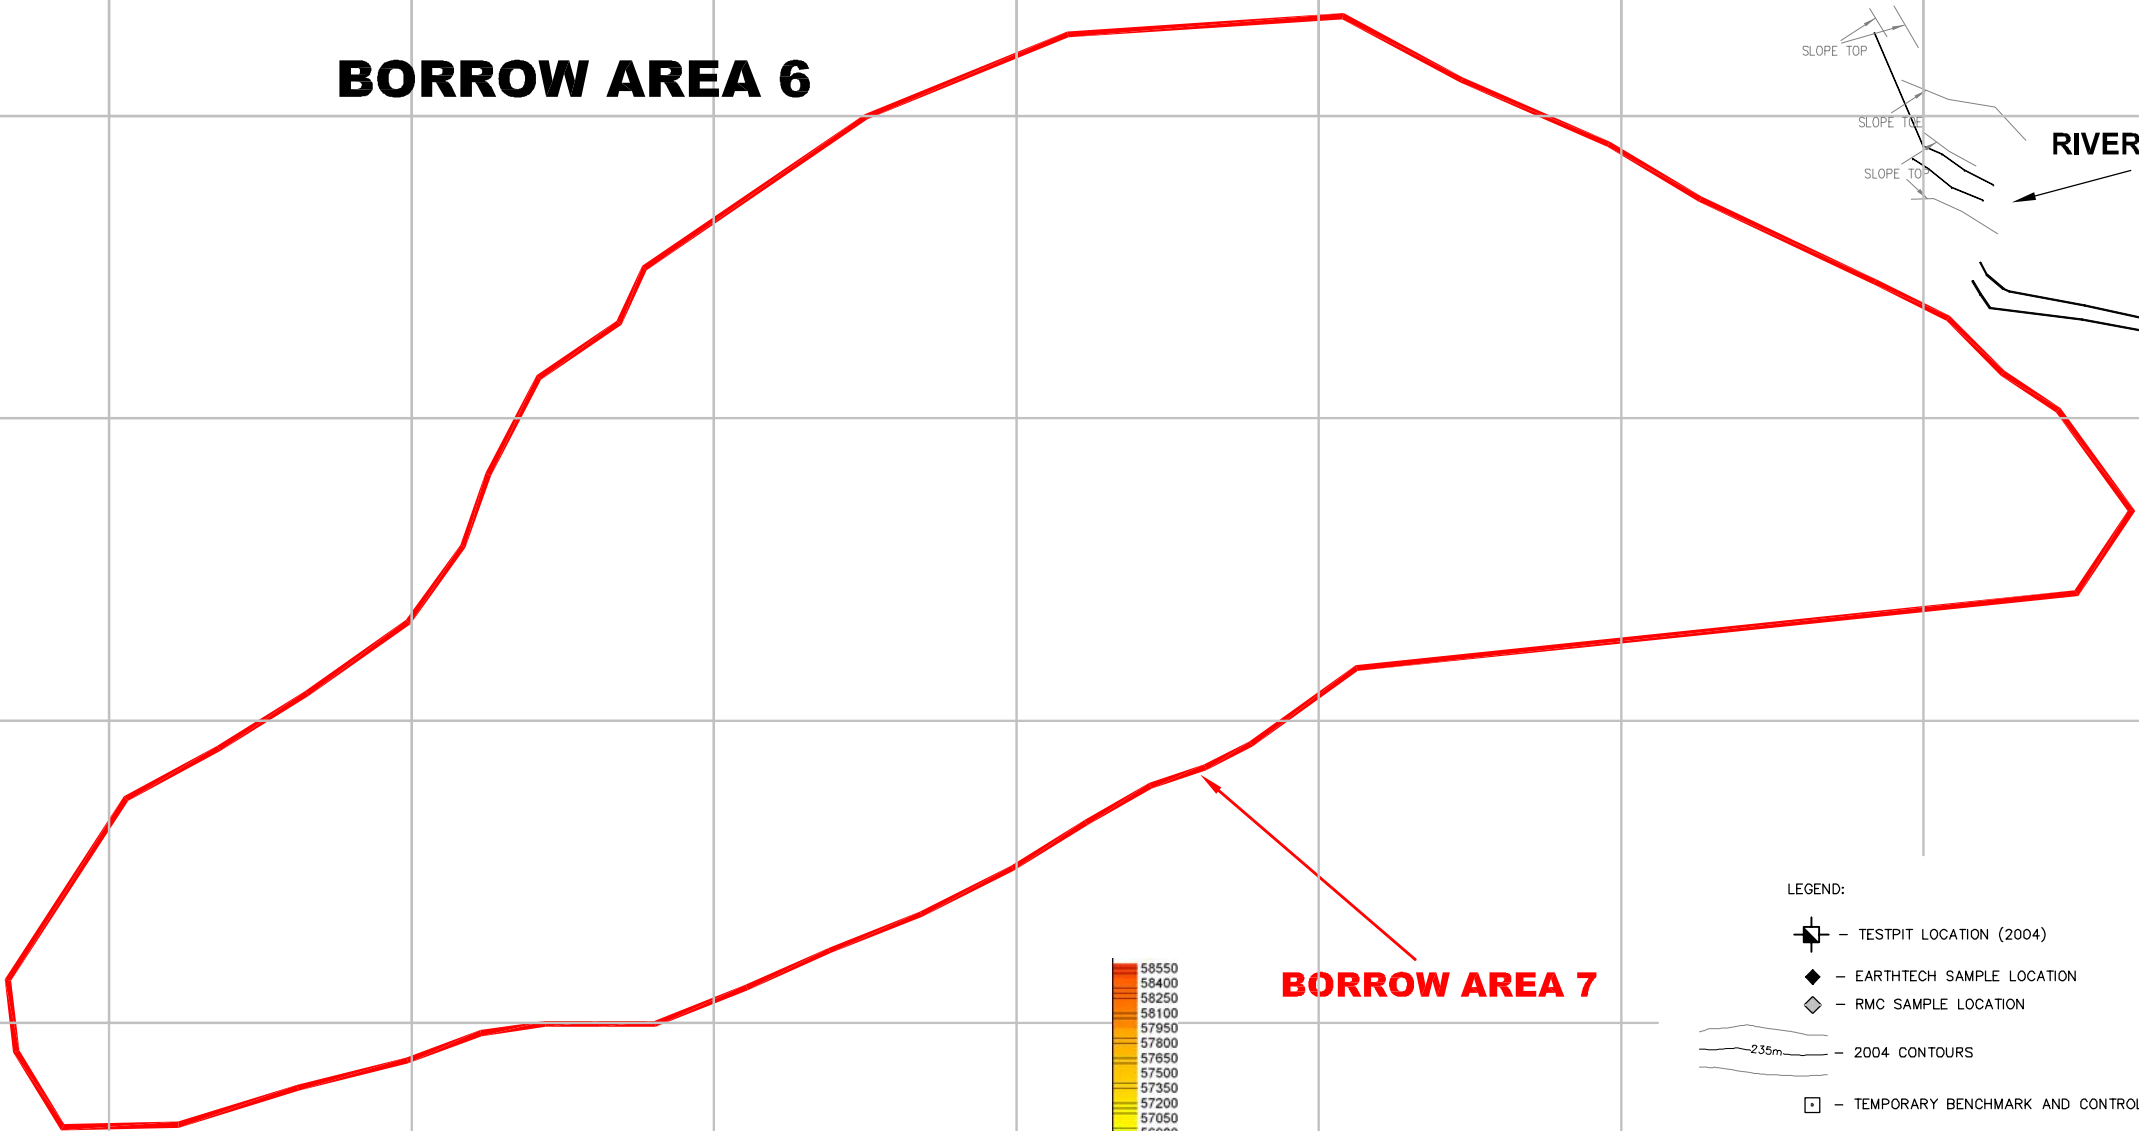


LEGEND:

- TESTPIT LOCATION (2004)
- EARTHTECH SAMPLE LOCATION
- RMC SAMPLE LOCATION
- 2004 CONTOURS
- TEMPORARY BENCHMARK AND CONTROL POINT

0 25 50 75 100 metres

BORROW DEBRIS AREA

DESIGNED BY: WTH/AB DRAWN BY: DBD DATE: 07/10/04 SCALE: AS SHOWN PROJECT No.: 0101-04-1100065.001 ACAD FILENAME: 11000650010206.dwg PERMIT SEAL <tr><td colspan="10">FOX-C EKALUGAD FJORD</td></tr> <tr><td colspan="10">BORROW AREA 6 GEOPHYSICS BOTTOM SENSOR READINGS</td></tr> <tr><td colspan="10">REVISION ISSUE 0 FIGURE 8C</td></tr>										FOX-C EKALUGAD FJORD										BORROW AREA 6 GEOPHYSICS BOTTOM SENSOR READINGS										REVISION ISSUE 0 FIGURE 8C									
FOX-C EKALUGAD FJORD																																							
BORROW AREA 6 GEOPHYSICS BOTTOM SENSOR READINGS																																							
REVISION ISSUE 0 FIGURE 8C																																							

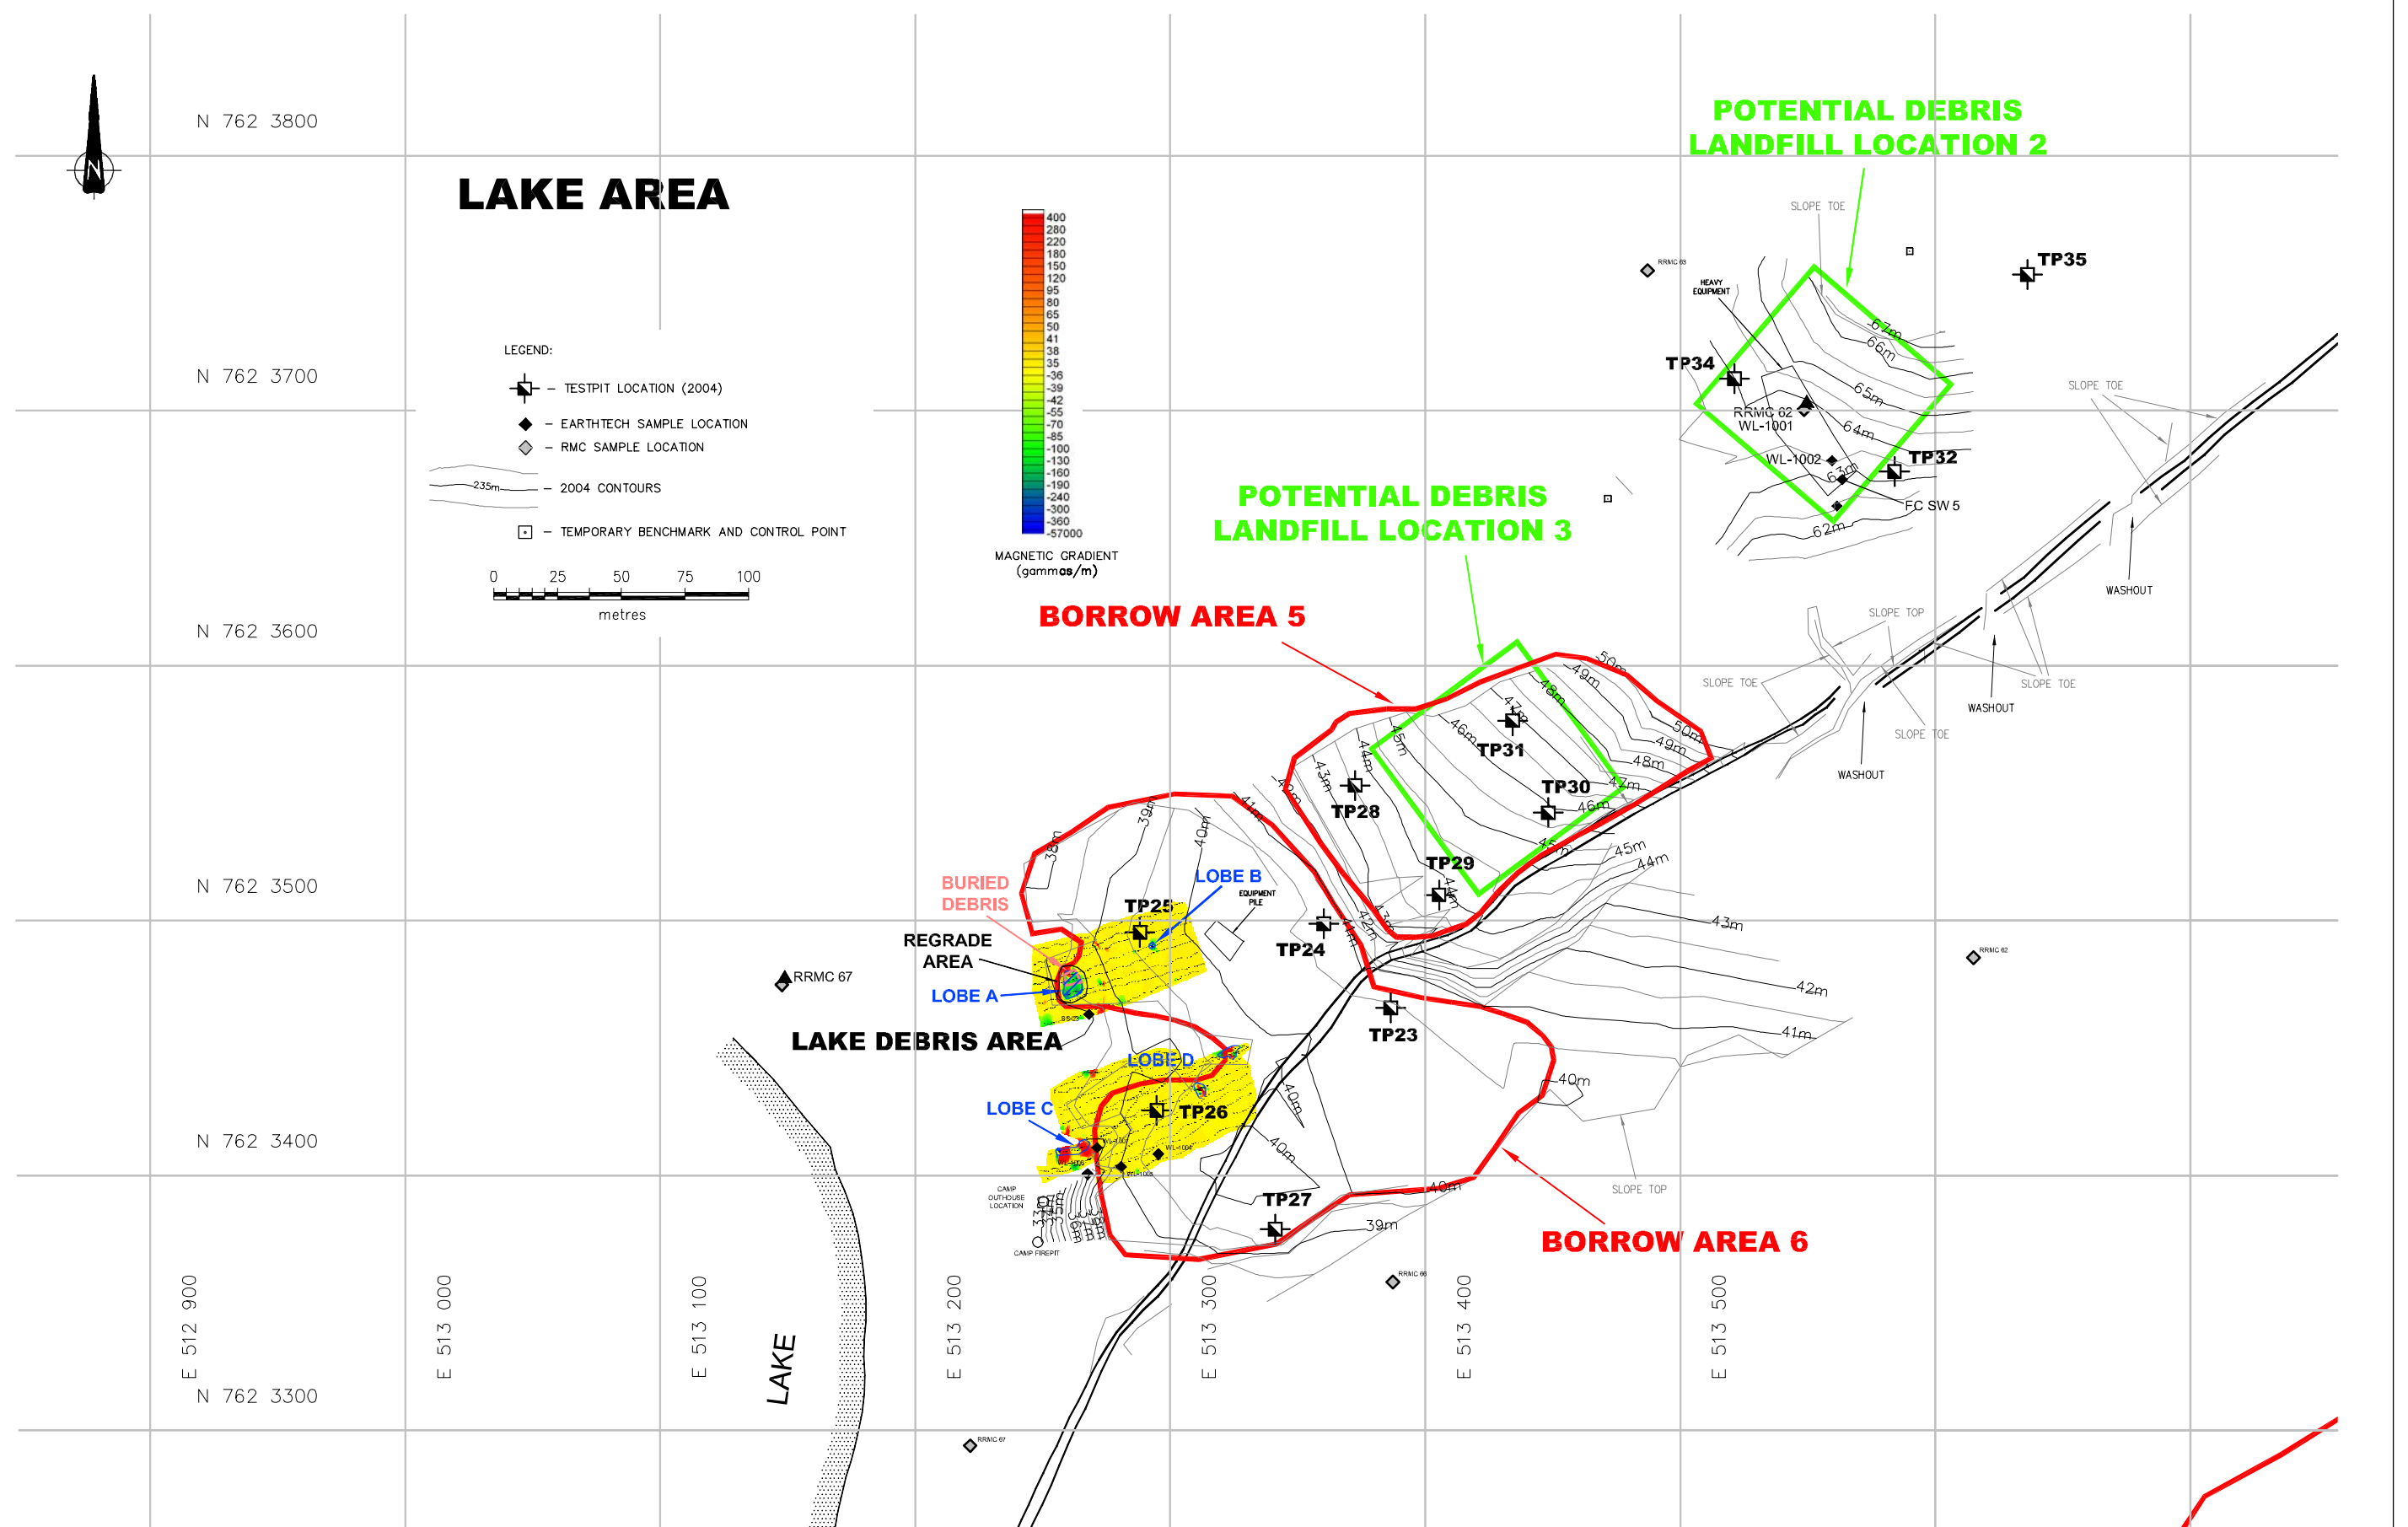[illegible]



N 762 3800

N 762 3700

N 762 3600

N 762 3500

N 762 3400

E 512 900

N 762 3300

E 513 000

E 513 100

E 513 200

E 513 300

E 513 400

E 513 500

LAKE AREA

LEGEND:



TESTPIT LOCATION (2004)

EARTHTECH SAMPLE LOCATION

RMC SAMPLE LOCATION

2.35m
2004 CONTOURS

TEMPORARY BENCHMARK AND CONTROL POINT

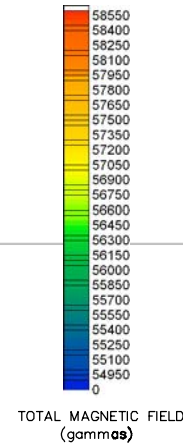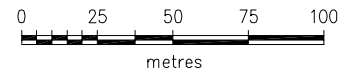

TOTAL MAGNETIC FIELD (gammas)

BORROW AREA 5

POTENTIAL DEBRIS LANDFILL LOCATION 3

POTENTIAL DEBRIS LANDFILL LOCATION 2

LAKE DEBRIS AREA

BURIED DEBRIS

REGRADE AREA

LOBE A


LOBE B

LOBE C


LOBE D


CAMP OUTHOUSE LOCATION
CAMP FIREPIT

LAKE

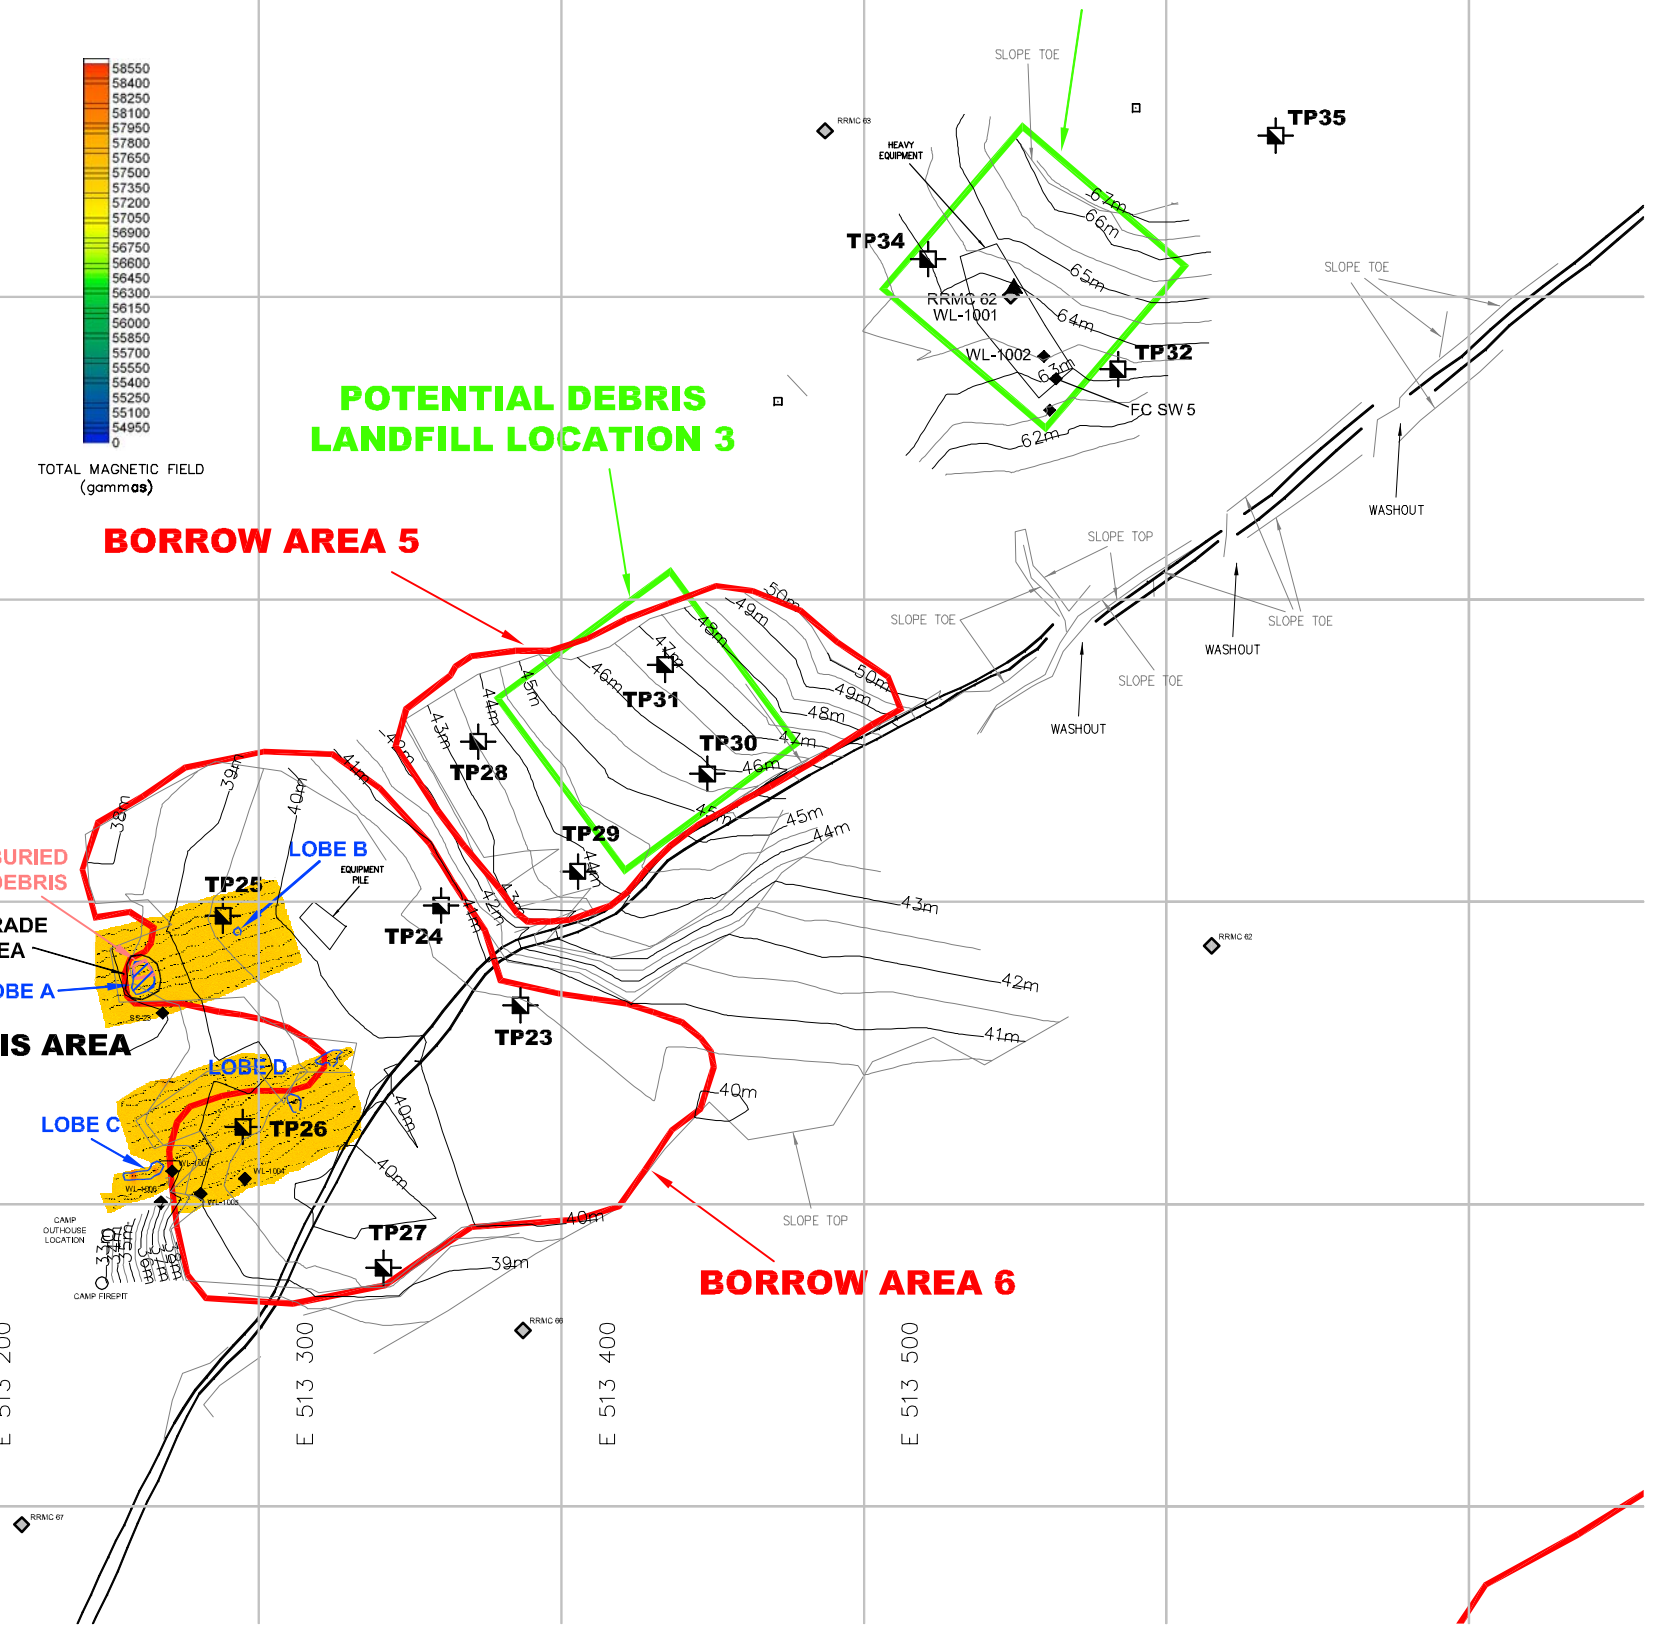



										 EBA Engineering Consultants Ltd.		 Public Works and Government Services Canada		Travaux publics et Services gouvernementaux Canada		
										DESIGNED BY:	WTH/AB	PERMIT	SEAL	FOX-C EKALUGAD FJORD		
										DRAWN BY:	DBD			LAKE AREA GEOPHYSICS TOP SENSOR READINGS		
										DATE:	07/10/04					
										SCALE:	AS SHOWN					
										PROJECT No.:	0101-04-1100065.001					
										ACAD FILENAME:	1100065001Q05d.dwg	REVISION ISSUE 0				
													FIGURE 9B			

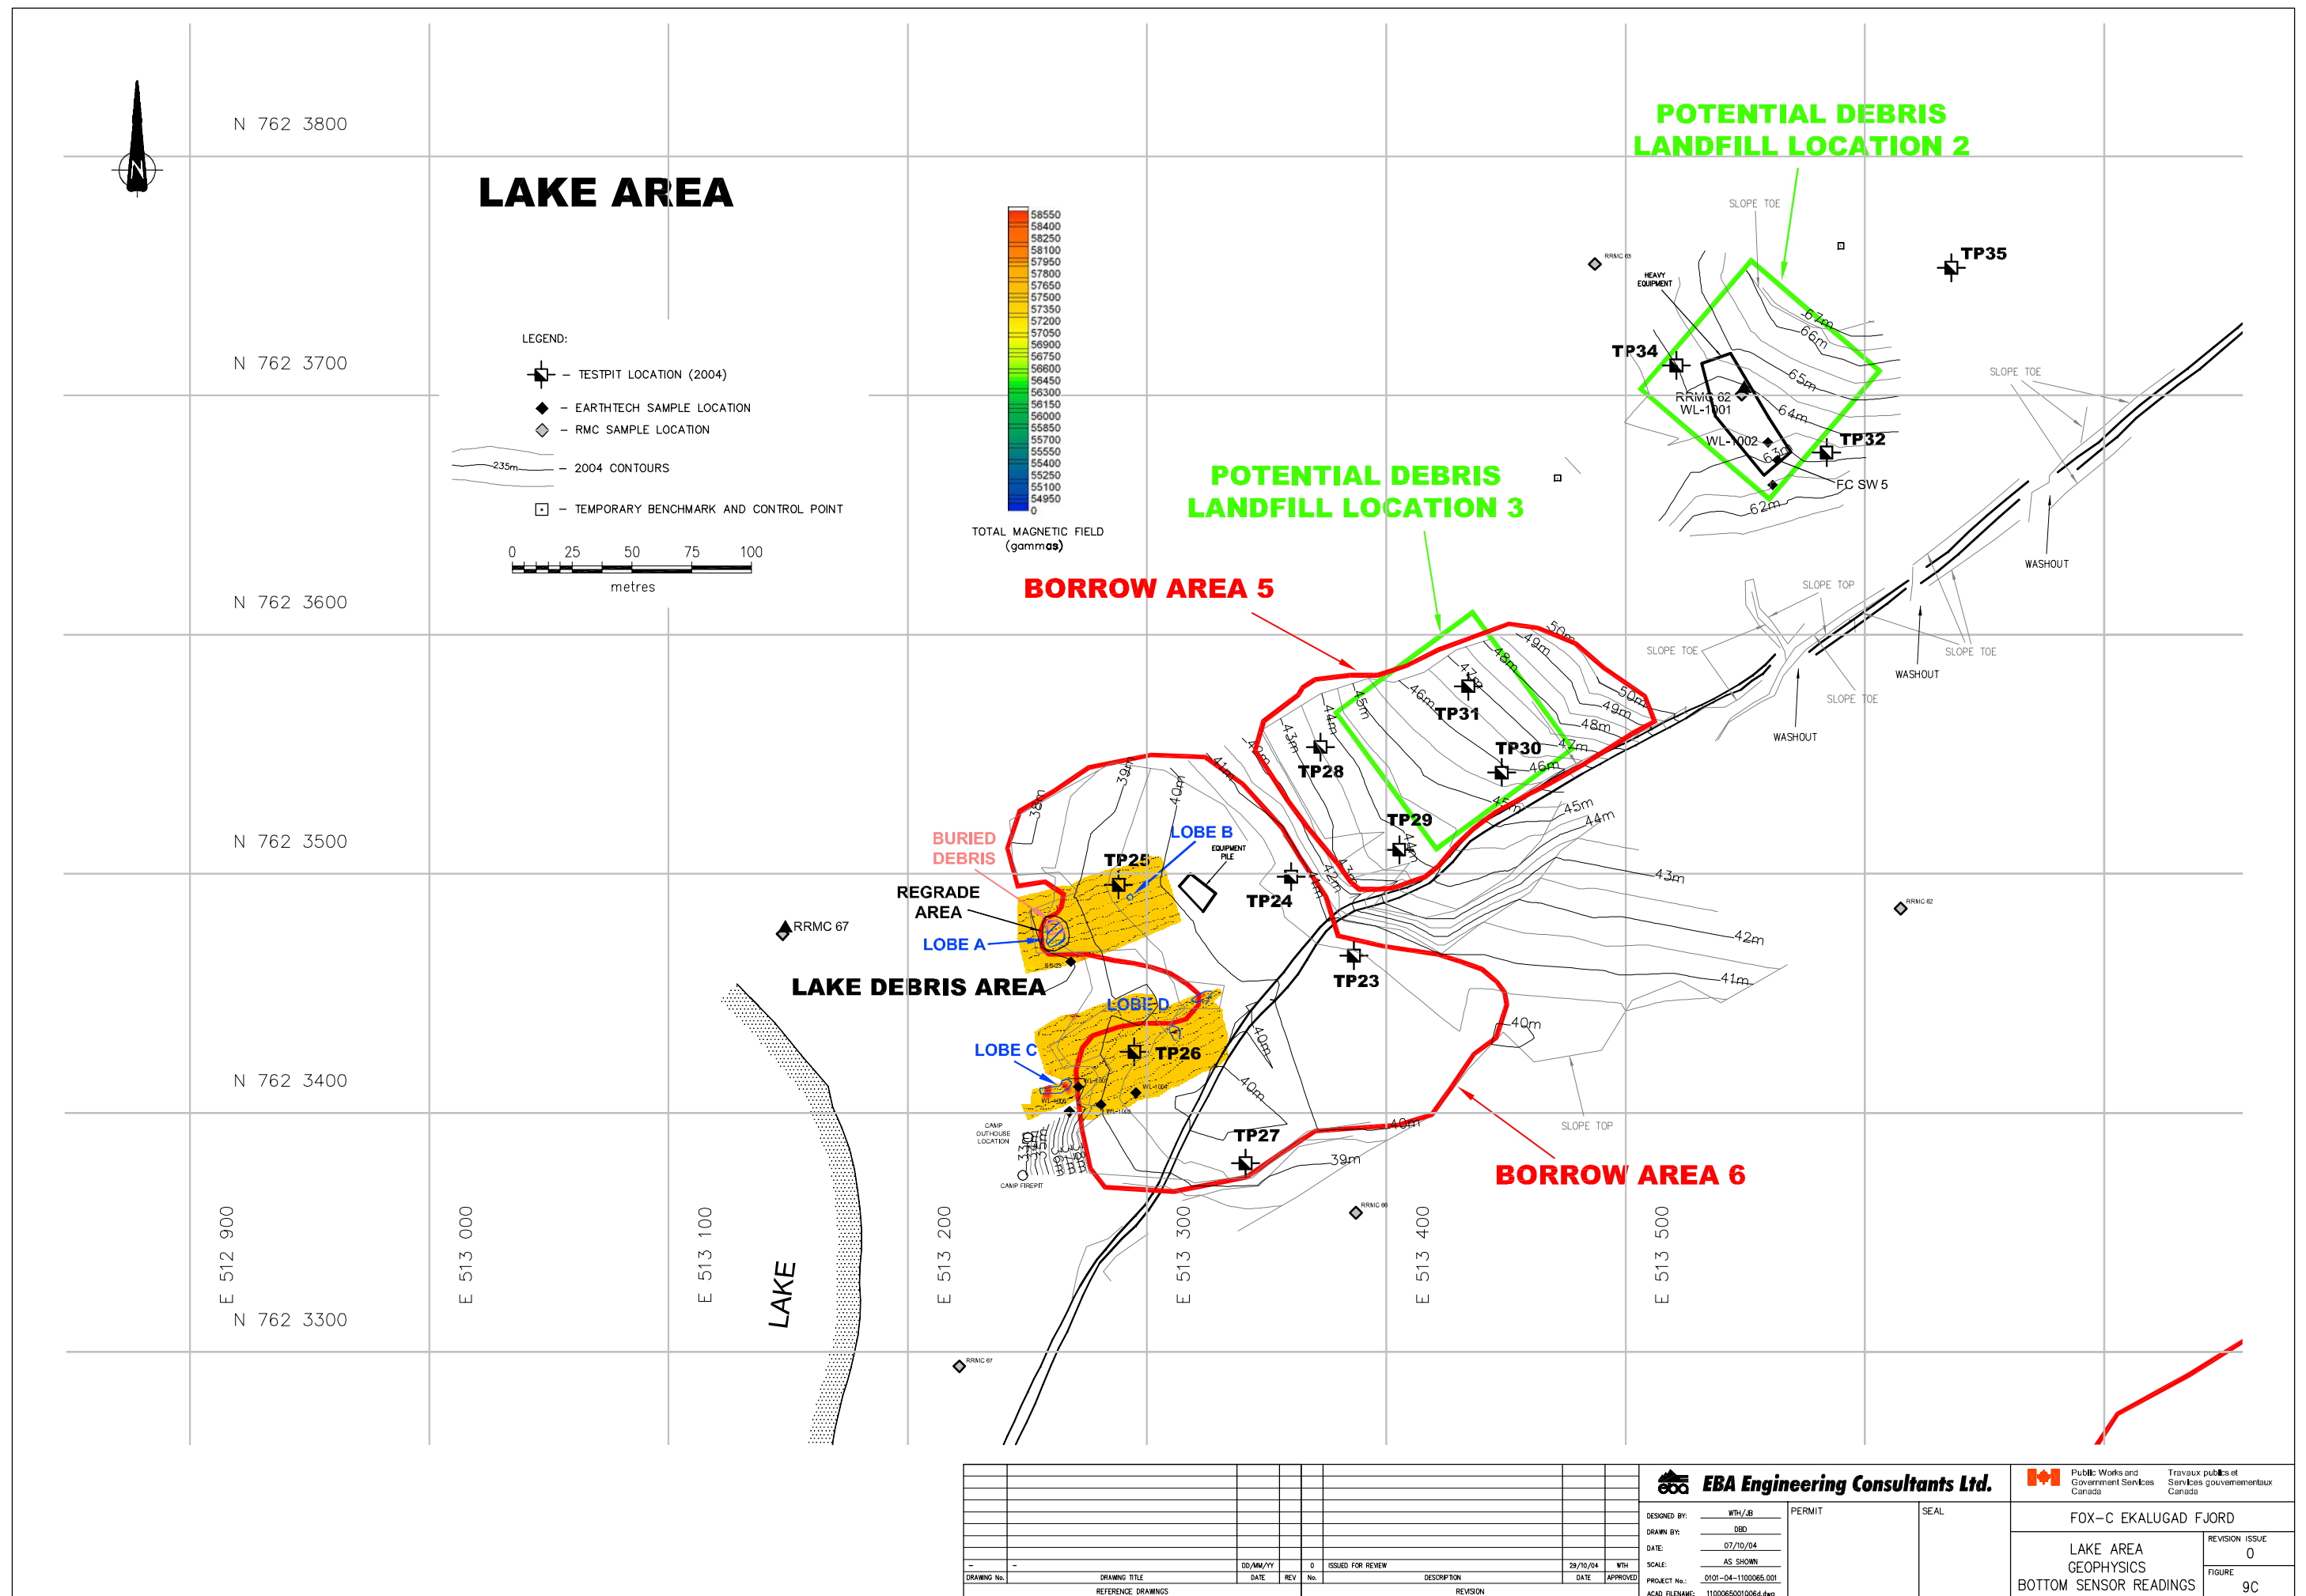

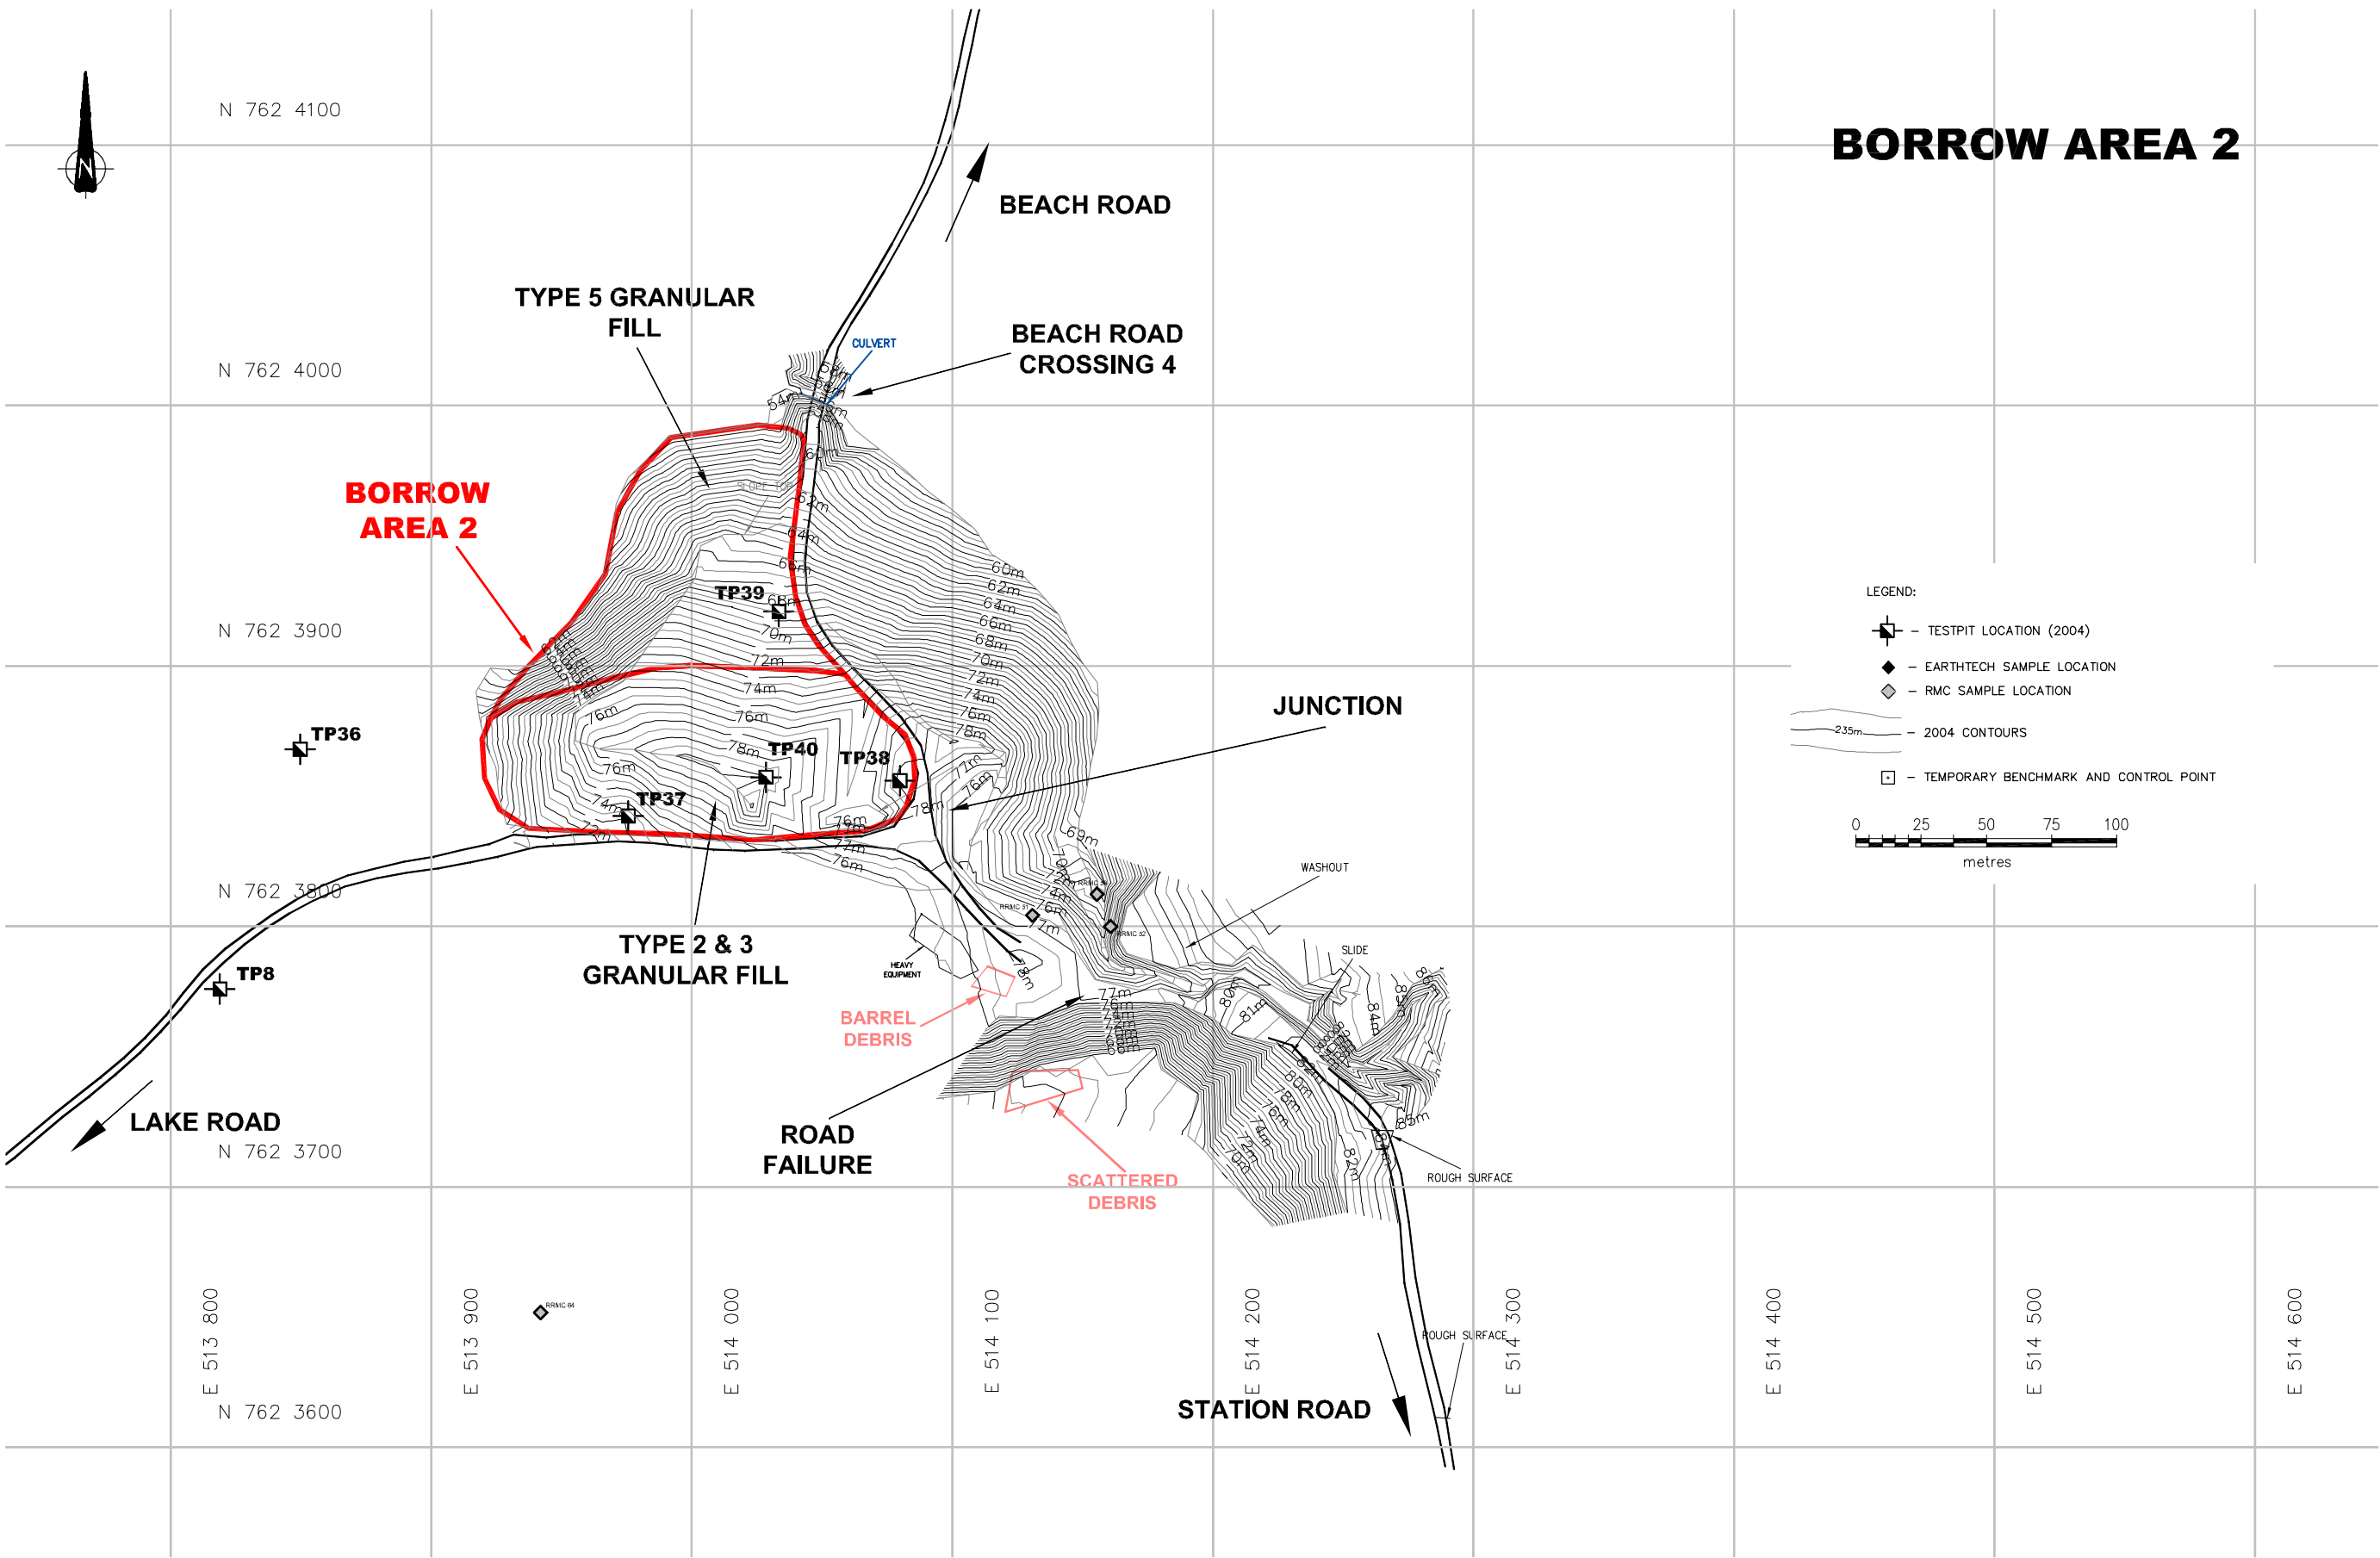


										 EBA Engineering Consultants Ltd.				 Public Works and Government Services Canada / Travaux publics et Services gouvernementaux Canada							
										DESIGNED BY: WTH/AB				PERMIT	SEAL	FOX-C EKALUGAD FJORD					
										DRAWN BY: DBD						BORROW AREA 2				REVISION ISSUE	
										DATE: 07/10/04										0	
										SCALE: AS SHOWN										FIGURE	
										PROJECT No.: 0101-04-1100065.001										10	
										ACAD FILENAME: 1100065001003d.dwg											

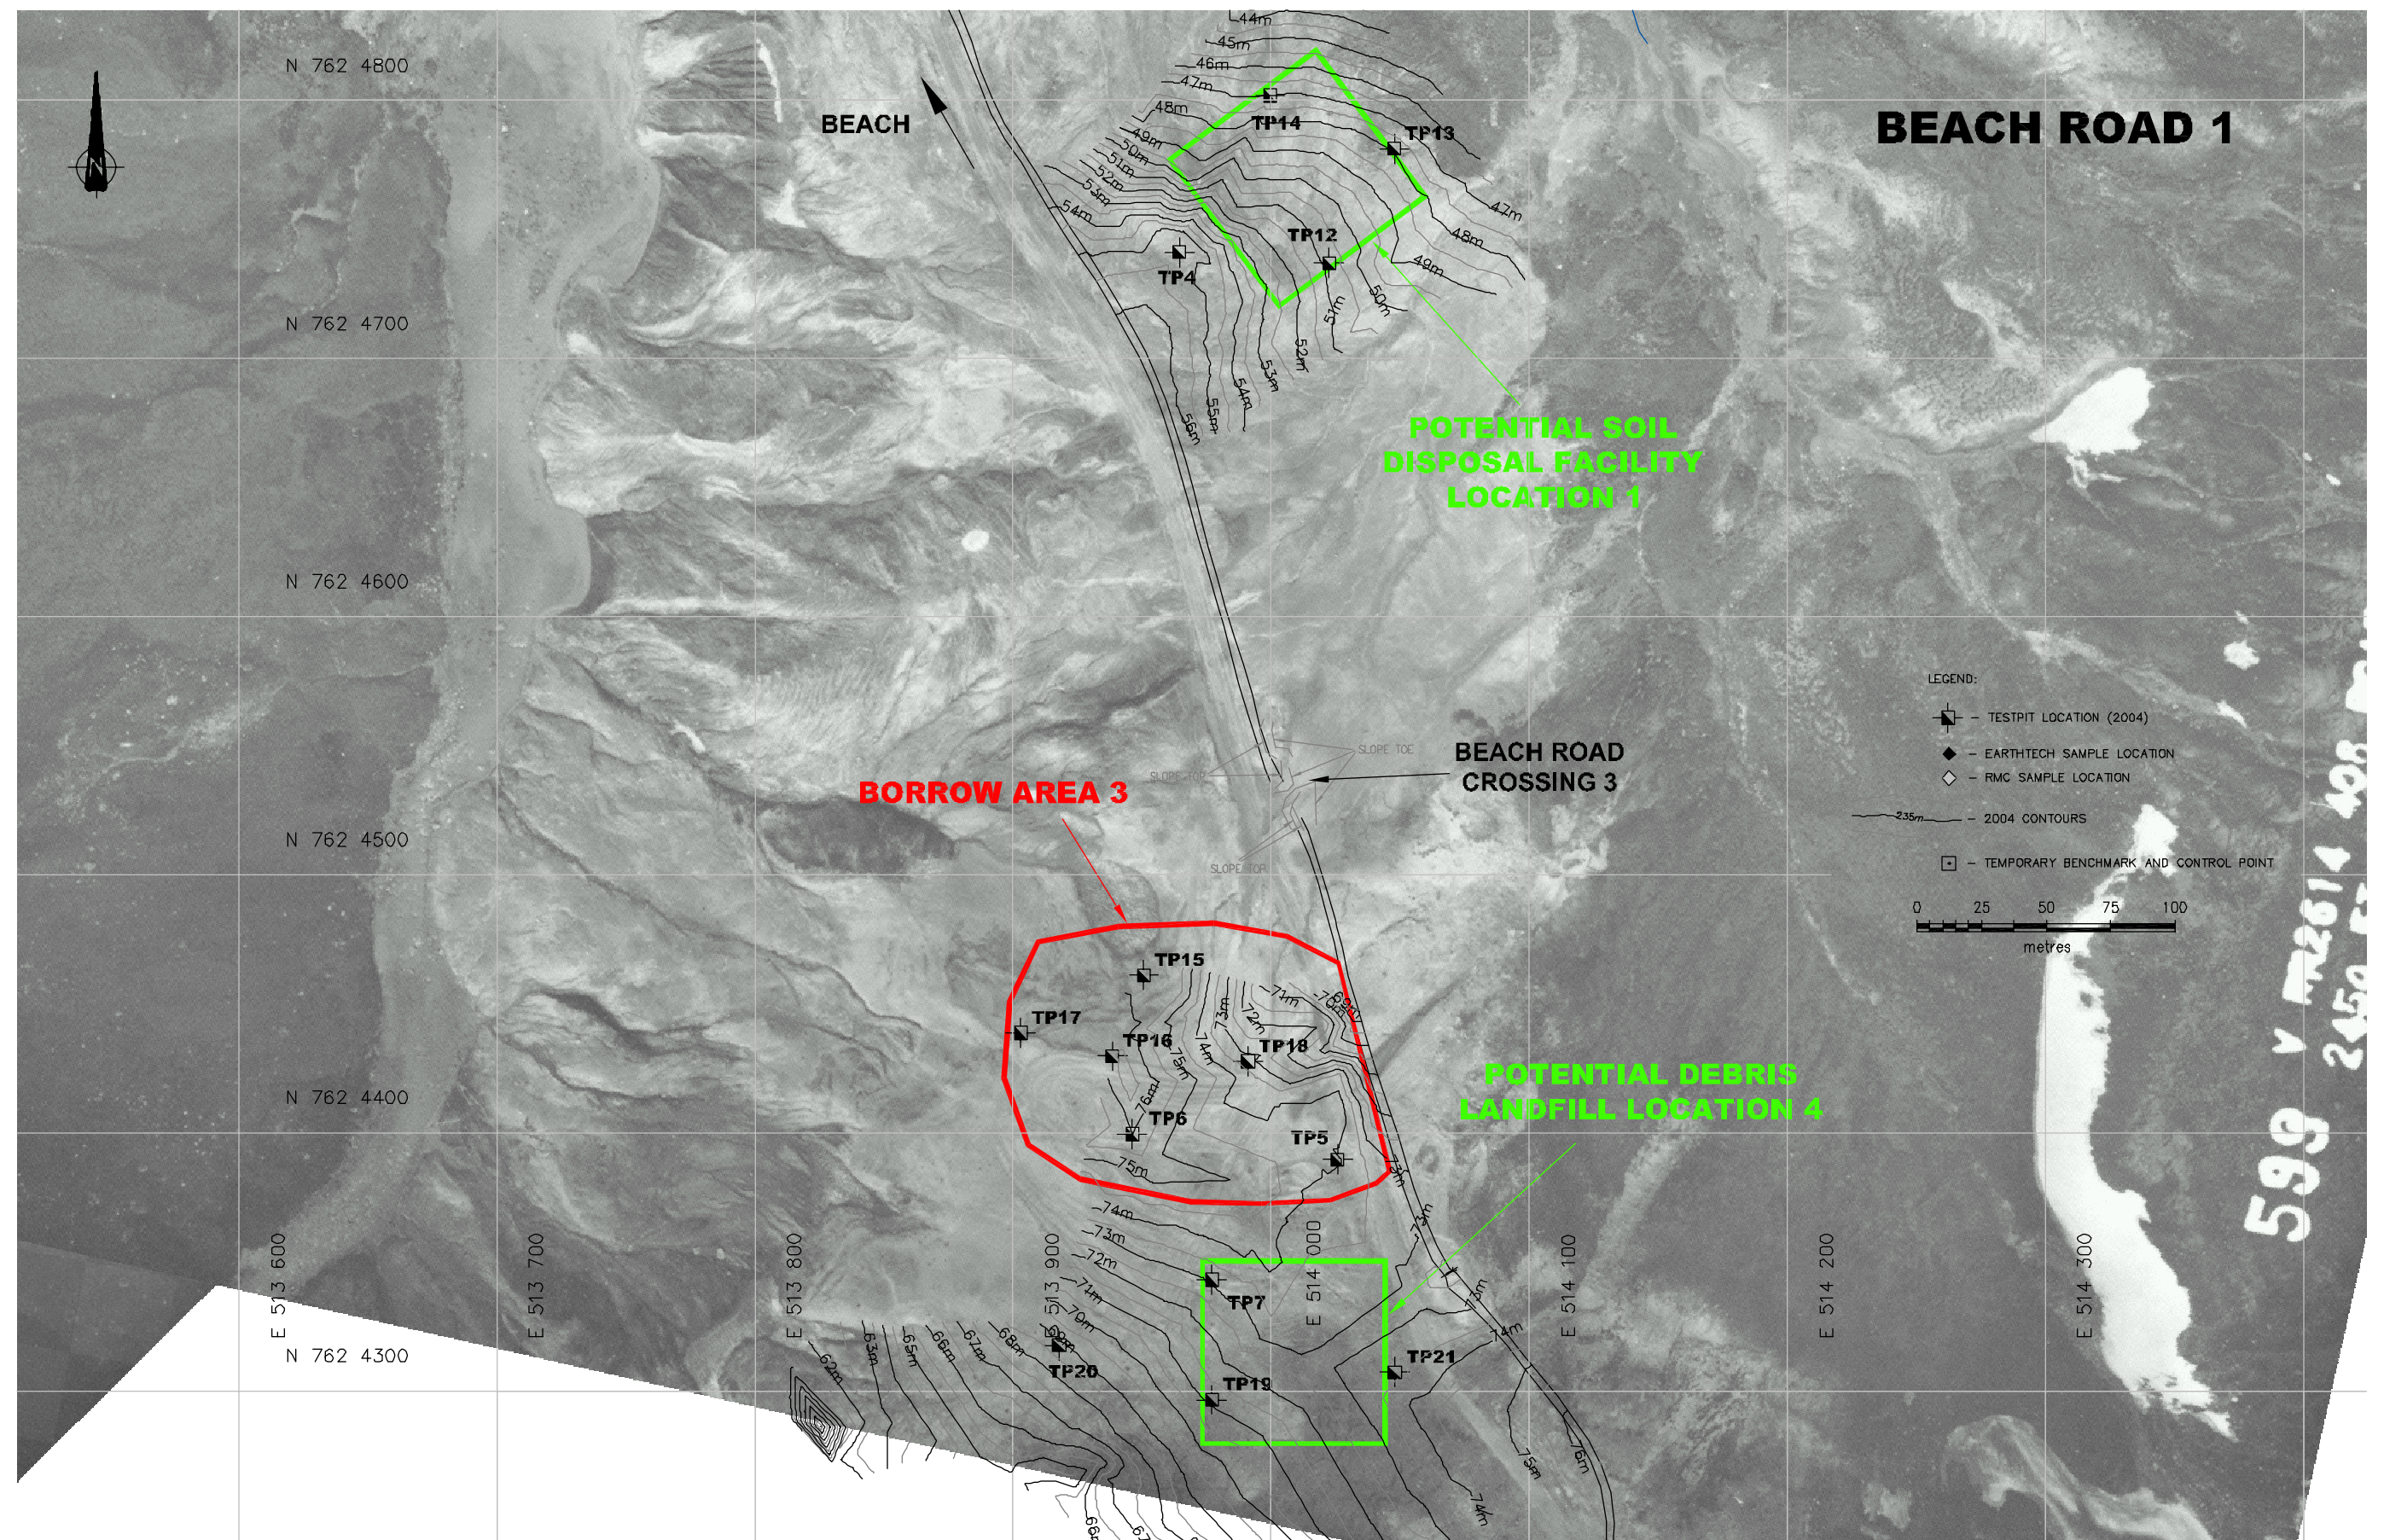[illegible]

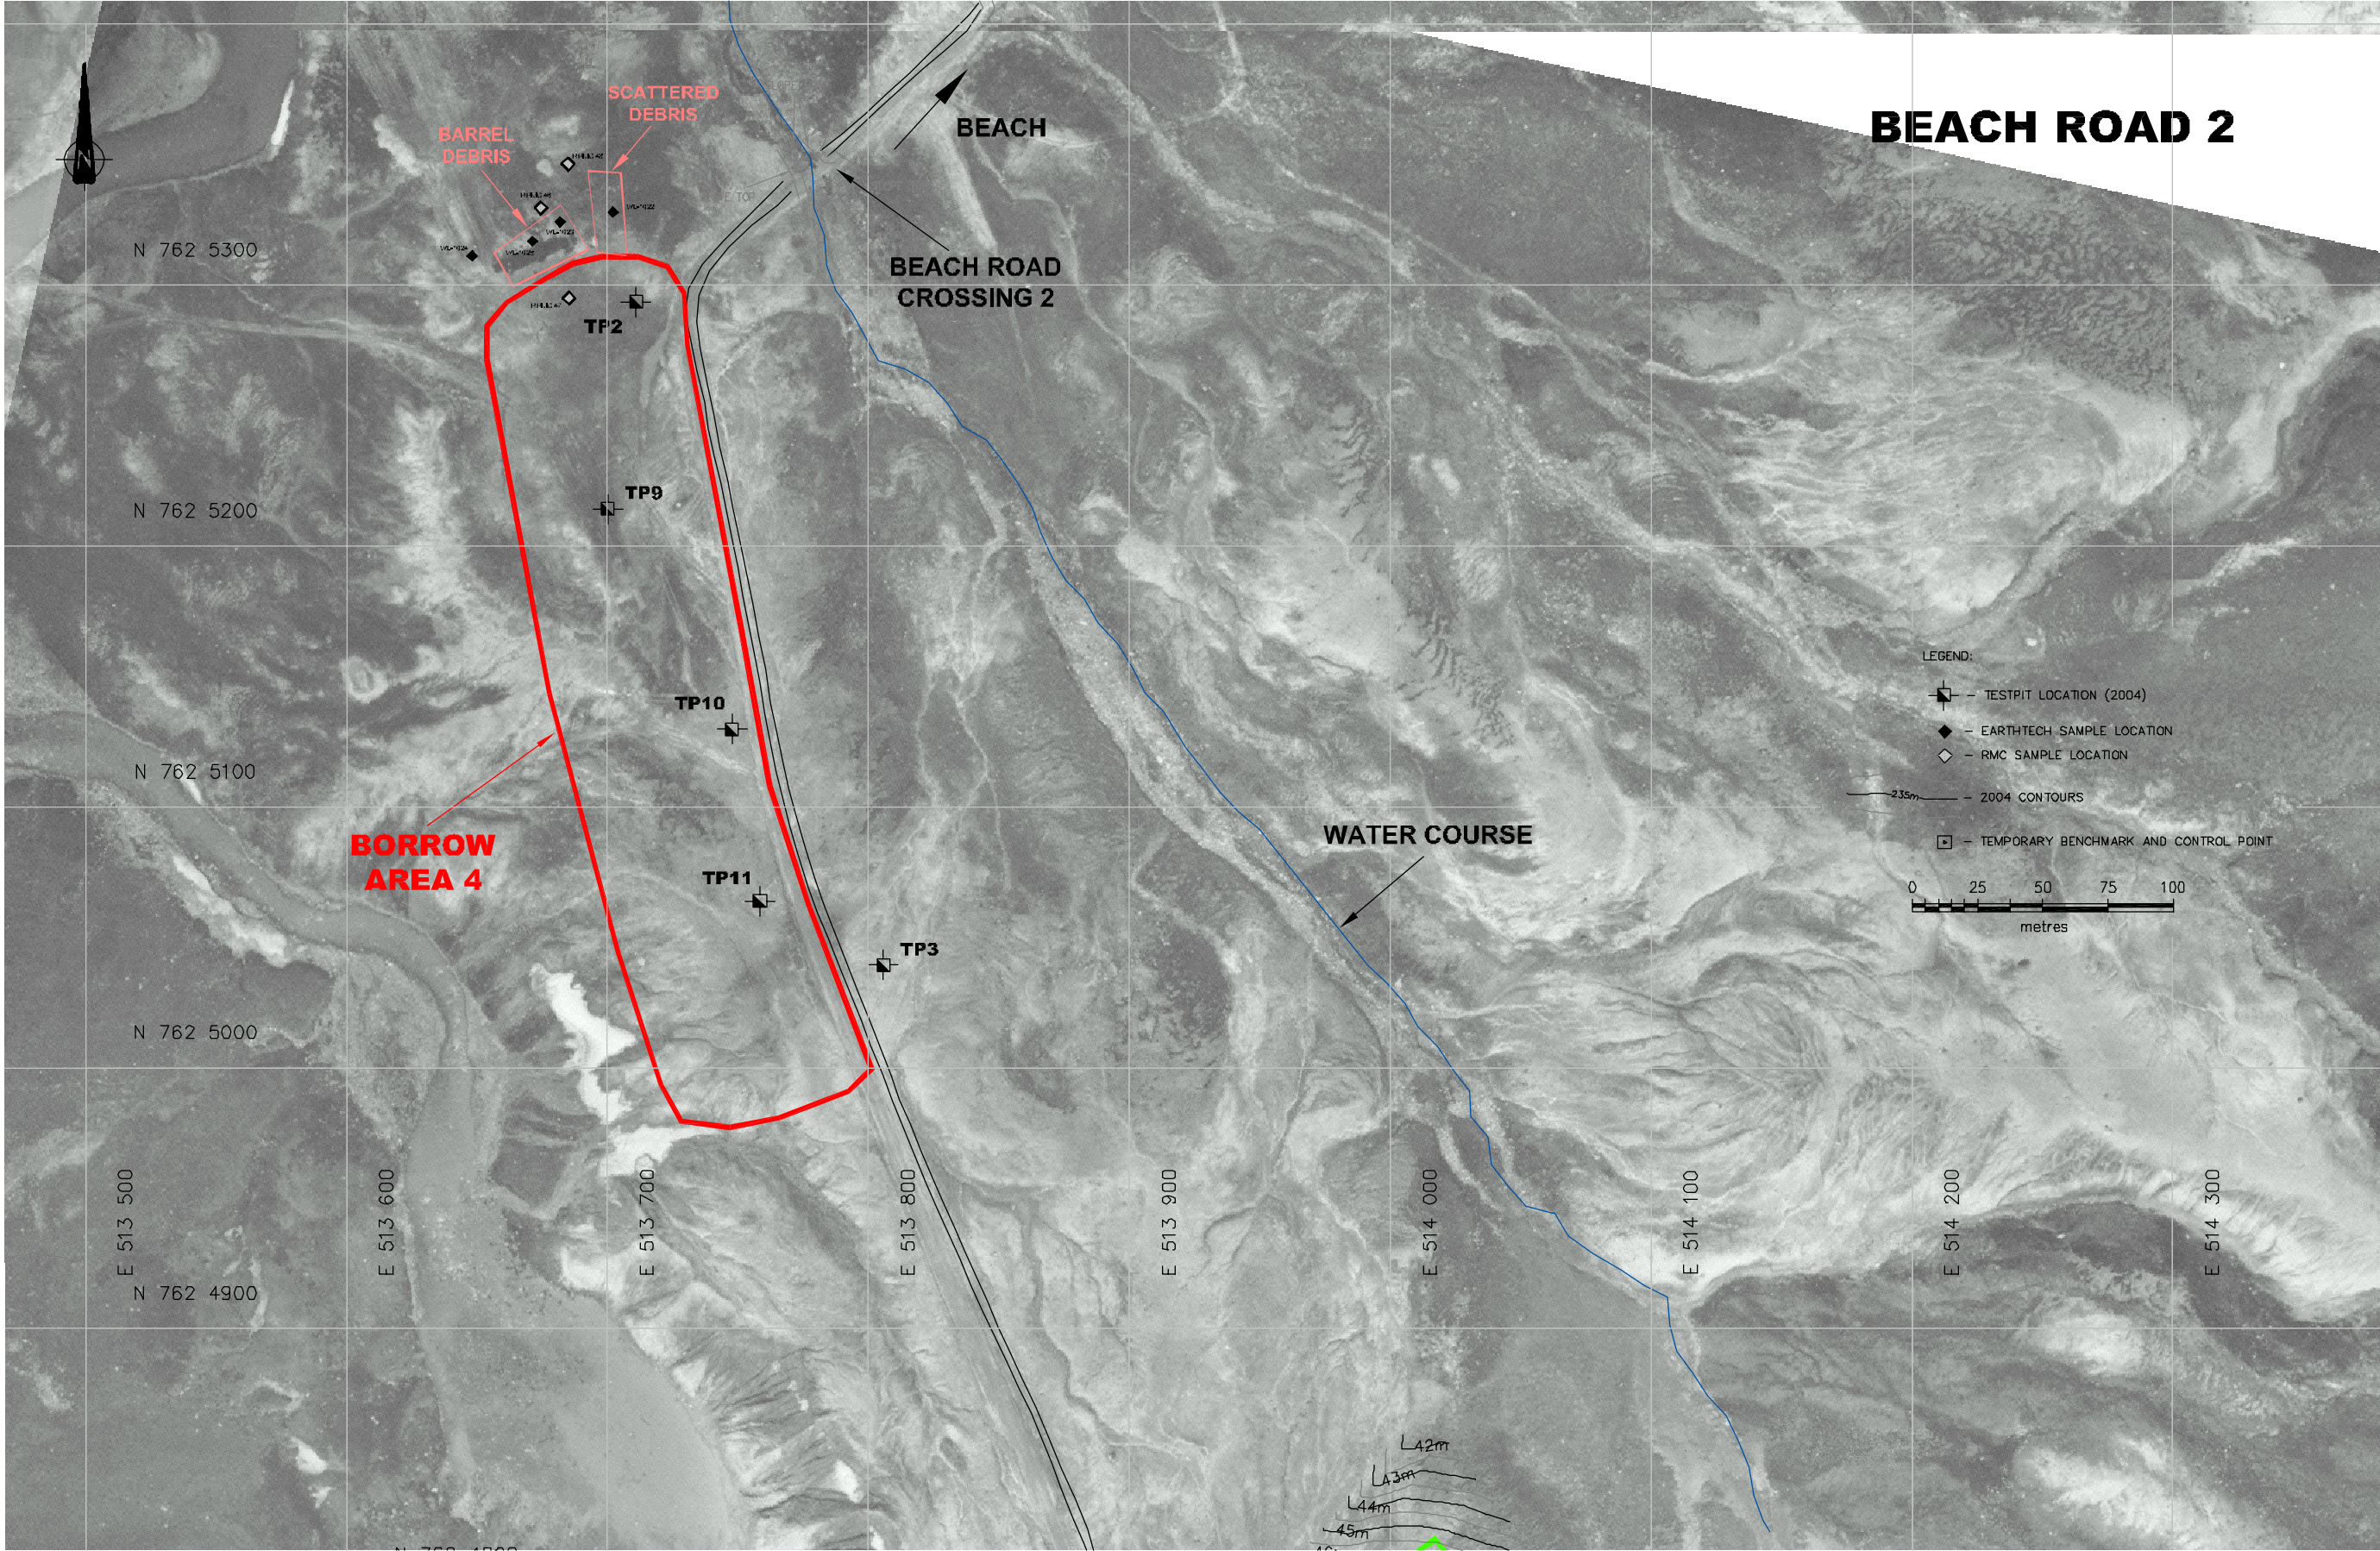

										DESIGNED BY: <u>WTH/AB</u>		PERMIT	SEAL	FOX-C EKALUGAD FJORD		
										DRAWN BY: <u>DED</u>				REVISION		
										DATE: <u>07/10/04</u>				0		
										SCALE: <u>AS SHOWN</u>				FIGURE		
										PROJECT No.: <u>0101-04-1100065.DOT</u>				12		
										ACAD FILENAME: <u>110006500100065.dwg</u>						
										ISSUED FOR REVIEW						
										DATE						
										APPROVED						
										DESCRIPTION						
										REVISION						
										DRAWING No.						
										REFERENCE DRAWINGS						

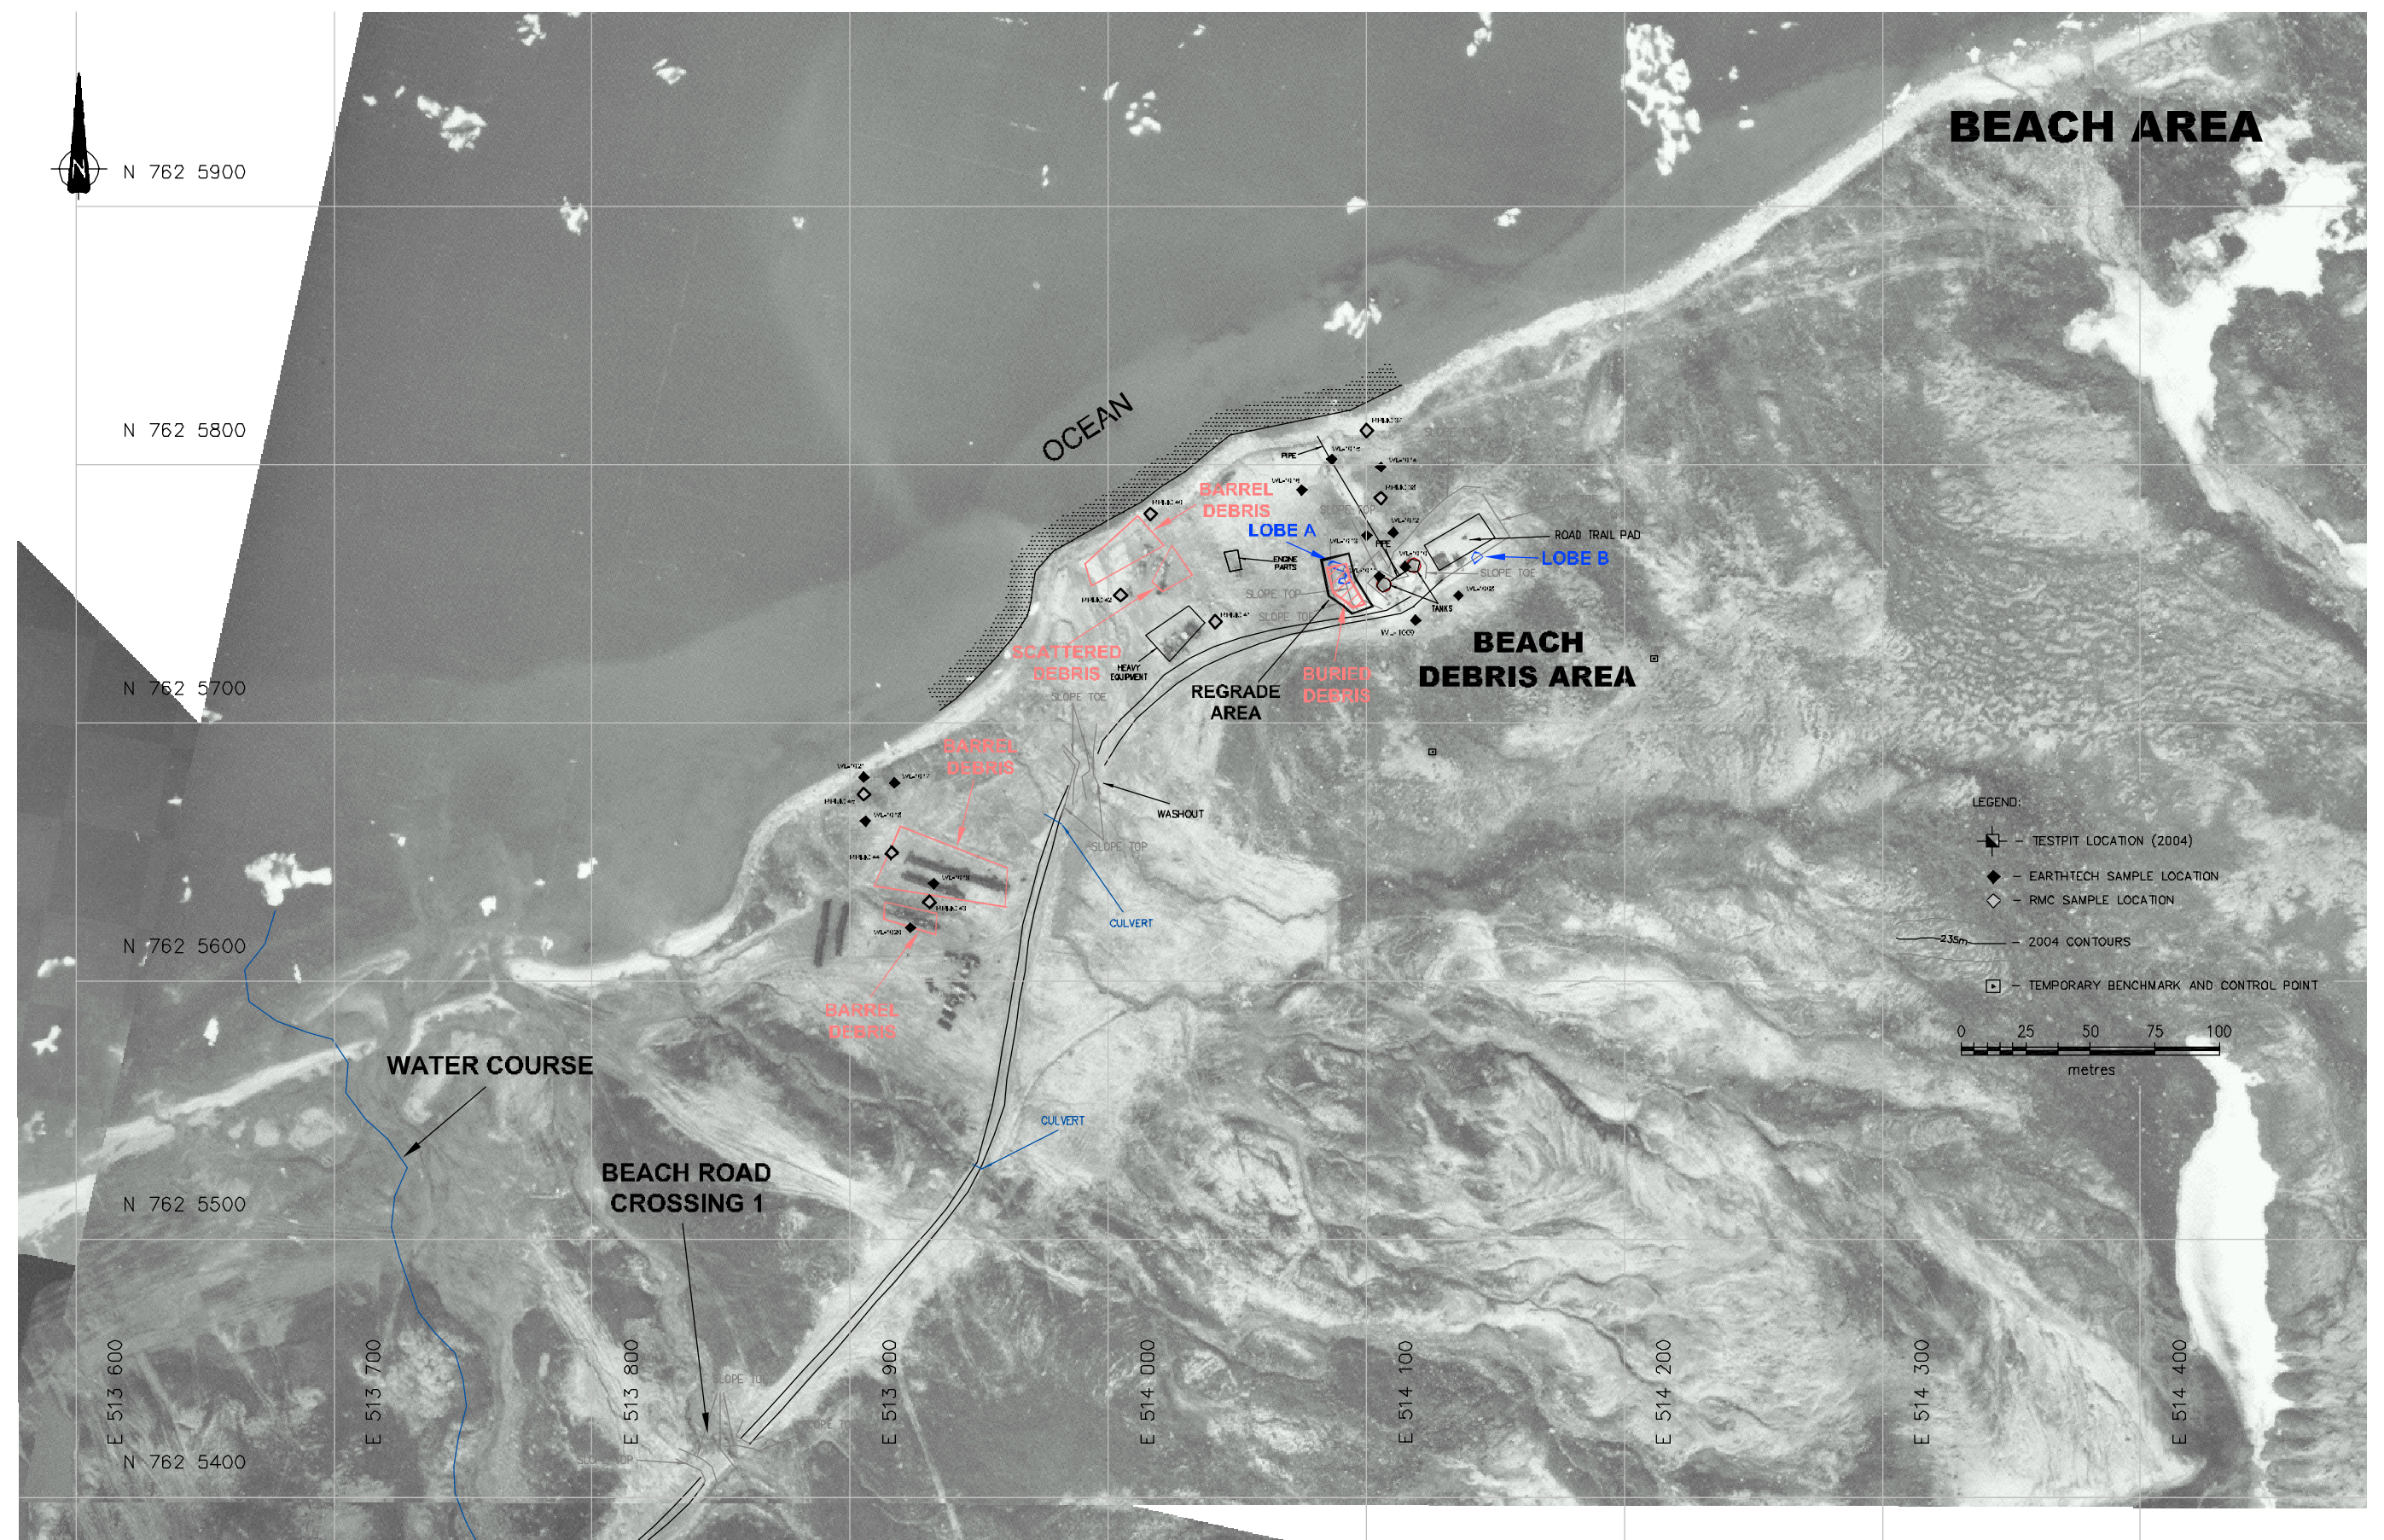[illegible]



N 762 5900

BEACH AREA

N 762 5800

N 762 5700

N 762 5600

N 762 5500

E 513 600

E 513 700

E 513 800

E 513 900

E 514 000

E 514 100

E 514 200

E 514 300

E 514 400

N 762 5400

WATER COURSE

BEACH ROAD CROSSING 1

OCEAN

SCATTERED DEBRIS

BARREL DEBRIS

BARREL DEBRIS

BARREL DEBRIS

LOBE A

BURIED DEBRIS

BEACH DEBRIS AREA

LOBE B

TANKS

REGRADE AREA

WASHOUT

CULVERT

CULVERT

SLOPE TOE

SLOPE TOP

PIPE

WL-1015

RRMIC 37

WL-1014

RRMIC 38

WL-1012

RRMIC 39

WL-1008

RRMIC 40

WL-1016

RRMIC 41

WL-1017

RRMIC 42

<

 N 762 5900

N 762 5700

N 762 5500

E 513 600

N 762 5400

E 513 700

WATER COURSE

E 513 800

BEACH ROAD CROSSING 1

E 513 900


E 514 000

E 514 100

E 514 200


E 514 300

E 514 400

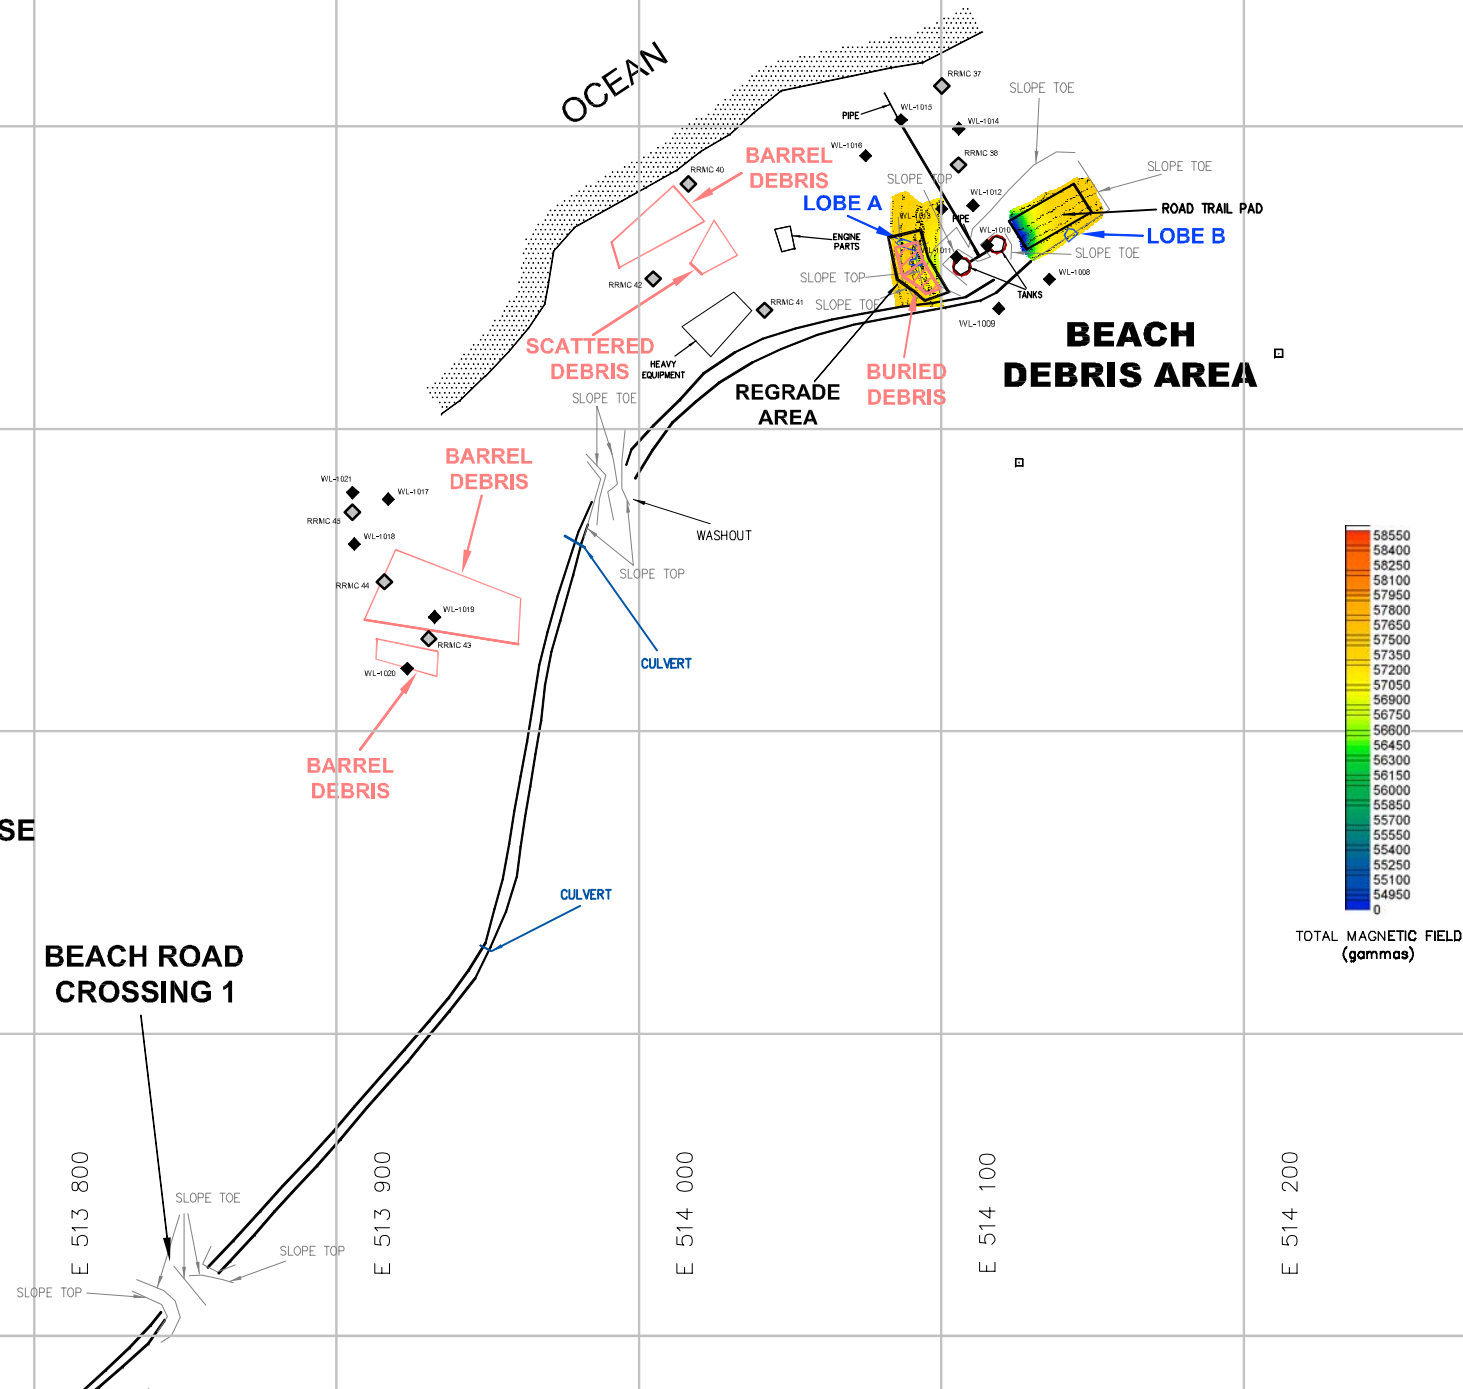TOTAL MAGNETIC FIELD
(gammas)

										 EBA Engineering Consultants Ltd.		 Public Works and Government Services Canada Travaux publics et Services gouvernementaux Canada		
										DESIGNED BY: <u>WTH/JB</u> DRAWN BY: <u>DEB</u> DATE: <u>07/10/04</u> SCALE: <u>AS SHOWN</u> PROJECT No.: <u>0101-04-1100065.001</u> ACQU. BY (NAME): <u>1100065001004.001</u>	PERMIT	SEAL	FOX-C EKALUGAD FJORD	
													BEACH AREA GEOPHYSICS TOP SENSOR READING	
												FIGURE 13C		

BEACH AREA

 

JORD	
REVISION	ISSUE
	0
FIGURE	13D