


PLAN

0 4 8 12m
4 2 1:200

| COORDINATE POINTS LANDFARM | | | |
|---|---|---|---|
| NO. | NORTHING | EASTING | ELEV. |
| D01 | 7 624 720.1 | 513 960.4 | 57.46 |
| D02 | 7 624 665.2 | 513 980.5 | 57.00 |
| D03 | 7 624 712.4 | 514 022.7 | 52.46 |
| D04 | 7 624 739.2 | 514 013.0 | 52.75 |

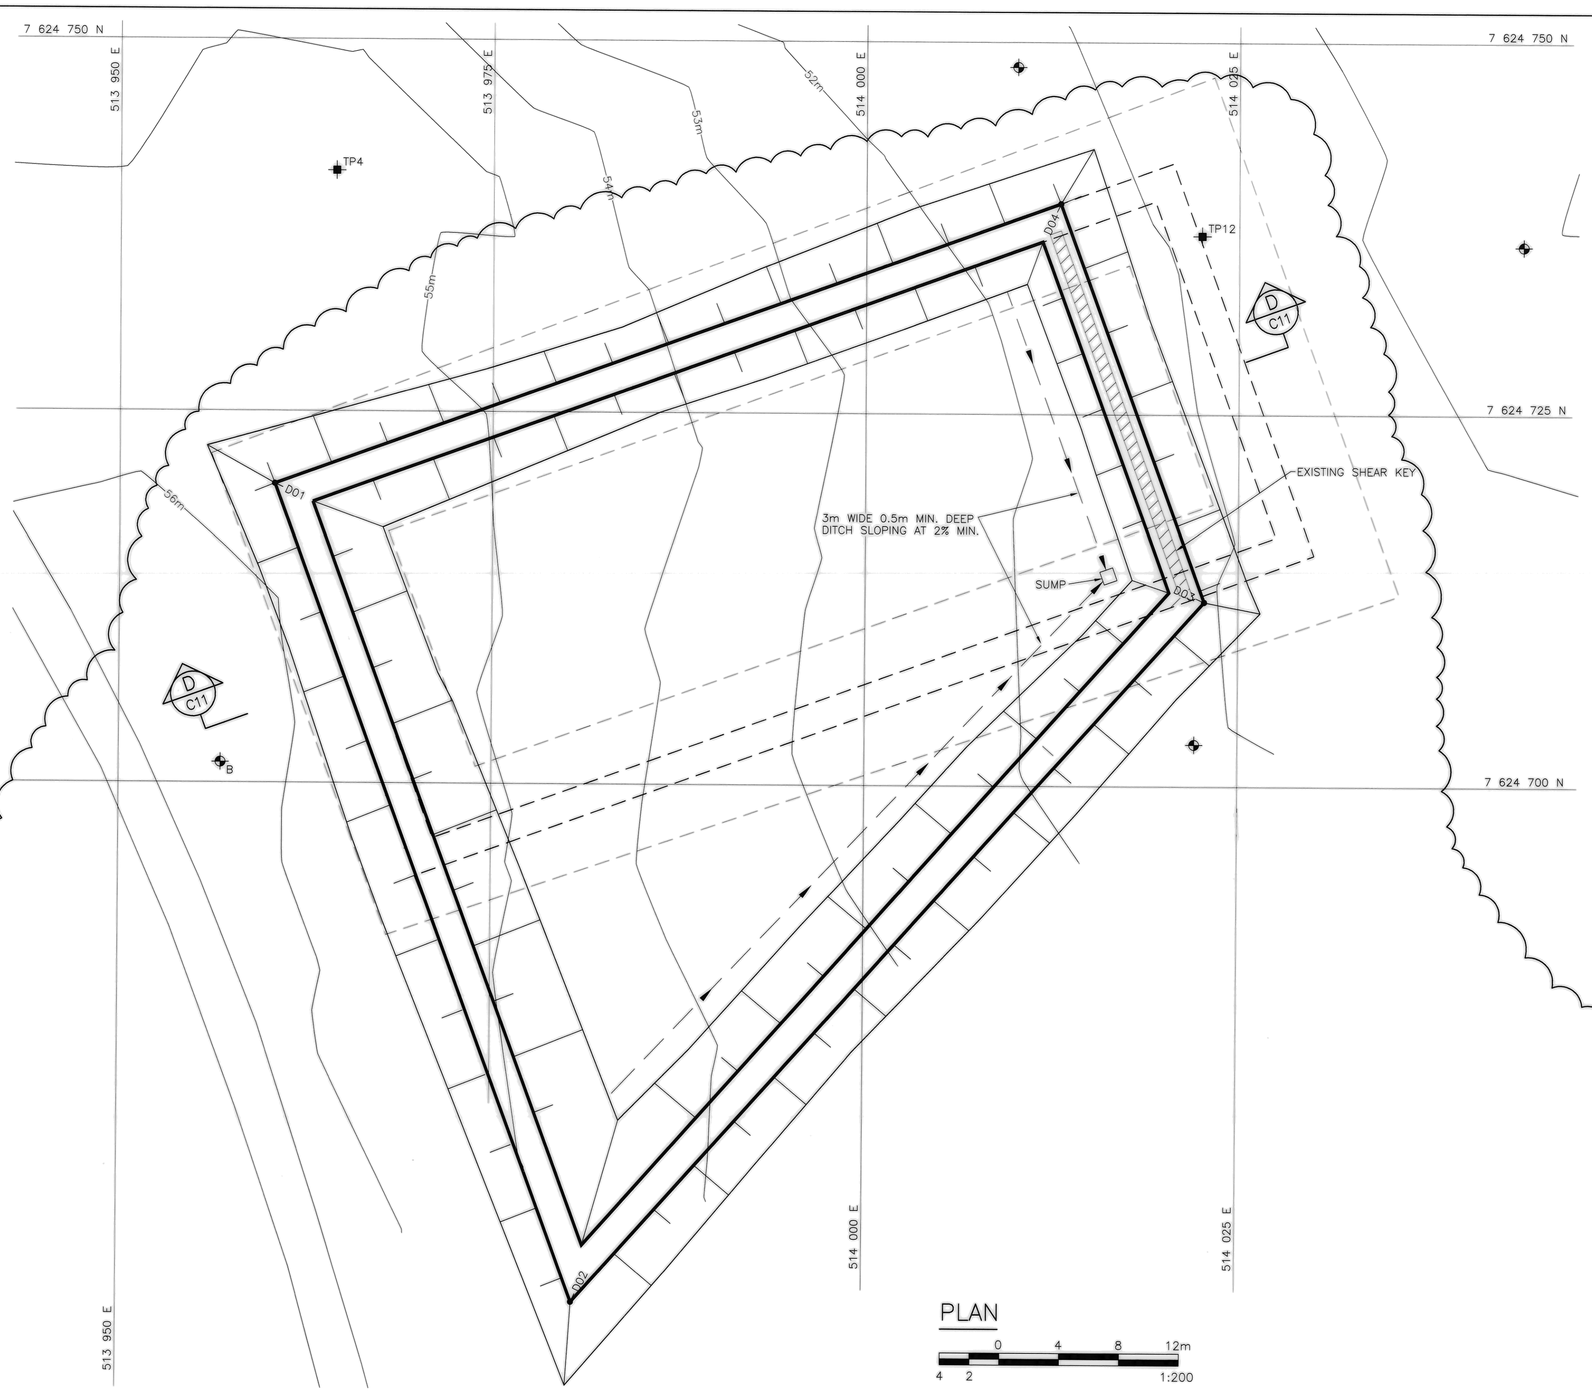


SECTION D C11

0 2 4 6m
2 1 1:100

Public Works and Government Services Canada / Travaux publics et Services gouvernementaux Canada

REAL PROPERTY SERVICES
Western Region

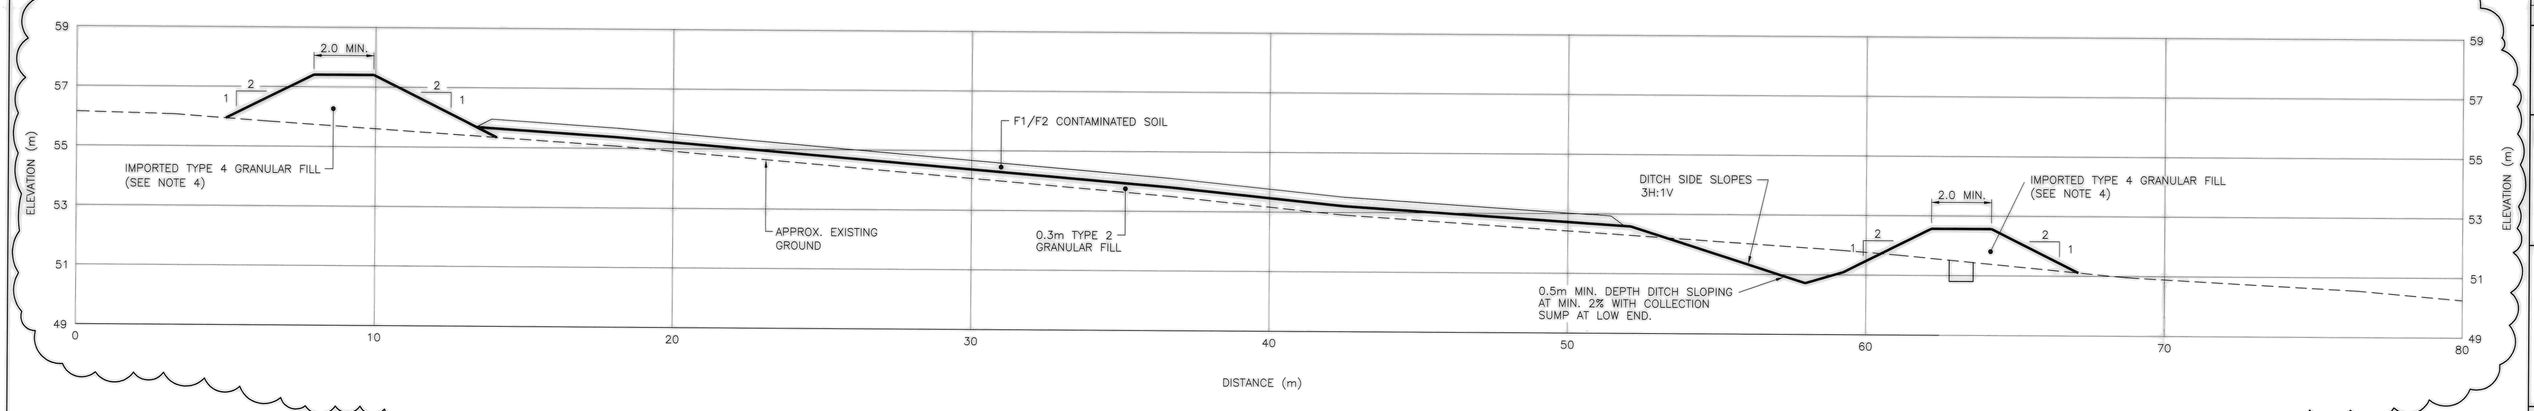Client: Indian and Northern Affairs Canada / Affaires indiennes et du Nord Canada
Canada

**Nunavut Regional Office**
**Iqaluit, Nunavut**

General Notes:

1. ALL COORDINATES ARE REFERENCED TO NAD83 CSRS, UTM ZONE 19. ELEVATIONS ARE REFERENCED TO MEAN SEA LEVEL, RELATIVE TO GEOID MODEL EGM96.
2. ALL DIMENSIONS ARE IN METRES UNLESS NOTED OTHERWISE.
3. REMOVE ALL SURFICIAL BOULDERS FROM LANDFARM CONSTRUCTION AREA.
4. TYPE 4 GRANULAR FILL FOR THE LANDFARM BERMS IS NOT REQUIRED TO BE SATURATED. PROVIDE MOISTURE CONDITIONING TO MEET COMPACTION REQUIREMENTS ONLY.
5. FOR MONITORING WELL INSTALLATION DETAILS, SEE DWG. C16. EXACT LOCATIONS TO BE FIELD DETERMINED BY THE ENGINEER.

Legend:

- TEST PIT LOCATION
- D01 COORDINATE POINT
- PROPOSED MONOTORING WELL LOCATION (3)
- B PROPOSED BACKGROUND MONITORING WELL LOCATION (1)

REGISTERED PROFESSIONAL ENGINEER
R.H. SCHMIDTKE
LICENSEE
N.W.T.

THE ASSOCIATION OF PROFESSIONAL ENGINEERS, GEOLOGISTS and GEOPHYSICISTS OF THE NORTHWEST TERRITORIES
PERMIT NUMBER
P 007
UMA ENGINEERING LTD.

uma
An AECOM Company

| REVISIONS | DESCRIPTION | DATE |
|---|---|---|
| 1 | REVISED LANDFARM | 06/08/21 |
| 0 | ISSUED FOR CONSTRUCTION | 05/07/25 |

A detail number / number du detail
B source drawing no. / de dessin no.
C detail on drawing no. / detail sur dessin no.

project title / titre du projet
**FOX-C Intermediate DEW Line Site**
**EKALUGAD FIORD**
**Site Restoration**

**Nunavut**

drawing title / titre du dessin
**LANDFARM**
**PLAN AND CROSS SECTION**

designed by / conçu par: B. FEDORAK
drawn by / dessiné par: M. MOTIUK
approved by / approuvé par: R. SCHMIDTKE
PWGSC Project Manager / Administrateur de Projets TPSGC: B. THOMPSON
scale / échelle: AS SHOWN
project no. / projet no.: 413759
date: AUGUST, 2006
sheet / feuille: C11 OF 16

413759-C11.DWG

91 1000 x 707