


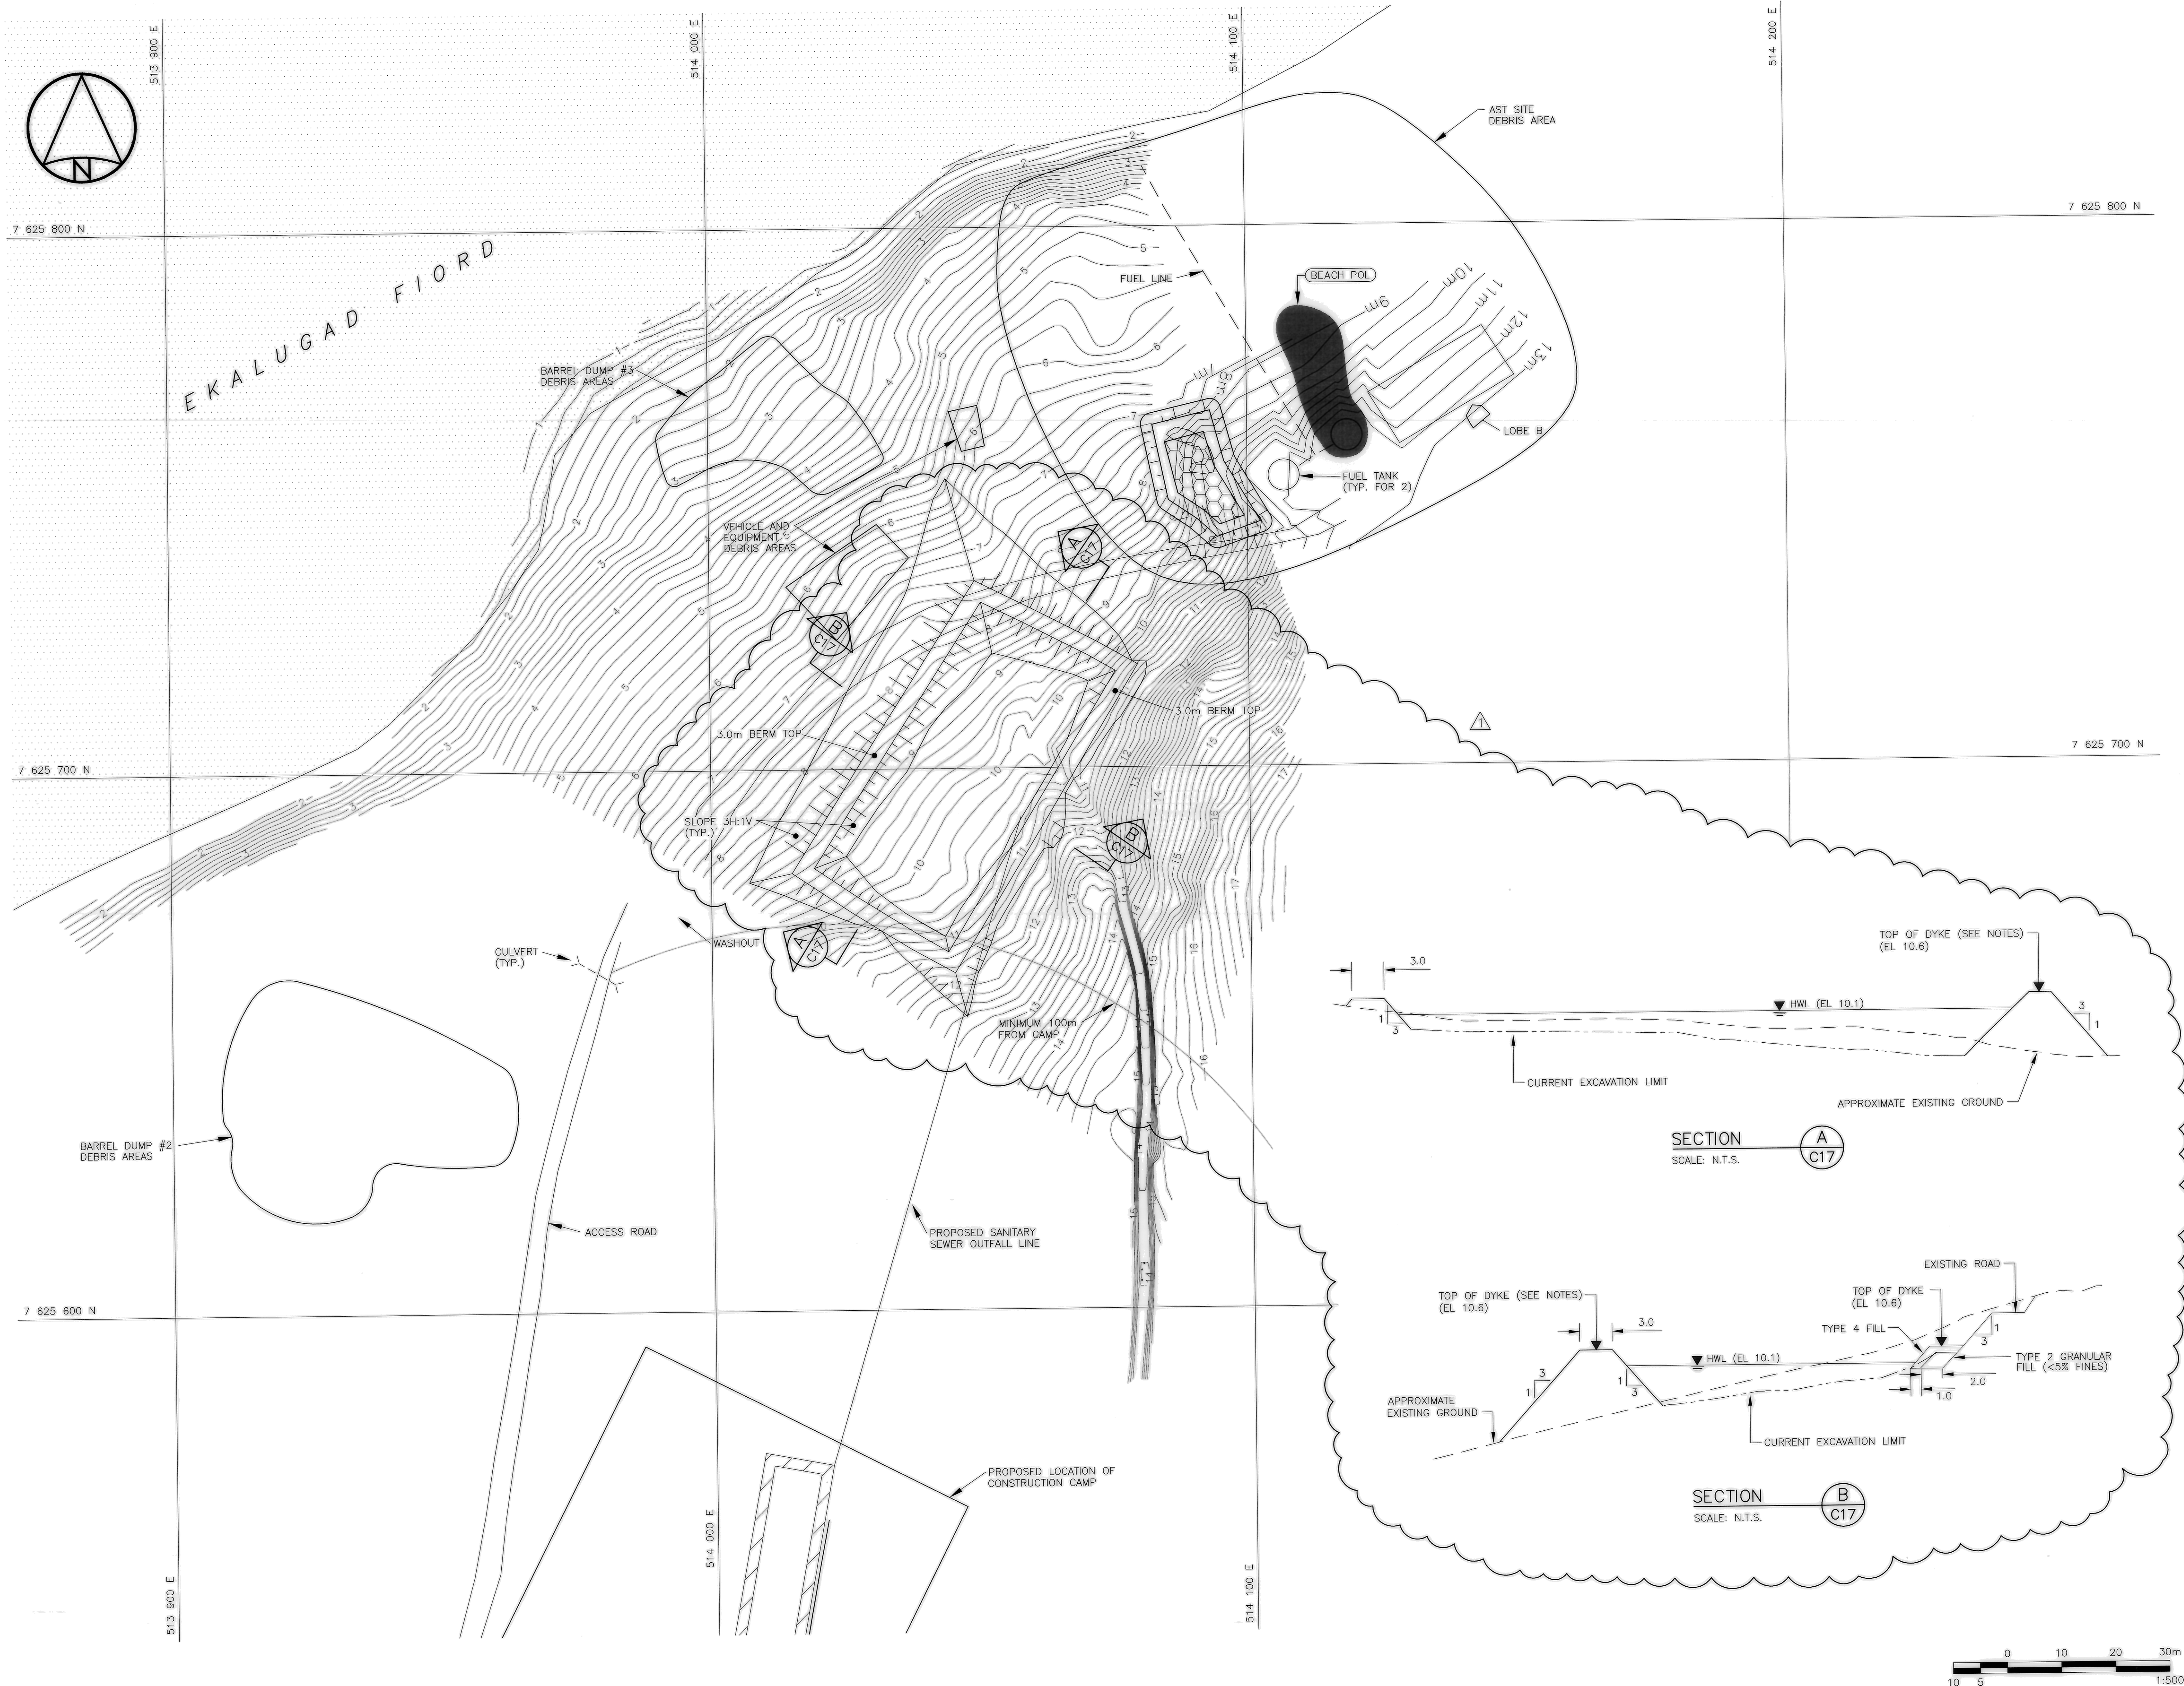

Public Works and
Government Services
Canada

Travaux publics et
Services gouvernementaux
Canada

REAL PROPERTY SERVICES
Western Region

Indian and Northern
Affairs Canada

Affaires indiennes
et du Nord Canada

Canada
Nunavut Regional Office
Iqaluit, Nunavut

Client Client

General Notes:
1. ALL COORDINATES ARE REFERENCED TO NAD83 CSRS, UTM ZONE 19. ELEVATIONS ARE REFERENCED TO MEAN SEA LEVEL, RELATIVE TO GEOD MODEL EGM96.
2. SITE PLANS AND TOPOGRAPHIC INFORMATION ARE BASED ON AIR PHOTOS AND SURVEYS. CURRENT CONDITIONS MAY NOT BE EXACTLY AS SHOWN.
3. ALL DIMENSIONS ARE IN METRES UNLESS NOTED OTHERWISE.
4. SEWAGE LAGOON TO BE LOCATED A MINIMUM OF 100m FROM CONSTRUCTION CAMP AND WATER BODY CONTAINING AQUATIC LIFE.
5. BERMS TO BE CONSTRUCTED OF TYPE 9 MATERIAL PLACED AND TRACK PACKED IN 0.5m THICK LIFTS
6. EXCESS MATERIAL FROM EXCAVATION OF LAGOON TO BE STOCKPILED FOR FUTURE USE IN LAGOON CLOSURE.

Legend:
 PHC CONTAMINATION
 BODY OF WATER
 GEOPHYSICAL ANOMALY

THE ASSOCIATION OF
PROFESSIONAL ENGINEERS,
GEOLOGISTS and GEOPHYSICISTS
OF THE NORTHWEST TERRITORIES
PERMIT NUMBER
P 007
UMA ENGINEERING
LTD.

An AECOM Company

REVISION	DESCRIPTION	DATE
1	REVISED LAGOON DESIGN/LOCATION	06/08/16
0	ISSUED FOR CONSTRUCTION	08/01/16

A

C

A detail number -
number: du détail

B

B source drawing no.
de dessin no.

C

C detail on drawing no.
détail sur dessin no.

project title
**FOX-C Intermediate DEW Line Site
EKALUGAD FIORD
Site Restoration**
Nunavut

drawing title
**SEWAGE LAGOON
SITE PLAN**

designed by
D. GILBERTSON

drawn by
M. MOTIUK

approved by
R. SCHMIDTKE

PROJECT Project Manager
B. THOMPSON

scale
1:500

project no.
413759

date
AUGUST, 2006

sheet
C17

feuille
OF 17