



G:\CD2655\FINAL\FOX-3\2013\CD2655_320_323_101-FOX-3_D.dwg, PL, 2014-01-28 1:39:25 PM

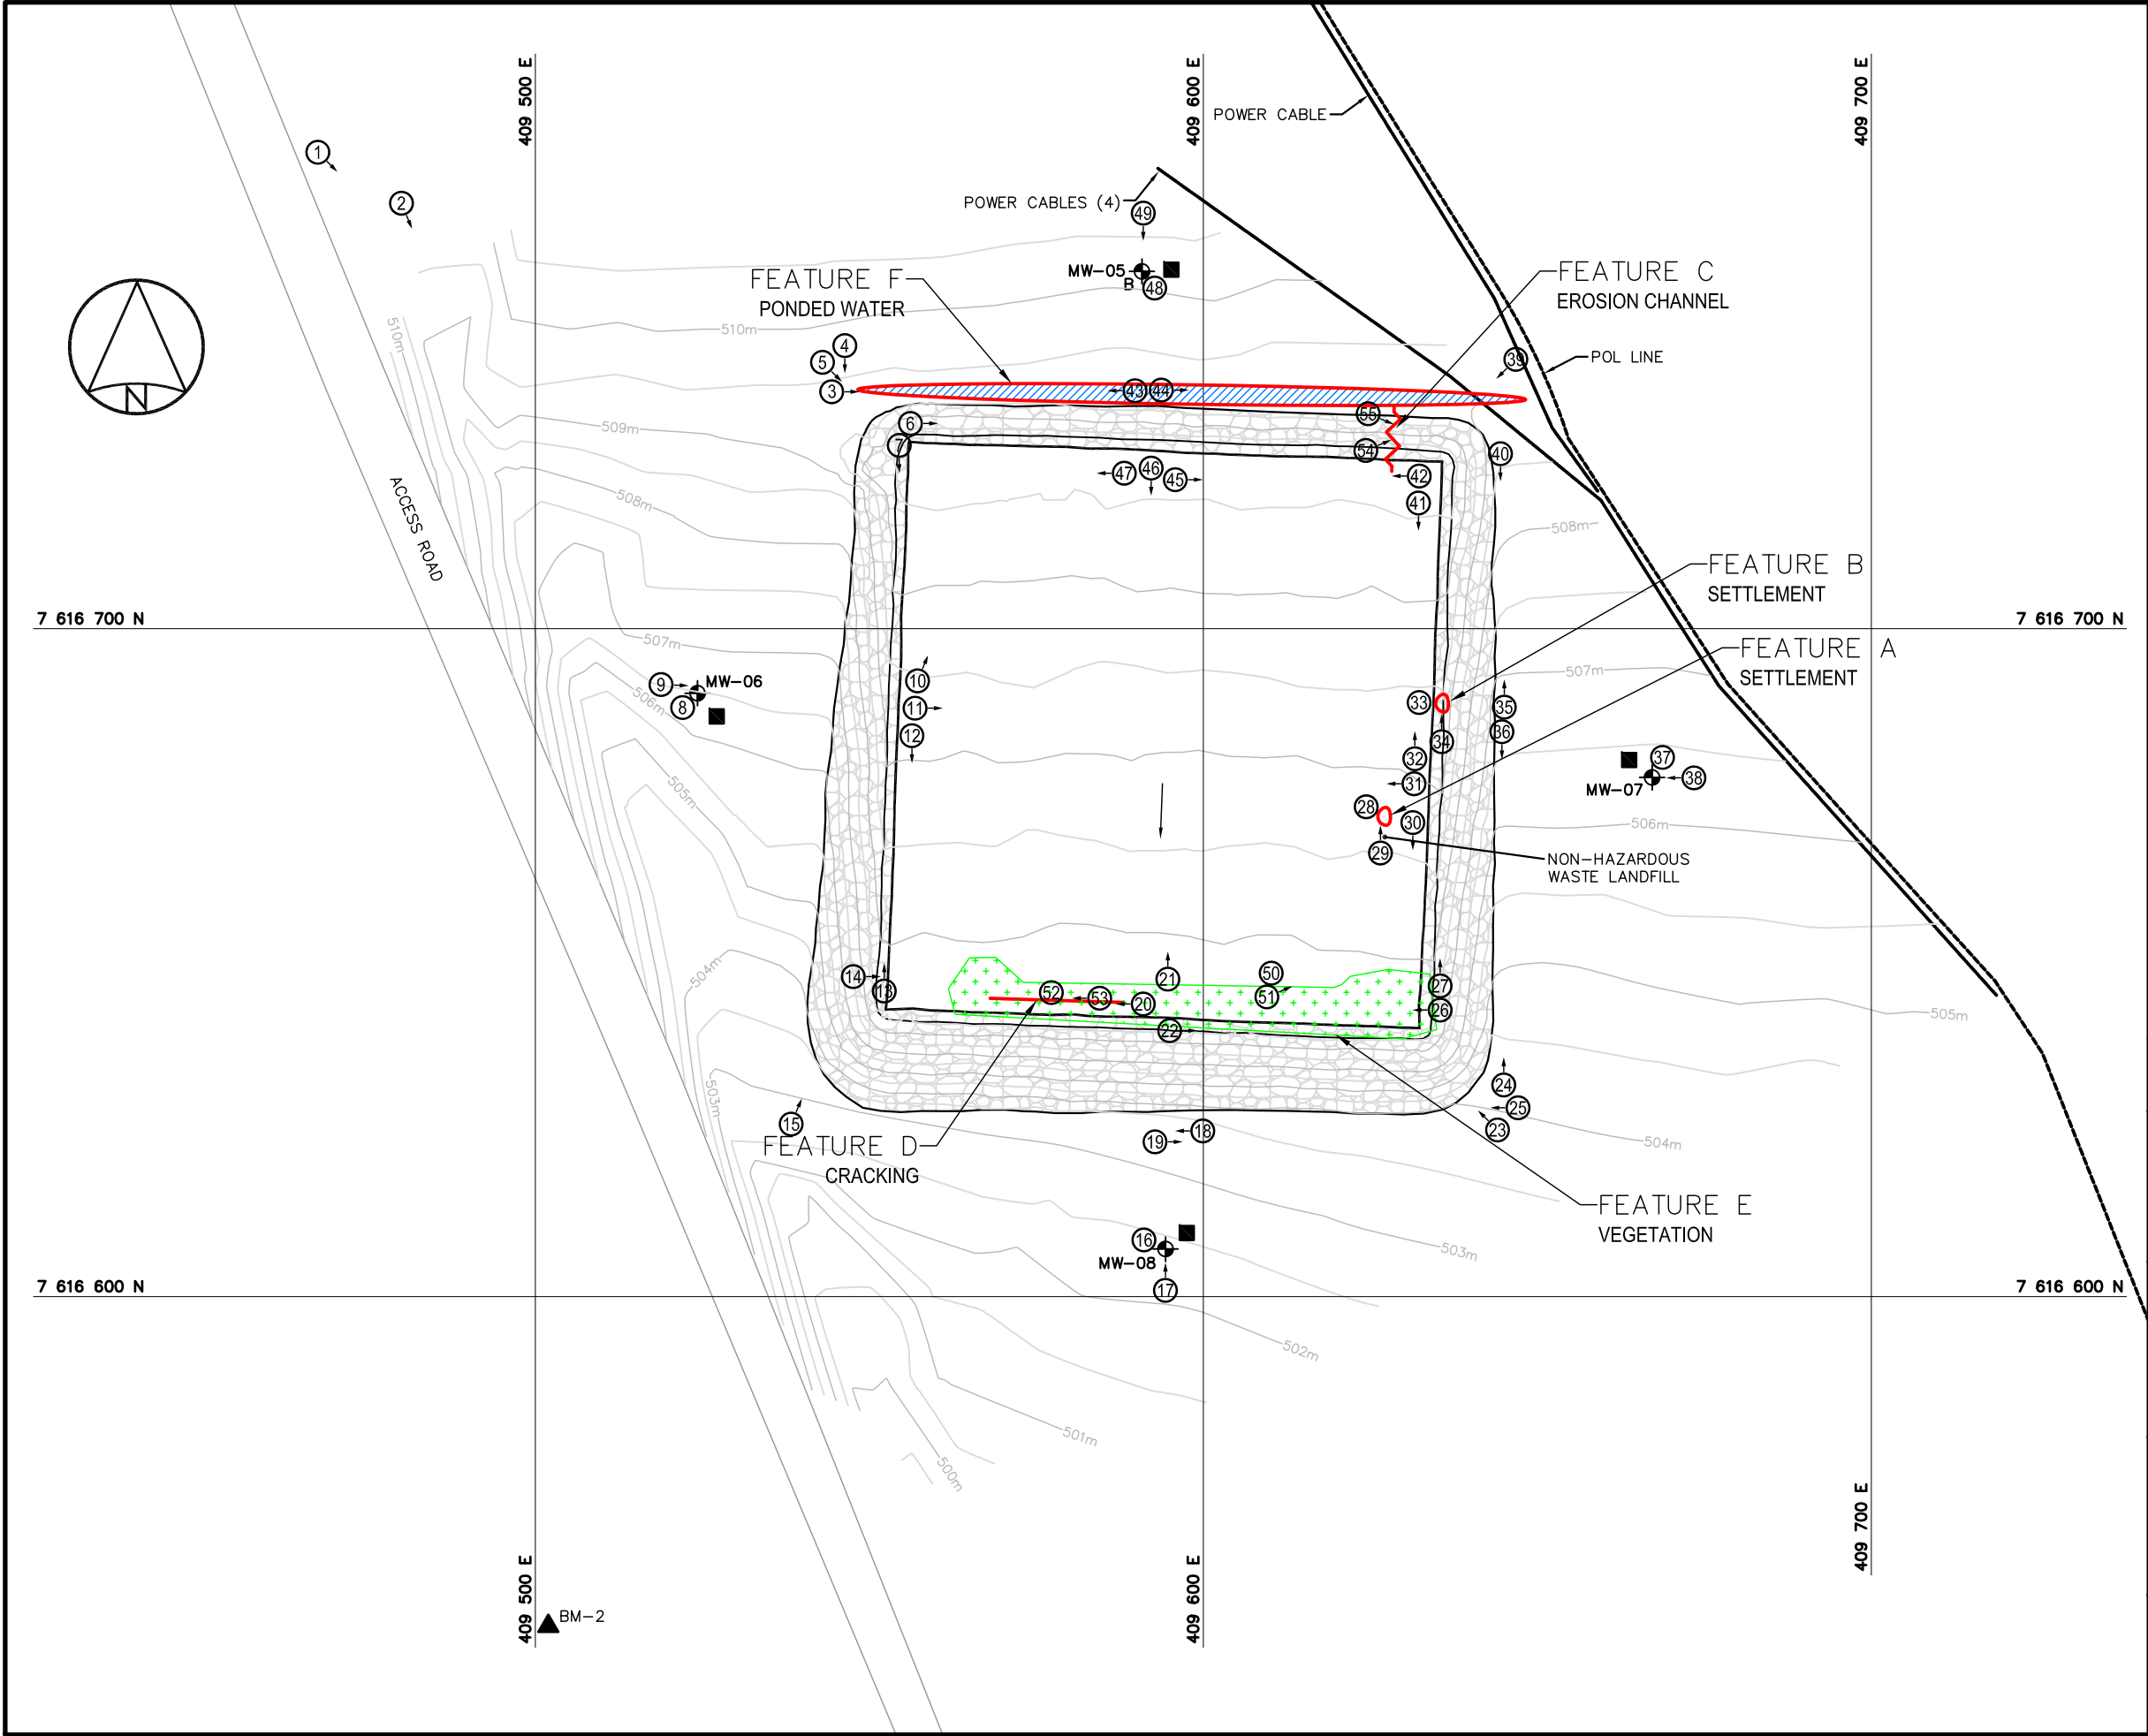

LEGEND

- MONITORING WELL LOCATION
- PERMANENT BENCHMARK LOCATION
- SOIL SAMPLING LOCATION
- PHOTOGRAPH VIEWPOINT LOCATION
- SETTLEMENT (NTS)
- PONDED WATER
- EROSION (NTS)
- VEGETATION
- CRACK (NTS)

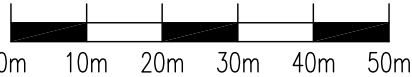

A	FINAL	14-01-23	P.L.	B.M.	A.L.
NO.	VERSION	DATE	BY	VERIF.	APPR.



COLLECTION OF
LANDFILL MONITORING DATA
FOX-3, DEWAR LAKES, NUNAVUT
NON-HAZARDOUS
WASTE LANDFILL

SITE REMEDIATION SOLUTIONS

Biogenie, a division of EnGlobe Corp.
4495 Wilfrid-Hamel blvd, Suite 200
Quebec, (Quebec) CANADA G1P 2J7
Phone : 418-653-4422 www.biogenie-env.com



MEASUREMENT UNIT Meter	SCALE: 1 : 1,000	DATE (month-year): JANUARY 2014
DRAWN BY: P. LÉGARÉ	VERIFIED BY: B. MACKAY	APPROVED BY: A. LECLAIR P. Eng.
PROJECT NO: CD2655_320_323	DRAWING NO: CD2655_320_323_101-FOX-3_B	PAGE PL

FIGURE FOX-3-4