



G:\CD2655\FINAL\FOX-3\2013\CD2655_320_323_101-FOX-3_E.dwg, PL 2014-01-28 1:42:01 PM

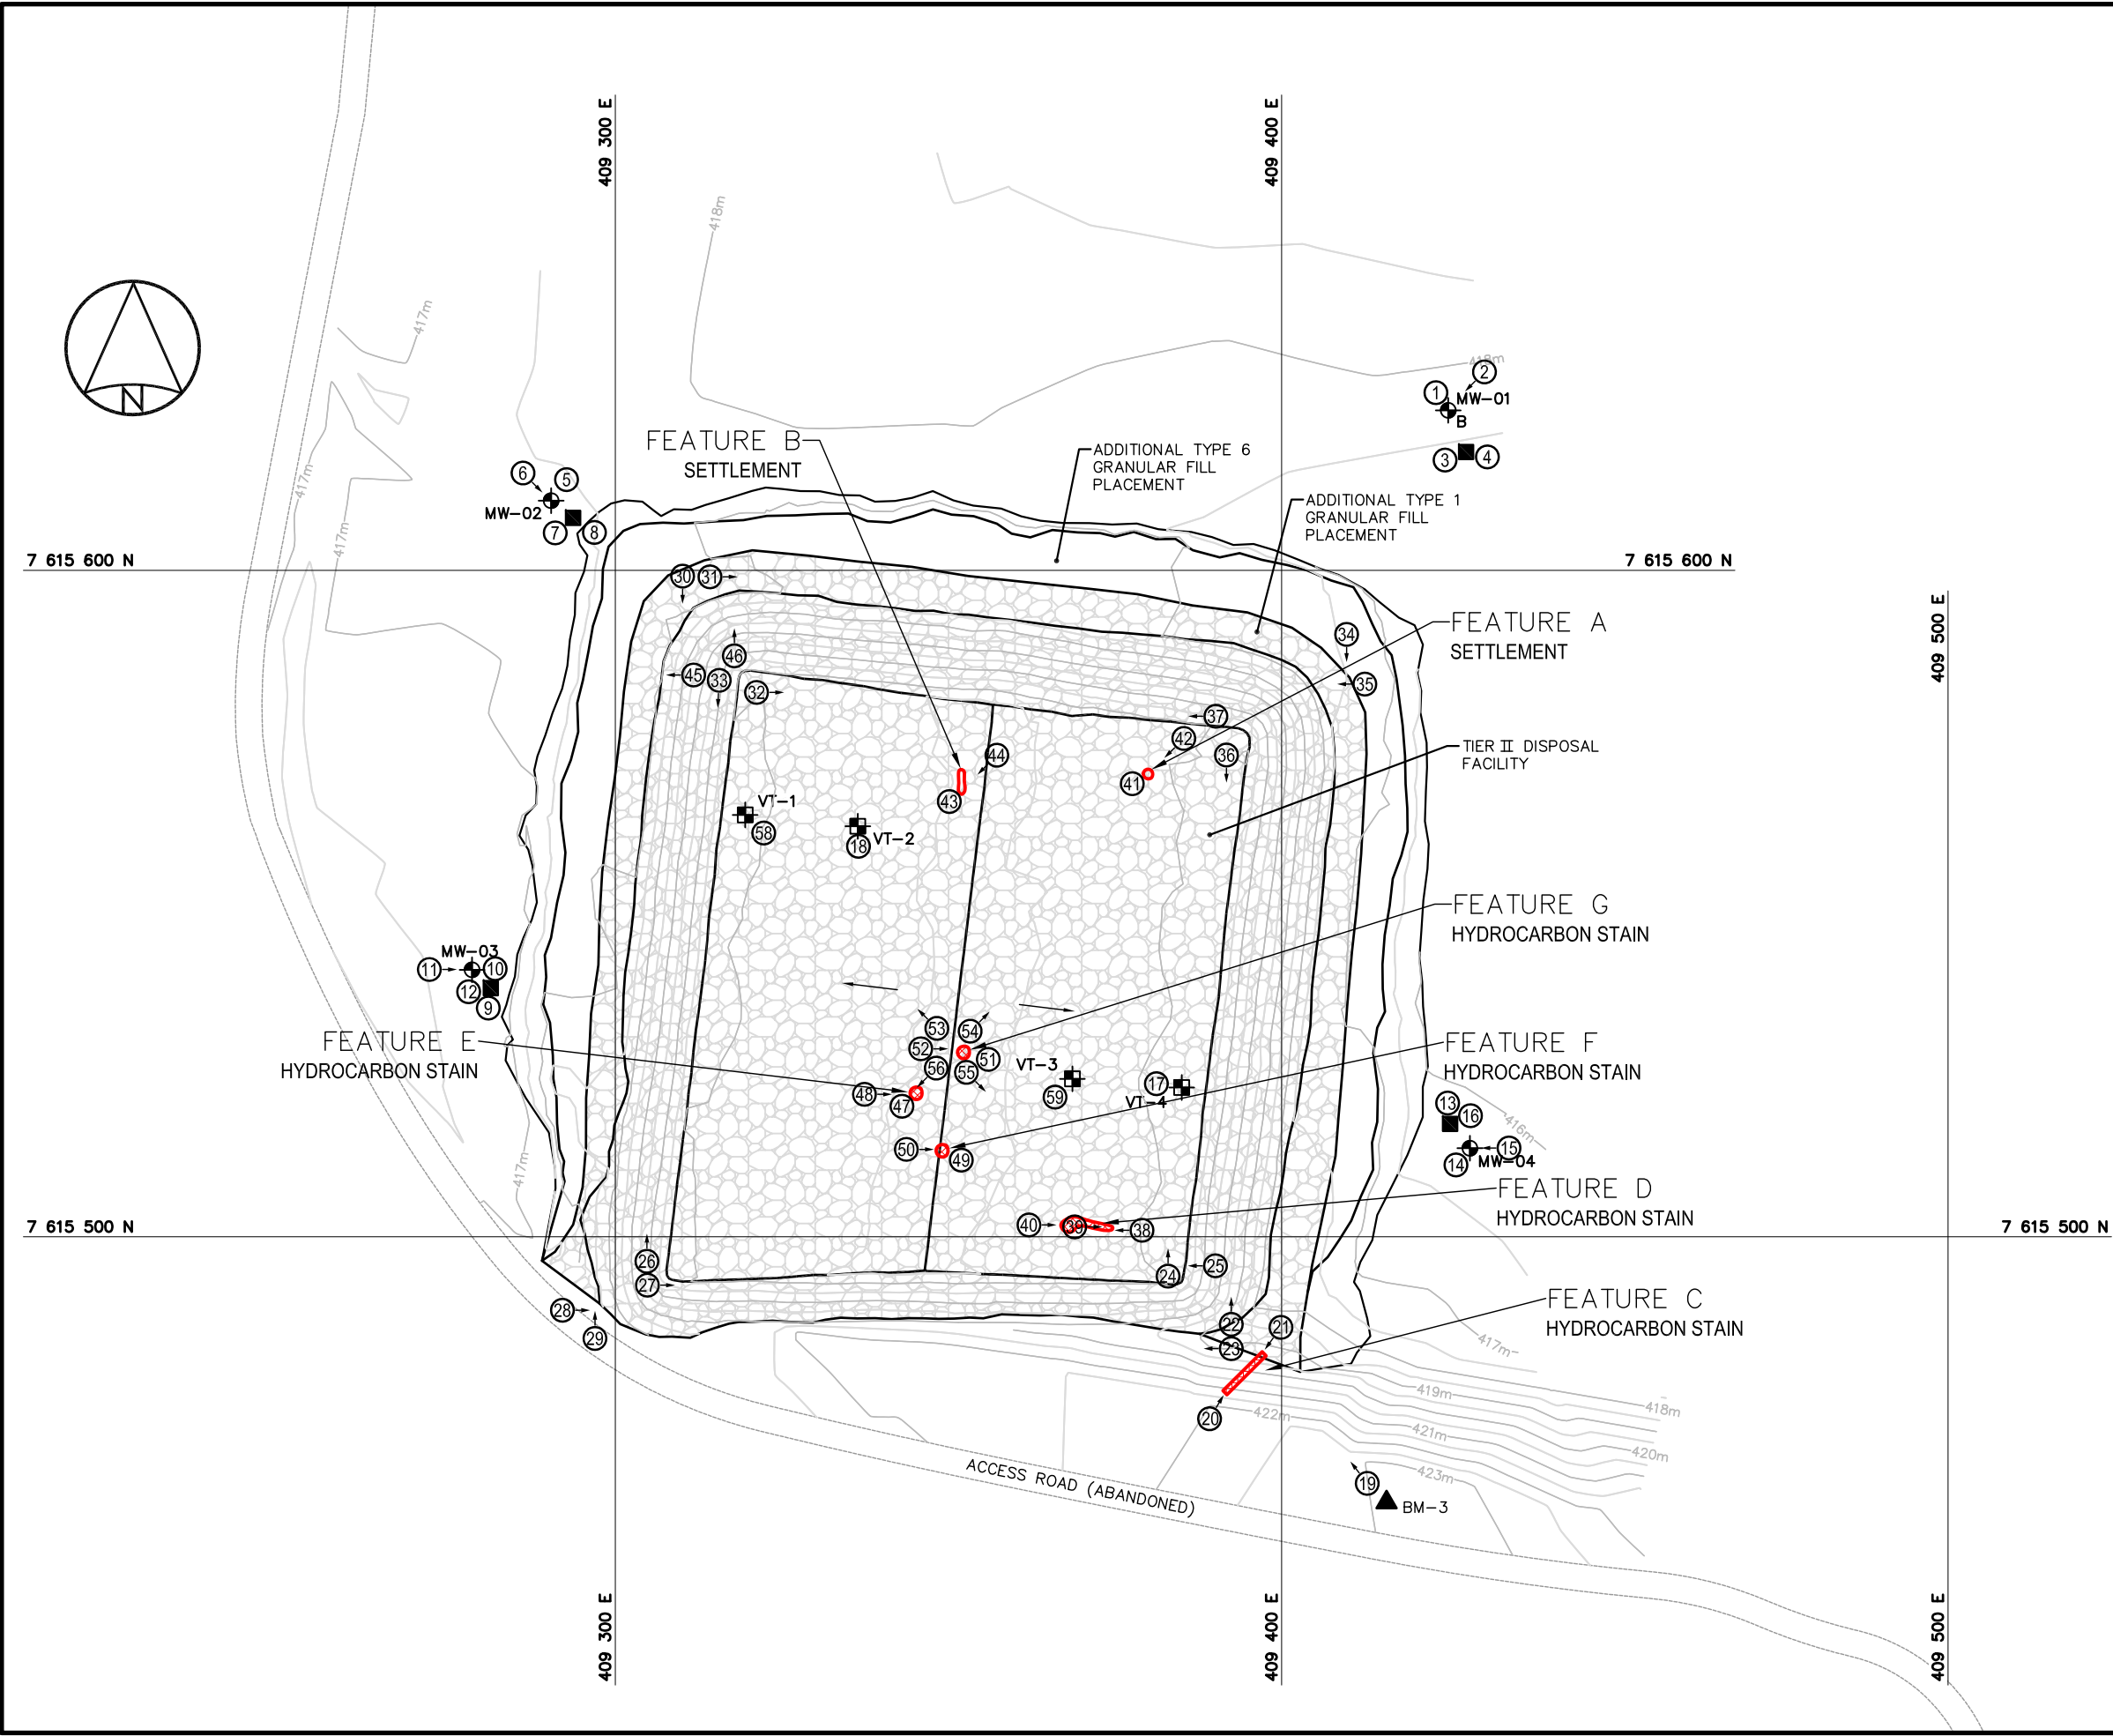

LEGEND

- MONITORING WELL LOCATION
- BACKGROUND MONITORING WELL LOCATION
- GROUND TEMPERATURE CABLE LOCATION
- PERMANENT BENCHMARK LOCATION
- SOIL SAMPLING LOCATION
- PHOTOGRAPH VIEWPOINT LOCATION
- SETTLEMENT (NTS)
- STAINING

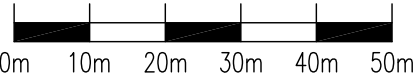

A	FINAL	14-01-28	P.L.	B.M.	A.L.
NO.	VERSION	DATE	BY	VERIF.	APPR.



COLLECTION OF LANDFILL MONITORING DATA FOX-3, DEWAR LAKES, NUNAVUT TIER II DISPOSAL FACILITY

SITE REMEDIATION SOLUTIONS

Biogenie, a division of EnGlobe Corp.
4495 Wilfrid-Hamel Blvd, Suite 200
Quebec, (Quebec) CANADA G1P 2J7
Phone : 418-653-4422 www.biogenie-env.com



MEASUREMENT UNIT Meter	SCALE: 1 : 1,000	DATE (month-year): JANUARY 2014
DRAWN BY: P. LÉGARÉ	VERIFIED BY: B. MACKAY	APPROVED BY: A. LECLAIR P. Eng.
PROJECT NO: CD2655_320_323	DRAWING NO: CD2655_320_323_101-FOX-3_E	PAGE PL

FIGURE FOX-3-5