

(Q)

7 596 100 N

PLOT: December 4, 2013 9:12:02 AM

Saved by: Cechi

N
FOX 4 L

8
E

7 596 000 N


COM

588 550 E

588 600 E

588 650 E

F4-25

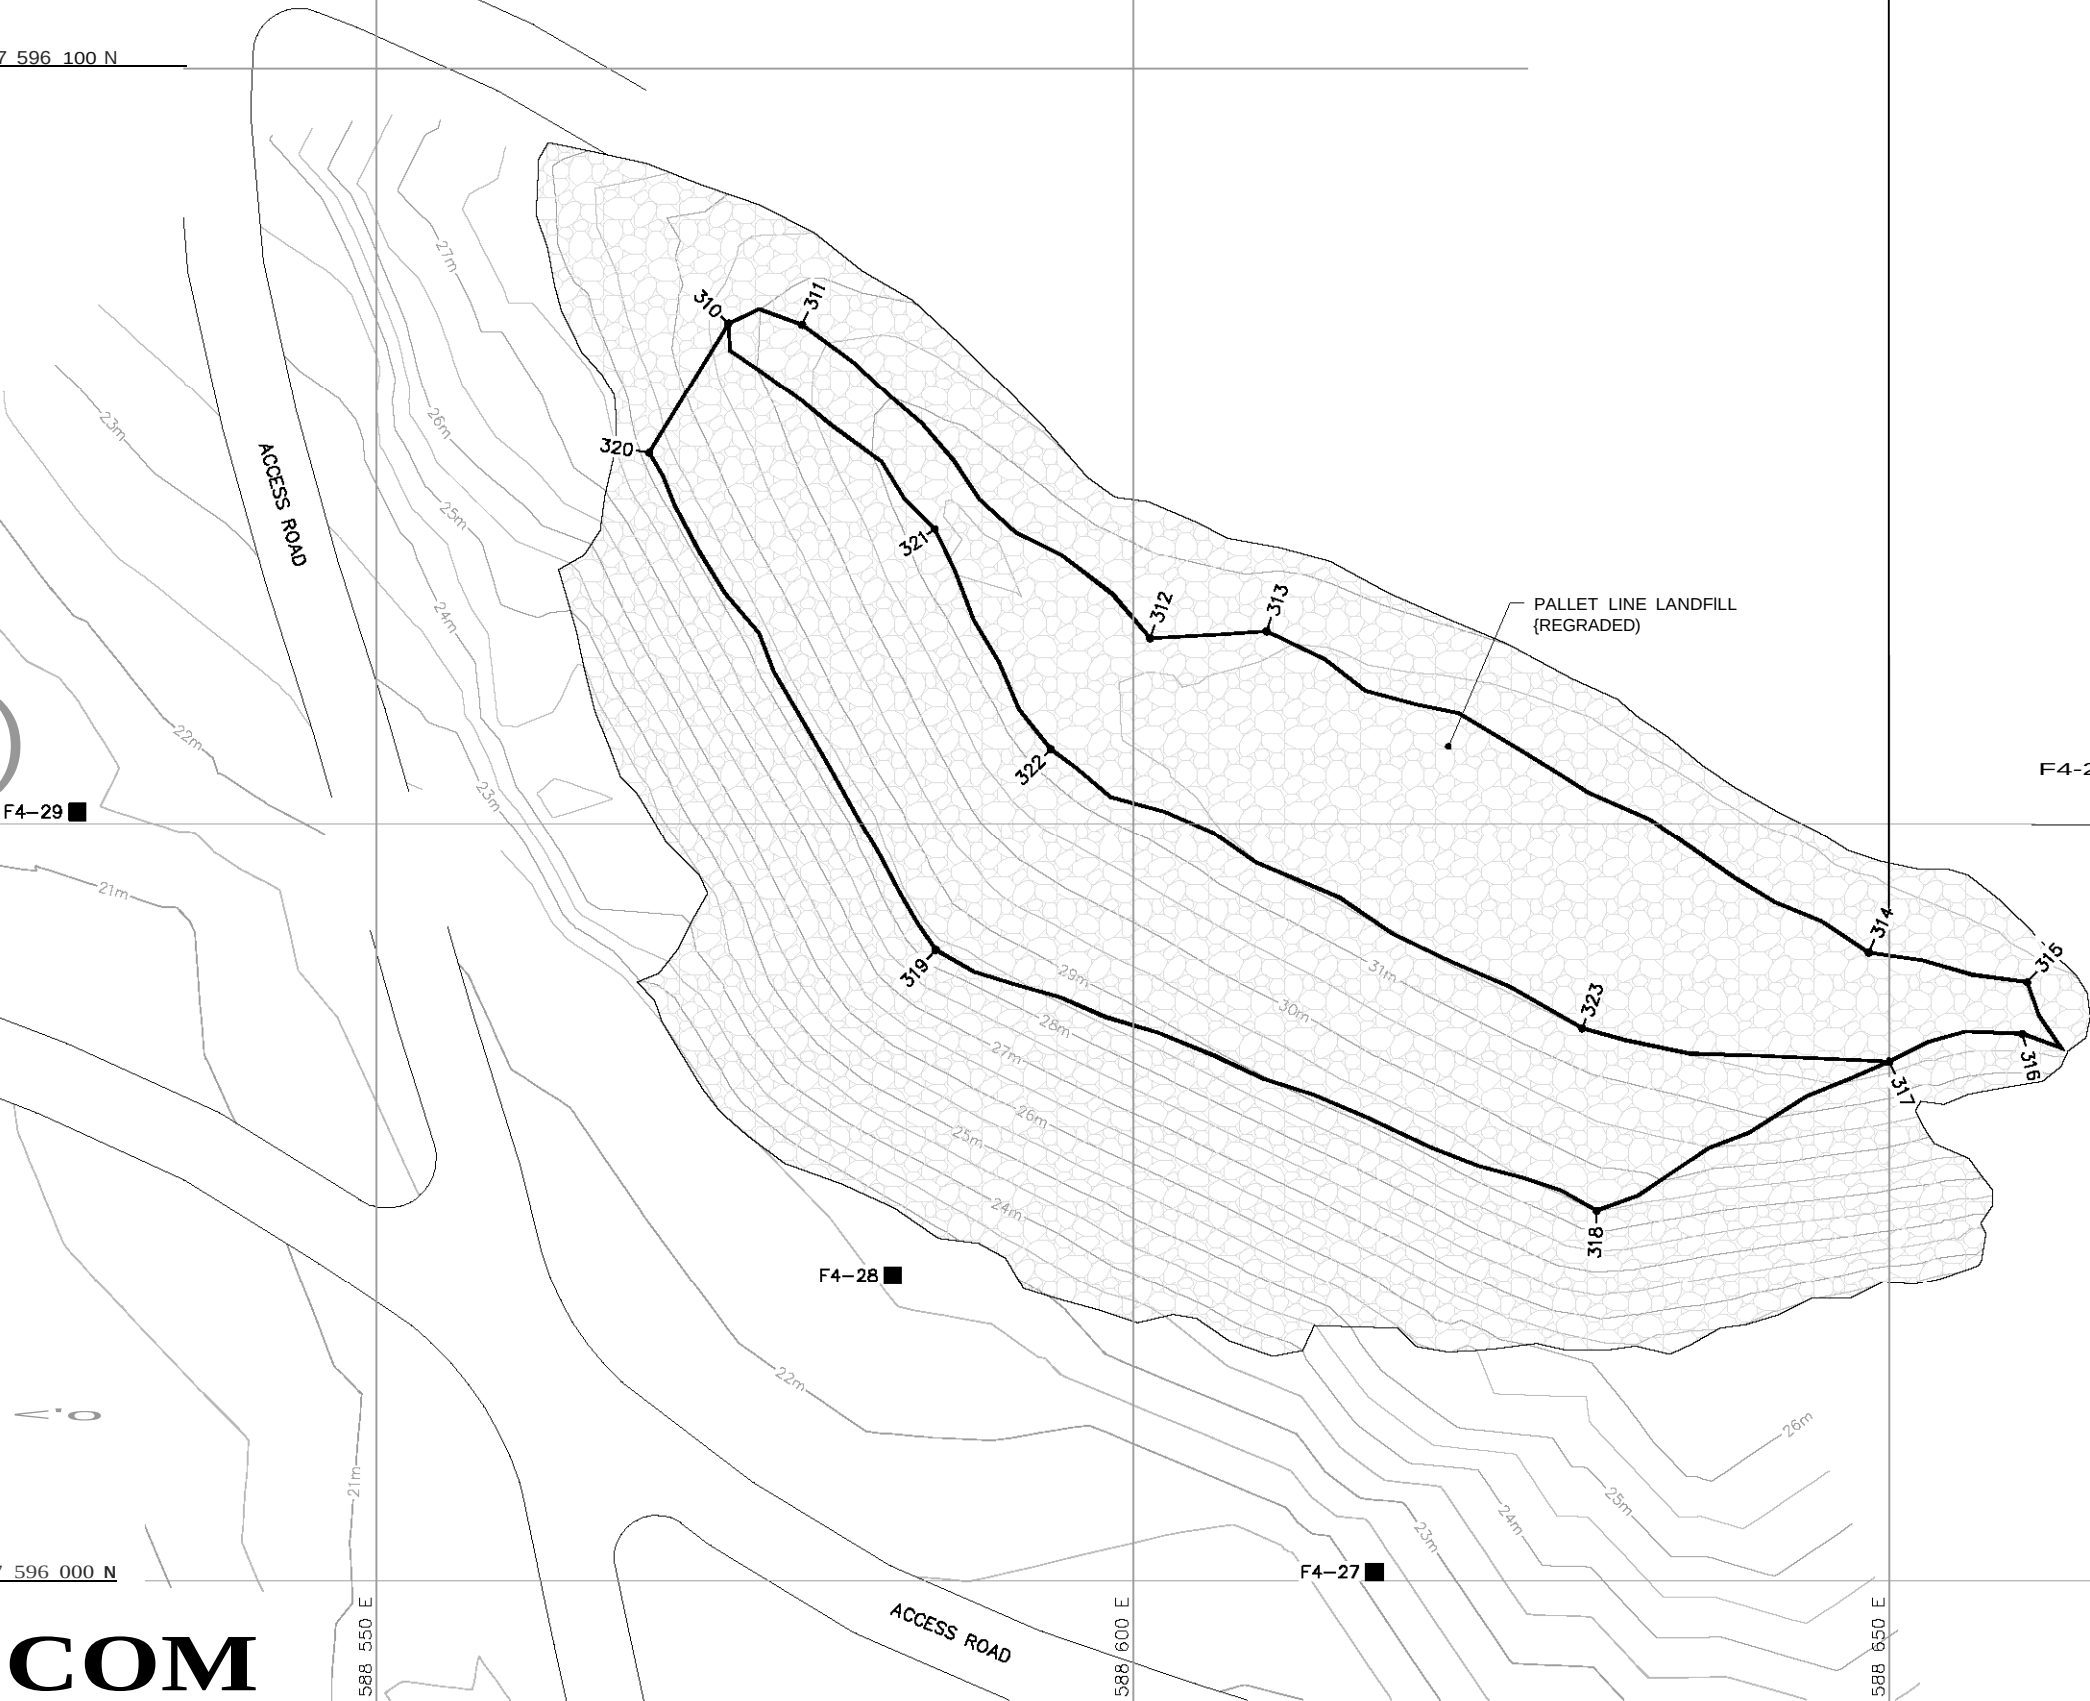

GENERAL NOTES:

1. ALL COORDINATES ARE REFERENCED TO NADB3 (CSRS), UTM ZONE 19N. ALL ELEVATIONS REFER TO GEODETIC DATUM.
2. ALL DIMENSIONS ARE IN METRES UNLESS NOTED OTHERWISE.

LEGEND:

- ... 10 COORDINATE POINT
- MONITORING SOIL SAMPLE LOCATION (5)

PALLET LINE LANDFILL REGRADED (AS-BUILT)			
NO.	UTM COORDINATES		ELEV.
	NORTHING	EASTING	
310	7 596 083.1	588 573.2	29.8
311	7 596 083.1	588 578.1	30.3
312	7 596 062.3	588 601.1	31.4
313	7 596 062.8	588 608.8	31.4
314	7 596 041.5	588 648.6	31.9
315	7 596 039.5	588 659.1	31.8
316	7 596 036.1	588 658.7	31.9
317	7 596 034.3	588 650.0	31.7
318	7 596 024.4	588 630.6	29.5
319	7 596 041.6	588 586.9	28.4
320	7 596 074.5	588 568.0	28.2
321	7 596 069.5	588 586.9	31.5
322	7 596 055.0	588 594.5	31.3
323	7 596 036.5	588 629.7	31.5

1:1500
0 5 10 m SCALE 1500

DEW LINE CLEAN UP
LANDFILL MONITORING PLAN
FOX-4 CAPE HOOPER
PALLET LINE LANDFILL
FIGURE FOX-4.5