


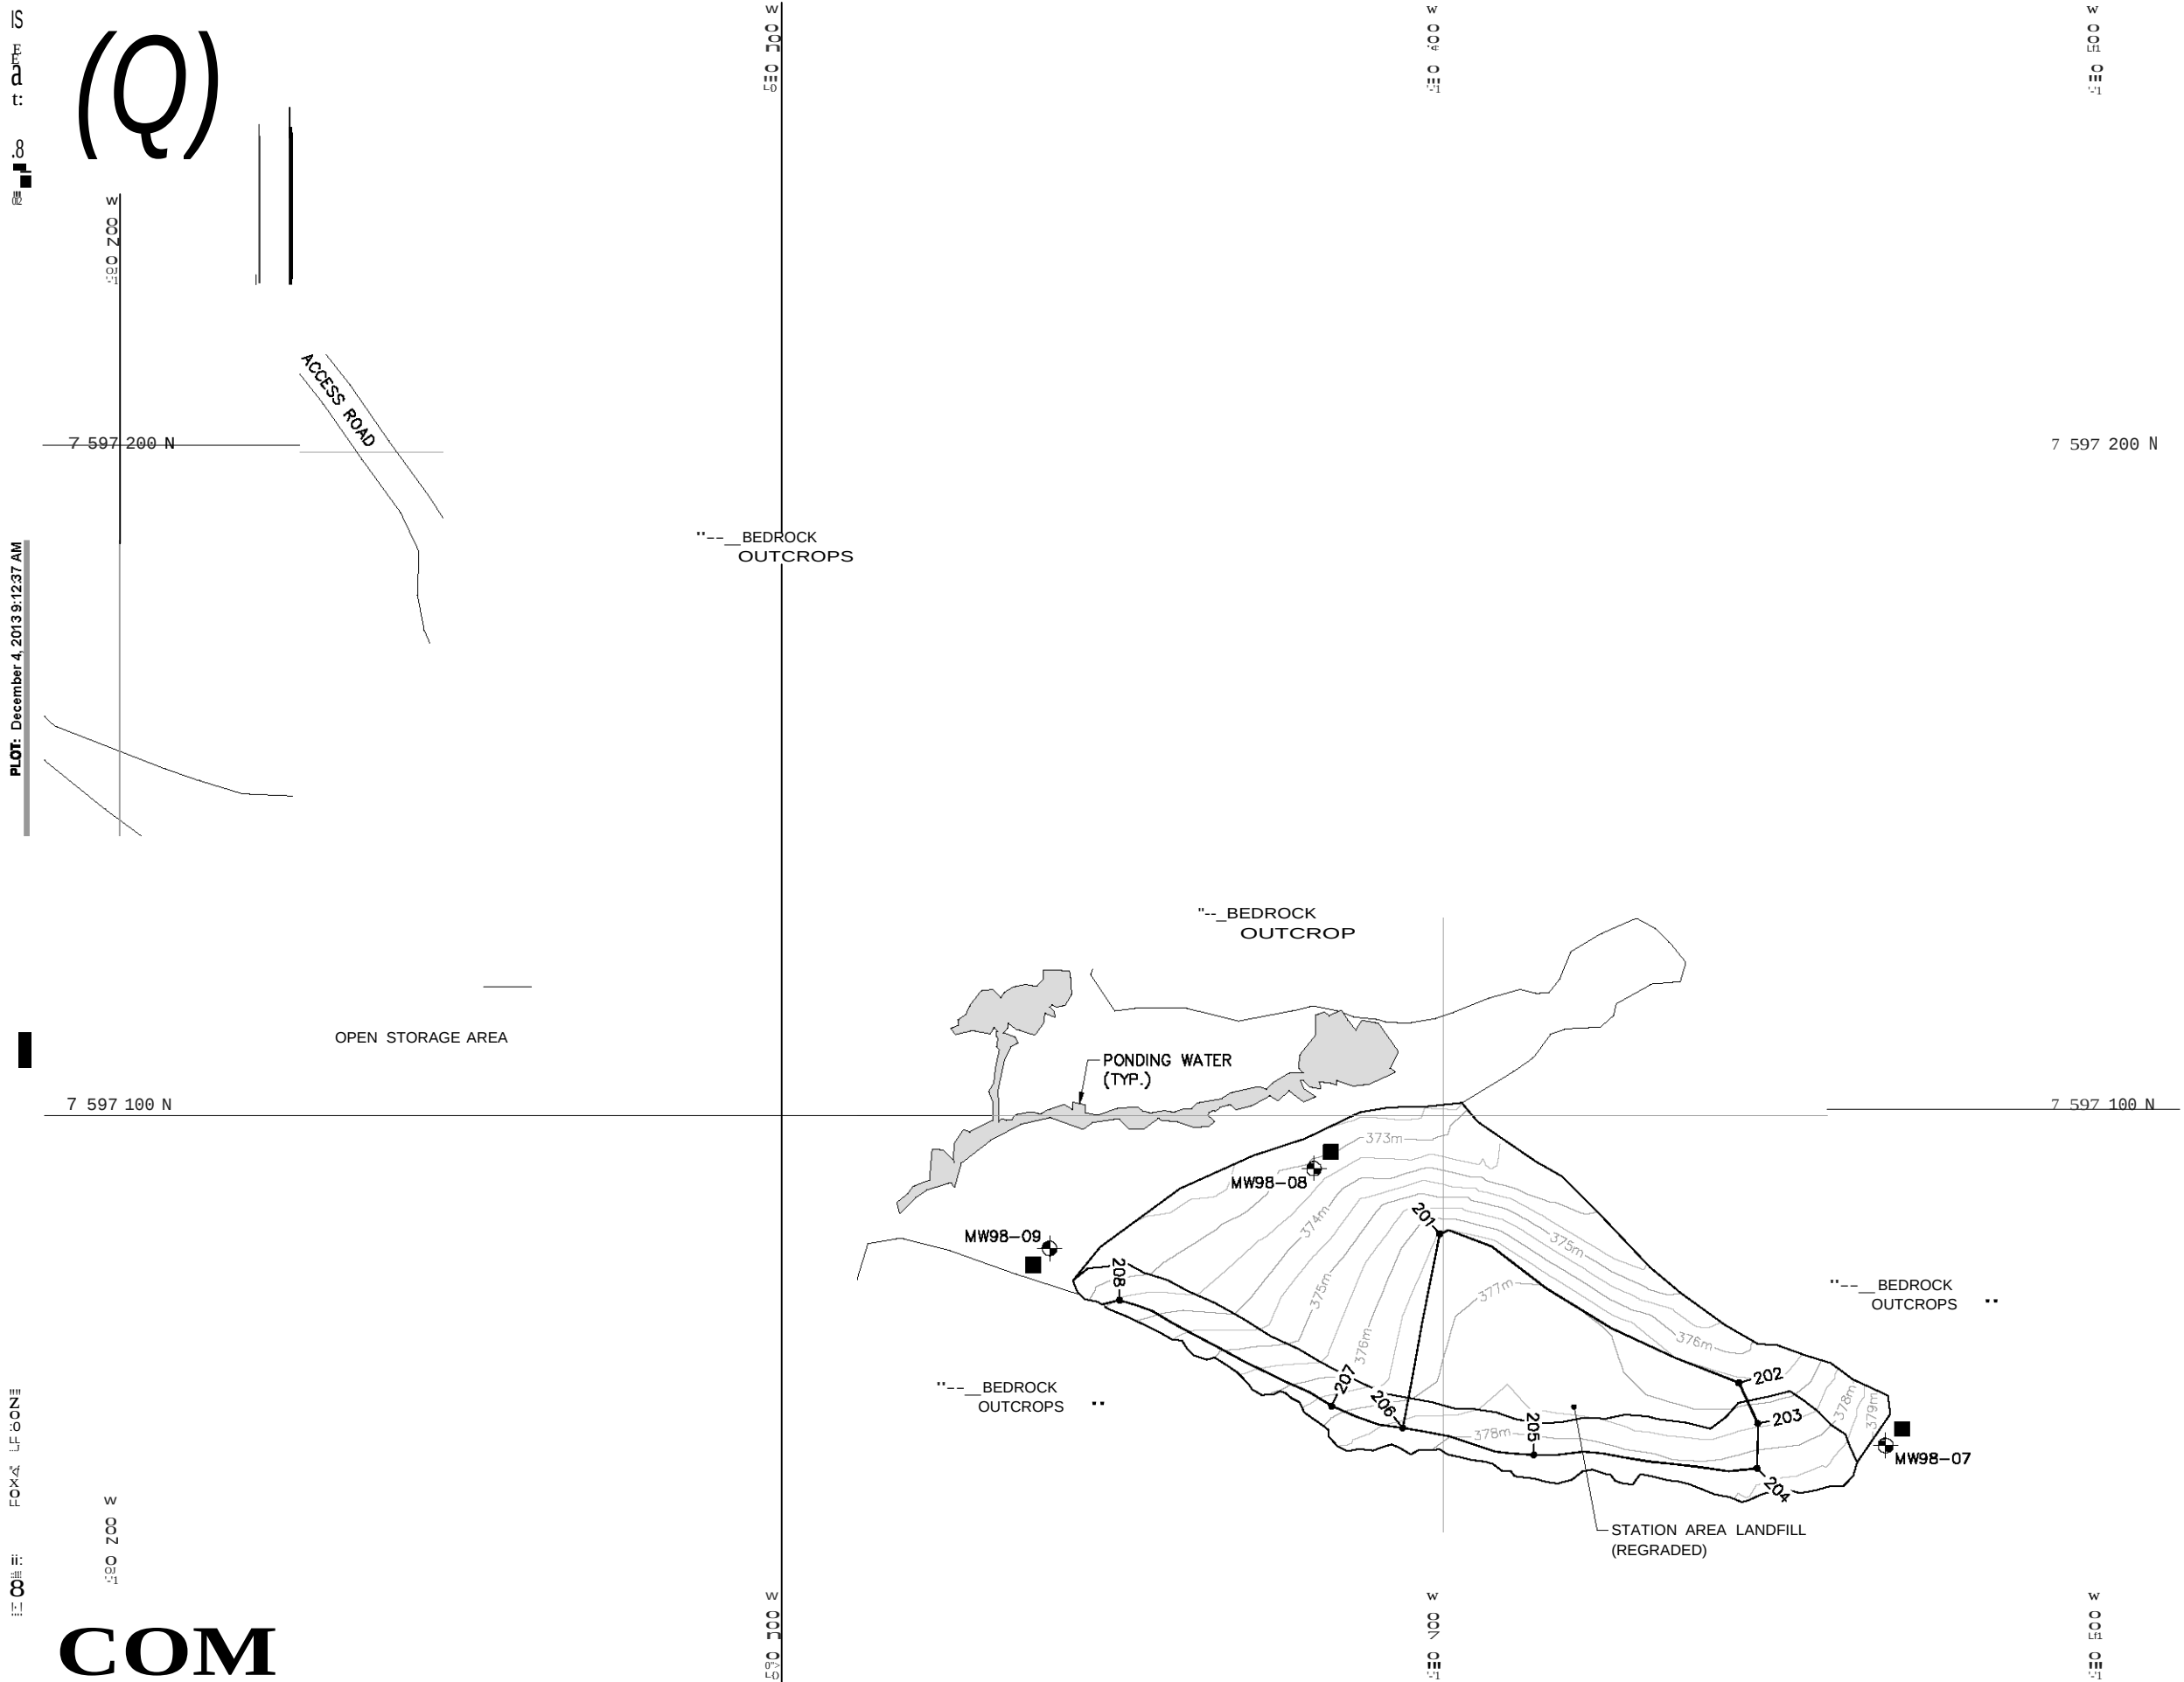


- GENERAL NOTES:
- 1. ALL COORDINATES ARE REFERENCED TO NAOB3 (CSRS), UTM ZONE 19N. ALL ELEVATIONS REFER TO GEODETIC DATUM.
  - 2. ALL DIMENSIONS ARE IN METRES UNLESS NOTED OTHERWISE.

LEGEND:

- Coordinate point symbol: COORDINATE POINT
- Monitoring well location symbol: MONITORING WELL LOCATION {3}
- Monitoring soil sample location symbol: MONITORING SOIL SAMPLE LOCATION {3}
- Body of water symbol: BODY OF WATER

| STATION AREA LANDFILL<br>REGRADED (AS-BUILT) |                 |           |       |
|----------------------------------------------|-----------------|-----------|-------|
| NO.                                          | UTM COORDINATES |           | ELEV. |
|                                              | NORTHING        | EASTING   |       |
| 201                                          | 7 597 082.2     | 590 399.4 | 376.5 |
| 202                                          | 7 597 059.7     | 590 444.6 | 376.6 |
| 203                                          | 7 597 053.6     | 590 447.4 | 377.0 |
| 204                                          | 7 597 046.8     | 590 447.3 | 378.3 |
| 205                                          | 7 597 048.8     | 590 413.6 | 378.4 |
| 206                                          | 7 597 052.9     | 590 393.8 | 377.7 |
| 207                                          | 7 597 056.2     | 590 383.1 | 376.8 |
| 208                                          | 7 597 072.2     | 590 351.0 | 373.6 |

| STATION AREA LANDFILL<br>MONITORING WELLS (AS-BUILT) |                 |           |       |
|------------------------------------------------------|-----------------|-----------|-------|
| NO.                                                  | UTM COORDINATES |           | ELEV. |
|                                                      | NORTHING        | EASTING   |       |
| MW98-07                                              | 7 597 050.2     | 590 466.8 | 379.4 |
| MW98-08                                              | 7 597 092.0     | 590 380.4 | 373.2 |
| MW98-09                                              | 7 597 080.0     | 590 340.5 | 372.4 |

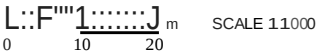

DEW LINE CLEAN UP  
LANDFILL MONITORING PLAN  
FOX-4 CAPE HOOPER  
STATION AREA LANDFILL  
FIGURE FOX-4.3