



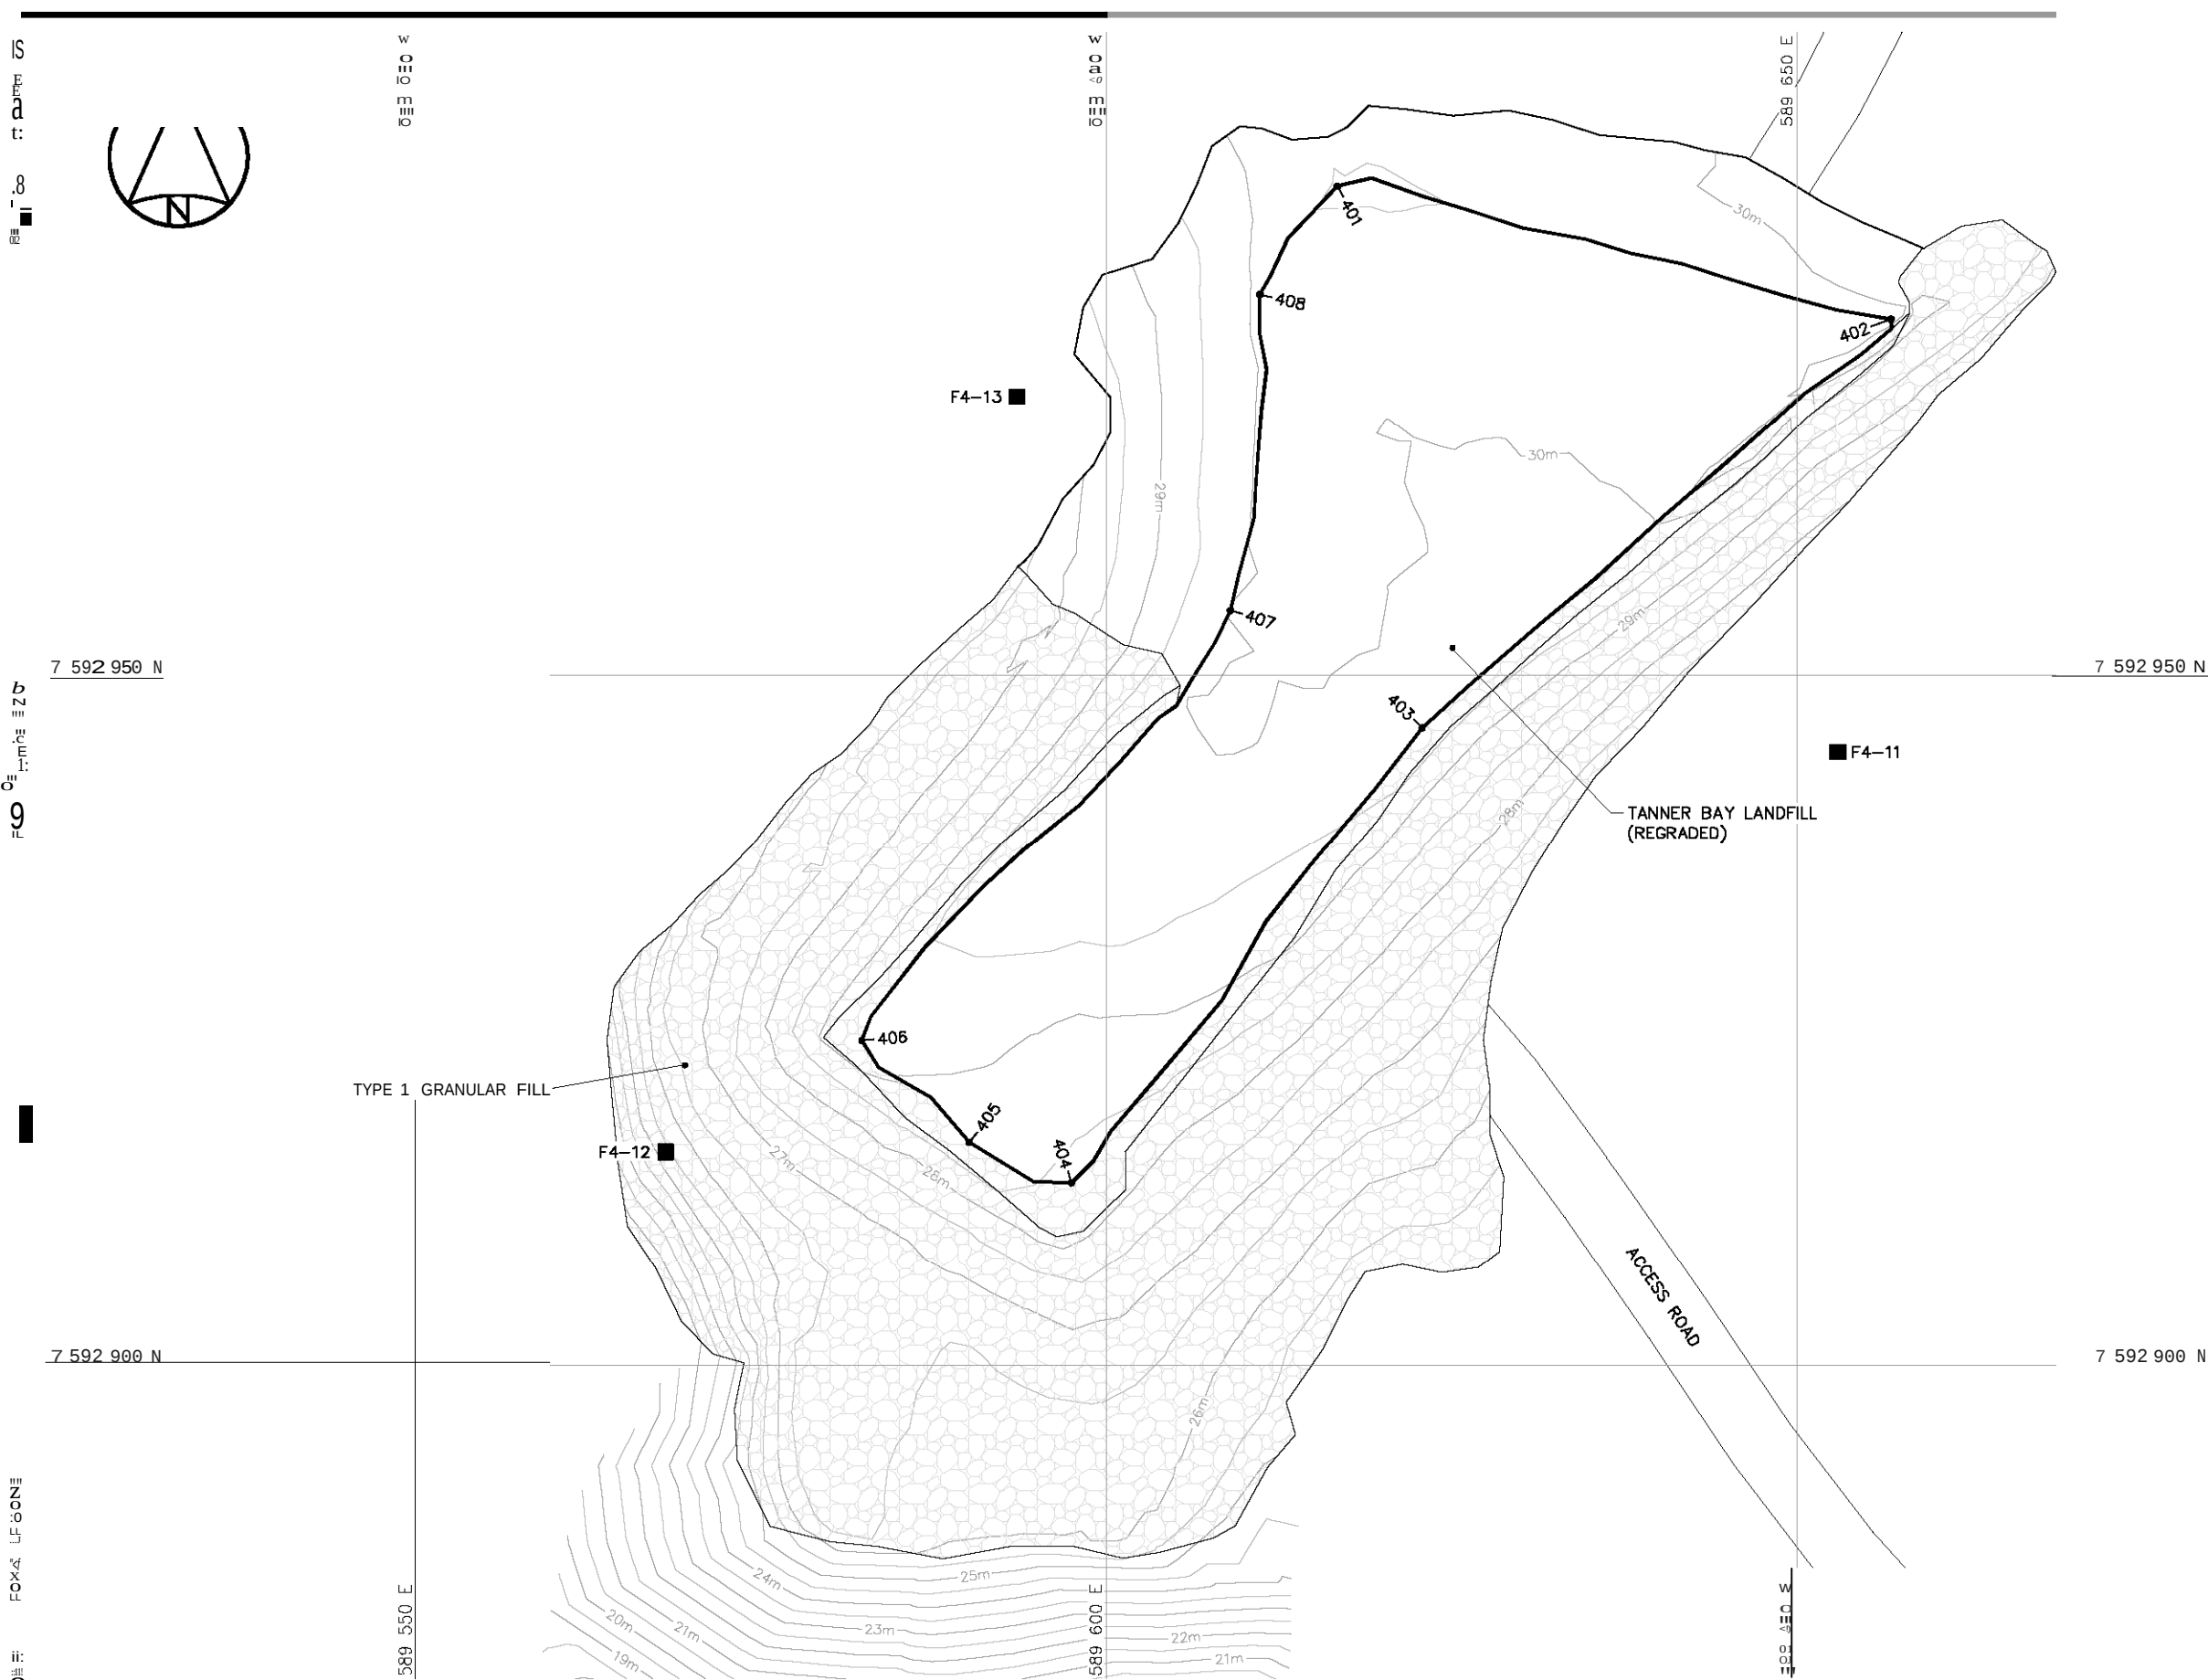

- GENERAL NOTES:
1. ALL COORDINATES ARE REFERENCED TO NADB3 (CSRS), UTM ZONE 19N. ALL ELEVATIONS REFER TO GEODETIC DATUM.
 2. ALL DIMENSIONS ARE IN METRES UNLESS NOTED OTHERWISE.

- LEGEND:
- COORDINATE POINT
 - MONITORING SOIL SAMPLE LOCATION (3)

TANNER BAY LANDFILL REGRADED (AS-BUILT)			
NO.	UTM COORINATES		ELEV.
	NORTHING	EASTING	
401	7 592 985.5	589 616.7	30.5
402	7 592 975.8	589 656.8	30.1
403	7 592 946.2	589 622.8	29.7
404	7 592 913.2	589 597.5	28.3
405	7 592 916.1	589 590.1	28.7
406	7 592 923.5	589 582.3	29.2
407	7 592 954.7	589 609.0	30.0
408	7 592 977.6	589 611.1	30.1

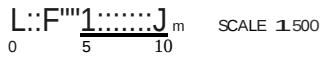

DEW LINE CLEAN UP
LANDFILL MONITORING PLAN

FOX-4 CAPE HOOPER

TANNER BAY LANDFILL
FIGURE FOX-4.6

COM