



NOTES:

1. DRAWINGS PROVIDED BY DCC (BIOGENIE S.R.D. INC.)

- LEGEND:**
- BM-2 ▲ BENCHMARK LOCATION
 - MW-5 ⊕ MONITORING WELL LOCATION
 - VT ⊕ THERMISTOR LOCATION
 - SOIL SAMPLE LOCATION
 - ⓐ PHOTOGRAPH LOCATION
 - ||||| SETTLEMENTS (NTS)
 - W- EROSION (NTS)
 - ▨ PONDED WATER

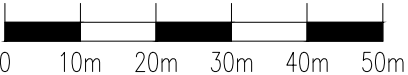

CLIENT: DEFENSE CONSTRUCTION CANADA/ KITNUNA PROJECTS		PROJECT: 2011 PIN-3 LADY FRANKLIN DEW LINE MONITORING REPORT	
CONSULTANT: 		TITLE: MAIN LANDFILL	
DESIGNED: -	CHECKED: -	PROJECT No: A07001A02	FIGURE No: FIG. A1
DRAFTED: -	APPROVED: -	DATE (YY-MM-DD): 11-10-12	REVISION: -