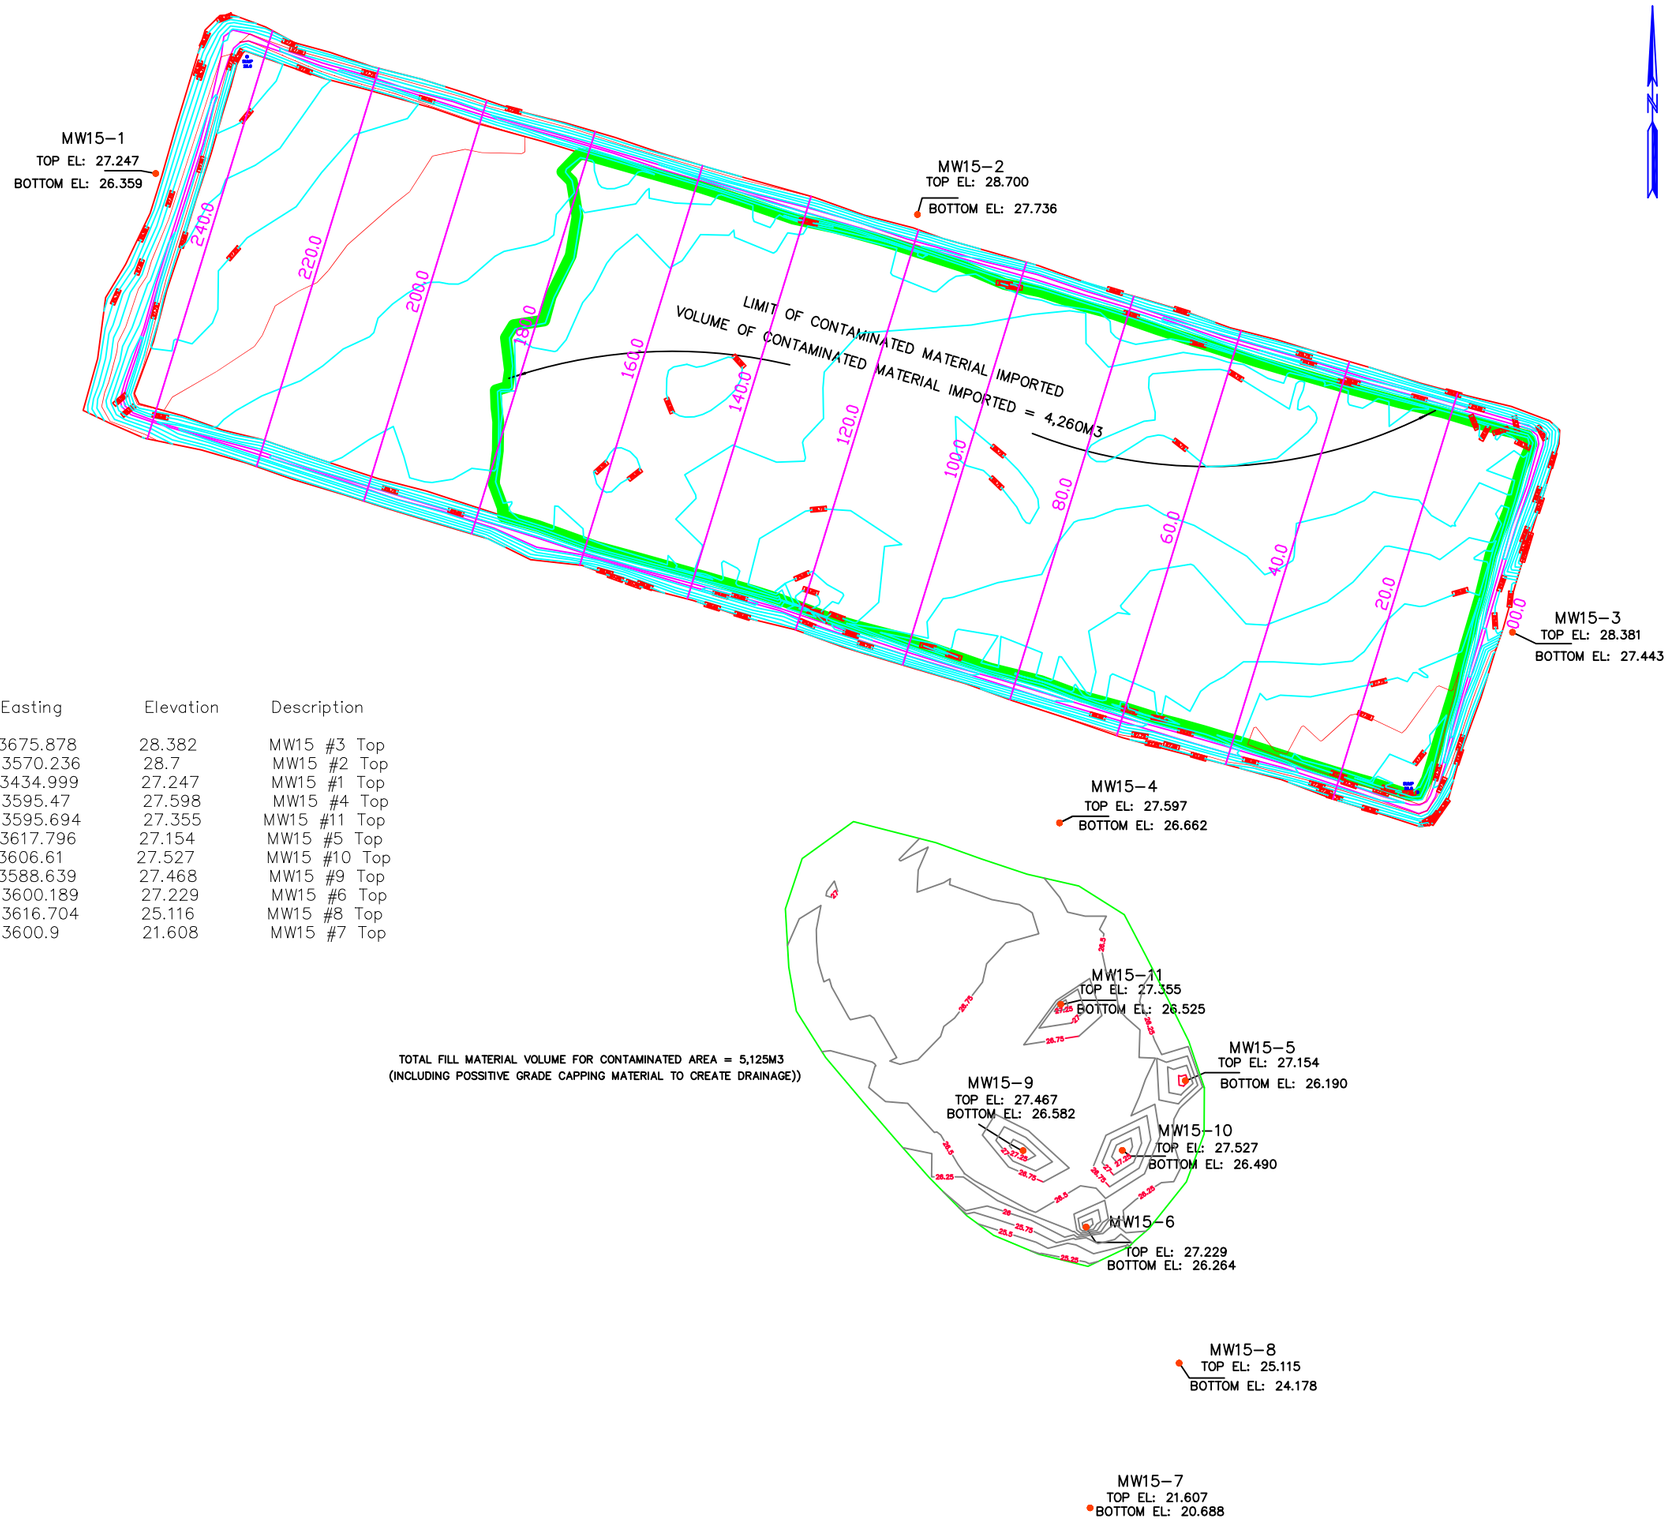

Point No.	Northing	Easting	Elevation	Description
9011020	7666833.113	493675.878	28.382	MW15 #3 Top
9011043	7666907.268	493570.236	28.7	MW15 #2 Top
9011065	7666914.554	493434.999	27.247	MW15 #1 Top
9011574	7666799.272	493595.47	27.598	MW15 #4 Top
9011576	7666767.062	493595.694	27.355	MW15 #11 Top
9011578	7666753.517	493617.796	27.154	MW15 #5 Top
9011580	7666741.128	493606.61	27.527	MW15 #10 Top
9011582	7666741.162	493588.639	27.468	MW15 #9 Top
9011584	7666727.524	493600.189	27.229	MW15 #6 Top
9011586	7666703.379	493616.704	25.116	MW15 #8 Top
9011588	7666677.668	493600.9	21.608	MW15 #7 Top

SUB–ARCTIC SURVEYS LTD.
P.O. BOX 2441
226 UTSINGI DRIVE
YELLOWKNIFE, NT. X1A 2P8
PHONE: 873–2047 FAX: 873–9079
WEB PAGE www.sub–arctic.ca
E–MAIL sas@sub–arctic.ca

NO.	REVISION\ISSUE	DATE:

DRAWN BY: M.W.
CHECKED BY: M.W.

UPLOGIAQ Inc

AS–BUILT LTU
SHOWING
MONITORING WELLS
LOCATION AND ELEVATION
CAMBRIDGE BAY – NU

PROJECT NO.: 14–075–GI
FILE NO.:

DATE: NOVEMBER 17, 2015
SCALE: 1:300