



0 25 50 Metres

SCALE: 1:15000


DRAWN BY: GLG  
CHECKED BY: HLF  
PROJECT: 152356

**Public Works and Government Services Canada**

**SITE PLAN CAMBRIDGE BAY AIRPORT  
VICTORIA ISLAND, NU**

FIG-01



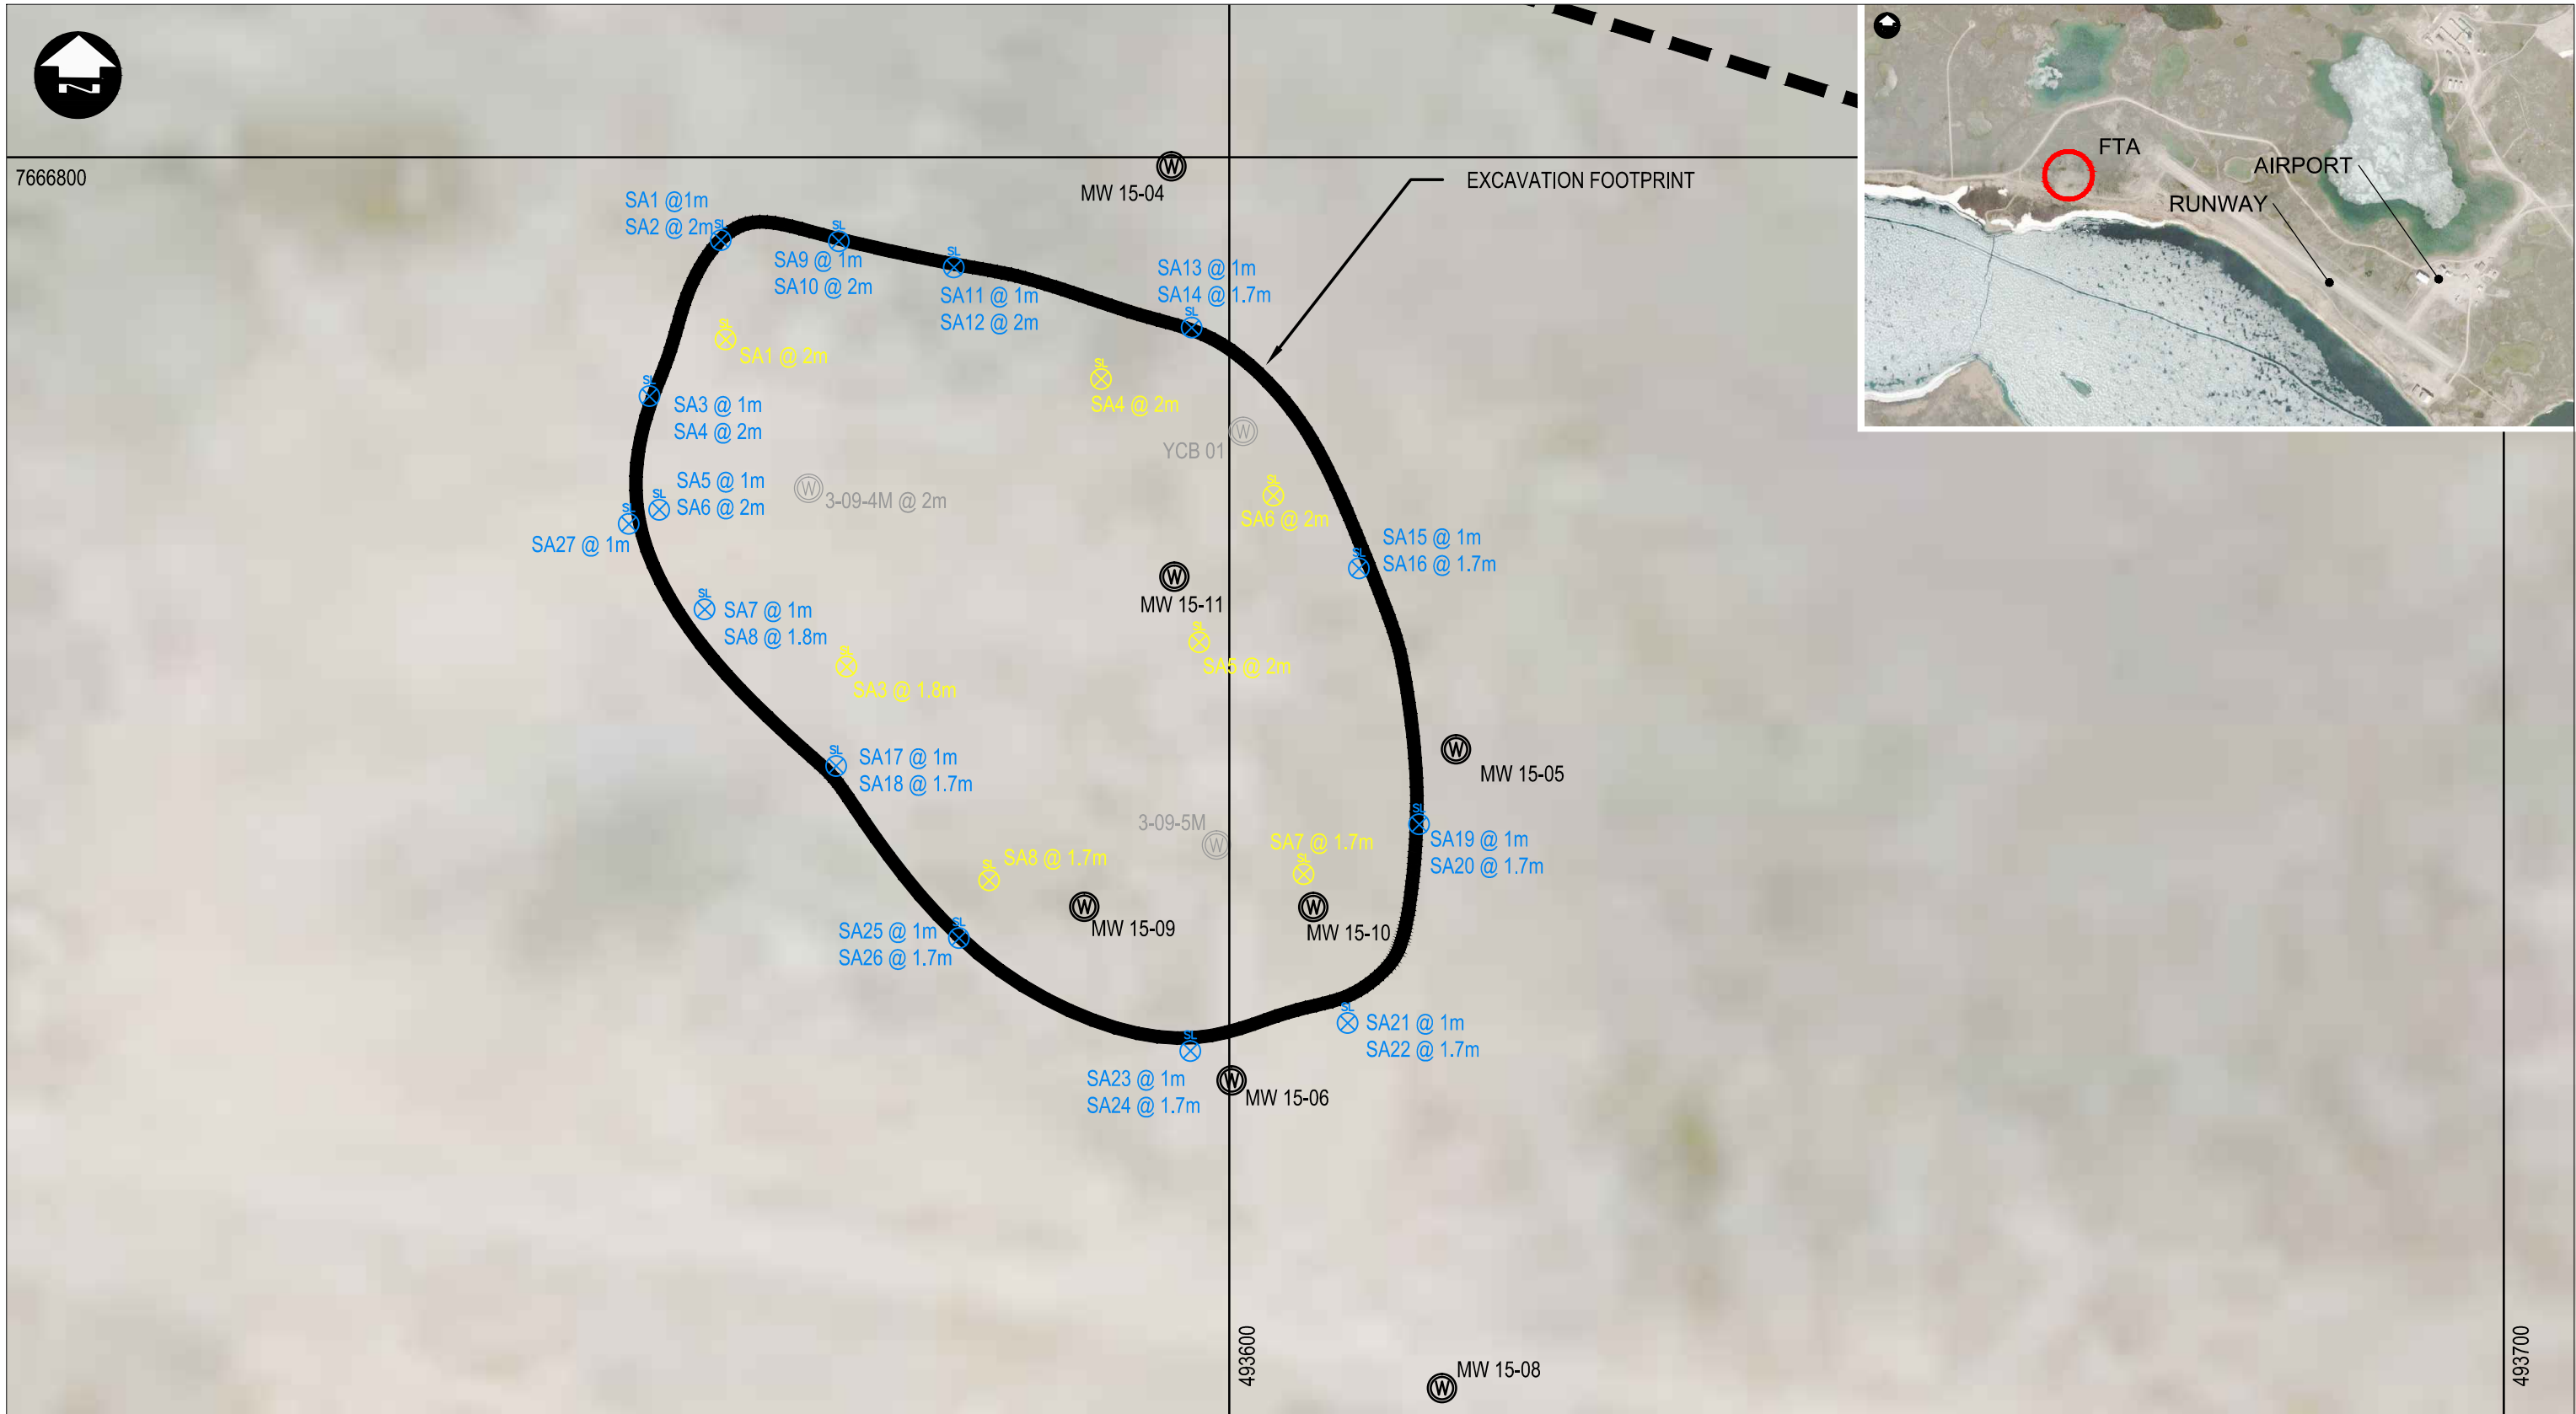

LEGEND

- MONITORING WELL
- DECOMMISSIONED MONITORING WELL
- WALL SAMPLE LOCATION
- FLOOR SAMPLE LOCATION


SCALE:  
N.T.S.  
DO NOT SCALE  
DRAWING

DRAWN BY: GLG  
CHECKED BY: HLF  
PROJECT: 152356

Public Works and Government Services Canada  
Cambridge Bay Airport FTA

SITE PLAN  
SHOWING SOIL SAMPLE LOCATIONS

FIG-02

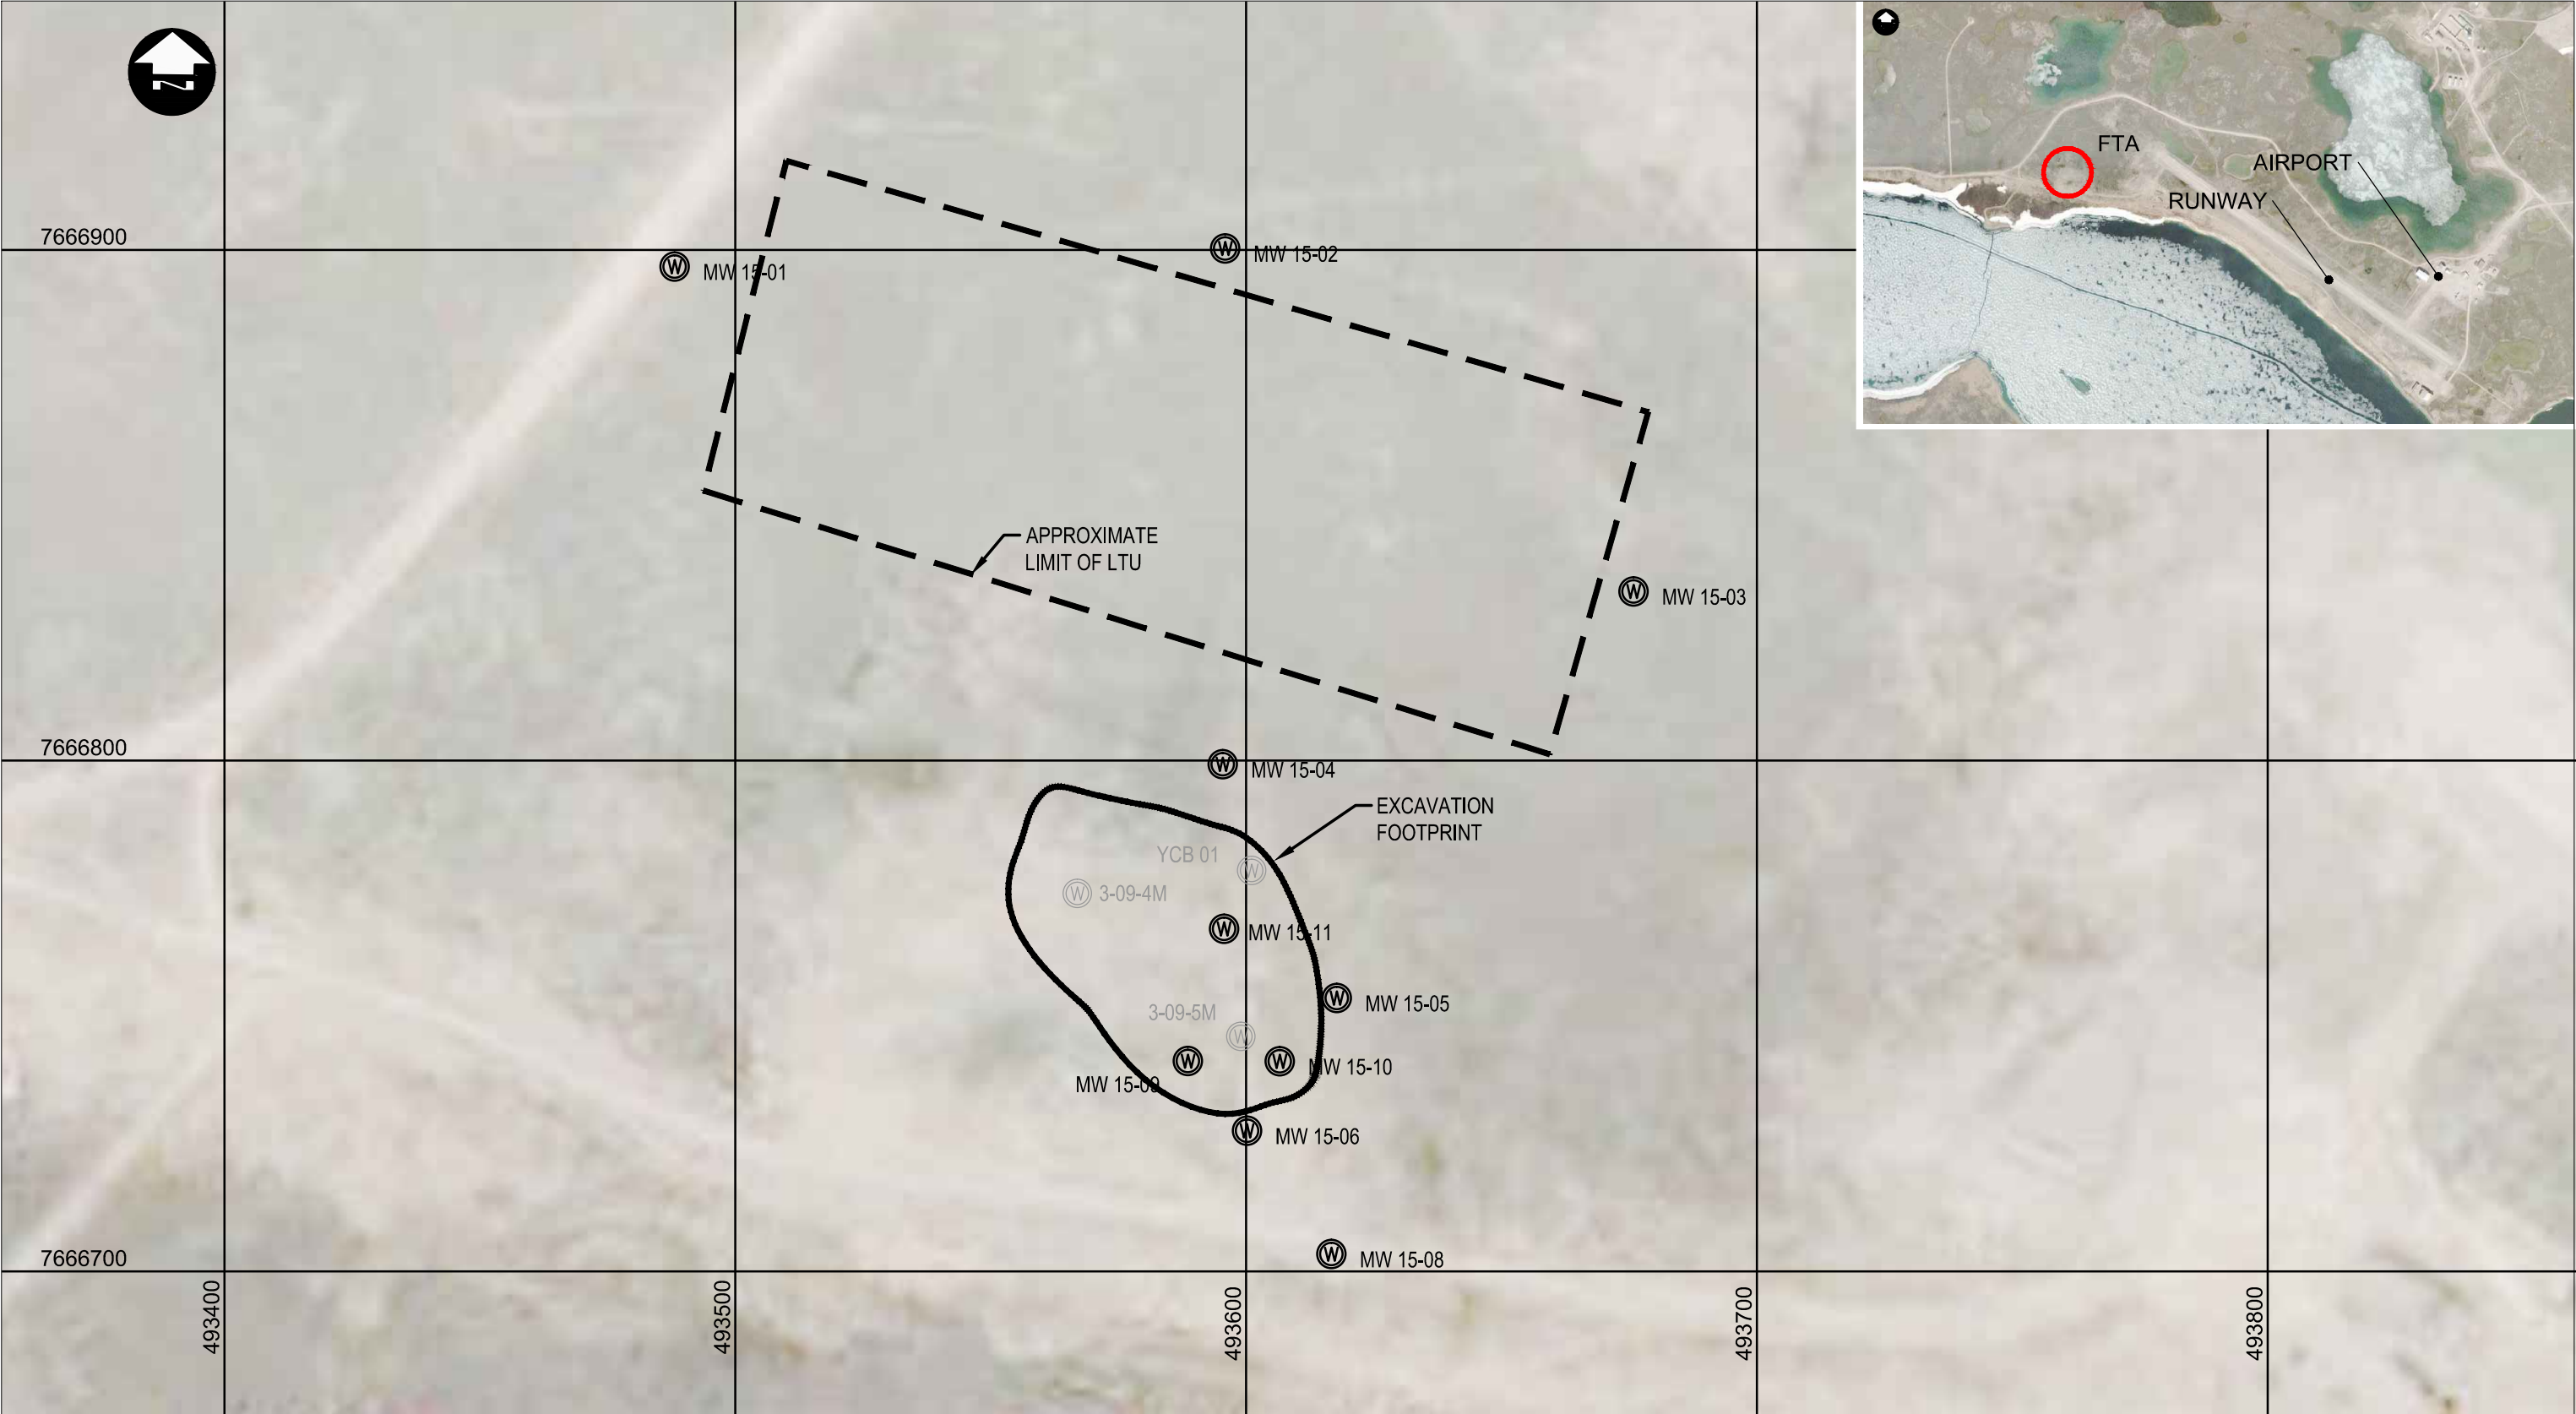



**DILLON**  
CONSULTING

**LEGEND**

 MONITORING WELL

 DECOMMISSIONED MONITORING WELL

**SCALE:**  
N.T.S.  
DO NOT SCALE  
DRAWING

DRAWN BY: GLG  
CHECKED BY: HLF  
PROJECT: 152356

**Public Works and Government Services Canada**


Cambridge Bay Airport FTA


**SITE PLAN**

**SHOWING MONITORING WELL LOCATIONS**

FIG-03



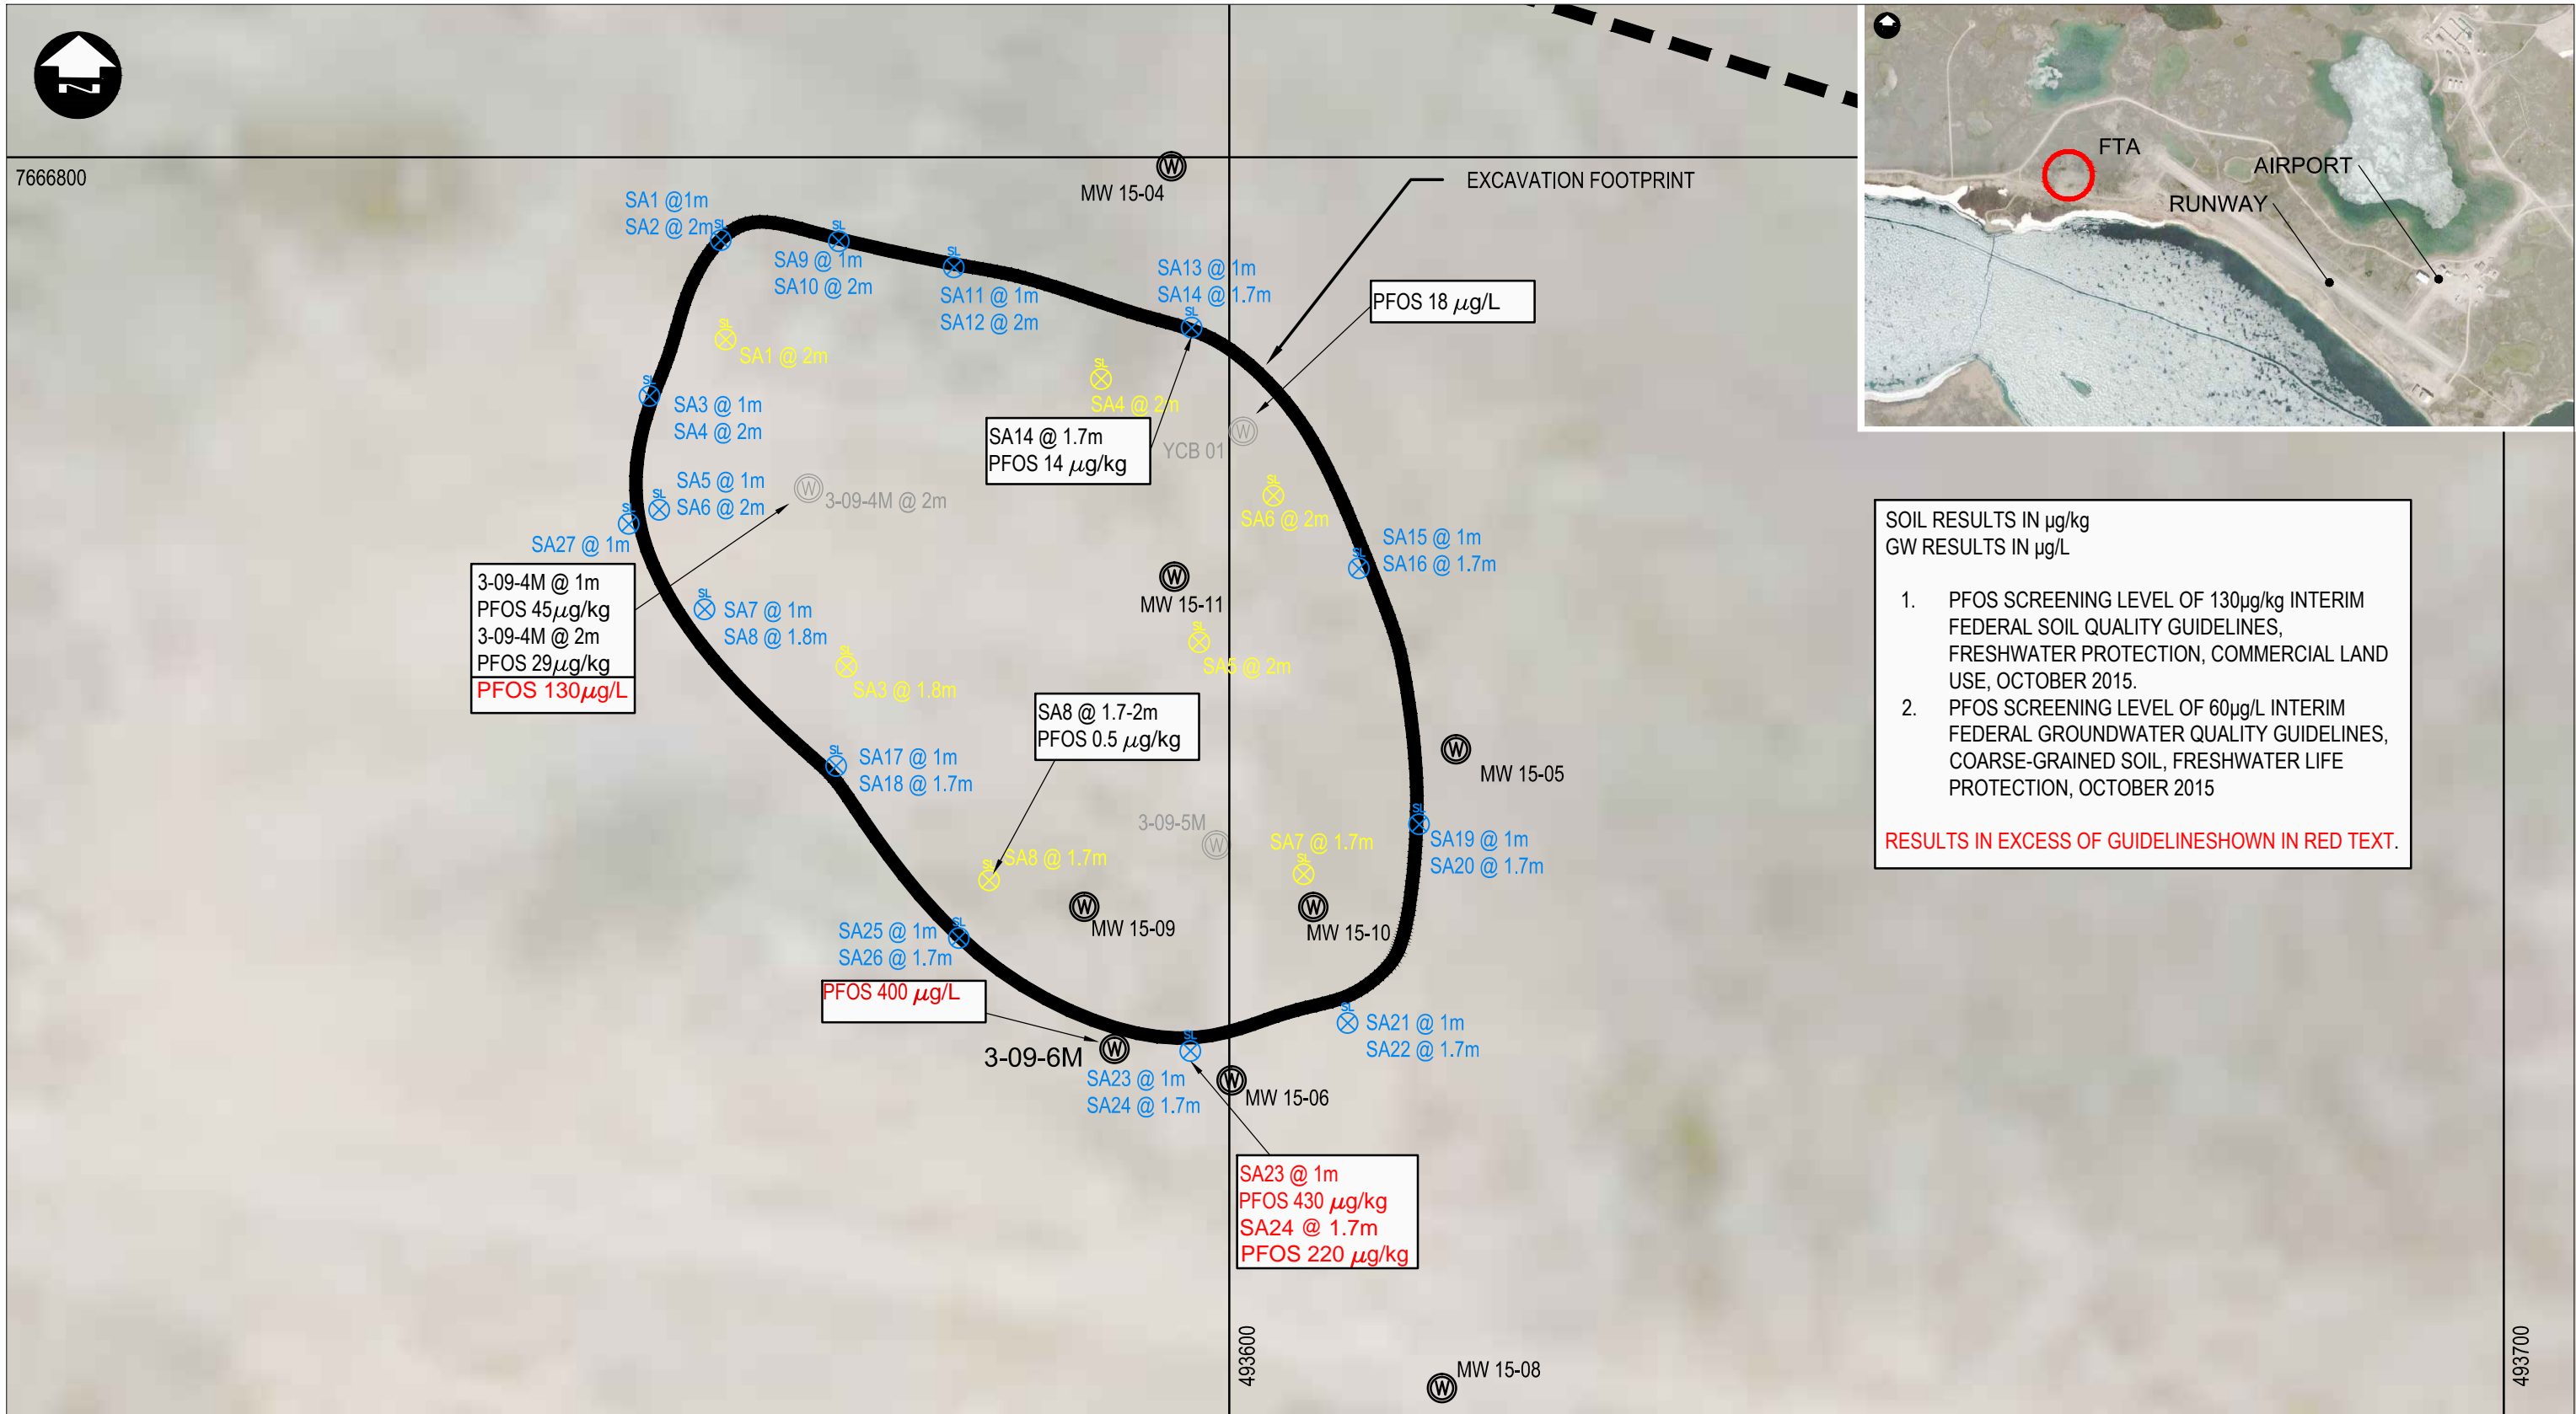



**DILLON**  
CONSULTING

**LEGEND**

-  MONITORING WELL
-  DECOMMISSIONED MONITORING WELL
-  WALL SAMPLE LOCATION
-  FLOOR SAMPLE LOCATION

SCALE:  
N.T.S.  
DO NOT SCALE  
DRAWING

DRAWN BY: GLG  
CHECKED BY: HLF  
PROJECT: 152356

**Public Works and Government Services Canada**

Cambridge Bay Airport FTA

**SITE PLAN  
SHOWING PFOS RESULTS**

FIG-04