


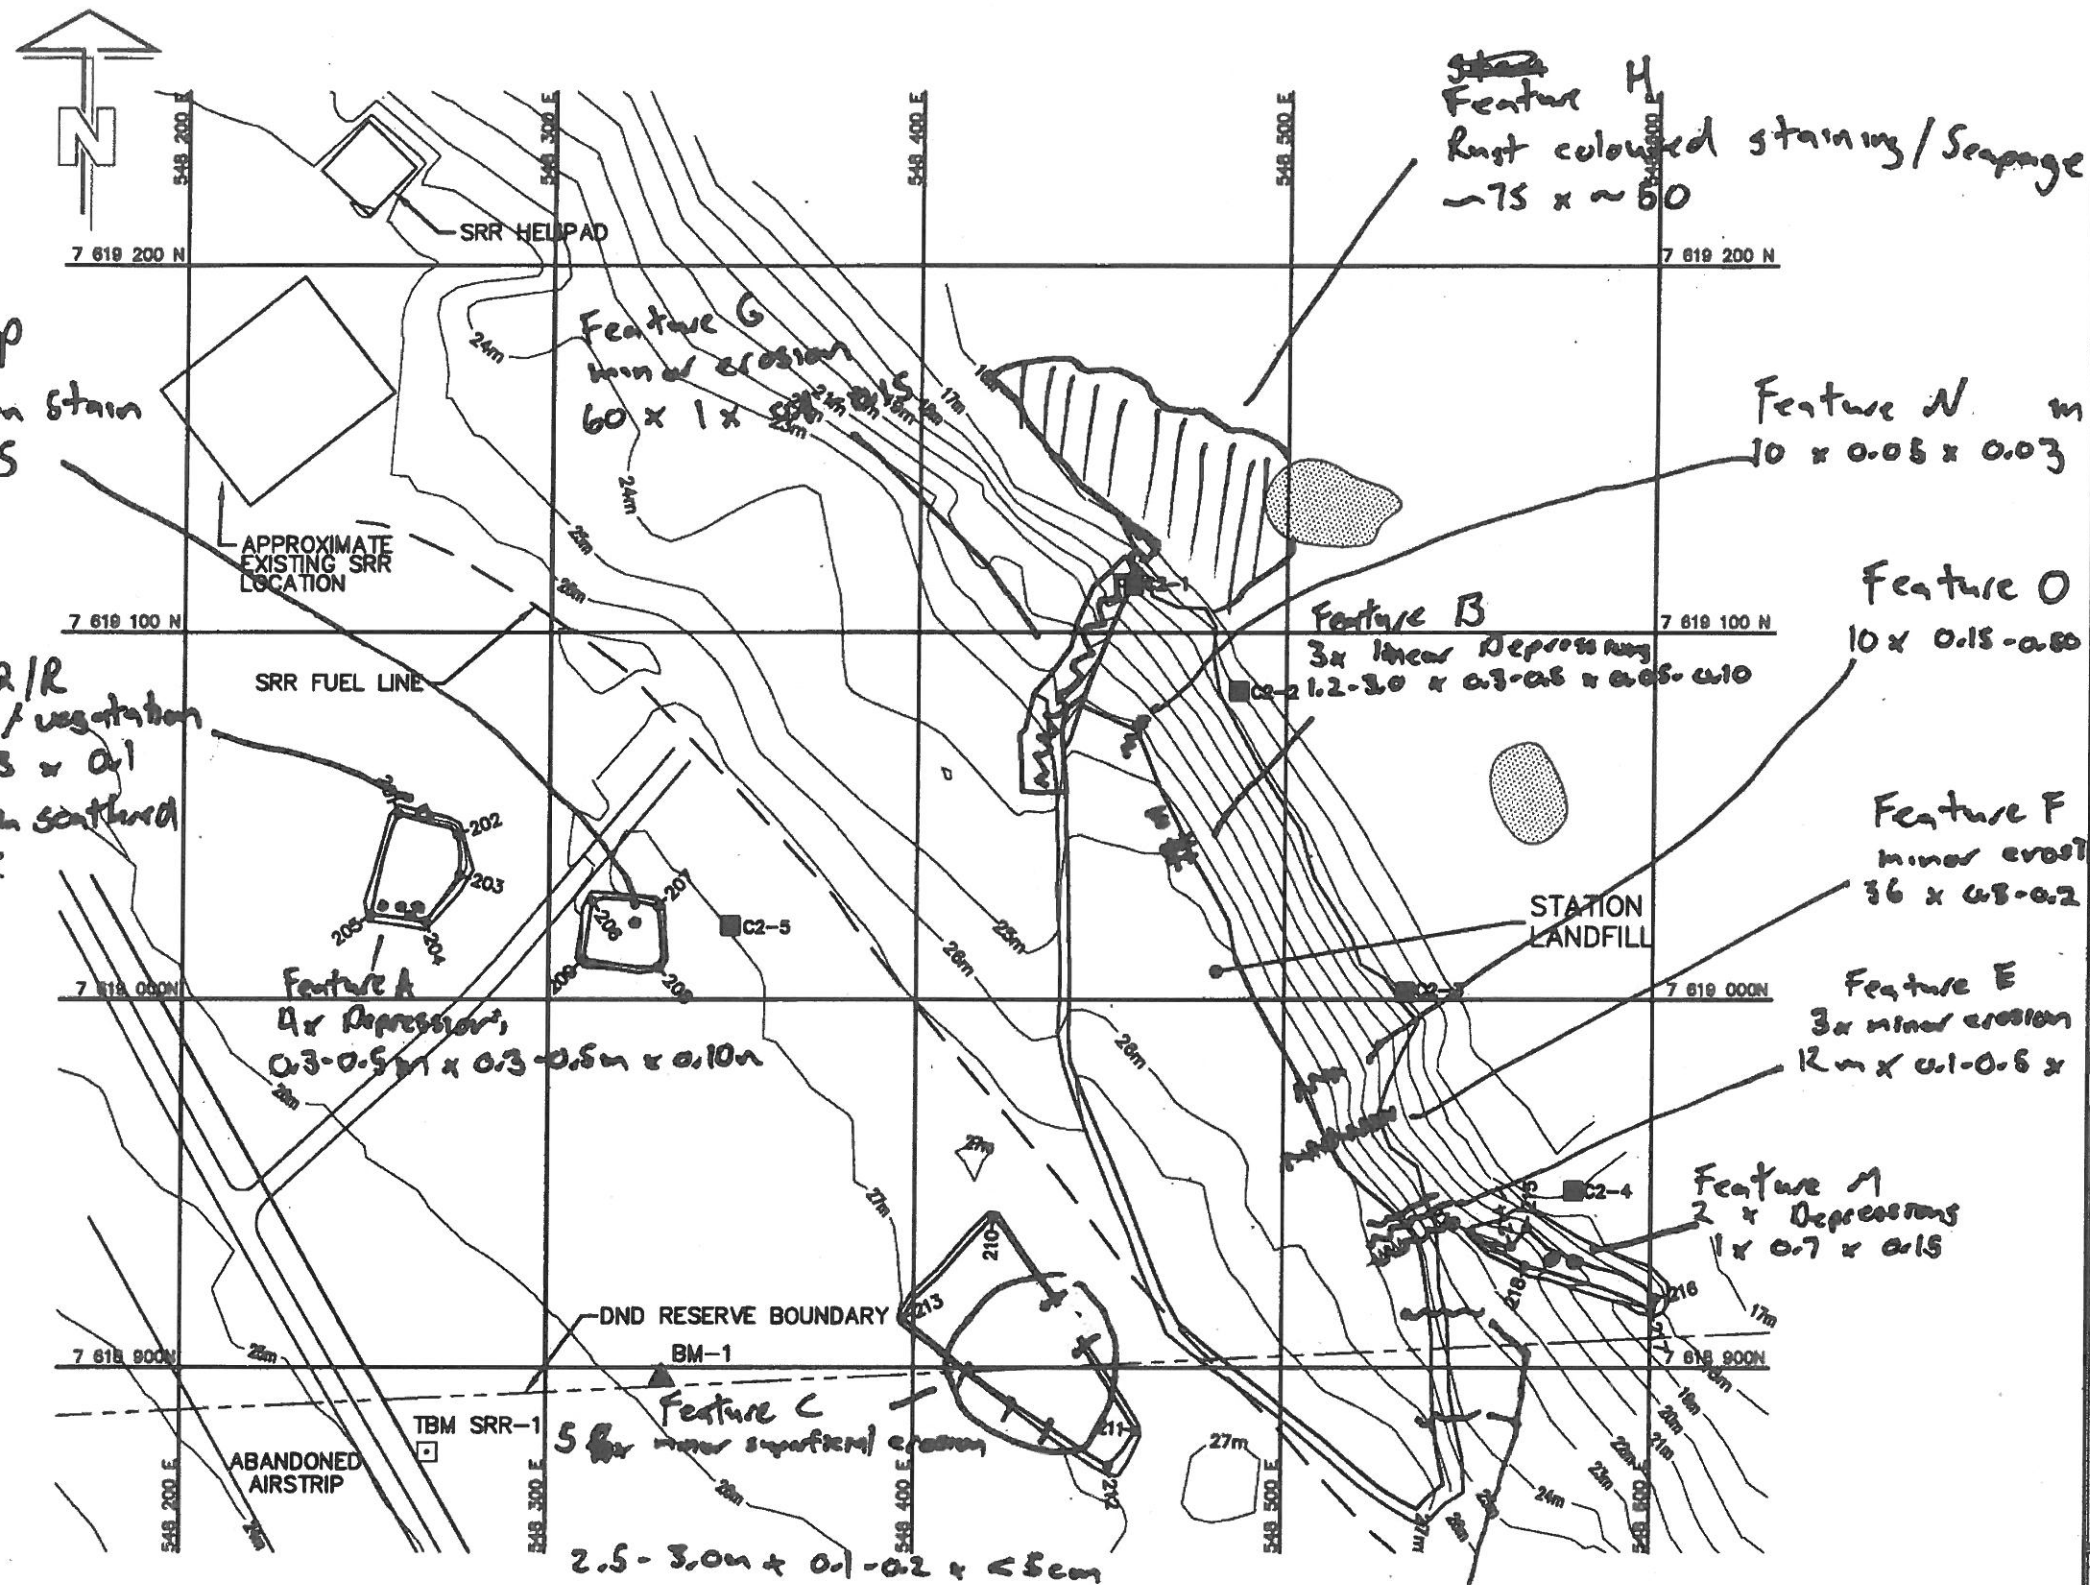

LEGEND

- TBM4 □ TEMPORARY BENCHMARK
- BM-1 ▲ PERMANENT BENCHMARK
- 101- COORDINATE POINT
- MONITORING SOIL SAMPLE LOCATION
- SURFICIAL EROSION (NTS)

20m 40m 60m 80m 100m

A	FINAL VERSION	10-05-27	PL	EC	JPP
NO.	VERSION	DATE	BY	VERIF.	APPR.

Construction de Défense Canada
Defence Construction Canada

LOGISTICS PLAN

COLLECTION OF LANDFILL MONITORING DATA
CAM-2, KITIKMEOT REGION (NUNAVUT)

STATION LANDFILL

SITE REMEDIATION SOLUTIONS

Biogenie, a division of EnGlobe Corp.
4405 Wilfrid-Hamel Blvd., Suite 200
Quebec (Quebec) CANADA G1P 2J7
Phone: (418) 653-4422 Fax: (418) 653-3583

MEASUREMENT UNIT	SCALE:	DATE (month-year):
Metre	1 : 2,000	JUNE 2010
DRAWN BY:	VERIFIED BY:	APPROVED BY:
P. LEGARE	E. CARRIERE	J.-P. PELLETIER
PROJECT NO:	DRAWING NO:	PAGE
CD8228_001_110	CD8228_001_110-CAM-2_D	PL

PERMANENT BENCHMARK				
NO.	COORDINATES		ELEV.	DESCRIPTION
	NORTHING	EASTING		
BM-1	7 618 897.363	548 331.191	28.595	25mm DIA. STEEL PIPE
SRR-1	7 618 877.108	548 287.873	24.975	18mm DIA. IRON BAR

Feature D
2x minor Erosion
8-15 x 0.05-2 x 0.05-0.15

