



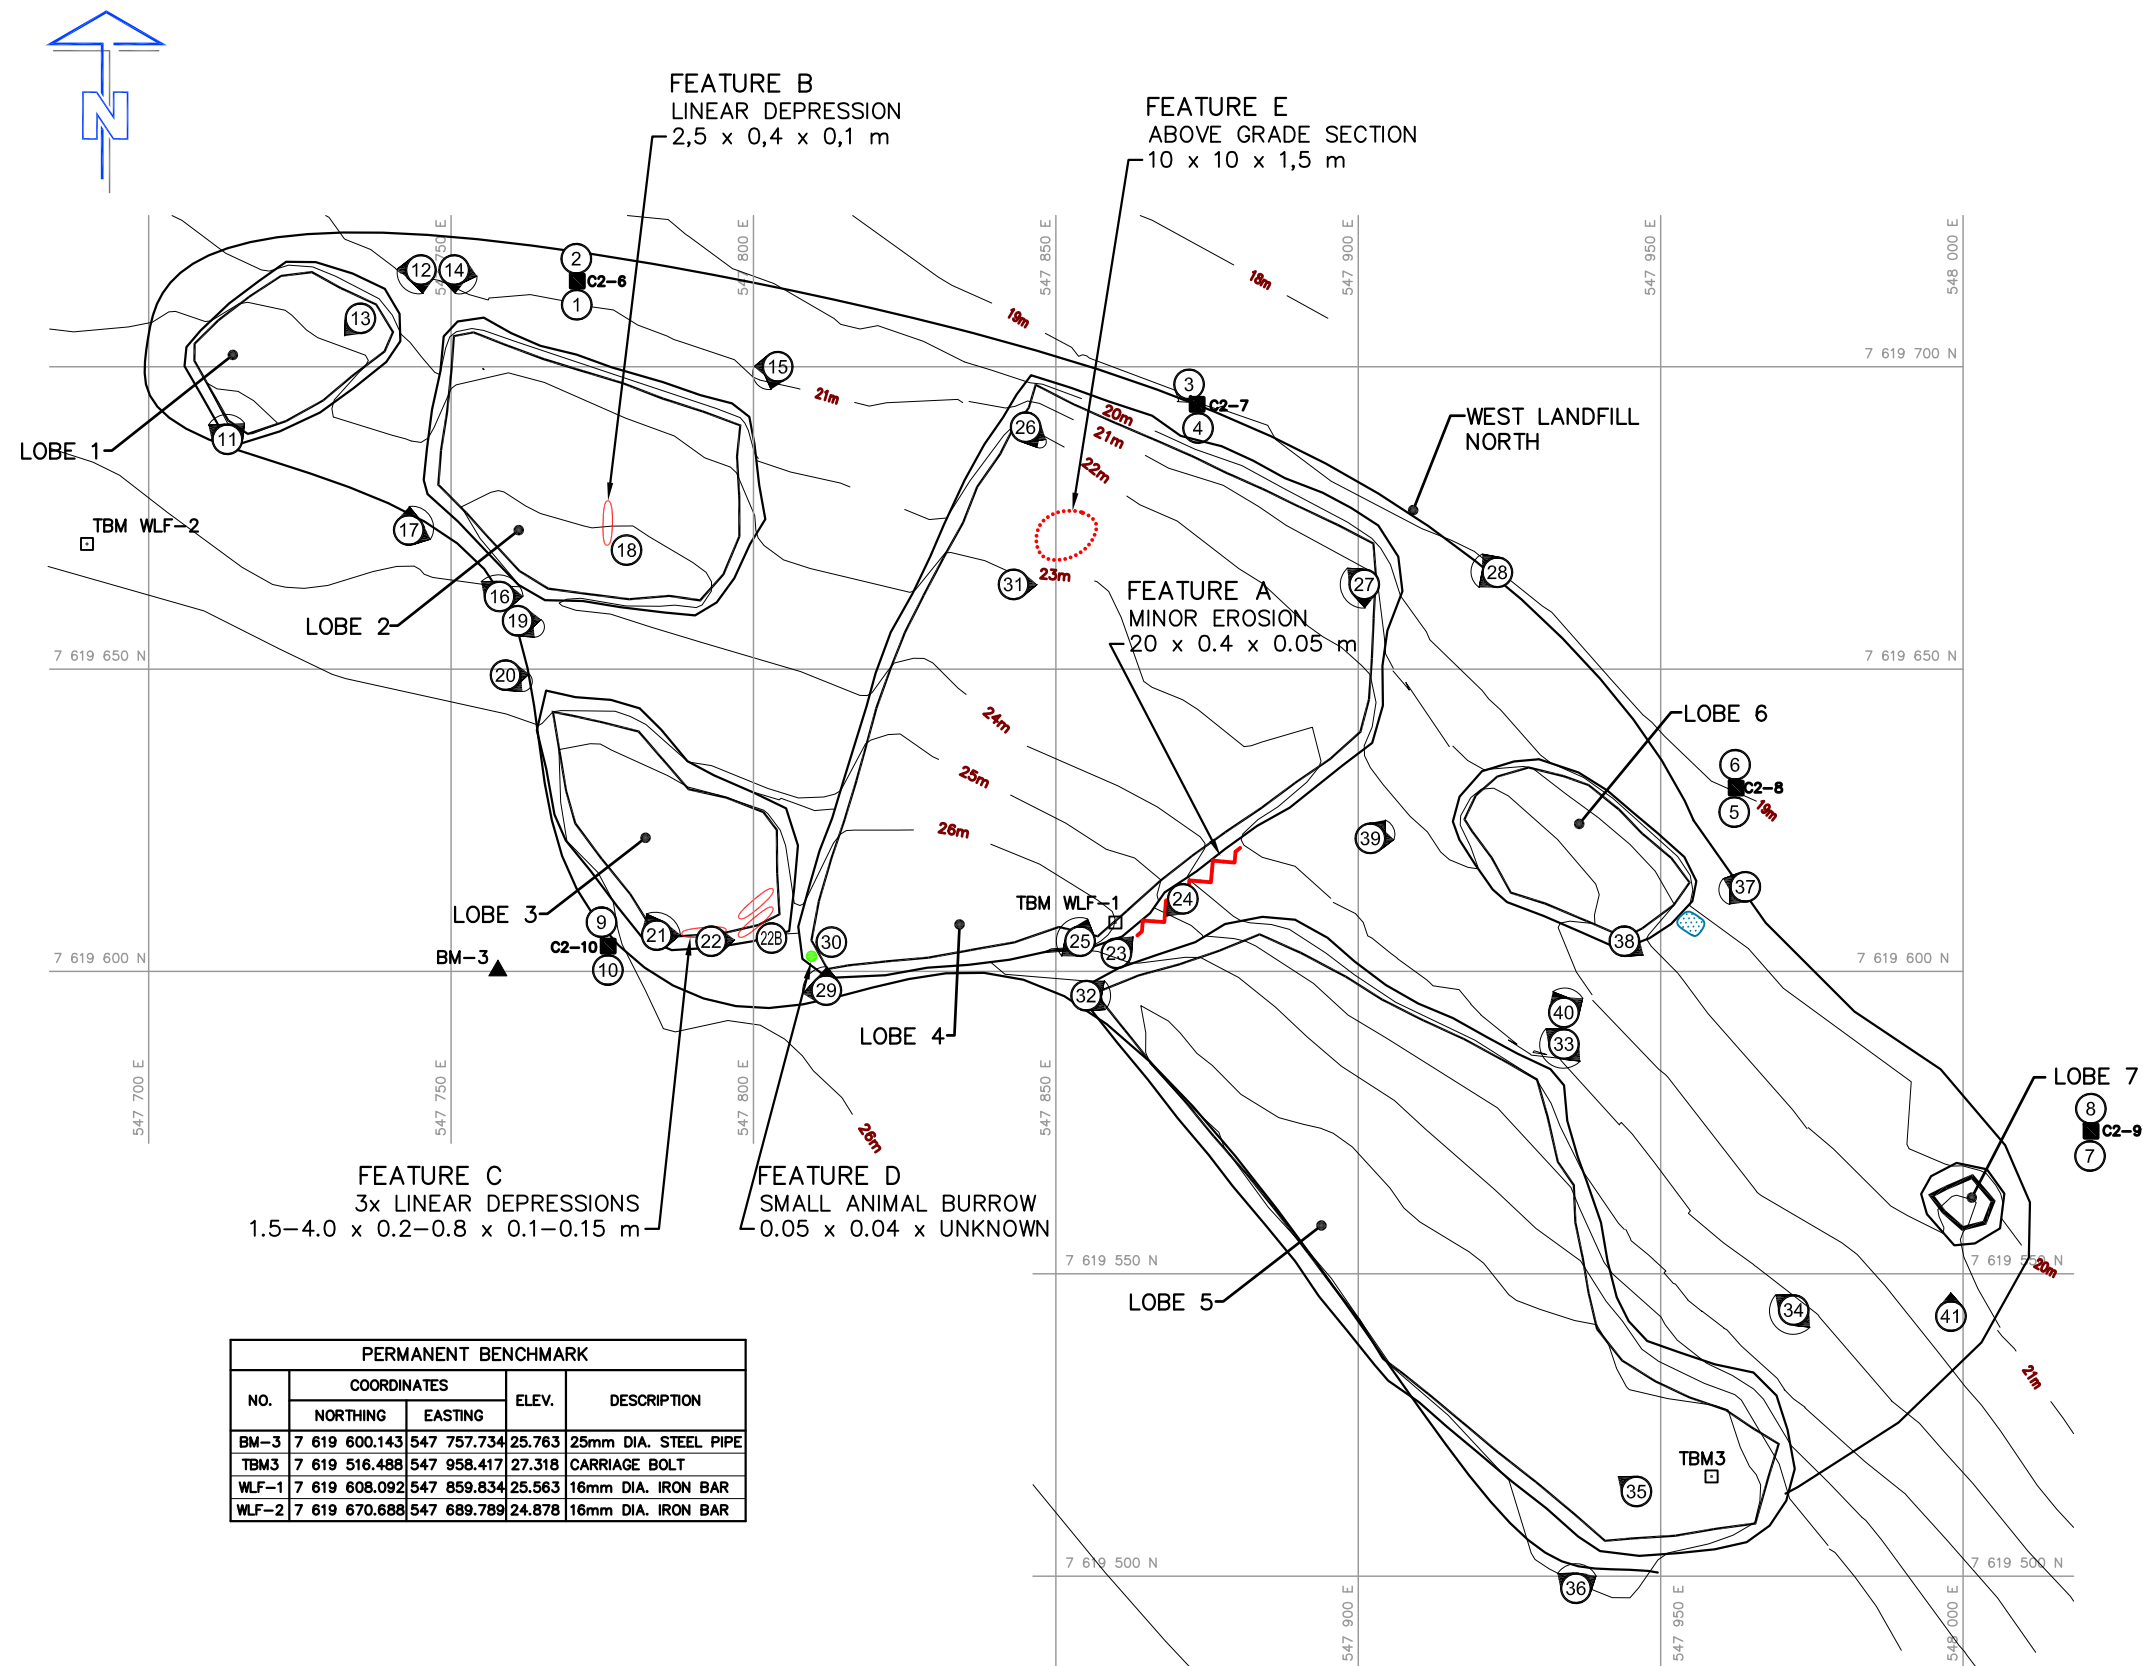

PERMANENT BENCHMARK				
NO.	COORDINATES		ELEV.	DESCRIPTION
	NORTHING	EASTING		
BM-3	7 619 600.143	547 757.734	25.763	25mm DIA. STEEL PIPE
TBM3	7 619 516.488	547 958.417	27.318	CARRIAGE BOLT
WLF-1	7 619 608.092	547 859.834	25.563	16mm DIA. IRON BAR
WLF-2	7 619 670.688	547 689.789	24.878	16mm DIA. IRON BAR

LEGEND

- TBM4 □ TEMPORARY BENCHMARK
BM-1 ▲ PERMANENT BENCHMARK
■ MONITORING SOIL SAMPLE LOCATION
Ⓢ PHOTOGRAPH LOCATION
~ EROSION (NTS)
○ SETTLEMENT (NTS)
○ RAISED AREA
● POND
● ANIMAL BURROW

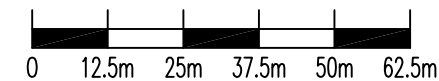

C	FINAL	13-04-19	D.L.	B.M.	A.L.
B	REVISION 1	13-02-14	A.L.	B.M.	A.L.
A	PRELIMINARY	12-11-30	P.L.	B.M.	A.L.
NO.	VERSION	DATE	PAR	VERIF.	APPR.



Construction de Défense Canada
Défence Construction Canada

FINAL REPORT COLLECTION OF LANDFILL MONITORING DATA CAM-2, GLADMAN POINT, NUNAVUT

WEST LANDFILL-NORTH

SITE REMEDIATION SOLUTIONS

Biogenie, a division of EnGlobe Corp.
4495 Wilfrid-Hamel Blvd., Suite 200
Quebec (Quebec) CANADA G1P 2J7
Phone: (418) 653-4422 Fax: (418) 653-3583



MEASUREMENT UNIT Meter	SCALE: 1 : 1,250	DATE (month-year): FEBRUARY 2013
DRAWN BY: P. LÉGARÉ	VERIFIED BY: B. MACKAY	APPROVED BY: A. LECLAIR P.ENG
PROJECT NO: CD2656_200_203	DRAWING NO: CD2656_200_203-CAM-2.3	PAGE PL

FIGURE CAM-2.3