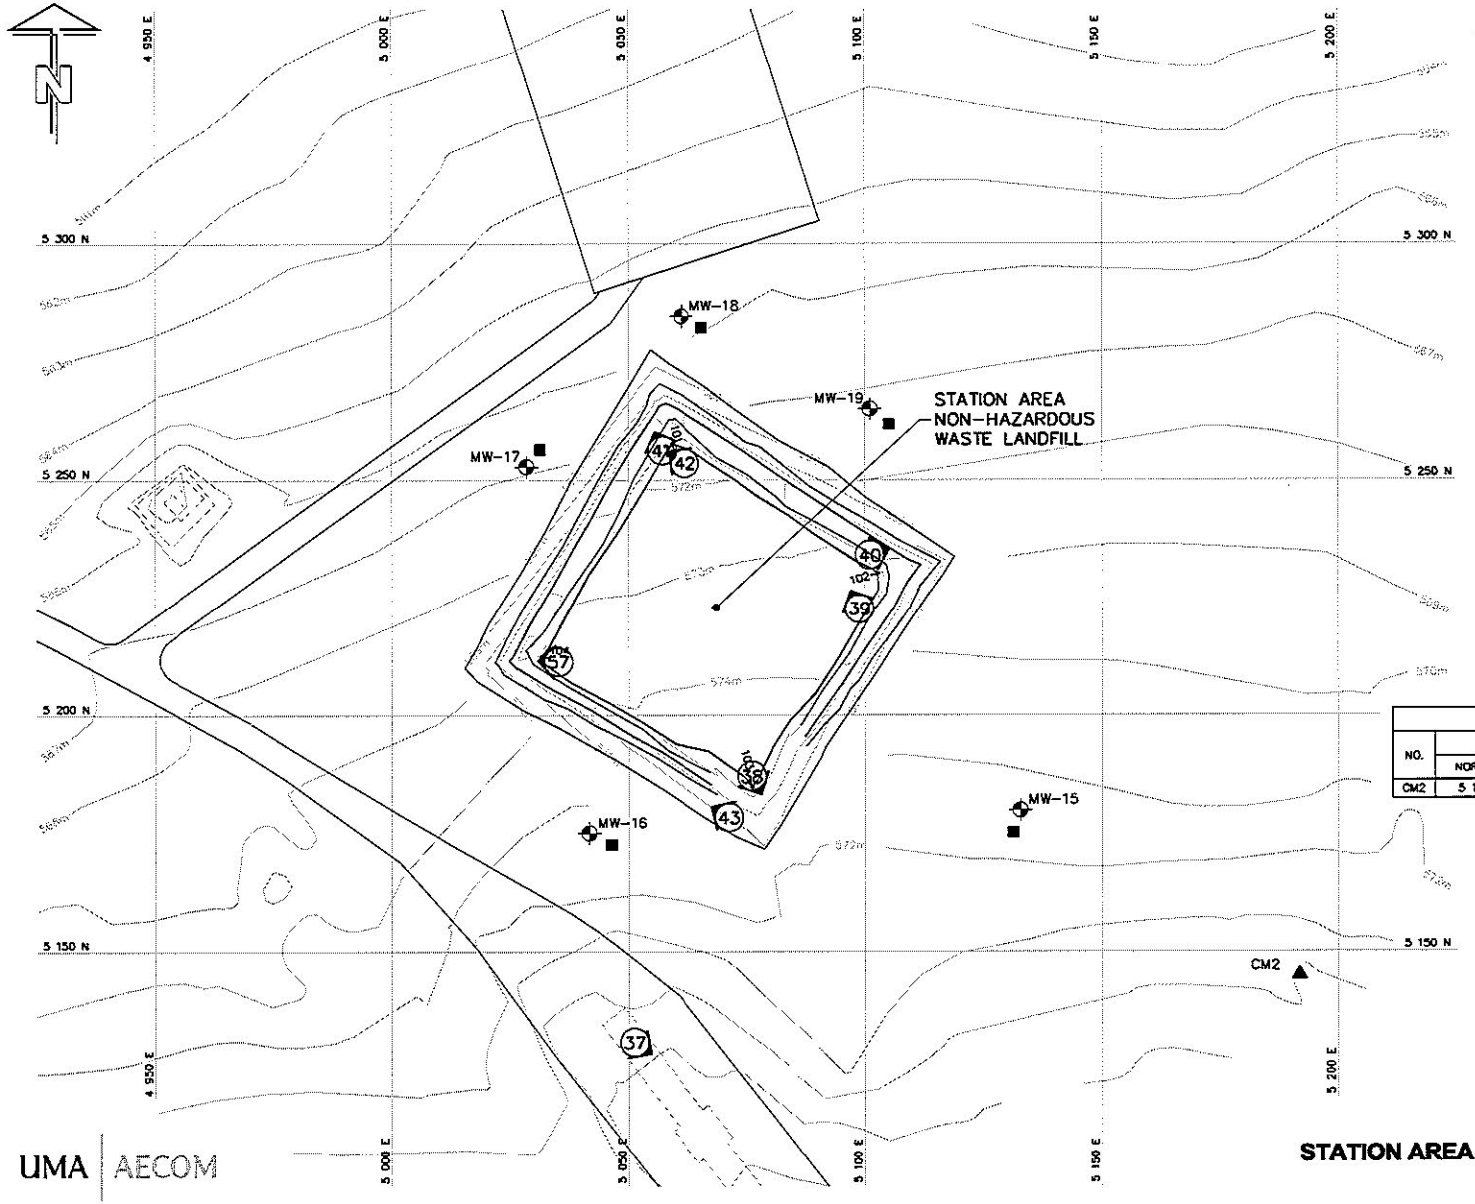

LEGEND:

TBM4 ⊡	TEMPORARY BENCHMARK
BM-1 ▲	PERMANENT BENCHMARK
101↦	COORDINATE POINT
■	MONITORING SOIL SAMPLE LOCATION
⊕	MONITORING WELL LOCATION
(39)	PHOTOGRAPHIC VIEWPOINT

COORDINATE POINTS (AS BUILT)
NON-HAZARDOUS WASTE LANDFILL

NO.	NORTHING	EASTING	ELEV.
101	5 257.7	5 059.3	571.4
102	5 230.2	5 102.8	573.5
103	5 185.1	5 076.2	574.6
104	5 212.3	5 031.6	573.5

COORDINATE POINTS (AS BUILT)
MONITORING WELLS

NO.	NORTHING	EASTING	ELEV.
MW-15	5 180.1	5 132.8	571.50
MW-16	5 175.2	5 041.7	570.63
MW-17	5 252.9	5 028.5	567.00
MW-18	5 284.7	5 061.3	565.82
MW-19	5 265.1	5 101.2	567.33

SURVEY CONTROL MONUMENTS

NO.	COORDINATES		ELEV.	DESCRIPTION
	NORTHING	EASTING		
CM2	5 145.012	5 191.951	574.530	FOX-5 BASELINE STA. -2+07.90

SCALE 1:1000 m
0 10 20 30

RECORD DRAWING
NOT FOR CONSTRUCTION

DEW LINE CLEAN UP
LANDFILL MONITORING PLAN

FOX-5 BROUGHTON ISLAND

STATION AREA NON-HAZARDOUS WASTE LANDFILL

FIGURE FOX-5.2

UMA | AECOM

DWG NAME: FX-5002DWG CLC - 07/11/13