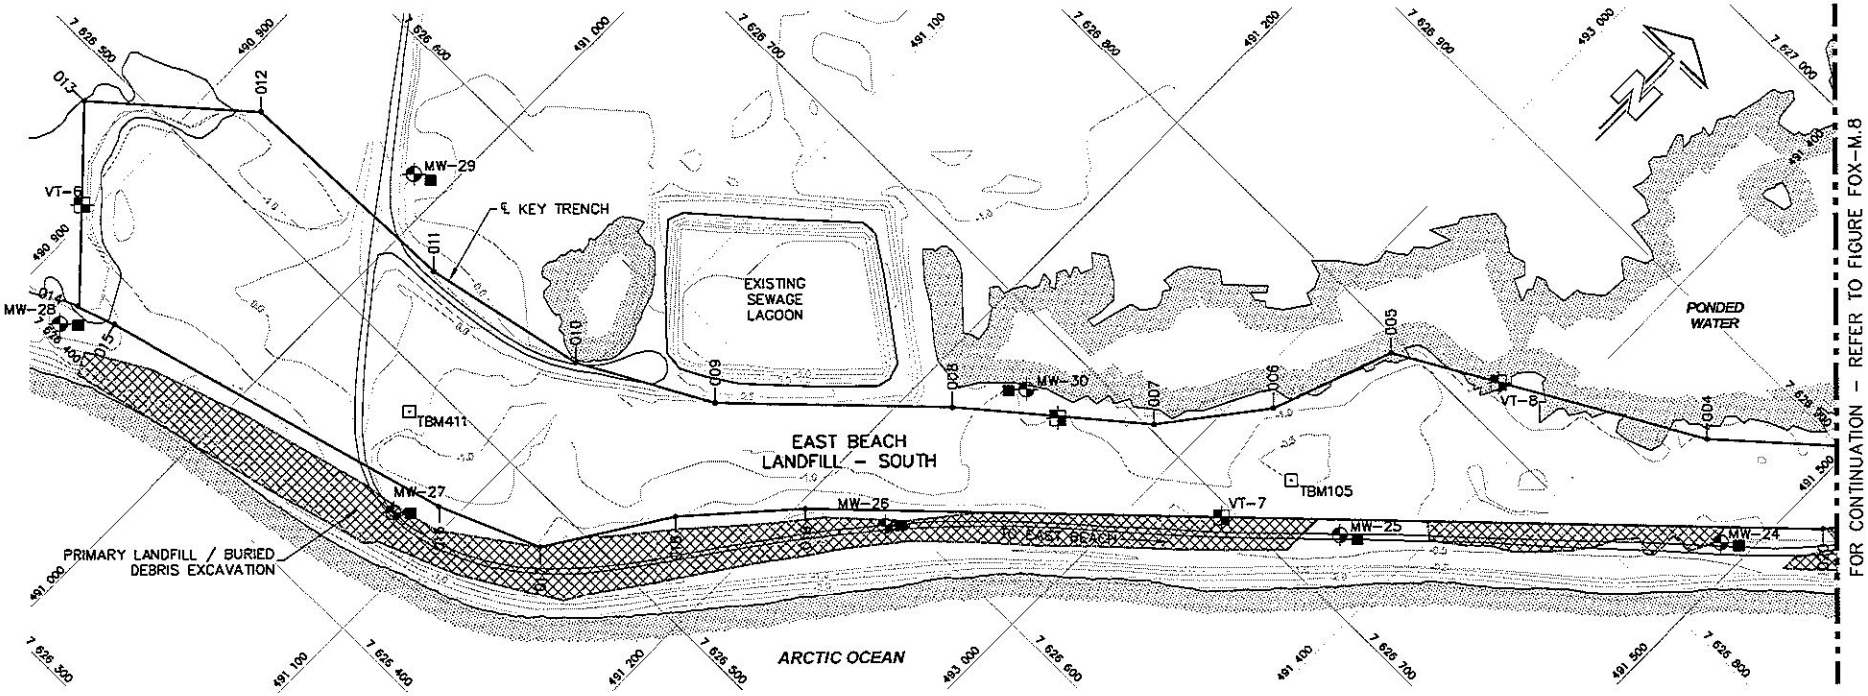

KEY TRENCH CENTRELINE COORDINATE POINTS

NO.	COORDINATES		NO.	COORDINATES	
	NORTHING	EASTING		NORTHING	EASTING
004	7 626 920.9	491 555.4	013	7 626 531.6	490 921.2
005	7 626 869.8	491 515.5	014	7 626 534.5	491 020.7
006	7 626 573.7	491 203.2	015	7 626 549.3	491 090.4
007	7 626 533.0	491 165.5	016	7 626 578.7	491 144.6
008	7 626 483.2	491 134.6	017	7 626 647.8	491 217.0
009	7 626 455.4	491 092.2	018	7 626 702.3	491 282.6
010	7 626 423.8	490 940.3	019	7 626 742.8	491 314.0
011	7 626 418.4	490 924.9	020	7 626 794.3	491 332.9
012	7 626 482.1	490 864.6			

COORDINATE POINTS (AS-BUILT) VERTICAL THERMISTORS

NO.	NORTHING	EASTING
VT-5	TBD	TBD
VT-7	TBD	TBD
VT-8	TBD	TBD

TEMPORARY BENCHMARKS

NO.	UTM COORDINATES		ELEV.
	NORTHING	EASTING	
TBM106	7 627 001.134	491 547.332	–1.054
TBM411	7 626 485.282	491 055.174	–0.112

0 20 40 m SCALE 1:2000

COORDINATE POINTS (AS BUILT) MONITORING WELLS

NO.	NORTHING	EASTING	ELEV.
MW-24	7 626 835.4	491 488.8	0.01
MW-25	7 626 724.5	491 371.8	0.24
MW-26	7 626 592.2	491 232.3	0.57
MW-27	7 626 450.3	491 080.3	–0.10
MW-28	7 626 407.7	490 923.9	–0.42
MW-29	7 626 558.2	490 985.7	–0.03
MW-30	7 626 675.1	491 234.0	–1.03

LEGEND:

- SURVEY CONTROL MONUMENT
- TEMPORARY BENCHMARK
- 2002 COORDINATE POINT
- MONITORING SOIL SAMPLE LOCATION
- MONITORING WELL LOCATION
- VERTICAL THERMISTOR LOCATION

NOTE: DRAWING TO BE UPDATED BASED ON RECORD INFORMATION

UMA | AECOM

DEW LINE CLEAN UP
LANDFILL MONITORING PLAN

FOX-M BROUGHTON ISLAND

EAST BEACH LANDFILL - SOUTH

FIGURE FOX-M.7

DGS NAME: FX-M07.DNG CLC - 07/12/11