



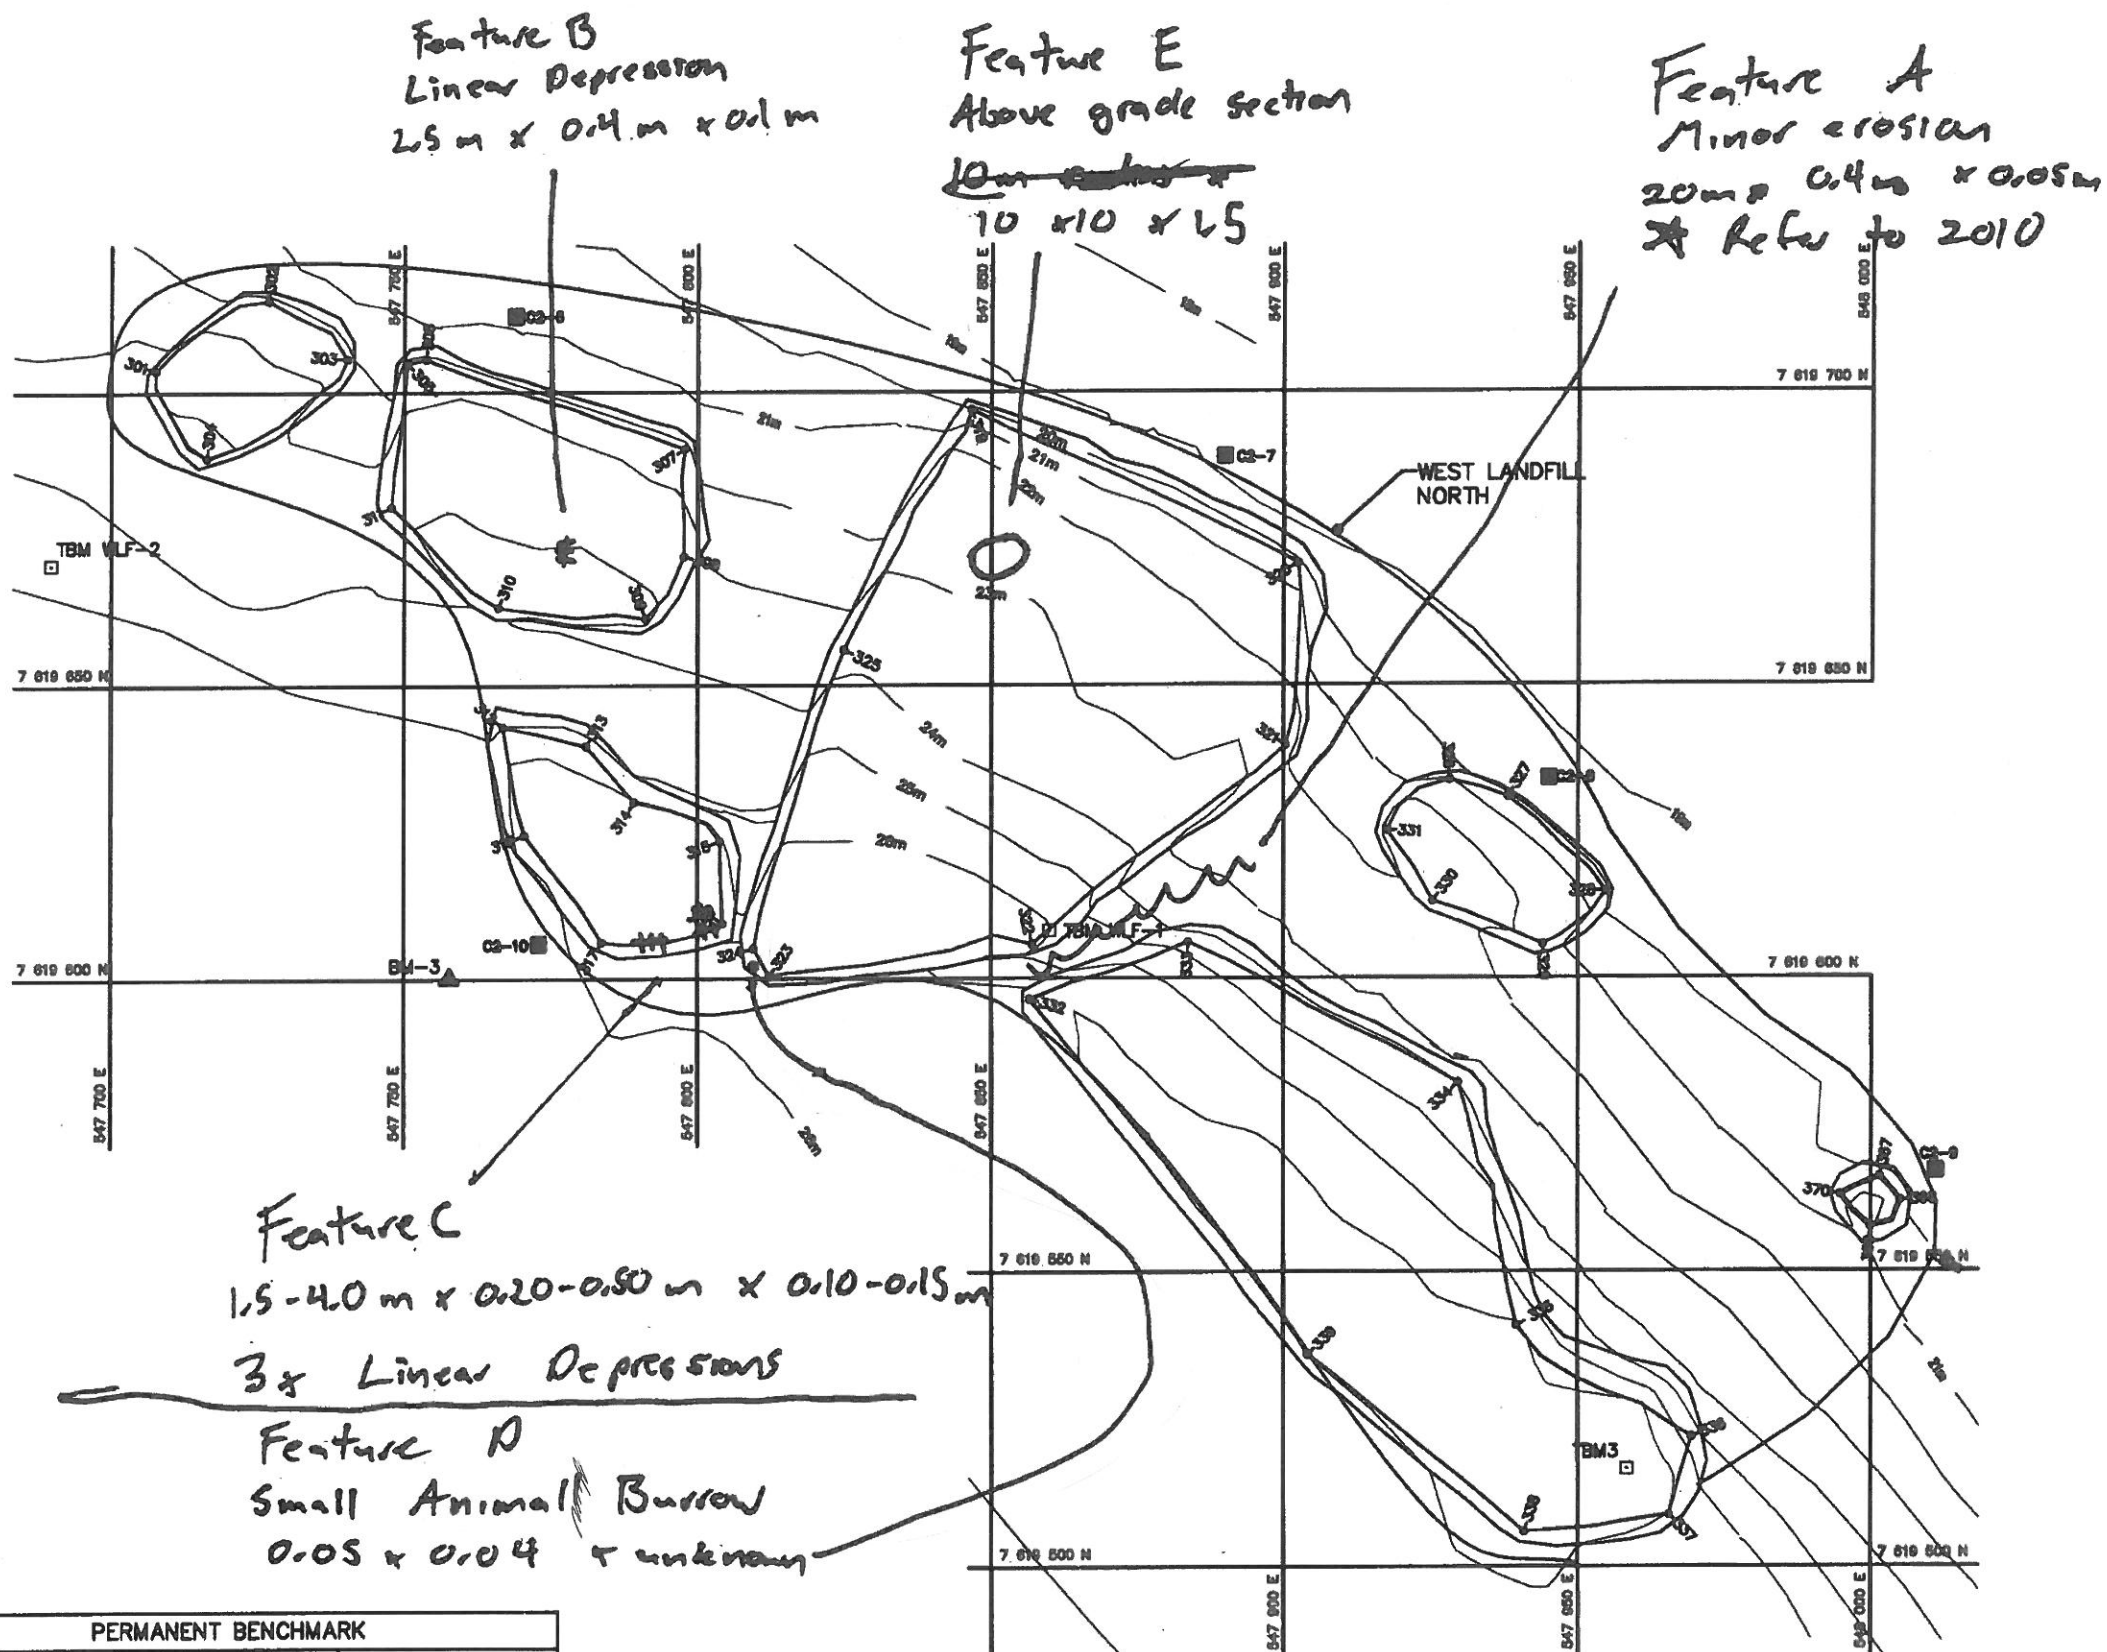

PERMANENT BENCHMARK				
NO.	COORDINATES		ELEV.	DESCRIPTION
	NORTHING	EASTING		
BM-3	7 619 600.143	547 757.734	25.783	25mm DIA. STEEL PIPE
TBM3	7 619 518.488	547 958.417	27.318	CARRIAGE BOLT
WLF-1	7 619 608.082	547 859.834	25.563	16mm DIA. IRON BAR
WLF-2	7 619 670.688	547 689.789	24.878	16mm DIA. IRON BAR

LEGEND

- TBM4 TEMPORARY BENCHMARK
- BM-1 PERMANENT BENCHMARK
- 101- COORDINATE POINT
- MONITORING SOIL SAMPLE LOCATION

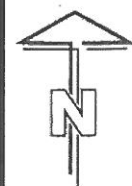

A	FINAL VERSION	10-08-27	PL	EC	JPP
NO.	VERSION	DATE	BY	VERIF.	APPR.



Construction de Défense Canada
Defence Construction Canada

LOGISTICS PLAN COLLECTION OF LANDFILL MONITORING DATA CAM-2, KITIKMEOT REGION (NUNAVUT)

WEST LANDFILL NORTH

SITE REMEDIATION SOLUTIONS

Biogénie, a division of EnGlobe Corp.
4485 Wilfrid-Hamel Blvd., Suite 200
Quebec (Quebec) CANADA G1P 2J7
Phone: (418) 653-4422 Fax: (418) 653-3583



MEASUREMENT UNIT	SCALE:	DATE (month-year):
Metre	1 : 1,250	JUNE 2010
DRAWN BY:	VERIFIED BY:	APPROVED BY:
P. LEGARE	E. CARRERE	J.-P. PELLETIER
PROJECT NO:	DRAWING NO:	PAGE
CD9229_001_110	CD9229_001_110-CAM-2_B	PL

APPENDIX