



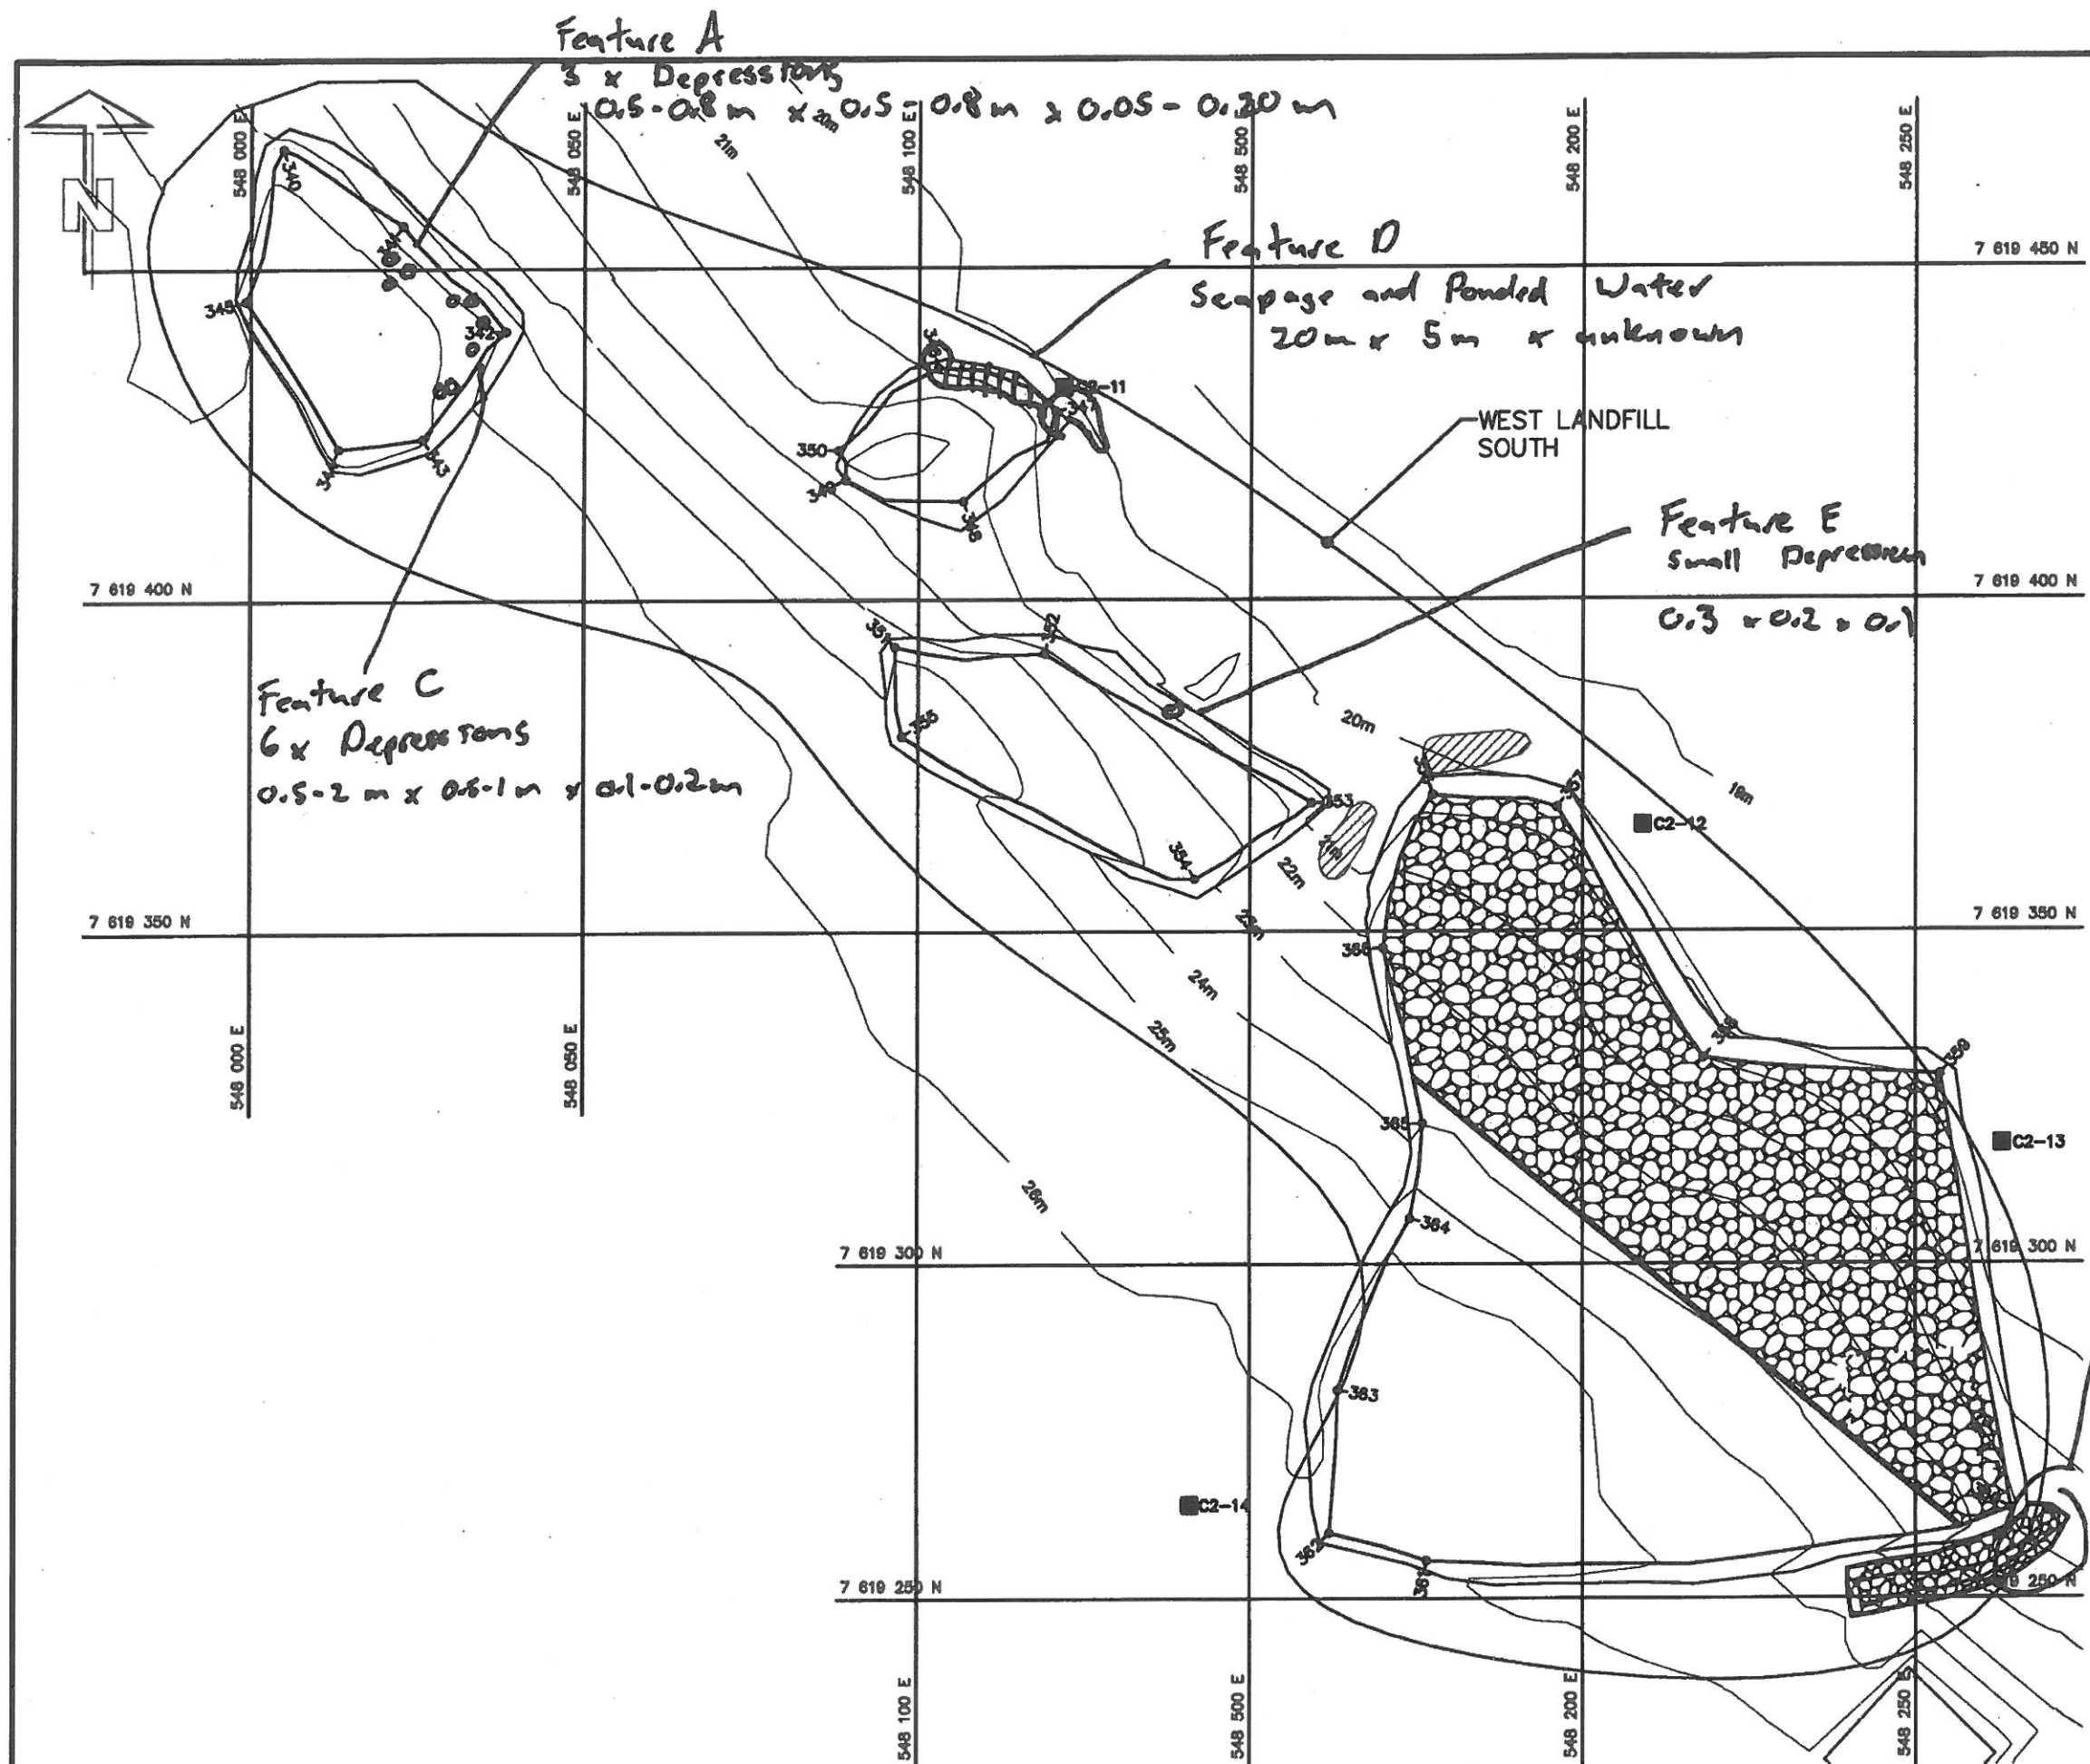

LEGEND

- TBM4 □ TEMPORARY BENCHMARK
- BM-1 ▲ PERMANENT BENCHMARK
- 101- COORDINATE POINT
- MONITORING SOIL SAMPLE LOCATION
- ▨ PONDED WATER

Feature B is around here, unchanged from previous report & see previous report

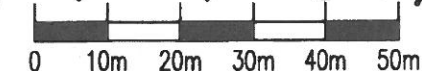

NO.	FINAL VERSION	10-05-27	PL	EC	JPP.
	VERSION	BY	PAR	VERIF.	APPR.



Construction de Défense Canada
Defence Construction Canada

LOGISTICS PLAN COLLECTION OF LANDFILL MONITORING DATA CAM-2, KITIKMEOT REGION (NUNAVUT) WEST LANDFILL SOUTH

SITE REMEDIATION SOLUTIONS

Biogenie, a division of EnGlobe Corp.
4485 Wilfrid-Hamel Blvd., Suite 200
Quebec (Quebec) CANADA G1P 2J7
Phone: (418) 653-4422 Fax: (418) 653-3583



MEASUREMENT UNIT Meter	SCALE: 1 : 1,000	DATE (month-year): JUNE 2010
DRAWN BY: P. LÉGARÉ	VERIFIED BY: E. CARRIÈRE	APPROVED BY: J.-P. PELLETIER
PROJECT NO: CD9229_001_110	DRAWING NO: CD9229_001_110-CAM-2_C	PAGE PL

APPENDIX

FIGURE