

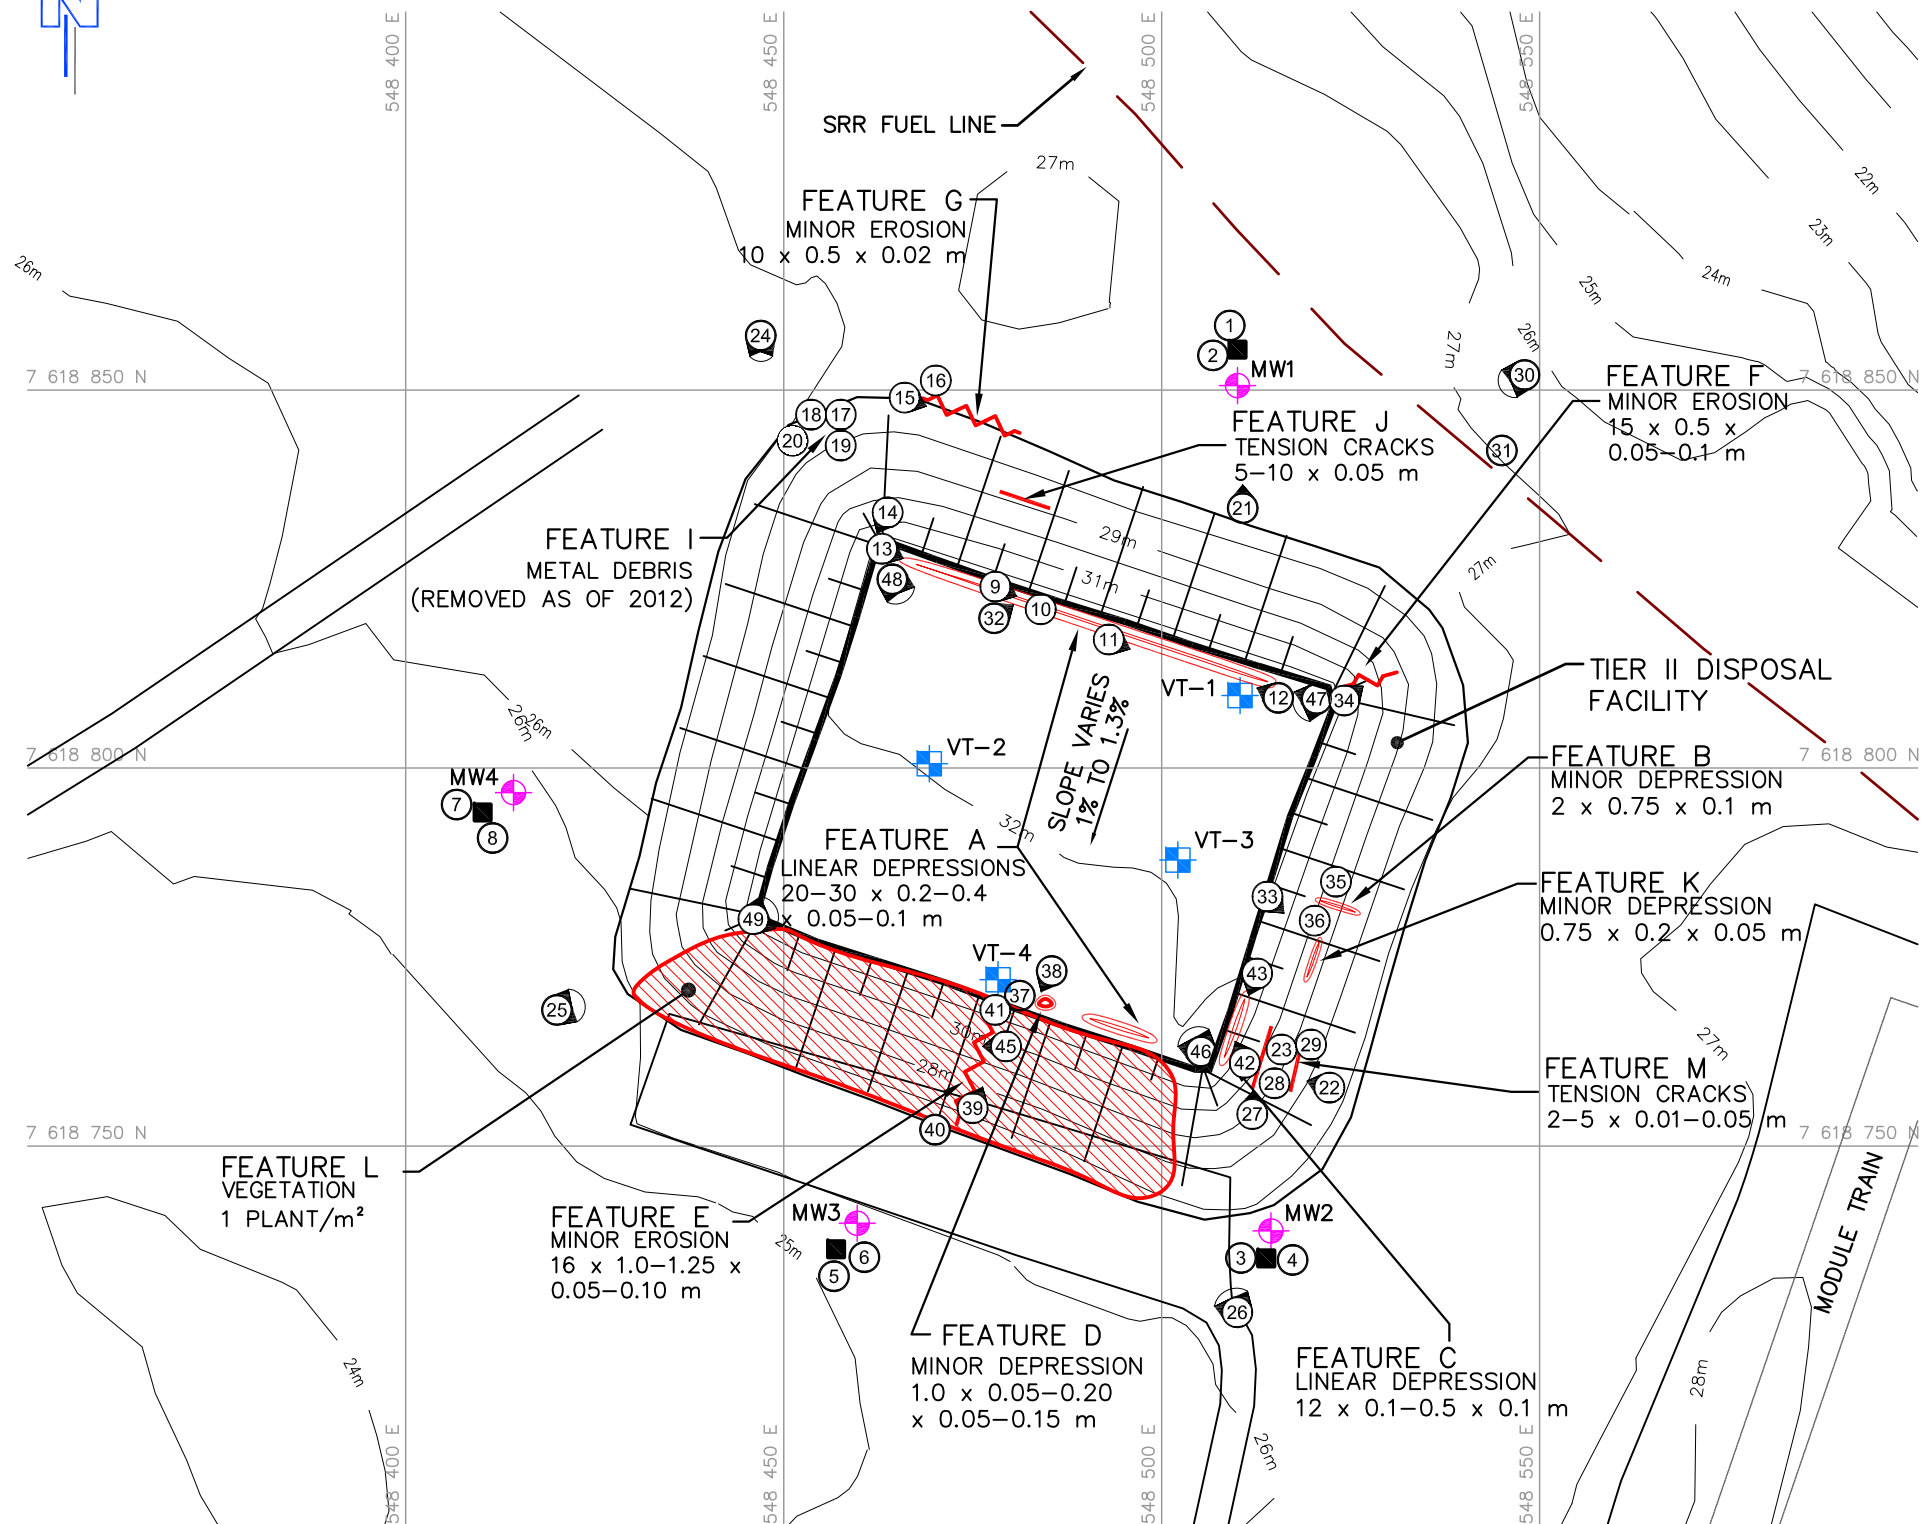


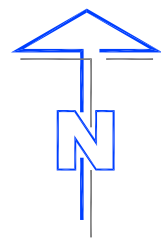

LEGEND

- MONITORING SOIL SAMPLE LOCATION
- ⊕ MONITORING WELL LOCATION
- ⊕ VERTICAL THERMISTOR LOCATION
- ⊕ PHOTOGRAPH LOCATION
- ~ SURFICIAL EROSION (NTS)
- TENSION CRACK (NTS)
- SETTLEMENT (NTS)
- ▨ VEGETATION

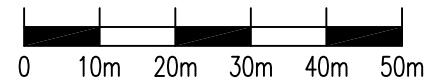

C	FINAL	13-04-19	D.L.	B.M.	A.L.
B	REVISION 1	13-02-14	A.L.	B.M.	A.L.
A	PRELIMINARY	12-11-30	P.L.	B.M.	A.L.
NO.	VERSION	DATE	PAR	VERIF.	APPR.



Construction de Défense Canada
Défence Construction Canada

FINAL REPORT COLLECTION OF LANDFILL MONITORING DATA CAM-2, GLADMAN POINT, NUNAVUT TIER II DISPOSAL FACILITY

SITE REMEDIATION SOLUTIONS

Biogenie, a division of EnGlobe Corp.
4495 Wilfrid-Hamel Blvd., Suite 200
Quebec (Quebec) CANADA G1P 2J7
Phone: (418) 653-4422 Fax: (418) 653-3583



MEASUREMENT UNIT Meter	SCALE: 1 : 1,000	DATE (month-year): FEBRUARY 2013
DRAWN BY: P. LÉGARÉ	VERIFIED BY: B. MACKAY	APPROVED BY: A. LECLAIR P.ENG
PROJECT NO: CD2656_200_203	DRAWING NO: CD2656_200_203-CAM-2_5	PAGE PL

FIGURE CAM-2.5