


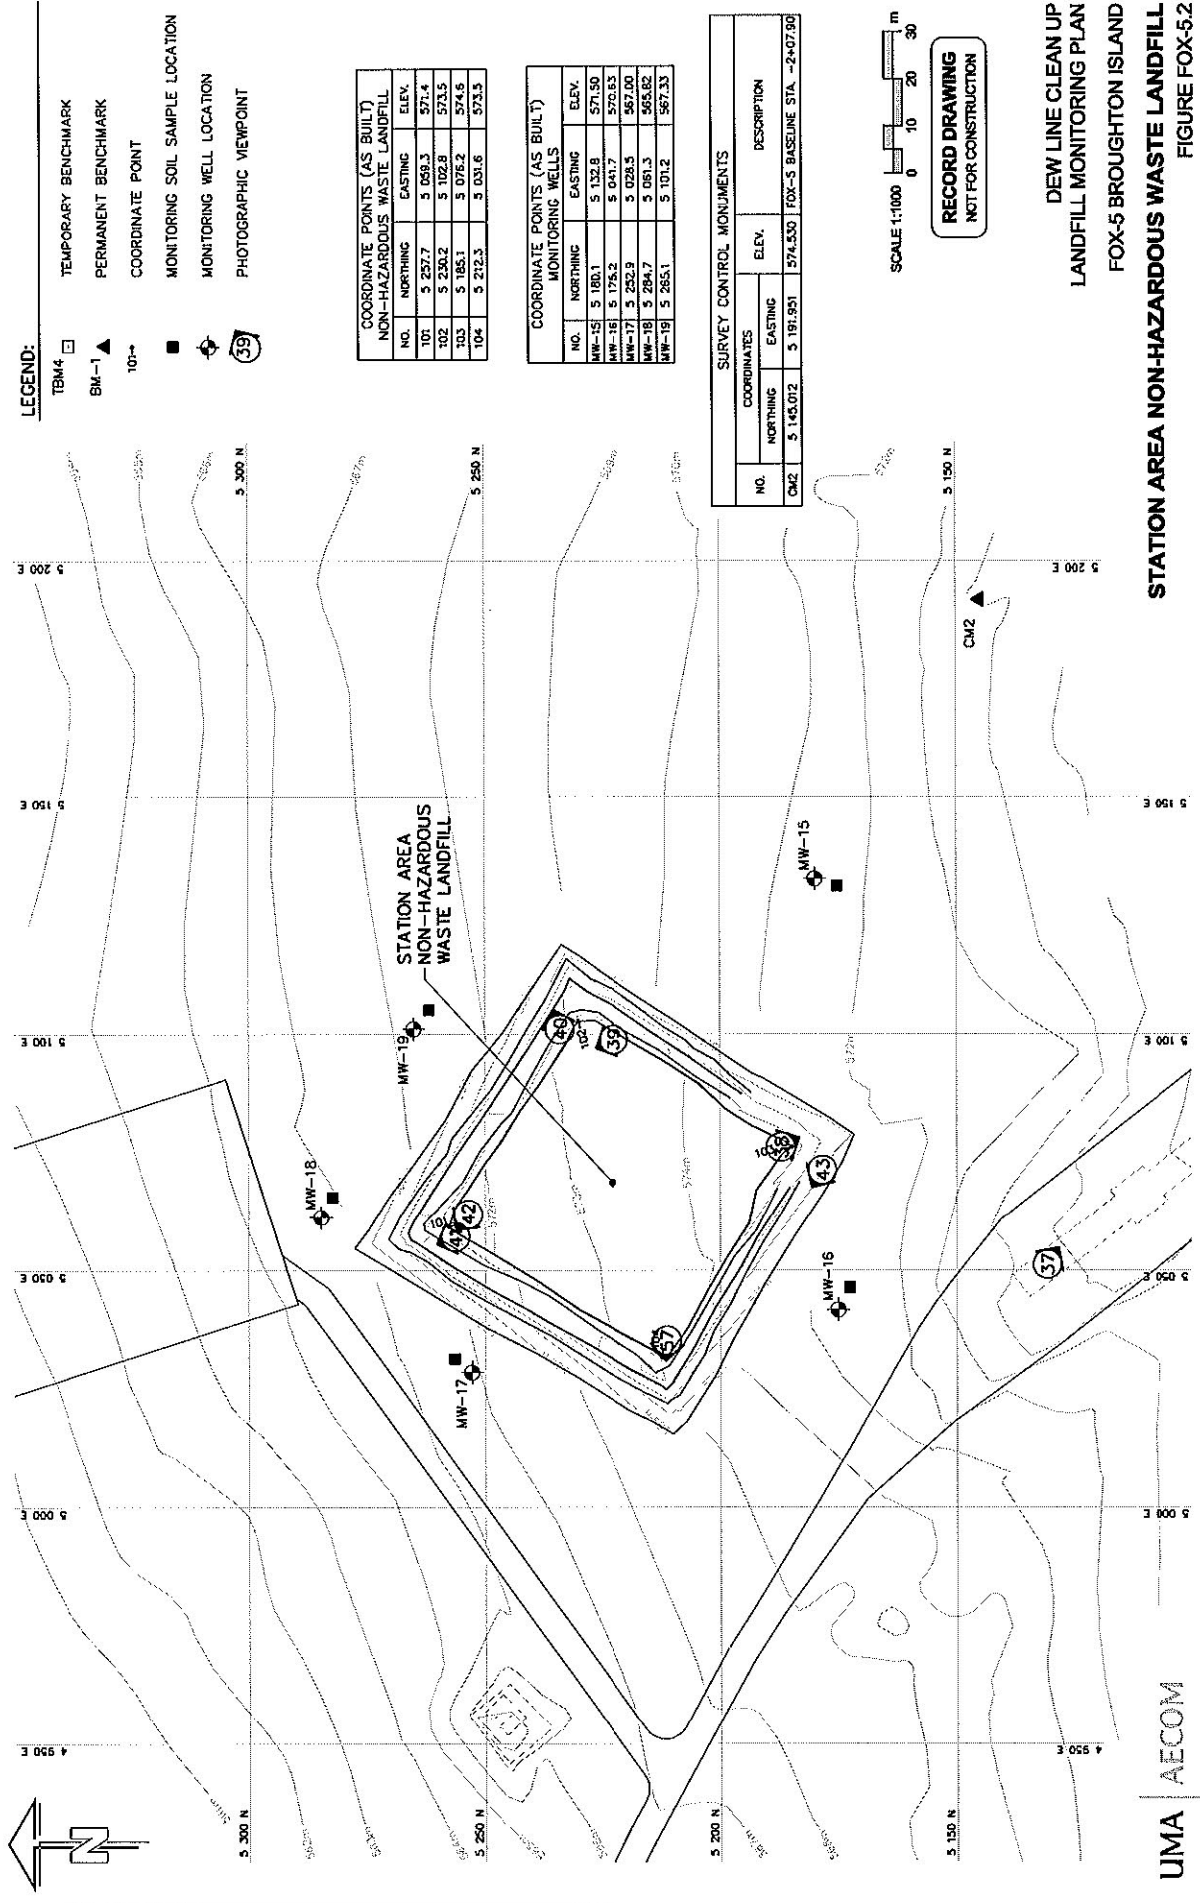

STATION AREA NON-HAZARDOUS WASTE LANDFILL  
FIGURE FOX-5.2