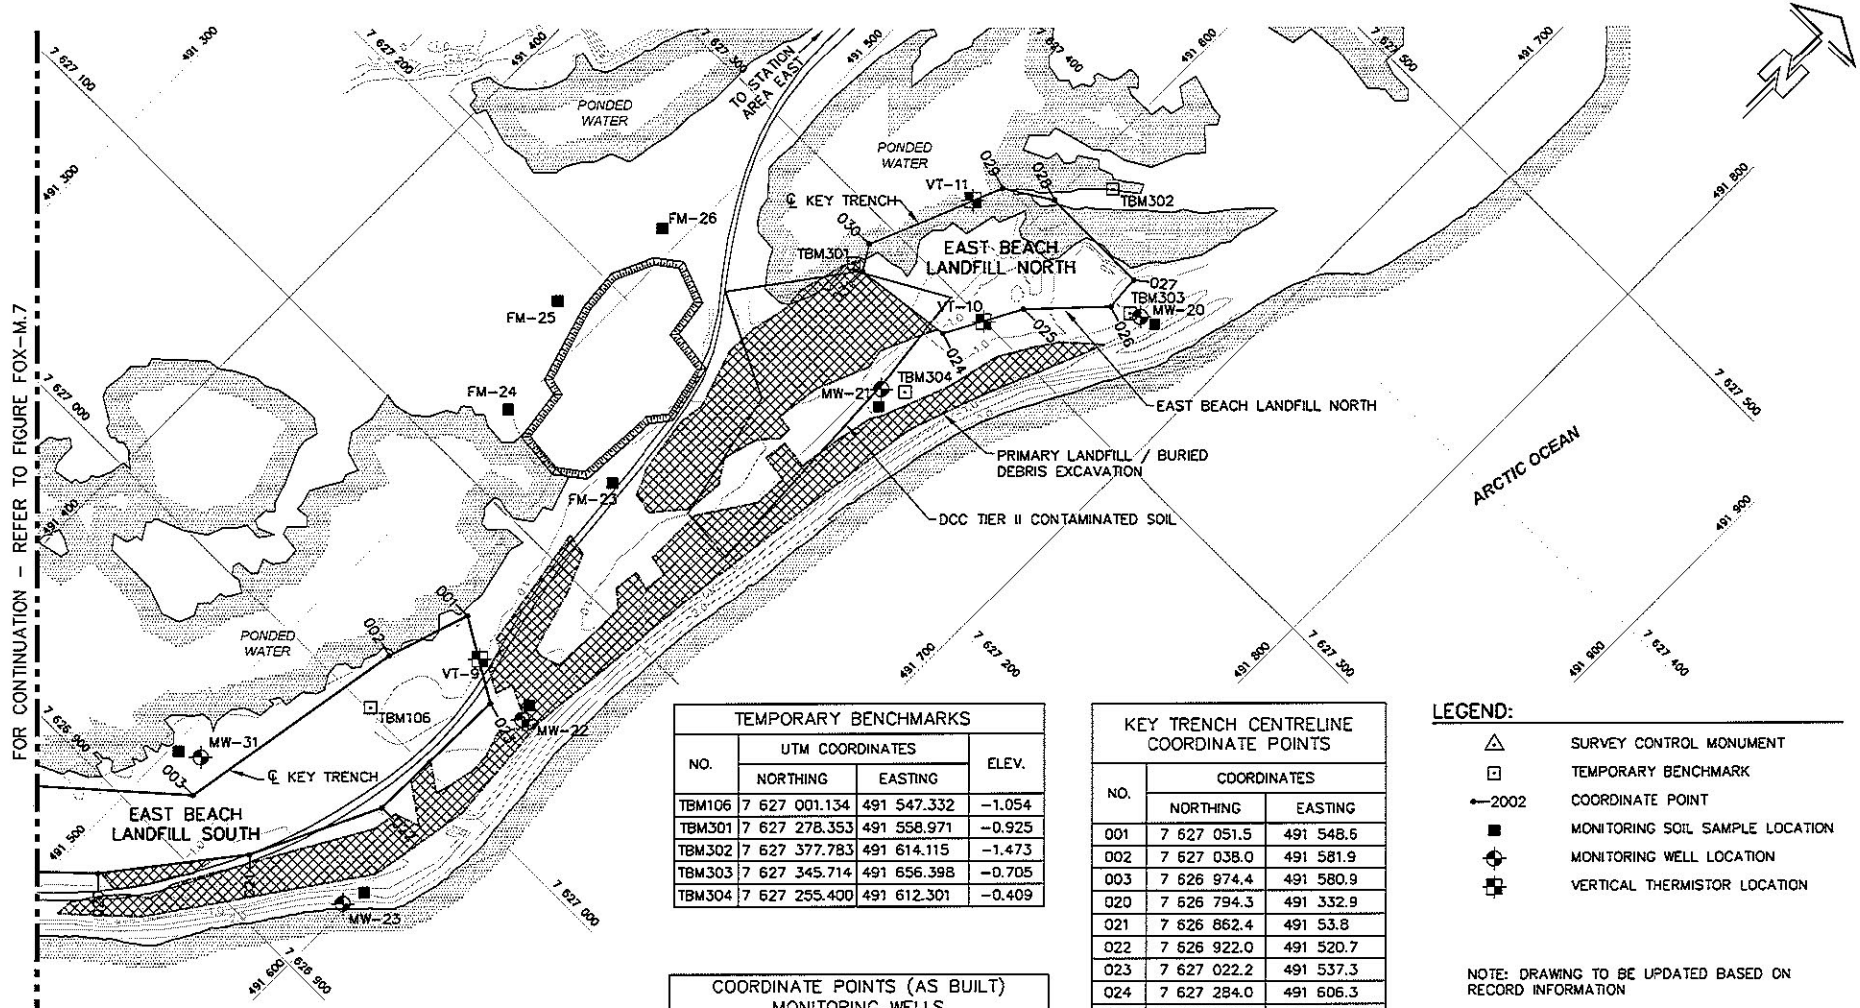

TEMPORARY BENCHMARKS			
NO.	UTM COORDINATES		ELEV.
	NORTHING	EASTING	
TBM106	7 627 001.134	491 547.332	−1.054
TBM301	7 627 278.353	491 558.971	−0.925
TBM302	7 627 377.783	491 614.115	−1.473
TBM303	7 627 345.714	491 656.398	−0.705
TBM304	7 627 255.400	491 612.301	−0.409

KEY TRENCH CENTRELINE COORDINATE POINTS		
NO.	COORDINATES	
	NORTHING	EASTING
001	7 627 051.5	491 548.6
002	7 627 038.0	491 581.9
003	7 626 974.4	491 580.9
020	7 626 794.3	491 332.9
021	7 626 862.4	491 53.8
022	7 626 922.0	491 520.7
023	7 627 022.2	491 537.3
024	7 627 284.0	491 606.3
025	7 627 315.2	491 623.1
026	7 627 342.0	491 648.6
027	7 627 356.7	491 647.5
028	7 627 657.0	491 599.8
029	7 627 345.1	491 580.9
030	7 627 288.7	491 557.8
031	7 627 278.5	491 564.1

COORDINATE POINTS (AS-BUILT) VERTICAL THERMISTORS		
NO.	NORTHING	EASTING
VT-9	TBD	TBD
VT-10	TBD	TBD
VT-11	TBD	TBD

COORDINATE POINTS (AS BUILT) MONITORING WELLS			
NO.	NORTHING	EASTING	ELEV.
MW-20	7 627 347.8	491 660.5	−0.03
MW-21	7 627 249.3	491 604.4	−0.60
MW-22	7 627 041.6	491 596.1	−0.48
MW-23	TBD	TBD	-
MW-31	7 626 935.6	491 511.6	−0.21

LEGEND:

- SURVEY CONTROL MONUMENT
- TEMPORARY BENCHMARK
- 2002 COORDINATE POINT
- MONITORING SOIL SAMPLE LOCATION
- MONITORING WELL LOCATION
- VERTICAL THERMISTOR LOCATION

NOTE: DRAWING TO BE UPDATED BASED ON RECORD INFORMATION

UMA | AECOM

DEW LINE CLEAN UP
LANDFILL MONITORING PLAN

FOX-M HALL BEACH

EAST BEACH LANDFILL - NORTH

FIGURE FOX-M.8