



G:\CD9229\2012\CAM-1\FINAL\CD9229_004_160-CAM-1.5-PL.dwg, 2013-04-02 11:44:20

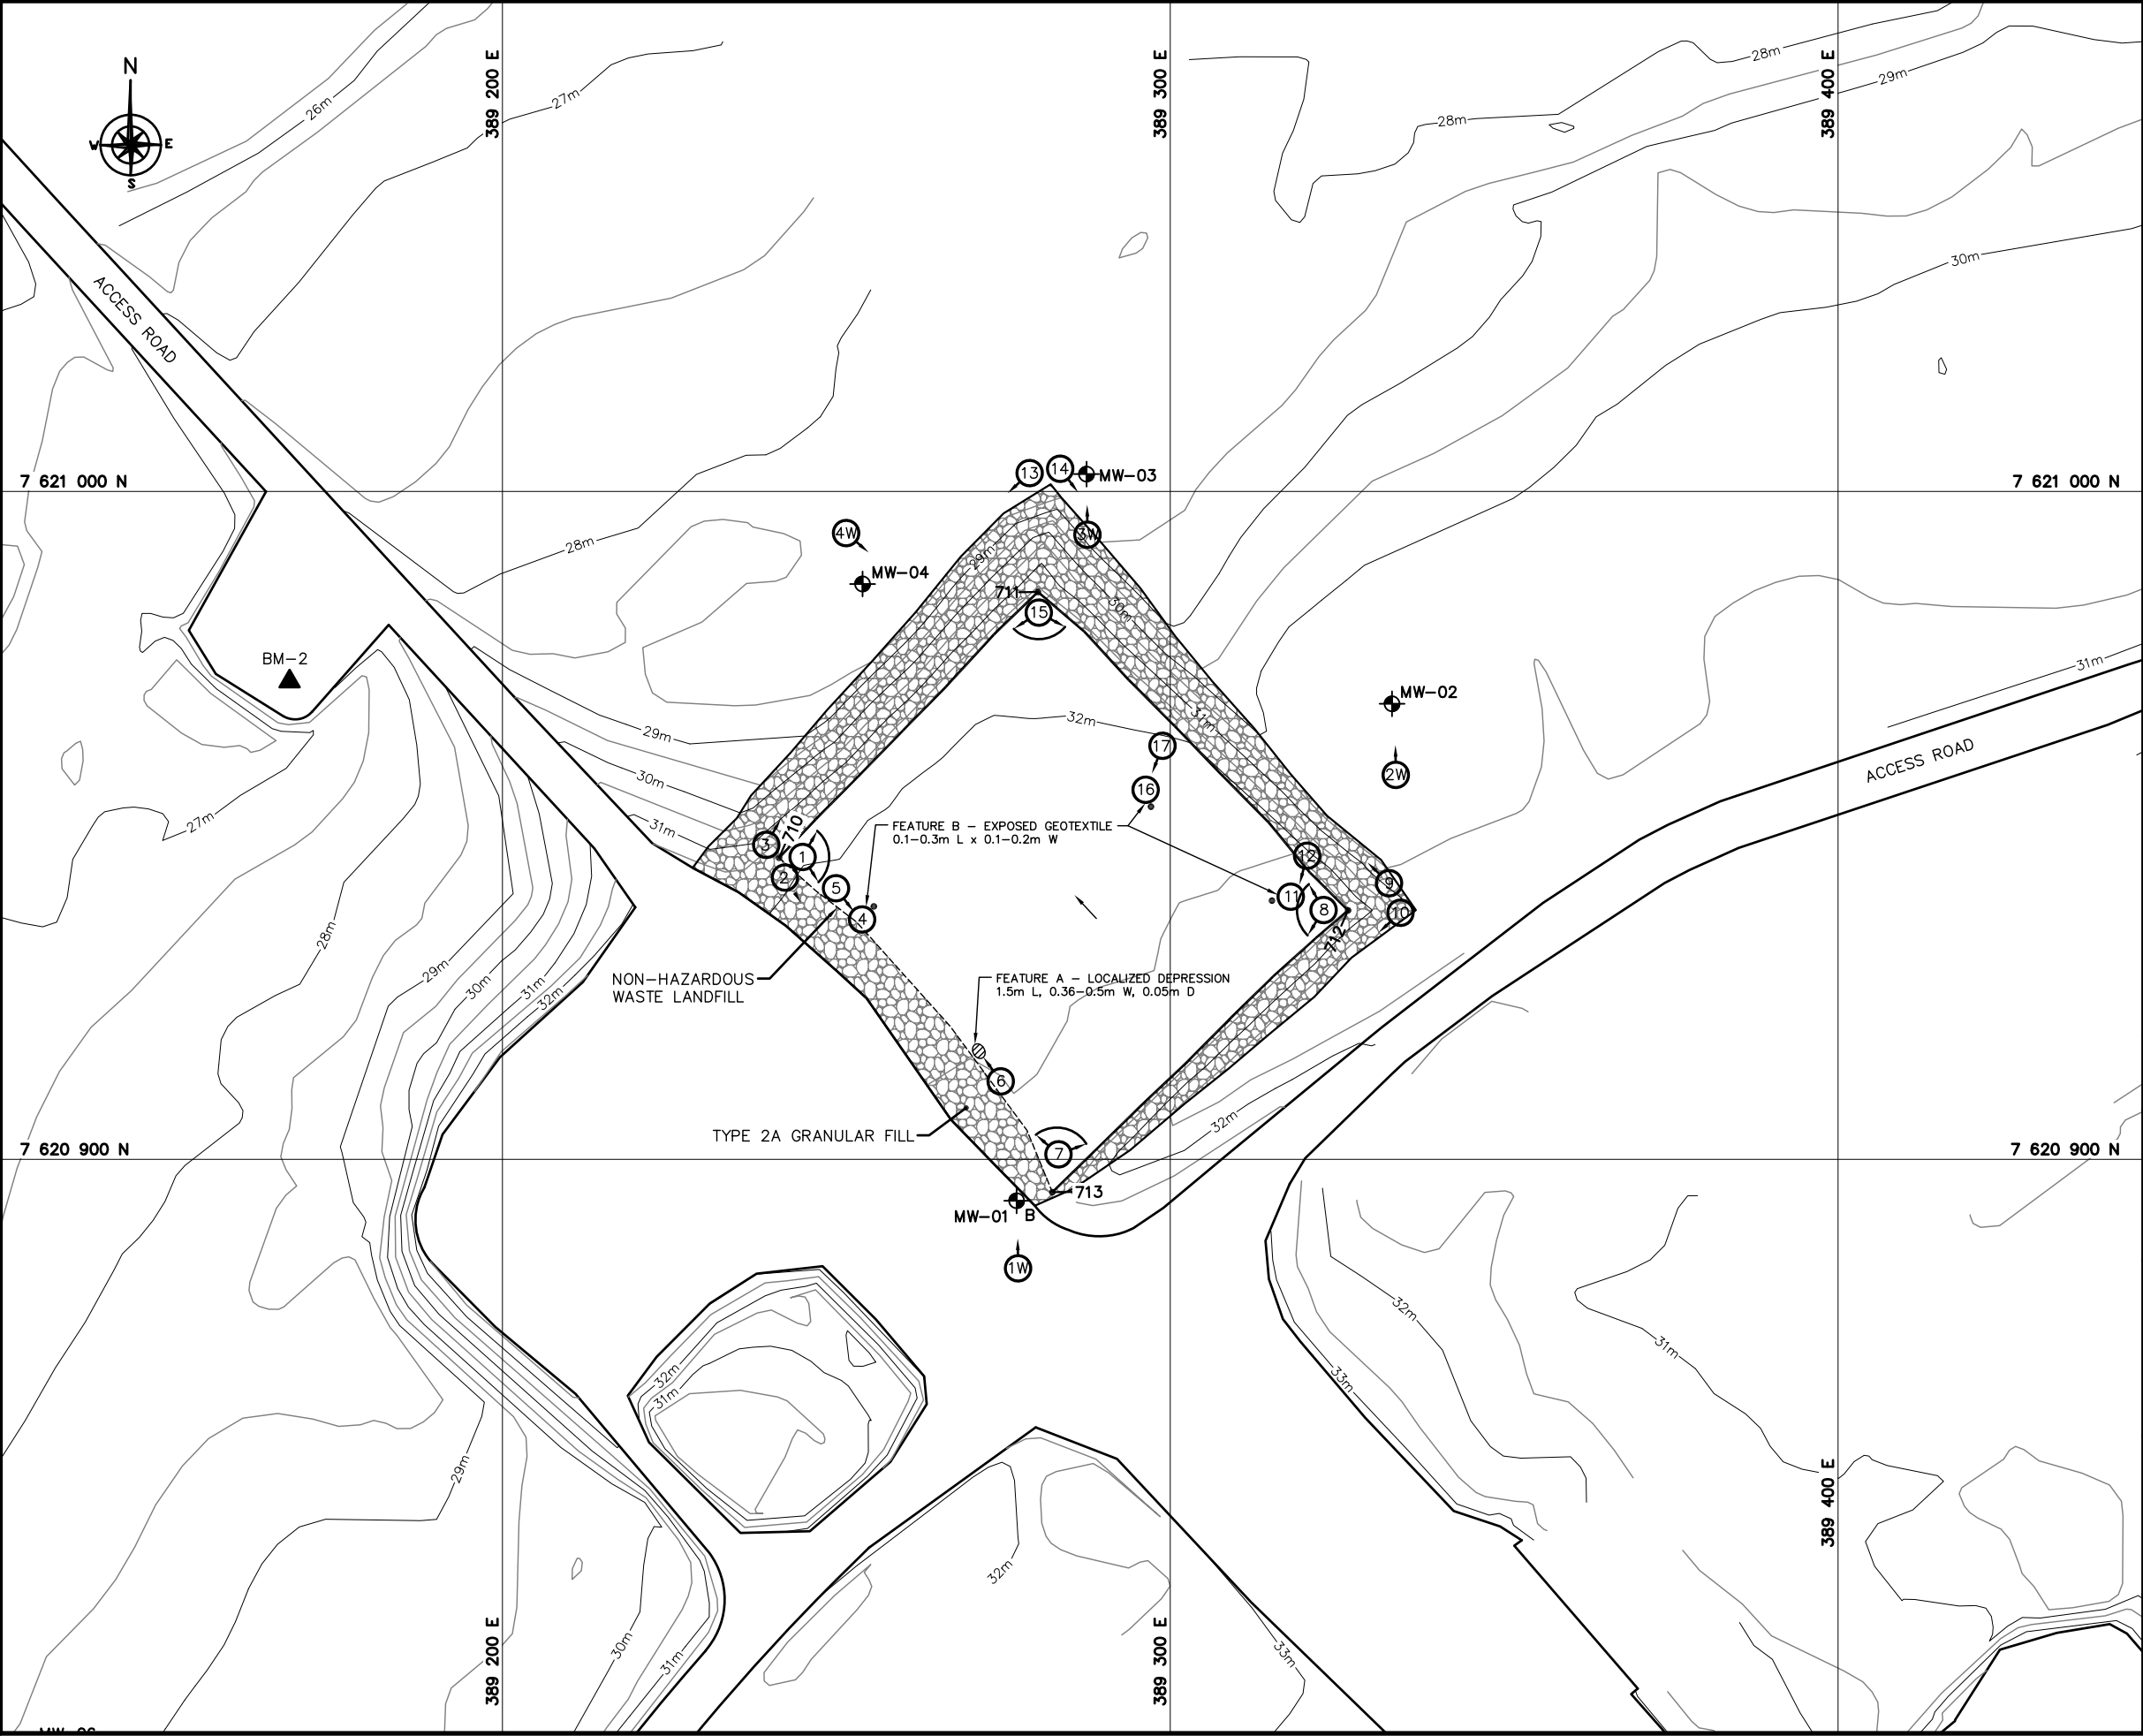

LEGEND

- ▲ BM-2 PERMANENT BENCHMARK LOCATION (1)
- 710 COORDINATE POINT
- ⊕ MONITORING WELL LOCATION (3)
- ⊕ B BACKGROUND MONITORING WELL LOCATION (1)
- 6 APPROX. PHOTOGRAPHIC VIEWPOINT
- BODY OF WATER
- ▨ MINOR SETTLEMENT (NTS)
- EXPOSED GEOTEXTILE (NTS)

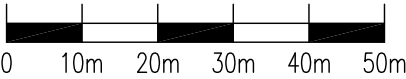

A	FINAL	13-04-02	LL	AP	AL
NO.	VERSION	DATE	PAR	VERIF.	APPR.



Construction de Défense Canada
Défence Construction Canada

COLLECTION OF
LANDFILL MONITORING DATA
CAM-1, JENNY LIND ISLAND, NUNAVUT

NON-HAZARDOUS WASTE LANDFILL

SITE REMEDIATION SOLUTIONS

Biogenie, a division of EnGlobe Corp.
4495 Wilfrid-Hamel blvd, Suite 200
Quebec, (Quebec) CANADA G1P 2J7
Phone: (418) 653-4422 Fax: (418) 653-3583



MEASUREMENT UNIT Metre	SCALE: 1 : 1,000	DATE (month-year): MARCH 2013
DRAWN BY: P. LÉGARÉ	VERIFIED BY: A. PASSALIS	APPROVED BY: A. LECLAIR P. ENG
PROJECT NO: CD9229_004_160	DRAWING NO: CD9229_004_160-CAM-1.5-PL	PAGE PL

FIGURE CAM-1.5