



G:\CD9229\2012\CAM-1\FINAL\CD9229_004_160-CAM-1.7-PL.dwg, PL, 2013-03-27 2:09:34 PM

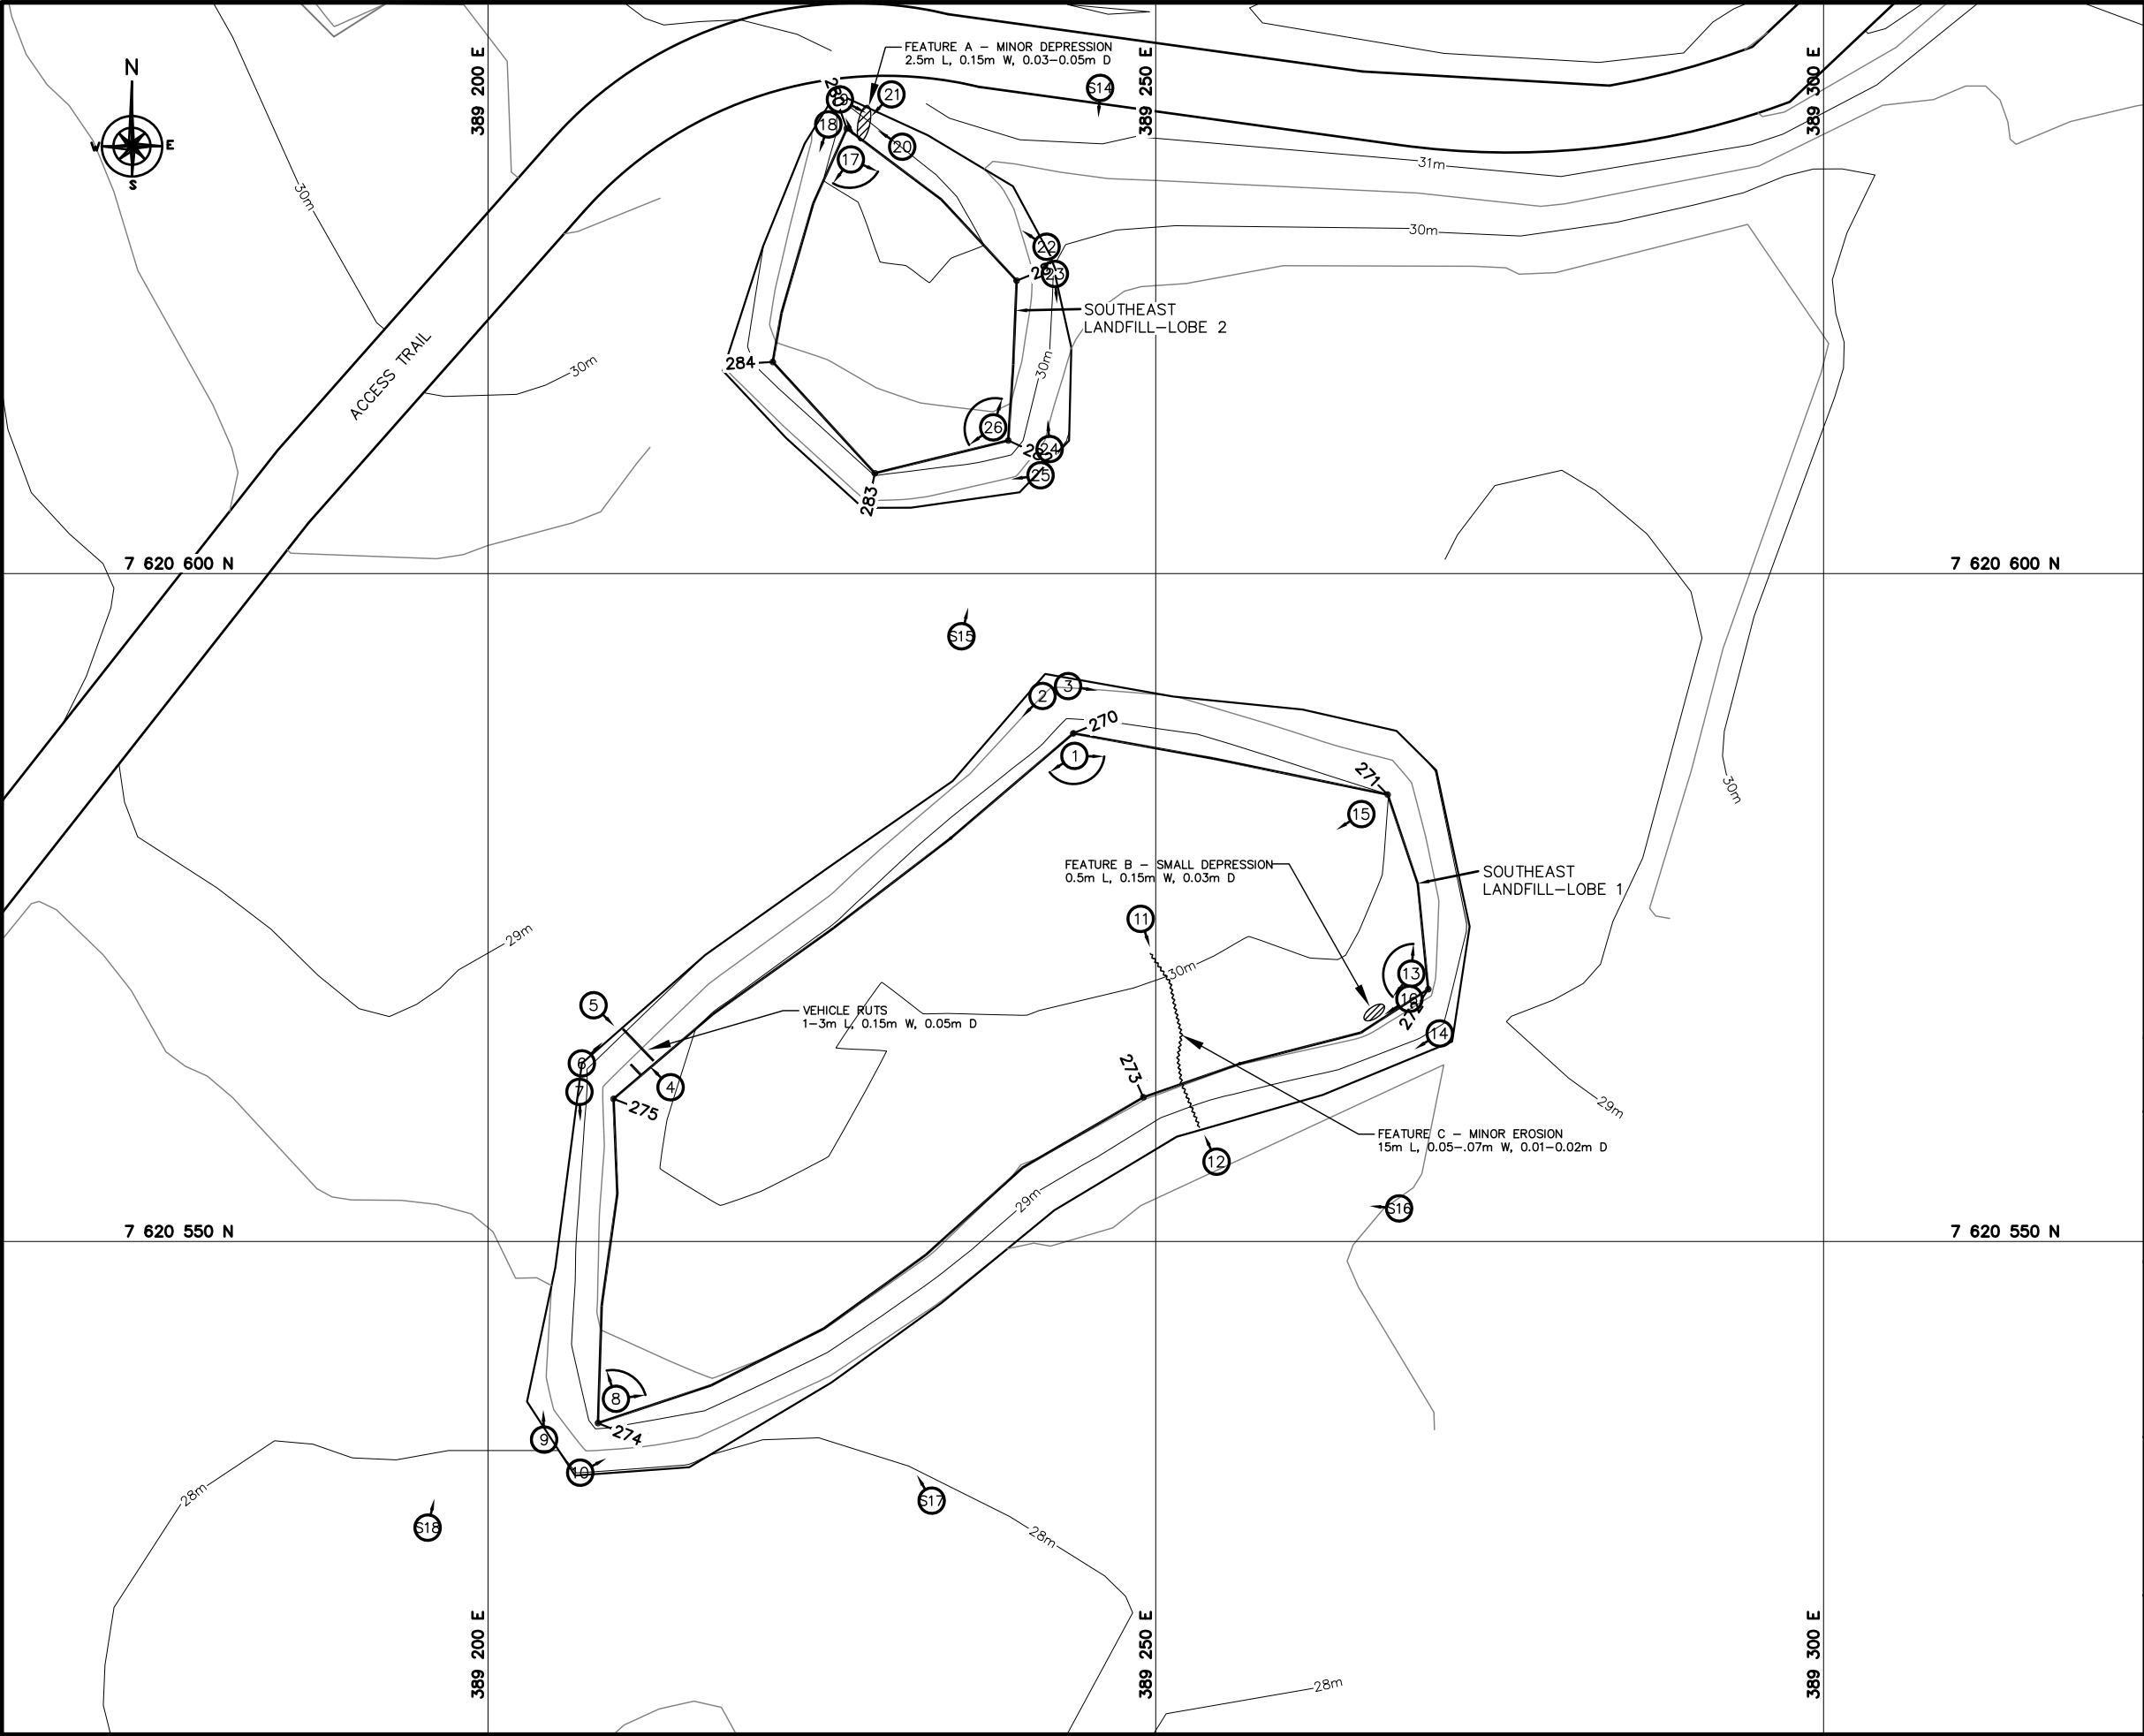

LEGEND

- 270 COORDINATE POINT
- 6 APPROX. PHOTOGRAPHIC VIEWPOINT
- MINOR SETTLEMENT (NTS)
- VEHICLE RUTS
- MINOR EROSION (NTS)

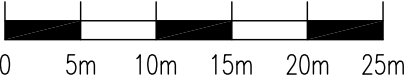

A	FINAL	13-03-08	P.L	A.P.	AL
NO.	VERSION	DATE	PAR	VERIF.	APPR.



COLLECTION OF
LANDFILL MONITORING DATA
CAM-1, JENNY LIND ISLAND, NUNAVUT
SOUTHEAST LANDFILL

SITE REMEDIATION SOLUTIONS
Biogenie, a division of EnGlobe Corp.
4495 Wilfrid-Hamel blvd, Suite 200
Quebec, (Quebec) CANADA G1P 2J7
Phone: (418) 653-4422 Fax: (418) 653-3583



MEASUREMENT UNIT Metre	SCALE: 1 : 500	DATE (month-year): MARCH 2013
DRAWN BY: P. LÉGARE	VERIFIED BY: A. PASSALIS	APPROVED BY: A. LECLAIR P. ENG
PROJECT NO: CD9229_004_160	DRAWING NO: CD9229_004_160-CAM-1.7-PL	PAGE PL

FIGURE CAM-1.7