



G:\CD2655\FINAL\FOX-2\2013\CD2655_310_313_101-FOX-2_B.dwg, PL 2014-01-27 12:41:05 PM

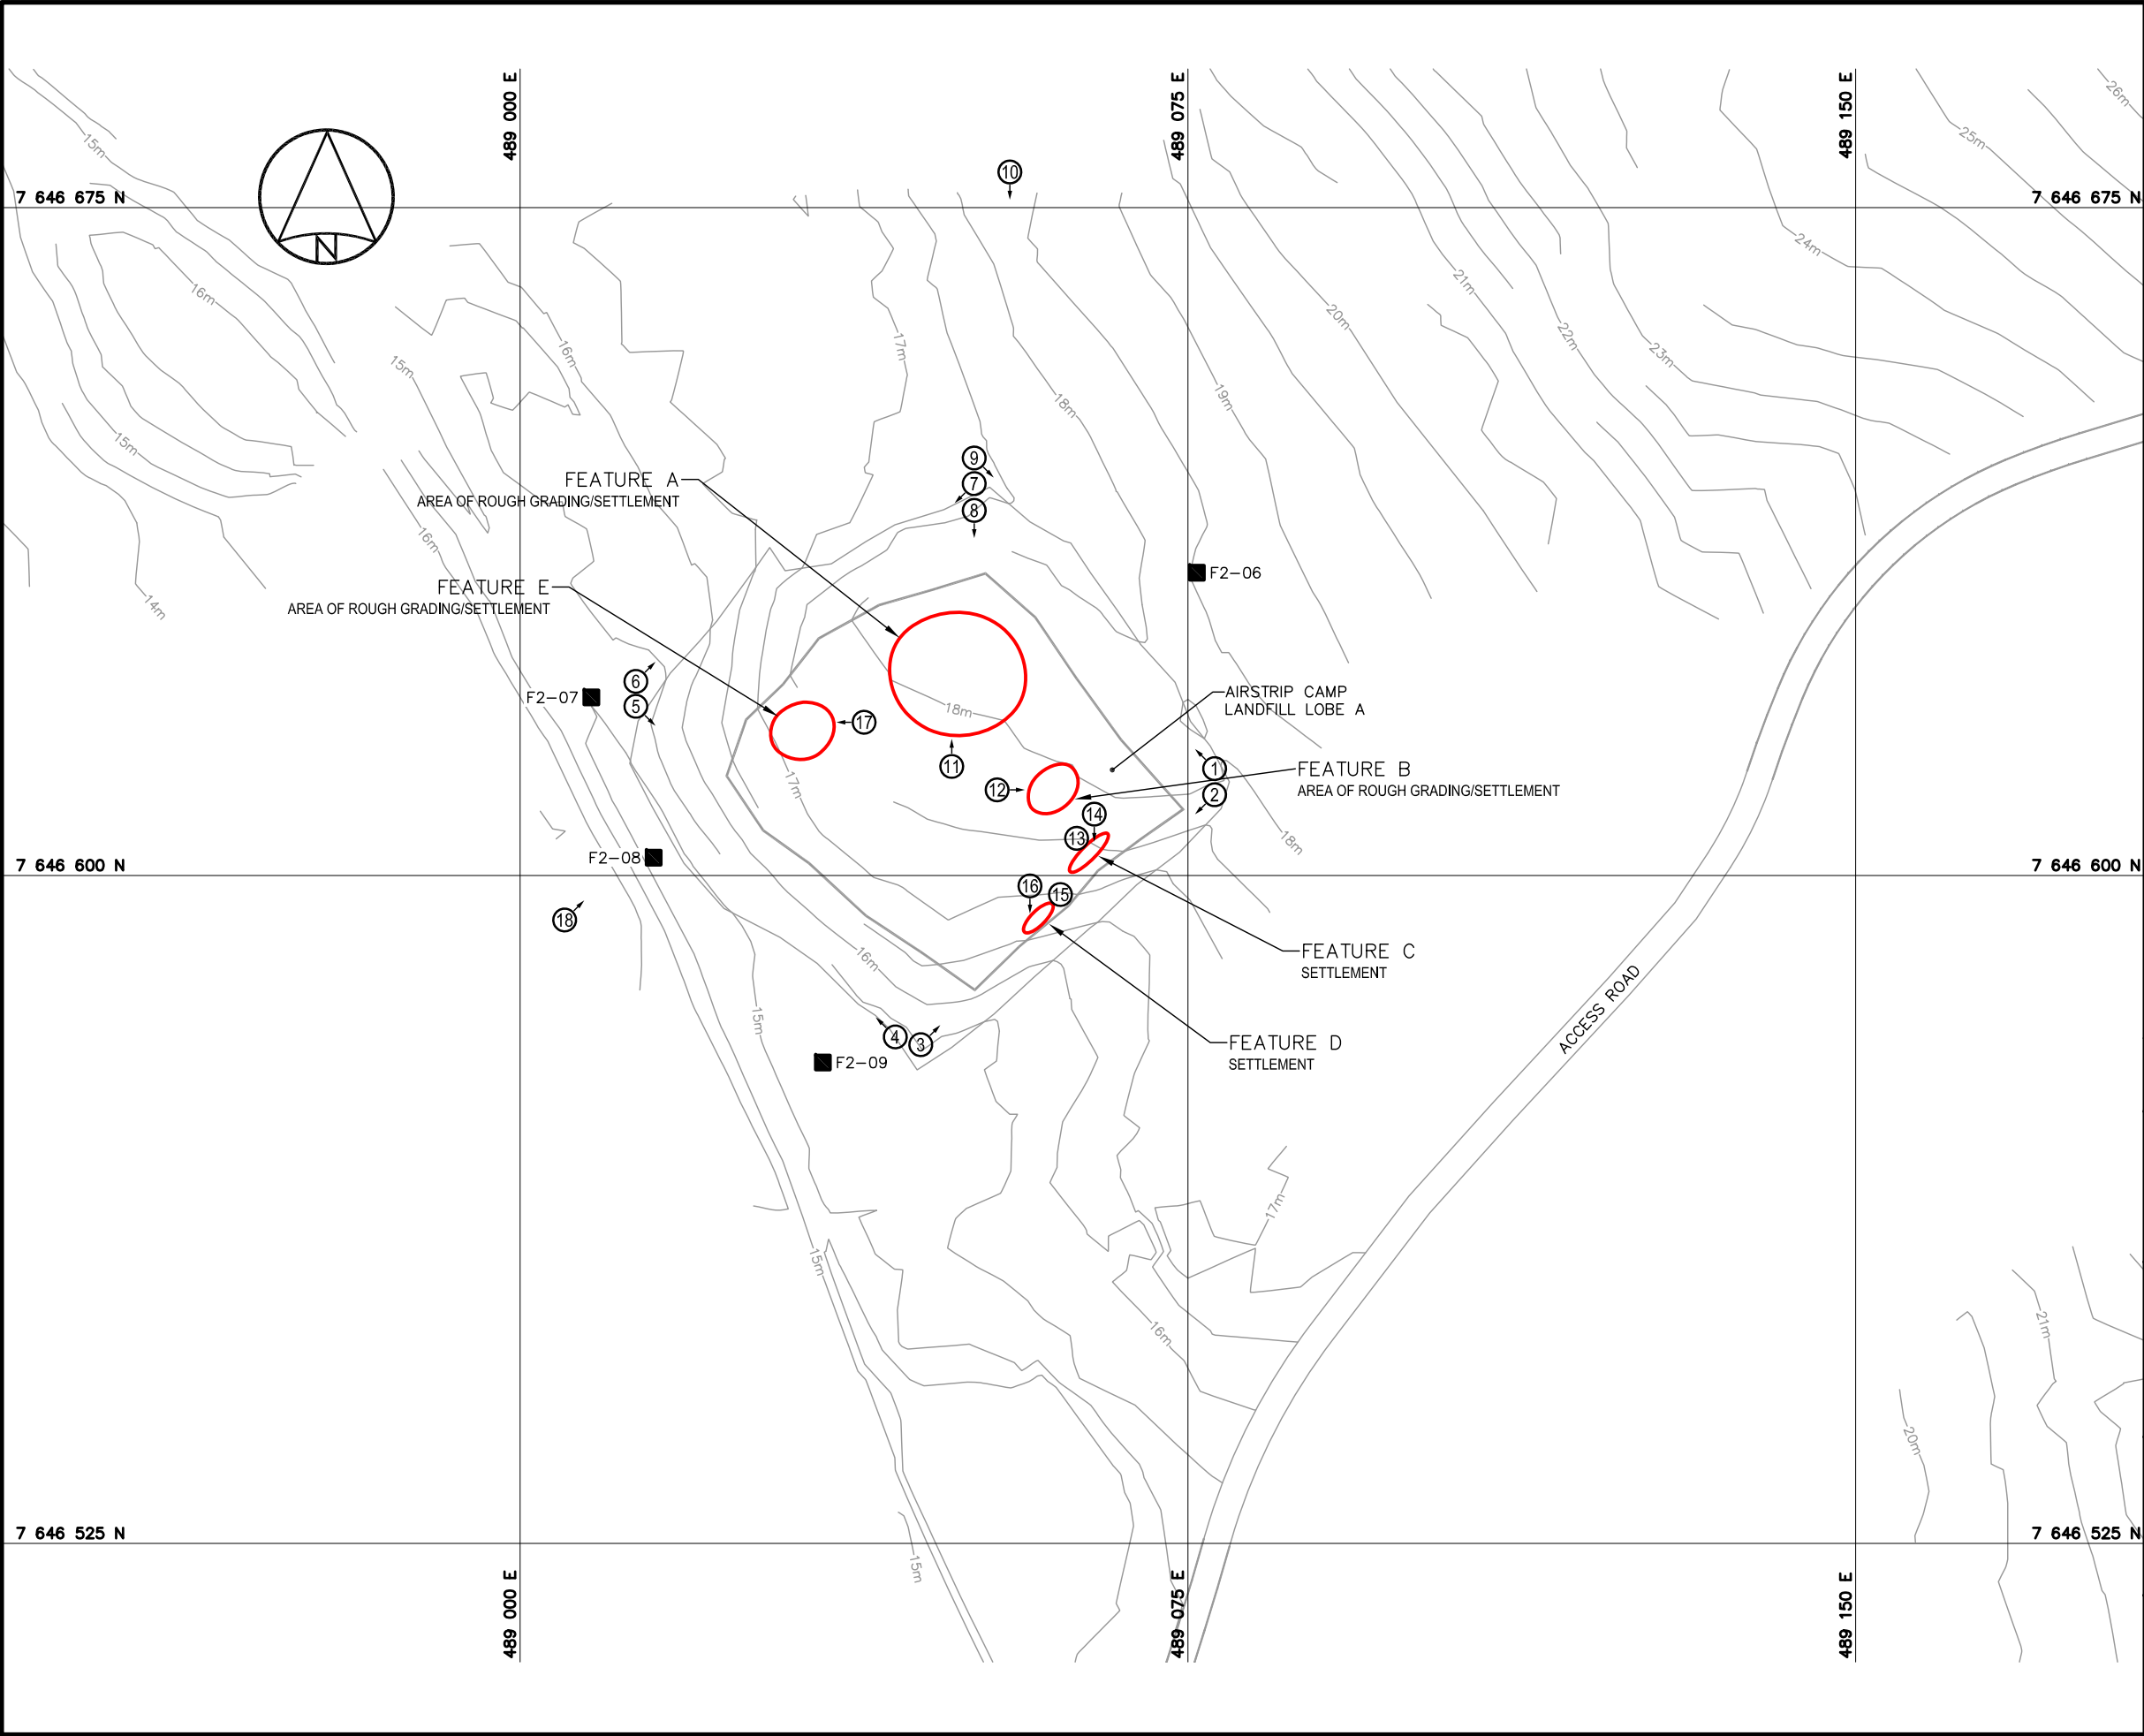

LEGEND

- SOIL SAMPLING LOCATION
- ① PHOTOGRAPH VIEWPOINT LOCATION
- SETTLEMENT (NTS)

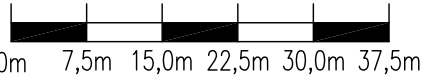

A	FINAL	14-01-27	P.L.	B.M.	AL
NO.	VERSION	DATE	BY	VERIF.	APPR.



Construction de Défense Canada
Défence Construction Canada

COLLECTION OF LANDFILL MONITORING DATA FOX-2, LONGSTAFF BLUFF, NUNAVUT AIRSTRIP CAMP LANDFILL LOBE A

SITE REMEDIATION SOLUTIONS

Biogenie, a division of EnGlobe Corp.
4495 Wilfrid-Hamel blvd, Suite 200
Quebec, (Quebec) CANADA G1P 2J7
Phone : 418-653-4422 www.biogenie-env.com



MEASUREMENT UNIT Meter	SCALE: 1 : 750	DATE (month-year): JANUARY 2014
DRAWN BY: P. LÉGARÉ	VERIFIED BY: B. MACKAY	APPROVED BY: A. LECLAIR P. Eng.
PROJECT NO: CD2655_310_313	DRAWING NO: CD2655_310_313_101-FOX-2_B	PAGE PL

FIGURE FOX-2.2