


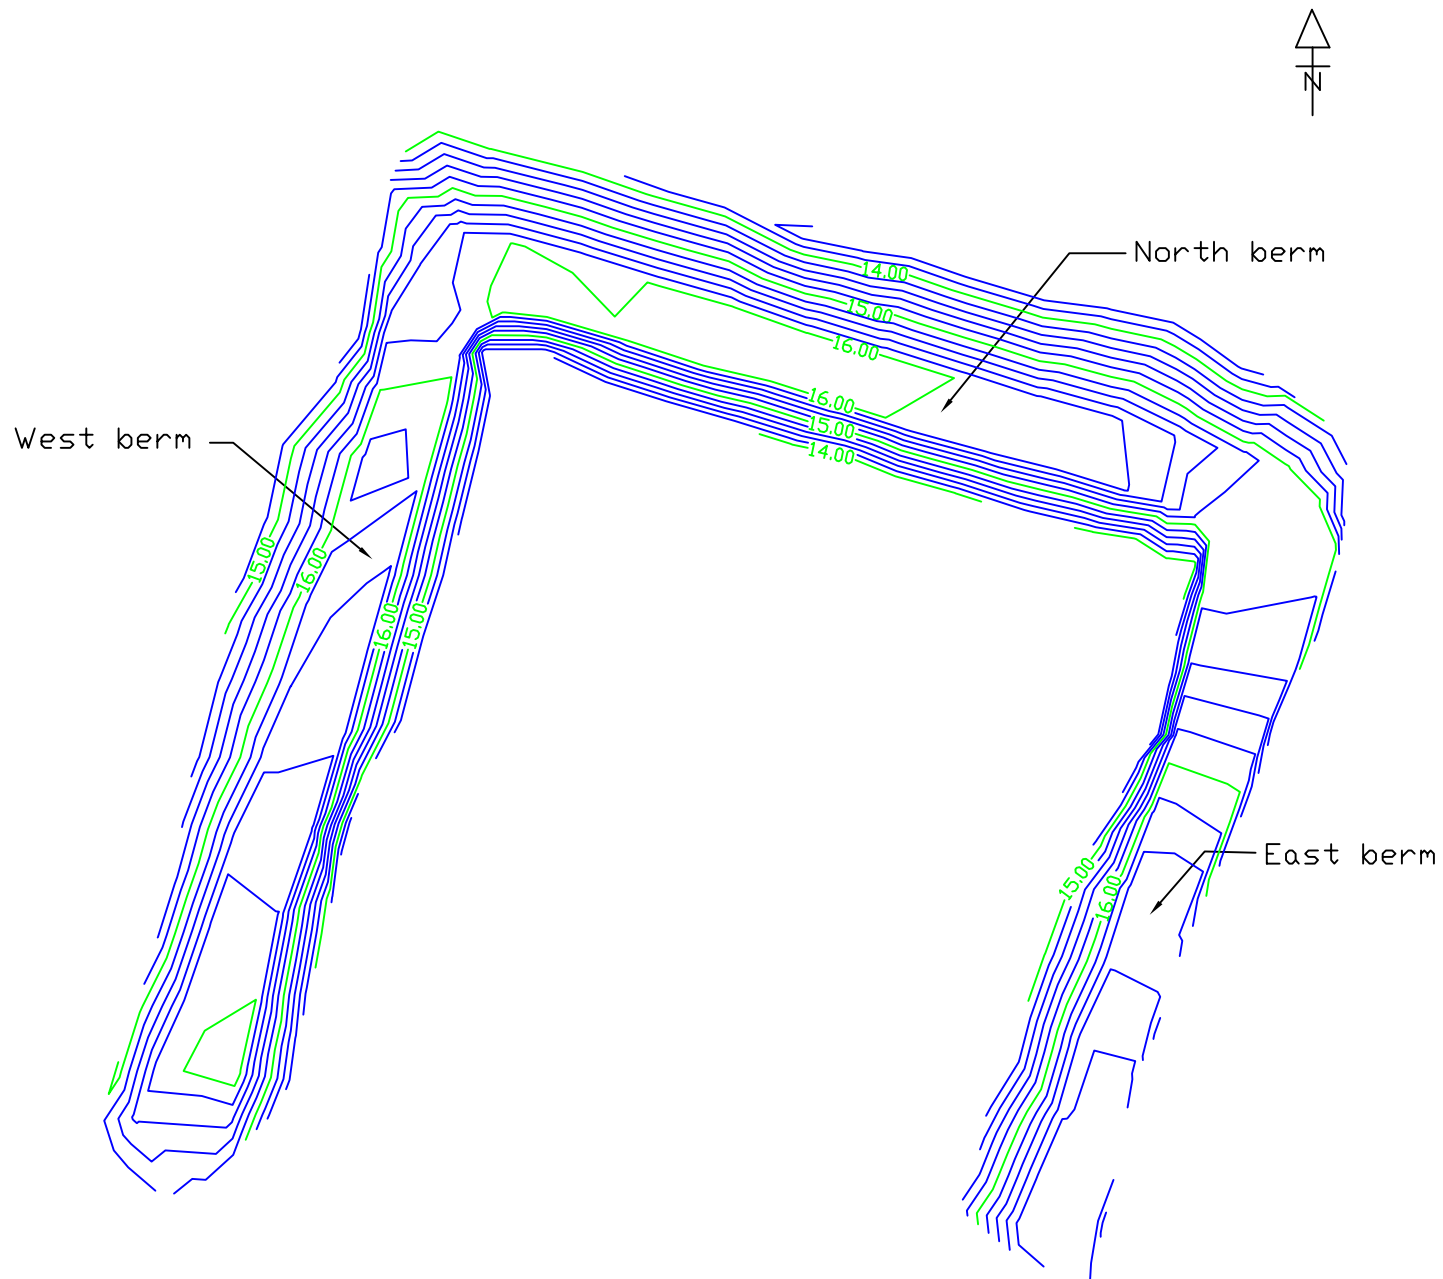

GENERAL NOTES :

- 1) Berm of the landfill for the august facturation
- 2) West berm Volume:
Cut: 9 cu.m. Fill: 1222 cu.m.
Net: 1179 cu.m. (FILL)
- 3) North berm Volume:
Cut: 0 cu.m. Fill: 1179 cu.m.
Net: 1179 cu.m. (FILL)
- 4) East berm Volume:
Cut: 27 cu.m. Fill: 460 cu.m.
Net: 434 cu.m. (FILL)
- 5) Total Landfill fill : 2836 cu.m.

-			
#	DESCRIPTION	BY	DATE
REVISIONS			
CAPE CHRISTIAN			
CLYDE RIVER			
LANDFILL			
	SCALE	DRAWER	DATE
	REF DWG	JPG	31/08/2009
	CHECK	DATE	
CONTRAT	DWG NUM		00