





POTENTIAL SOURCES FOR GRANULAR MATERIALS						
BORROW AREA	GRANULAR TYPE (SEE SECTION 02226 IN SPECIFICATION)					
	TYPE 1	TYPE 2	TYPE 3	TYPE 4	TYPE 5	TYPE 6
1		✓	✓			✓
2				✓*		
3	✓	✓	✓		✓	✓
4		✓				
5		✓				
6		✓				
7		✓				
8				**		
9				✓*		
10		✓		**		

\* MATERIAL IS WET AND SOFT AND REQUIRES BLENDING WITH SAND AND GRAVEL TO PRODUCE TYPE 4 GRANULAR FILL.

\*\* REQUIRES FURTHER INVESTIGATION TO VERIFY THIS POSSIBLE SOURCE.

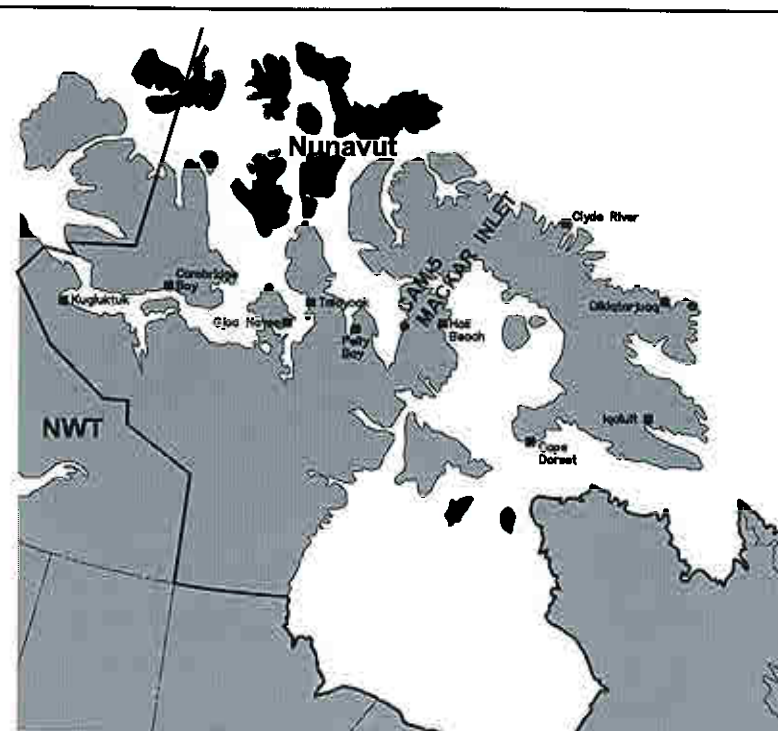

LOCATION OF MACKAR INLET WITHIN NUNAVUT TERRITORY  
N.T.S.

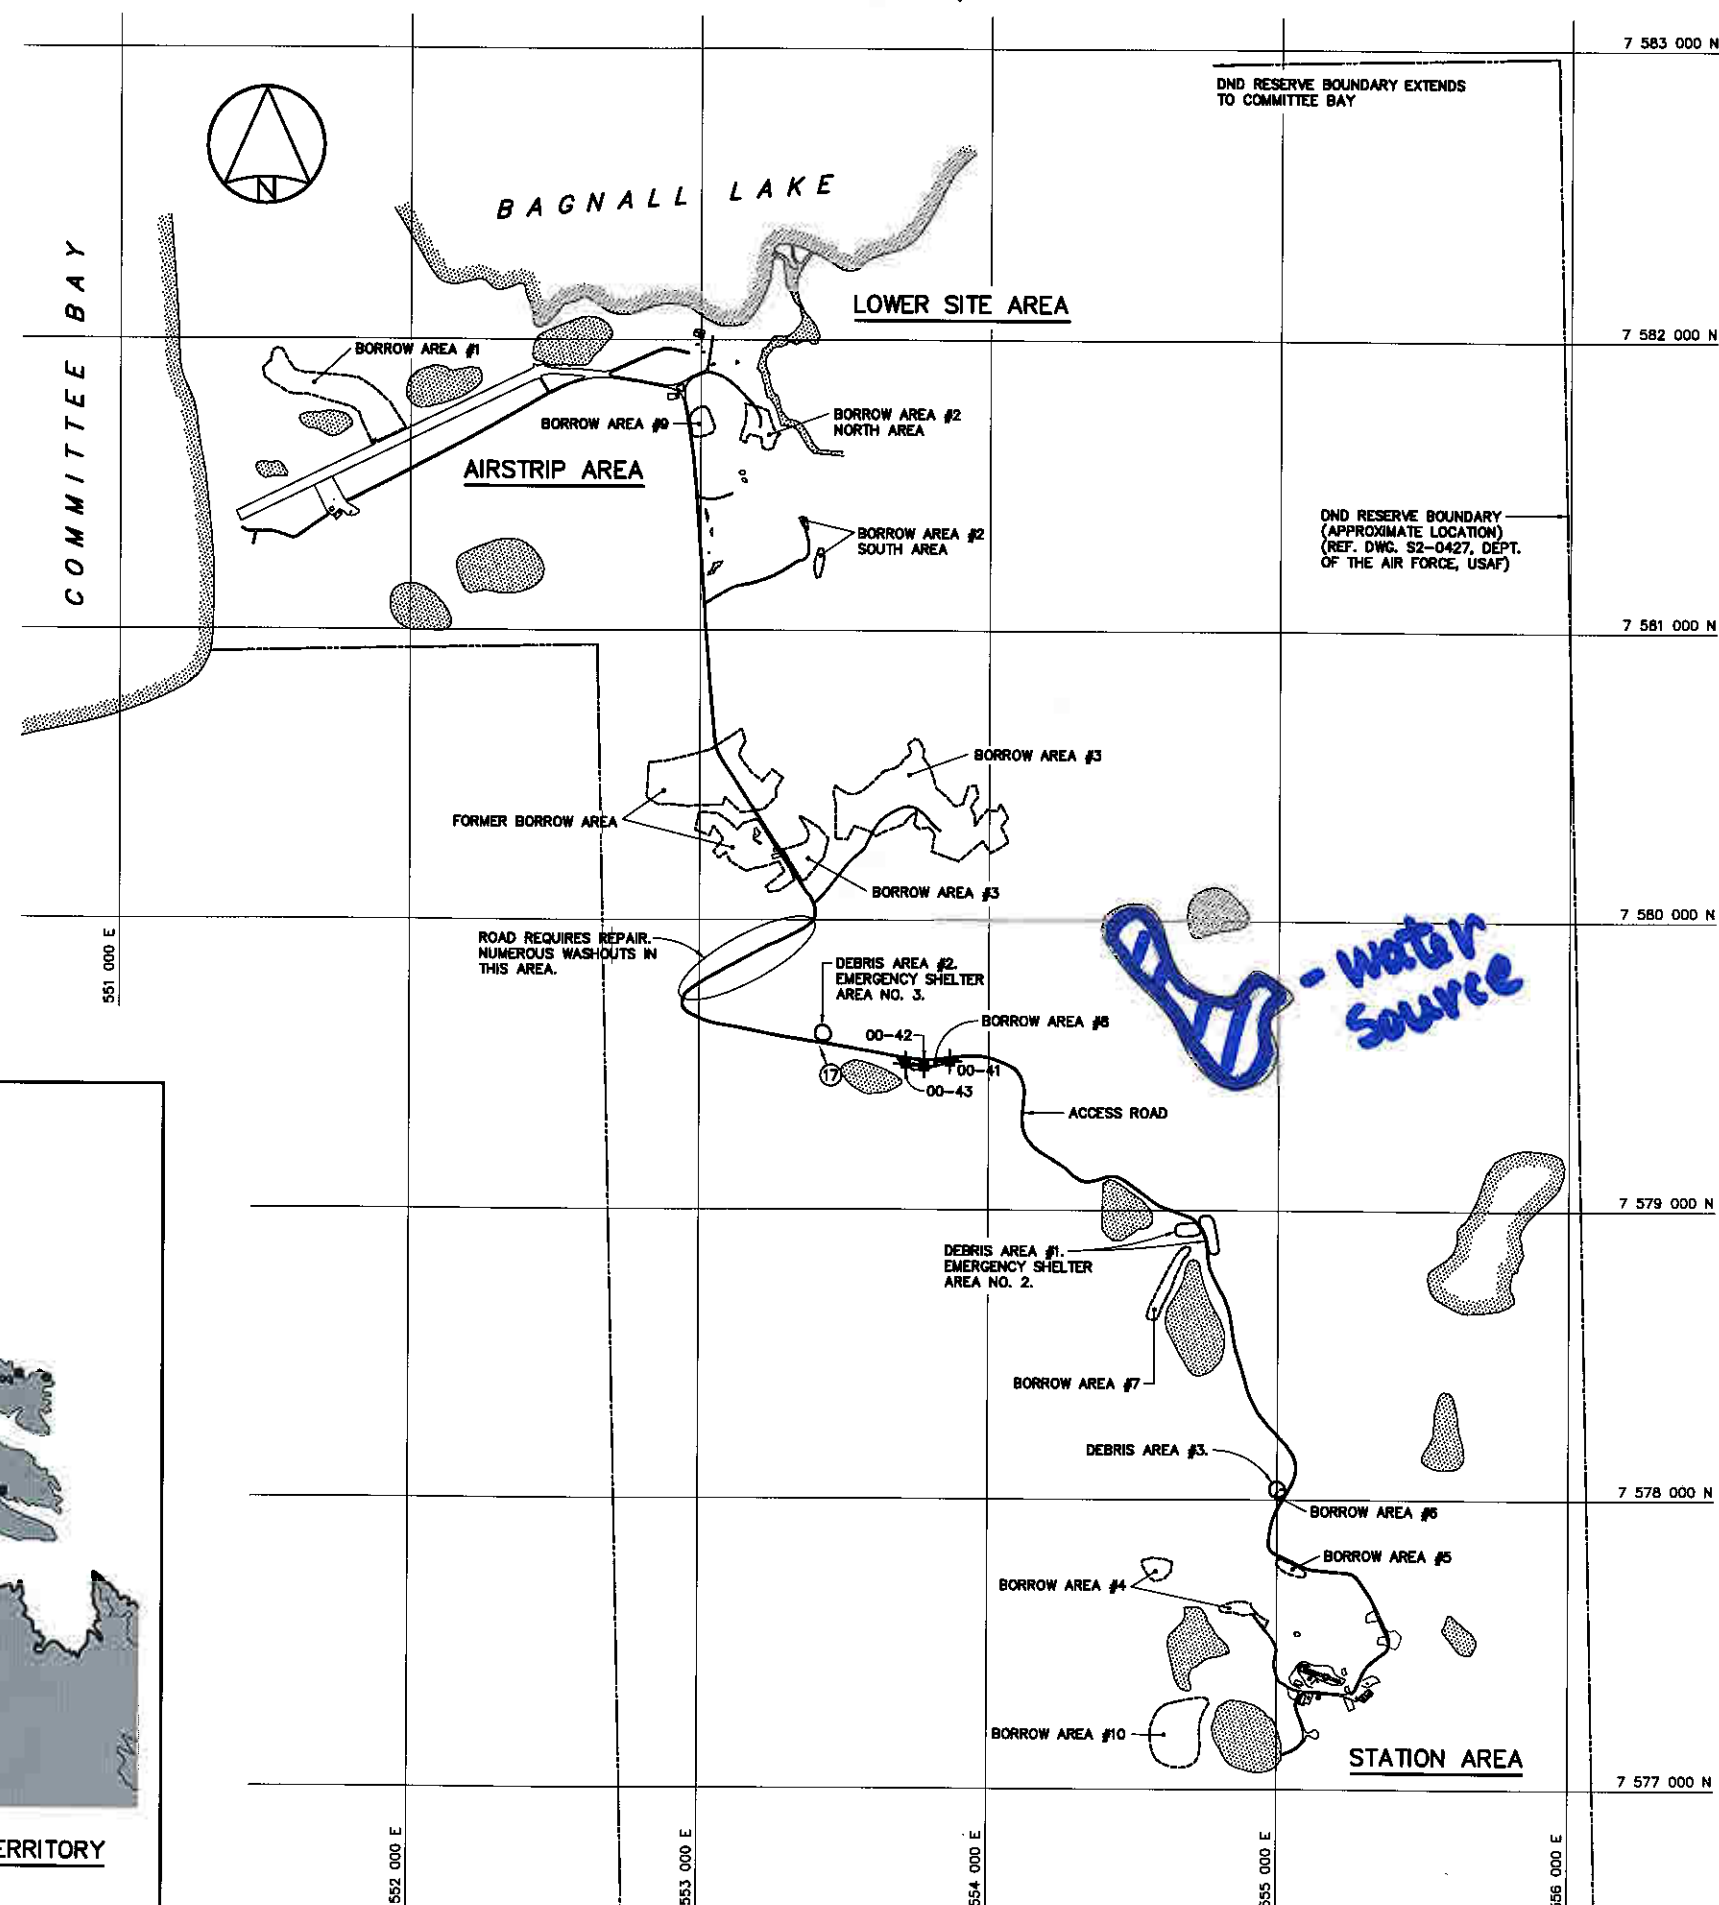

<b>National Defence</b> <b>Défense nationale</b>	
<b>Headquarters</b> <b>Quartier général</b>	
<b>General Notes:</b> <ol style="list-style-type: none"> <li>ALL COORDINATES ARE REFERENCED TO NAD83 (CSRS), UTM ZONE 18N. ELEVATIONS ARE REFERENCED TO MEAN SEA LEVEL, RELATIVE TO GEOID MODEL CANADIAN HT2.0.</li> <li>ALL NON-HAZARDOUS DEBRIS WITHIN PLAN AREA TO BE PLACED IN NON-HAZARDOUS WASTE LANDFILL.</li> <li>REFER TO TABLE 02219-1 IN SPECIFICATIONS FOR DESCRIPTION OF DEBRIS AREAS.</li> </ol>	
<b>Legend:</b> <ul style="list-style-type: none"> <li> PHOTOGRAPHIC VIEWPOINT</li> <li> TEST PIT LOCATION</li> <li> BODY OF WATER</li> <li> APPROXIMATE EXTENT OF DEBRIS AREAS</li> <li> APPROXIMATE EXTENT OF BORROW AREAS</li> <li> APPROXIMATE LOCATION OF PROPERTY BOUNDARIES</li> </ul>	
<b>8 05-06-24</b> No. DATE	ISSUED FOR R.F.A.P. REVISION REVISION APPR.
SCALE - ÉCHELLE 200 100 0 200 400 600m	
PROJECT - PROJET <b>CAM-5 MACKAR INLET</b>	
<b>DEW LINE CLEAN UP</b>	
© COPYRIGHT HER MAJESTY THE QUEEN IN RIGHT OF CANADA 2005, AS REPRESENTED BY THE MINISTER OF NATIONAL DEFENCE.	
TRADE - MÉTIER SITING	DATE 2005-06-24
SUBJECT - SUJET	
<b>OVERALL SITE PLAN</b>	
PRODUCTION DESIGNED ETUDIE DRAWN DESSINE CHECKED VÉRIFIÉ COORDINATION	CONCURRENCE - ASSISENMENT DES OFF. AGENT CONCEPT SECT HD CHIEF SECT DES MOR GEST CONCEPT REVIEWED - REVU
DWG. NO. - DESSIN NO. H-M27/1-9101-101	