





MONITORING SOIL SAMPLE LOCATION

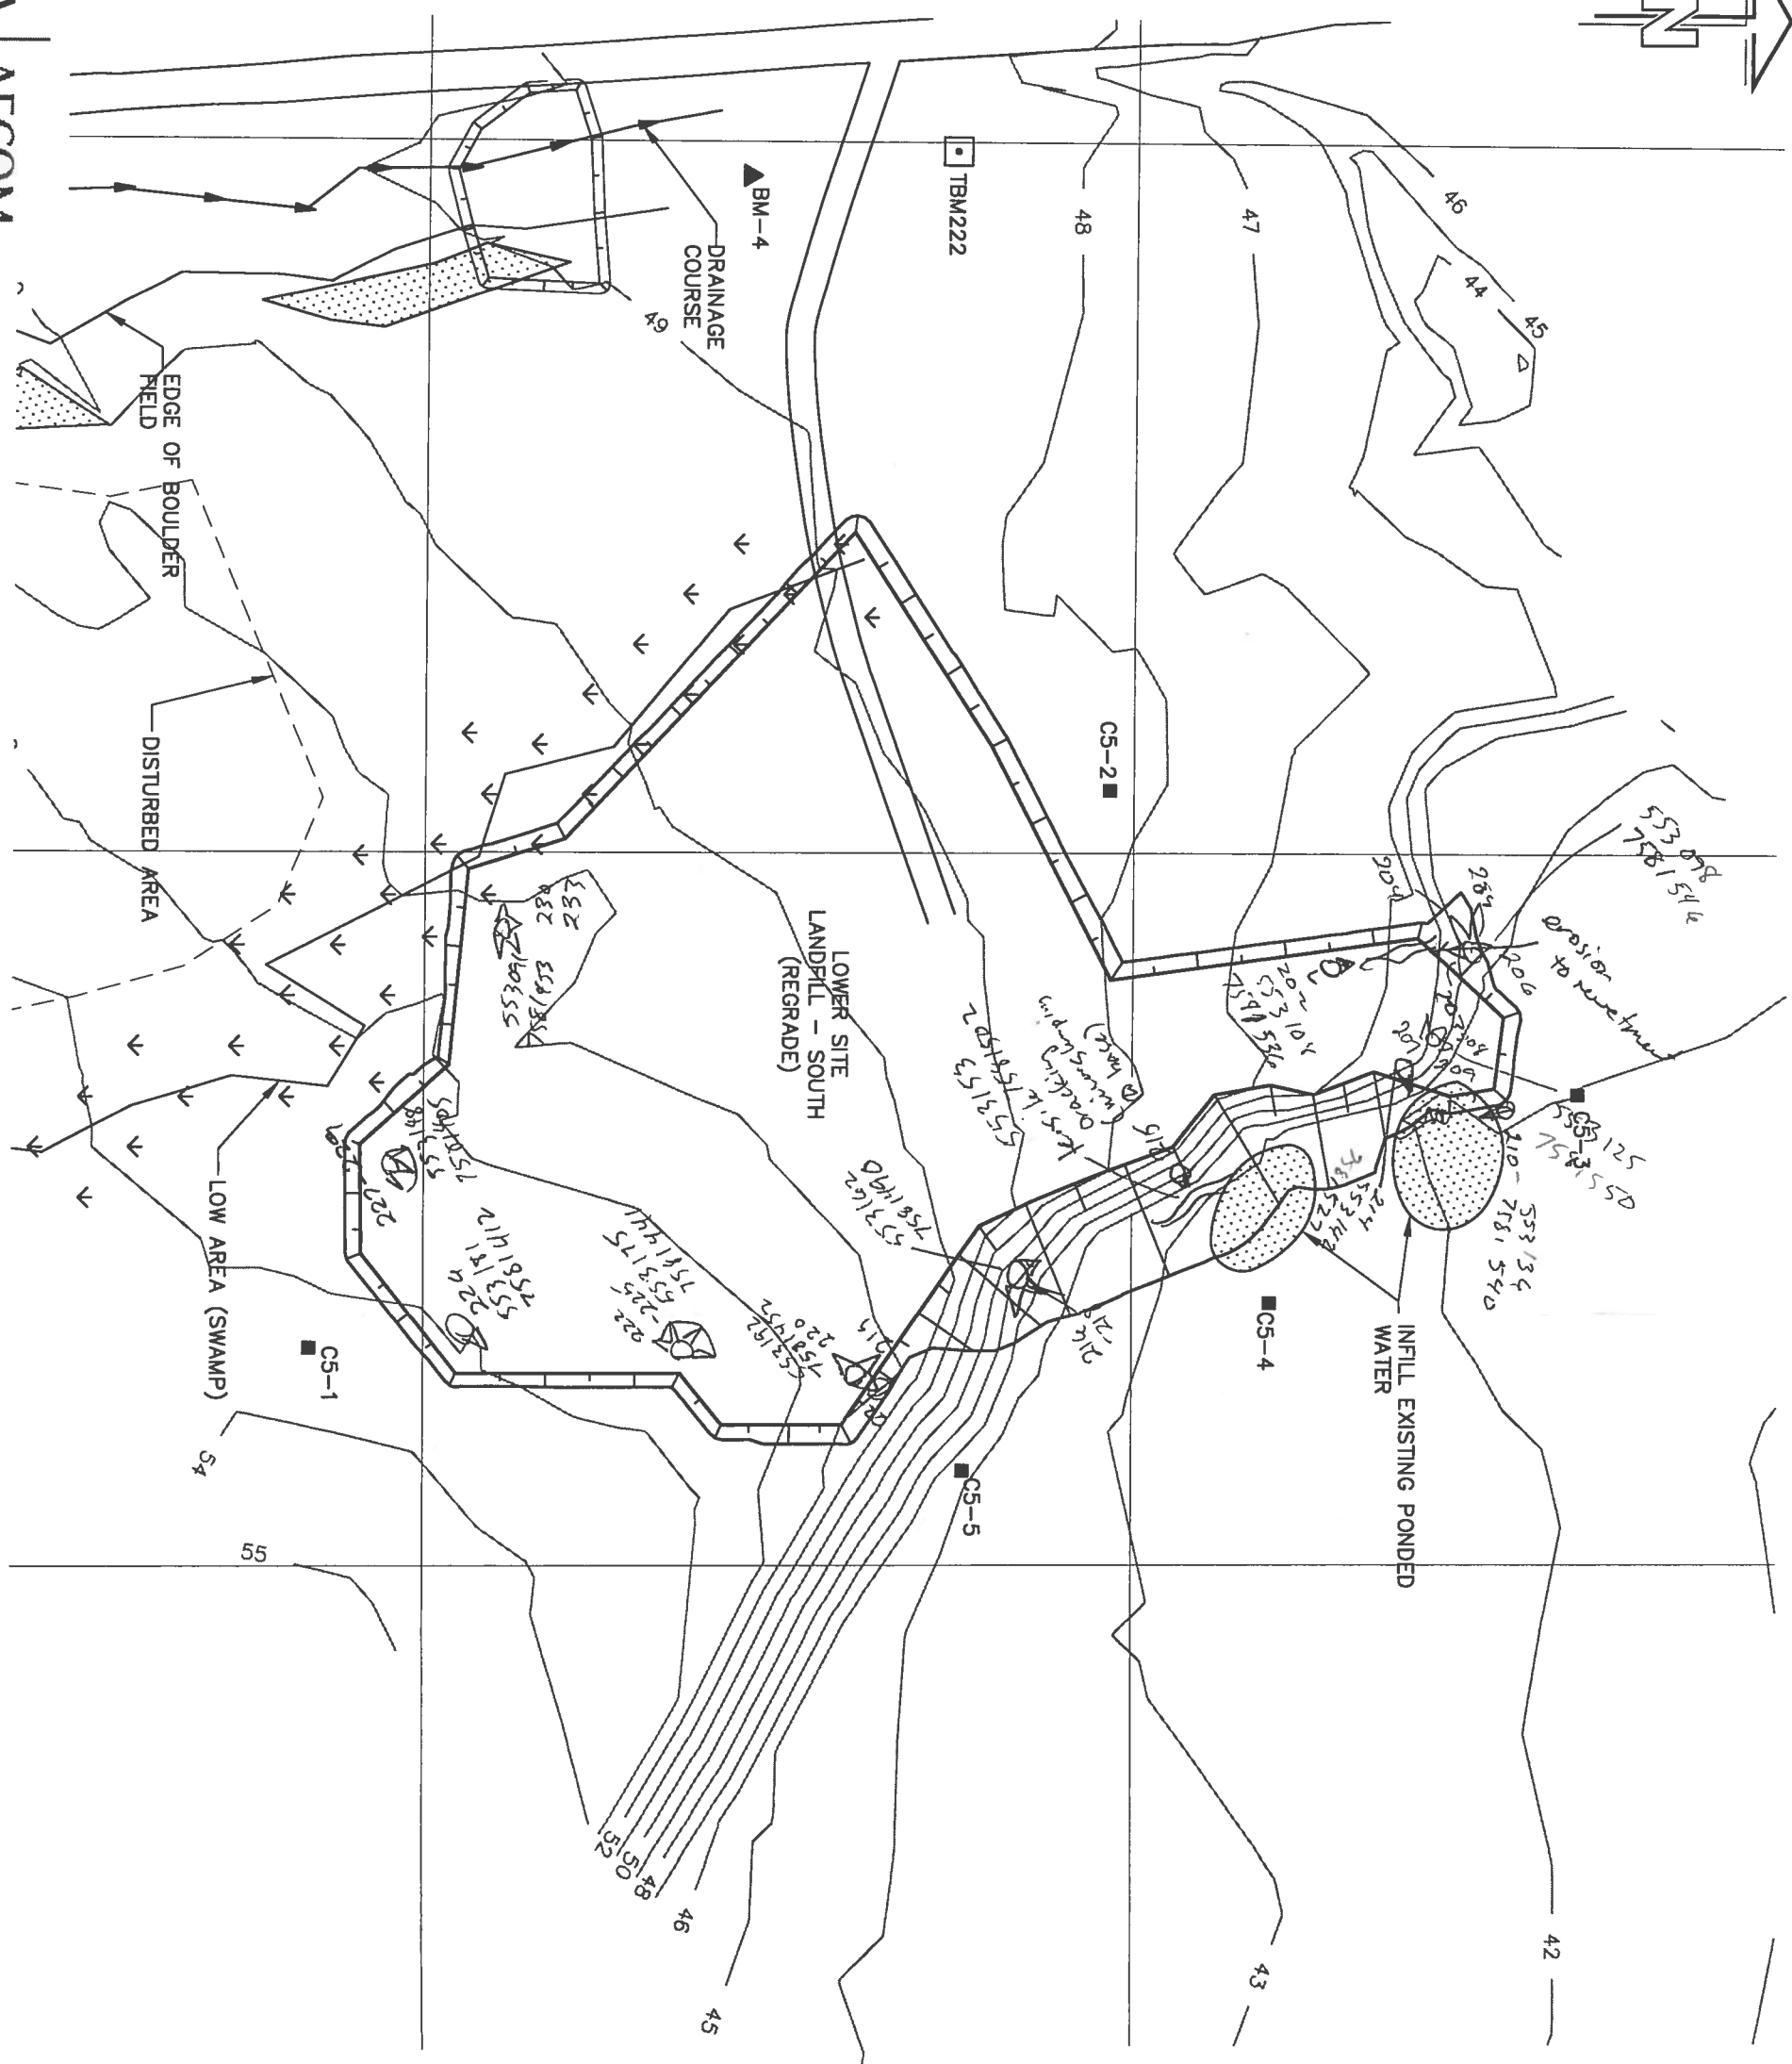

Defence Construction Canada
DEW Line
CAM-5 Macker Inlet


Lower Site Landfill - South
FIGURE CAM-5.2

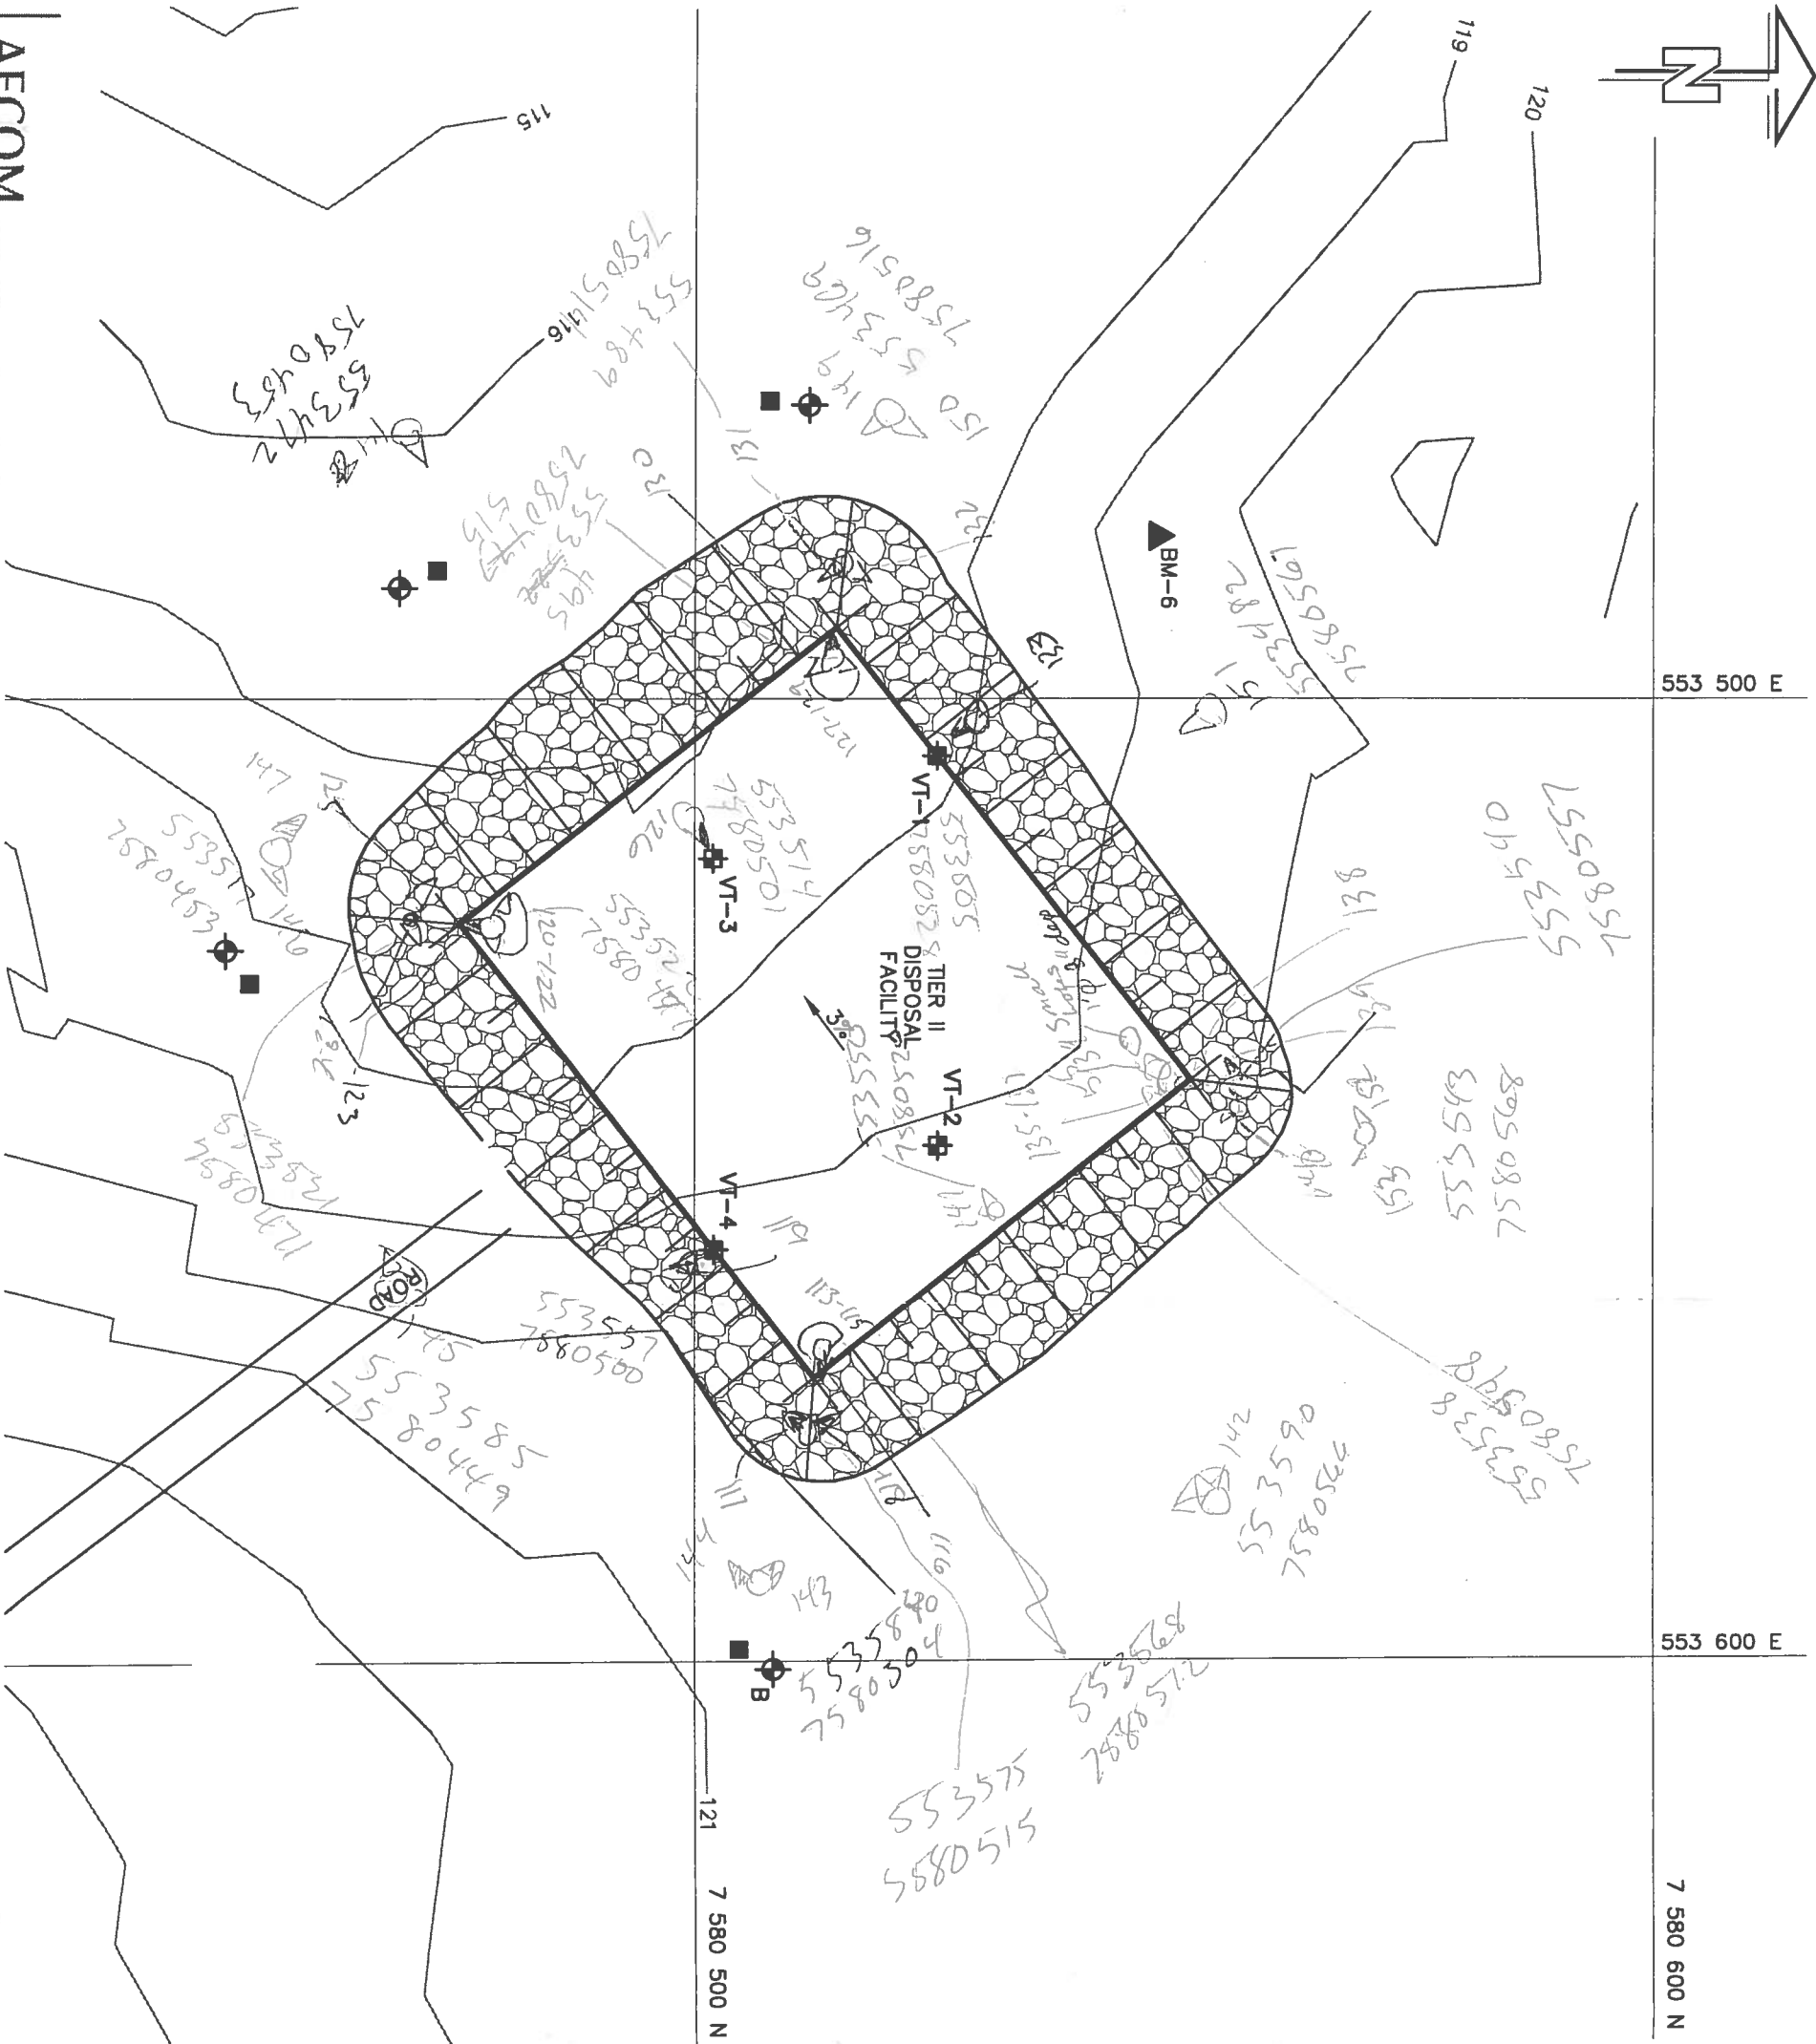

LEGEND:

- MONITORING WELL LOCATION
- THERMISTOR
- MONITORING SOIL SAMPLE LOCATION

Defence Construction Canada
DEW Line
CAM-5 Mackay Inlet
Tier II Disposal Facility
FIGURE CAM-5.3

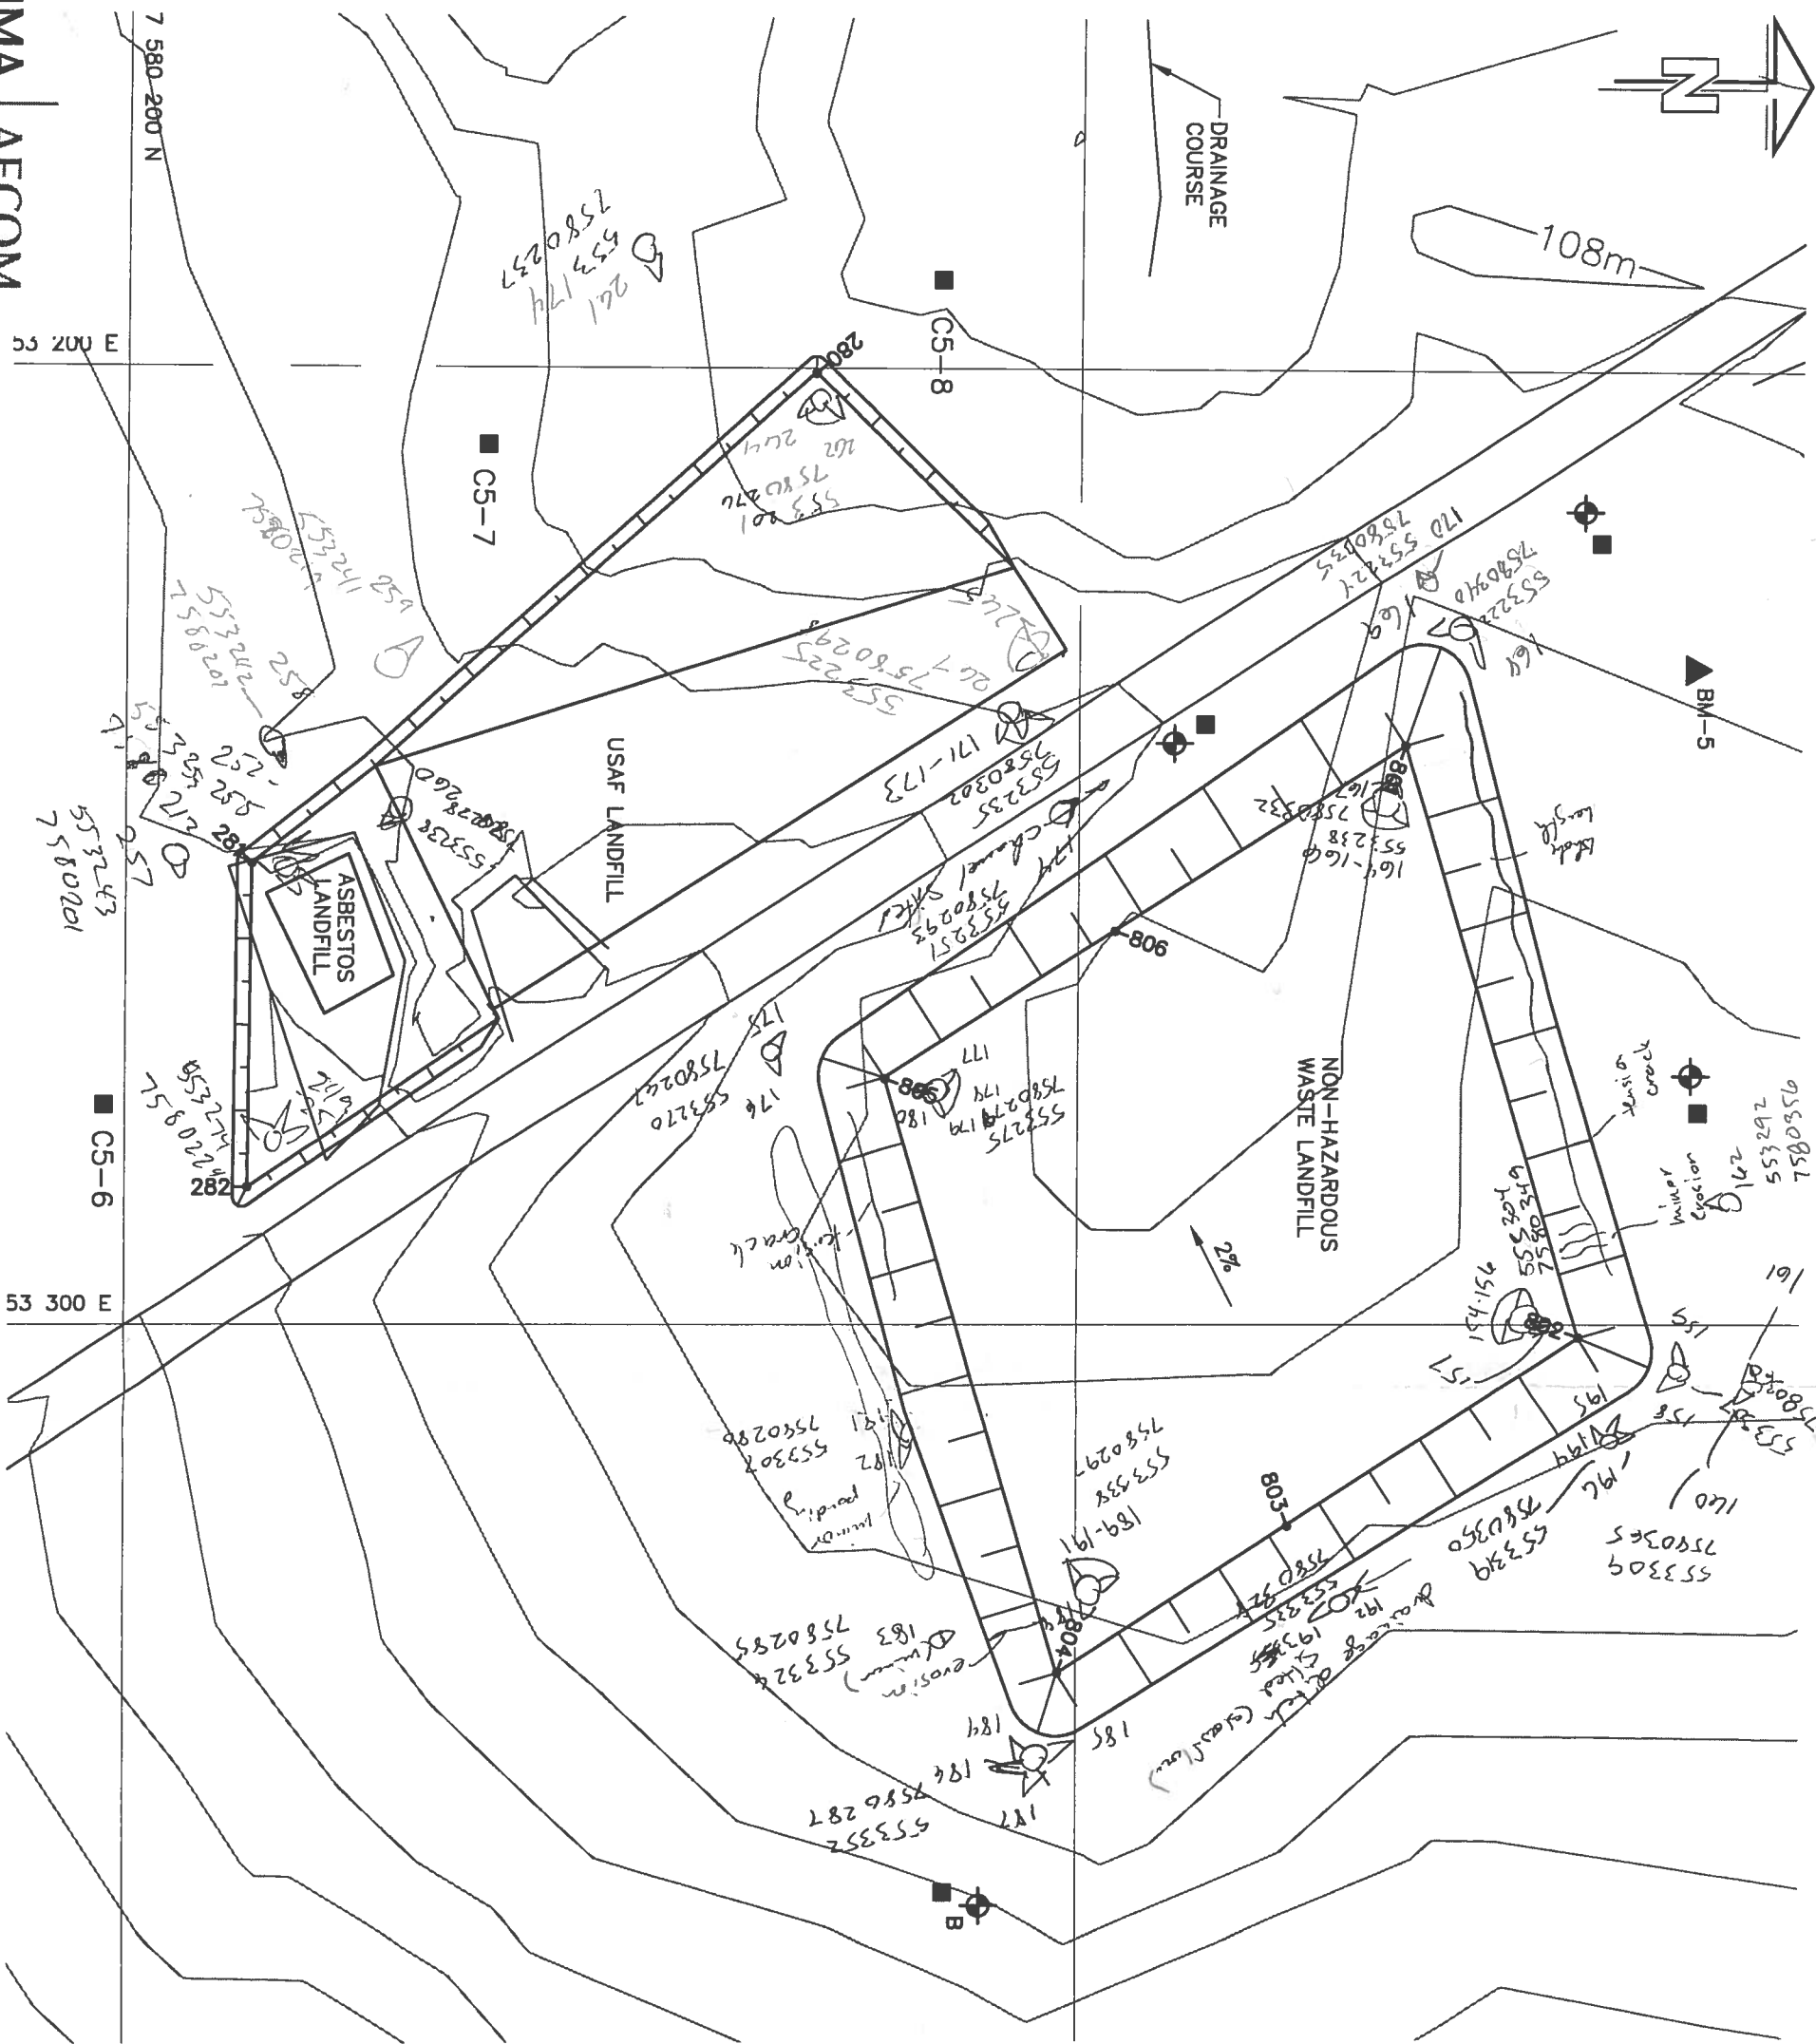

LEGEND:

- 101- COORDINATE POINT
- MONITORING WELL LOCATION
- MONITORING SOIL SAMPLE LOCATION

NO.	COORDINATES		ELEV.
	NORTHING	EASTING	
801	7 580 334.3	553 239.2	112.2
802	7 580 352.6	553 301.4	113.5
803	7 580 322.1	553 321.0	113.5
804	7 580 298.0	553 336.5	113.5
805	7 580 279.7	553 274.3	112.2
806	7 580 303.8	553 258.8	112.2



SCALE 1:750

Defence Construction Canada

DEW Line

CAM-5 Macker Inlet

Non-Hazardous Waste,

USAF & Asbestos Landfill

FIGURE CAM-5.4