



G:\CD2655\FINAL\CAM-5\CD2655_200_203-CAM-5.2.dwg, CAM-5.2, 2013-02-12 3:34:36 PM

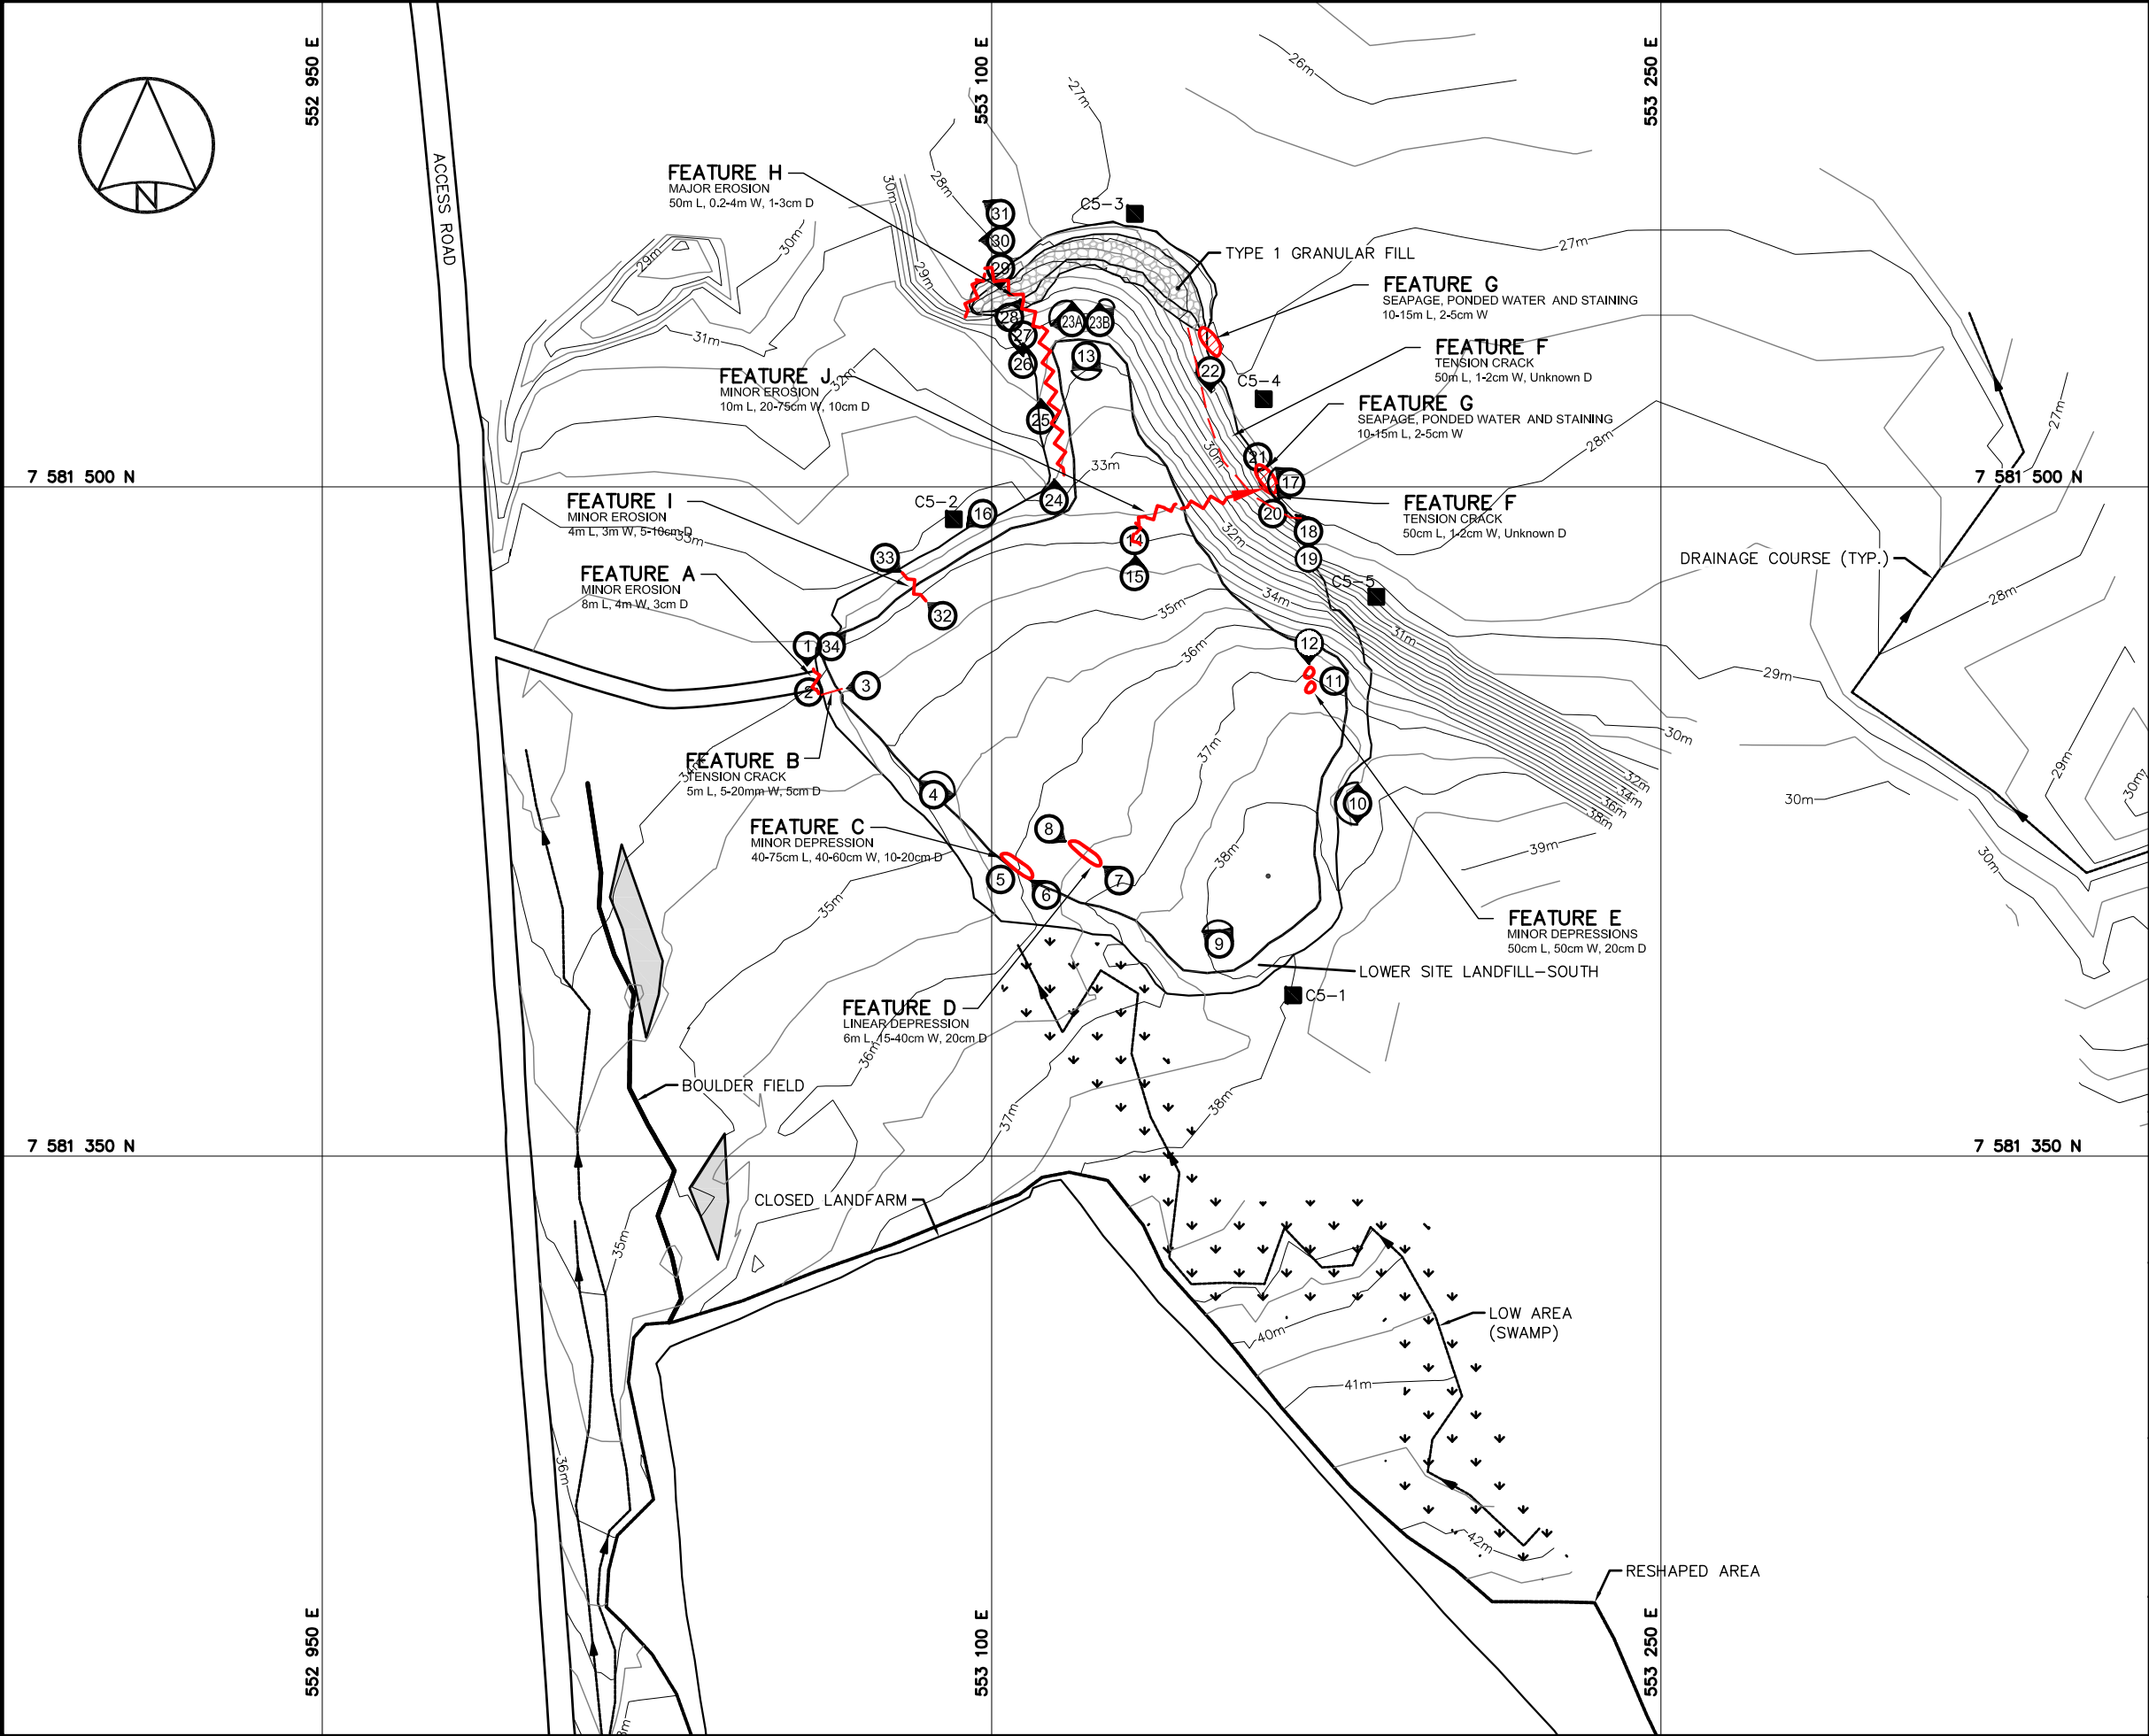

LEGEND

- BODY OF WATER
- SOIL SAMPLE LOCATION
- PHOTOGRAPH LOCATION
- SETTLEMENT (NTS)
- EROSION (NTS)
- CRACK (NTS)
- PONDING
- SEEPAGE (NTS)

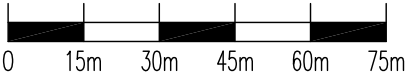

A	FINAL	13-02-12	P.L.	B.M.	A.L.
NO.	VERSION	DATE	PAR	VERIF.	APPR.



Construction de Défense Canada
Défence Construction Canada

COLLECTION OF LANDFILL MONITORING DATA CAM-5, MACKAR INLET, NUNAVUT

LOWER SITE LANDFILL - SOUTH

SITE REMEDIATION SOLUTIONS

Biogenie, a division of EnGlobe Corp.
4495 Wilfrid-Hamel Blvd, Suite 200
Quebec, (Quebec) CANADA G1P 2J7
Phone: (418) 653-4422 Fax: (418) 653-3583



MEASUREMENT UNIT	SCALE:	DATE (month-year):
Meter	1 : 1,500	FEBRUARY 2013
DRAWN BY:	VERIFIED BY:	APPROVED BY:
P. LÉGARÉ	B. MACKAY	A. LECLAIR P. Eng
PROJECT NO:	DRAWING NO:	PAGE
CD2655_200_203	CD2655_200_203-CAM-5.2	CAM-5.2

FIGURE CAM-5.2