



G:\CD2655\FINAL\CAM-5\CD2655_200_203-CAM-5.5.dwg, CAM-5.5, 2013-02-12 3:39:02 PM

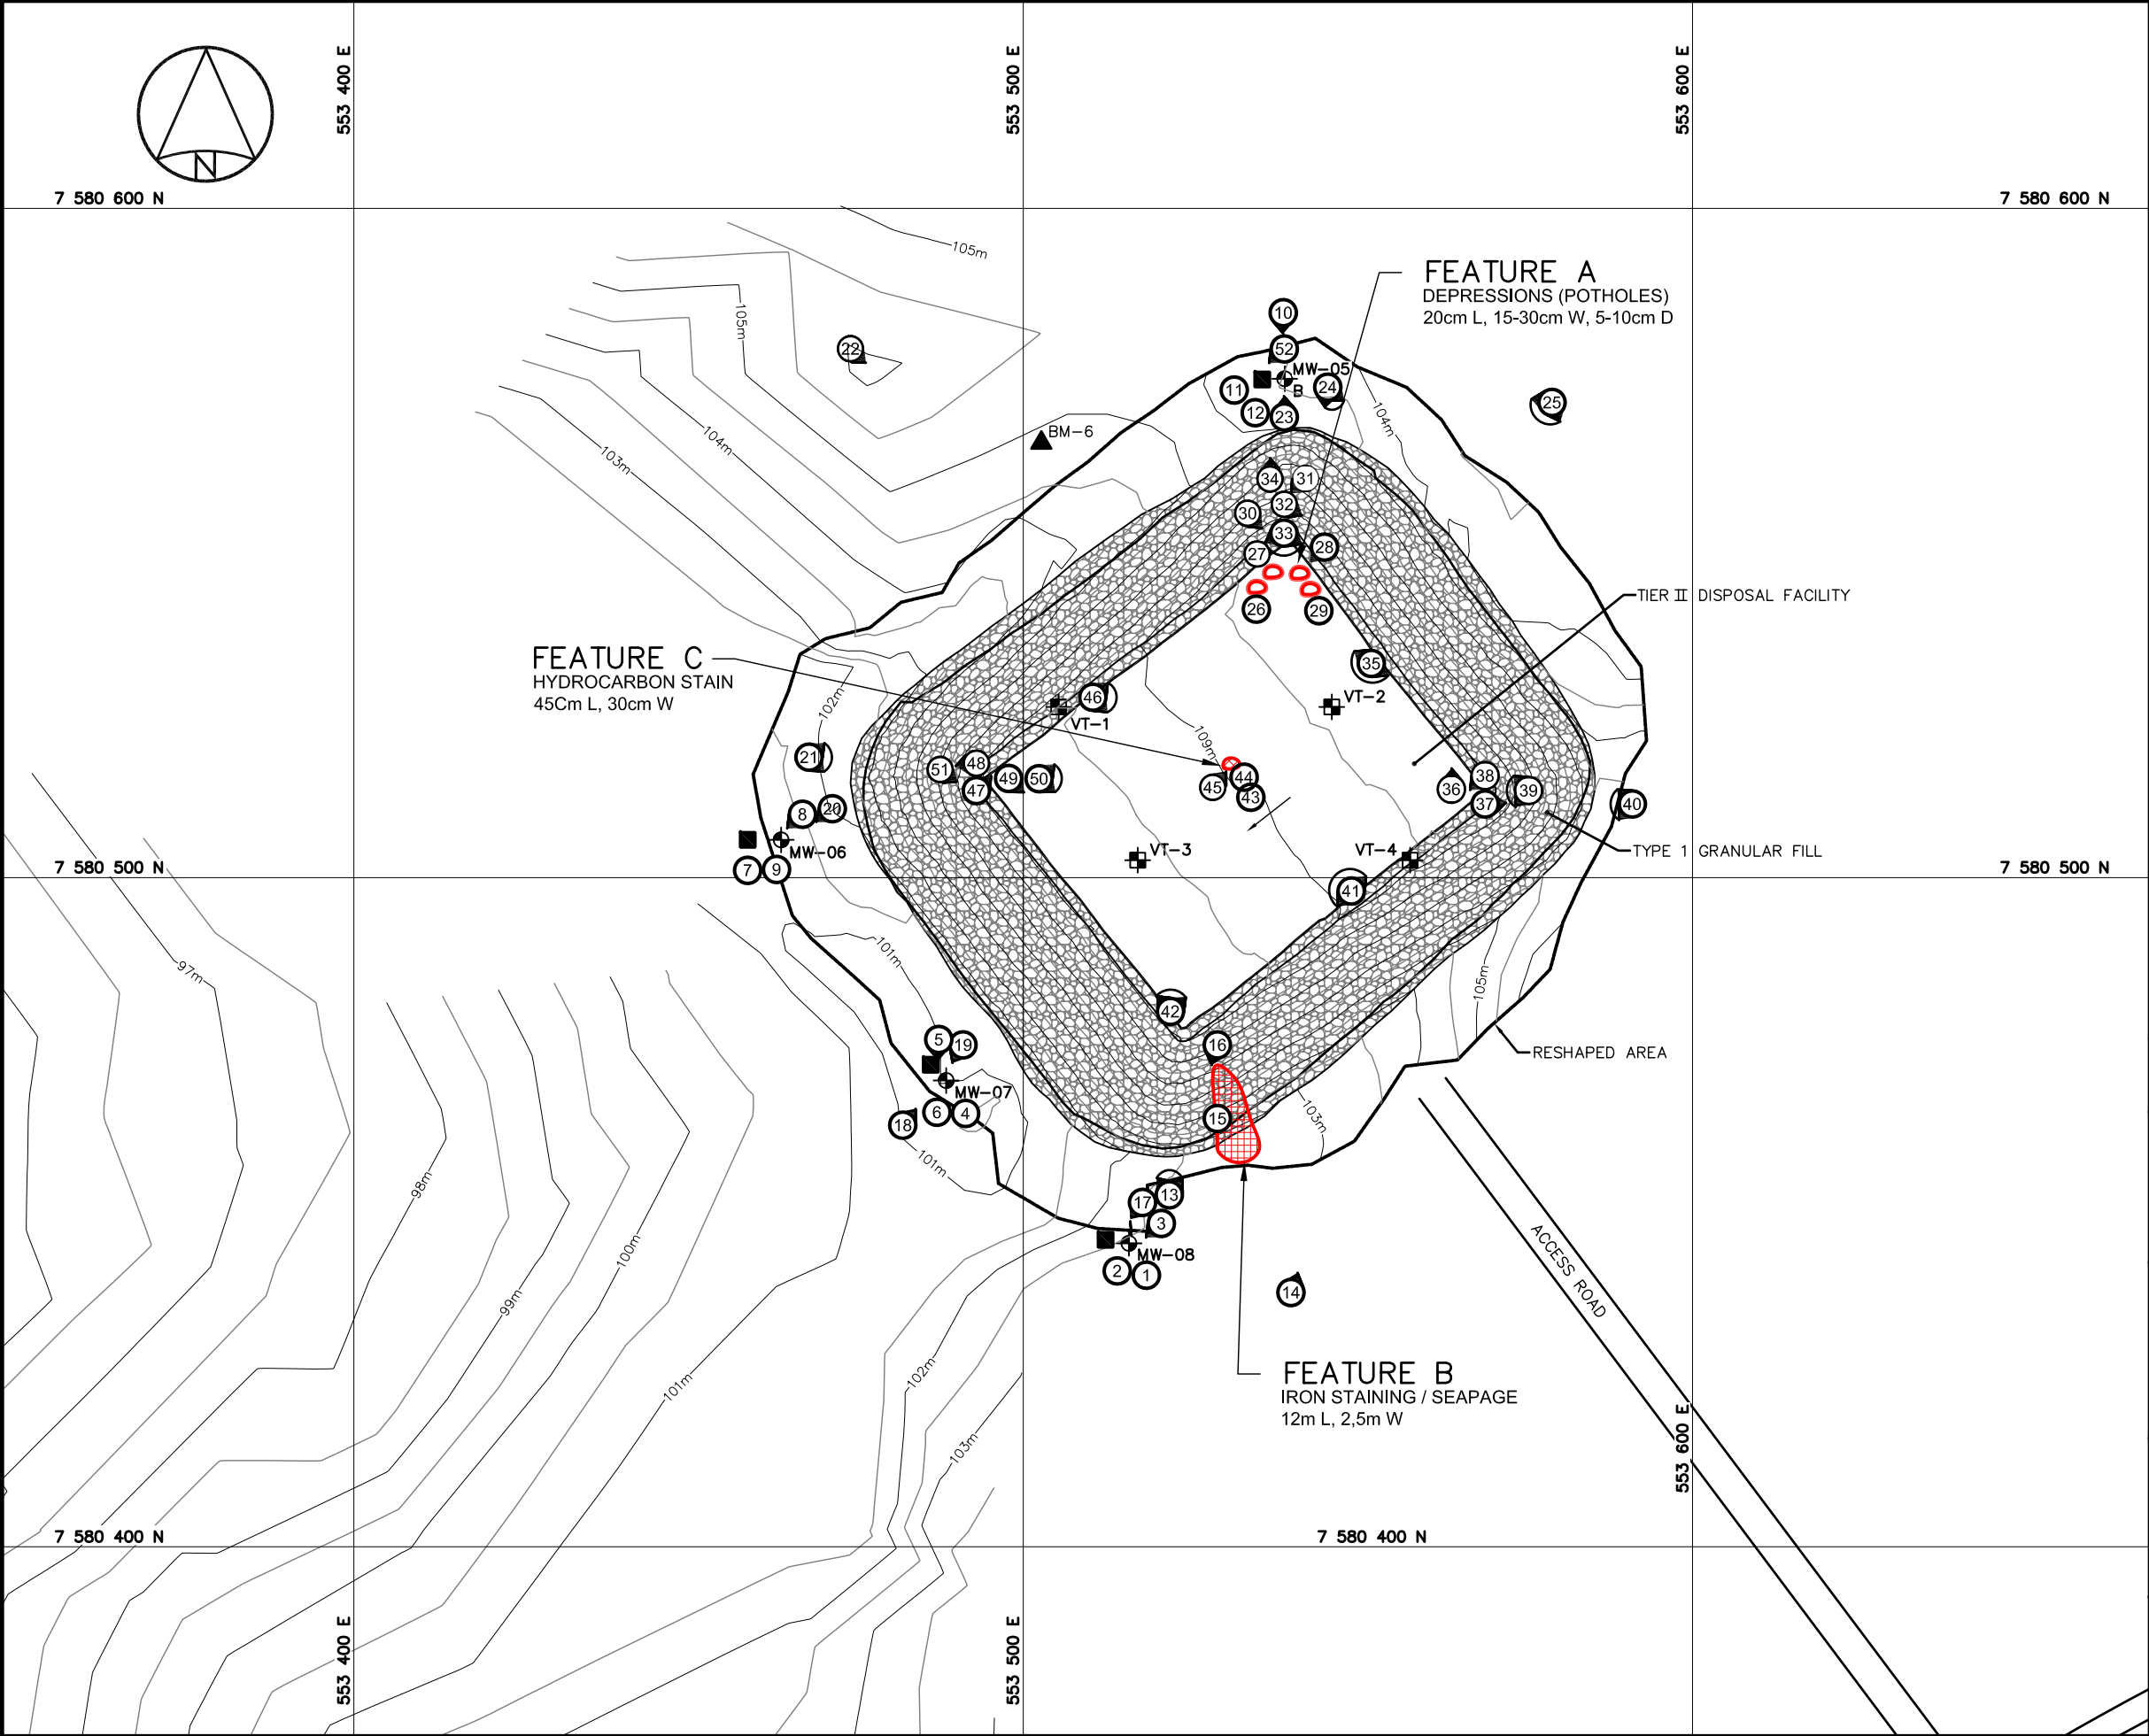

LEGEND

- ▲ BM-6 PERMANENT BENCHMARK LOCATION (1)
- ⊕ MONITORING WELL LOCATION (3)
- ⊕ B BACKGROUND MONITORING WELL LOCATION (1)
- ⊕ GROUND TEMPERATURE CABLE LOCATION (4)
- MONITORING SOIL SAMPLE LOCATION (4)
- ⊕ 33 PHOTOGRAPH LOCATION
- SETTLEMENT (NTS)
- ▨ STAINING AND SEAPAGE
- ▨ STAINING

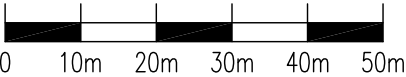

A	FINAL	13-02-12	P.L.	B.M.	AL
NO.	VERSION	DATE	PAR	VERIF.	APPR.



COLLECTION OF
LANDFILL MONITORING DATA
CAM-5, MACKAR INLET, NUNAVUT
TIER II DISPOSAL FACILITY

SITE REMEDIATION SOLUTIONS
Biogenie, a division of EnGlobe Corp.
4495 Wilfrid-Hamel blvd, Suite 200
Quebec, (Quebec) CANADA G1P 2J7
Phone: (418) 653-4422 Fax: (418) 653-3583



MEASUREMENT UNIT Meter	SCALE: 1 : 1,500	DATE (month-year): FEBRUARY 2013
DRAWN BY: P. LÉGARÉ	VERIFIED BY: B. MACKAY	APPROVED BY: A. LECLAIR P. Eng
PROJECT NO: CD2655_200_203	DRAWING NO: CD2655_200_203-CAM-5.5	PAGE CAM-5.5

FIGURE CAM-5.5