



G:\CD2655\FINAL\CAM-5\2013\CD2655_300_303-CAM-5_B.dwg, CAM-5.2, 2014-01-08 10:30:09 AM

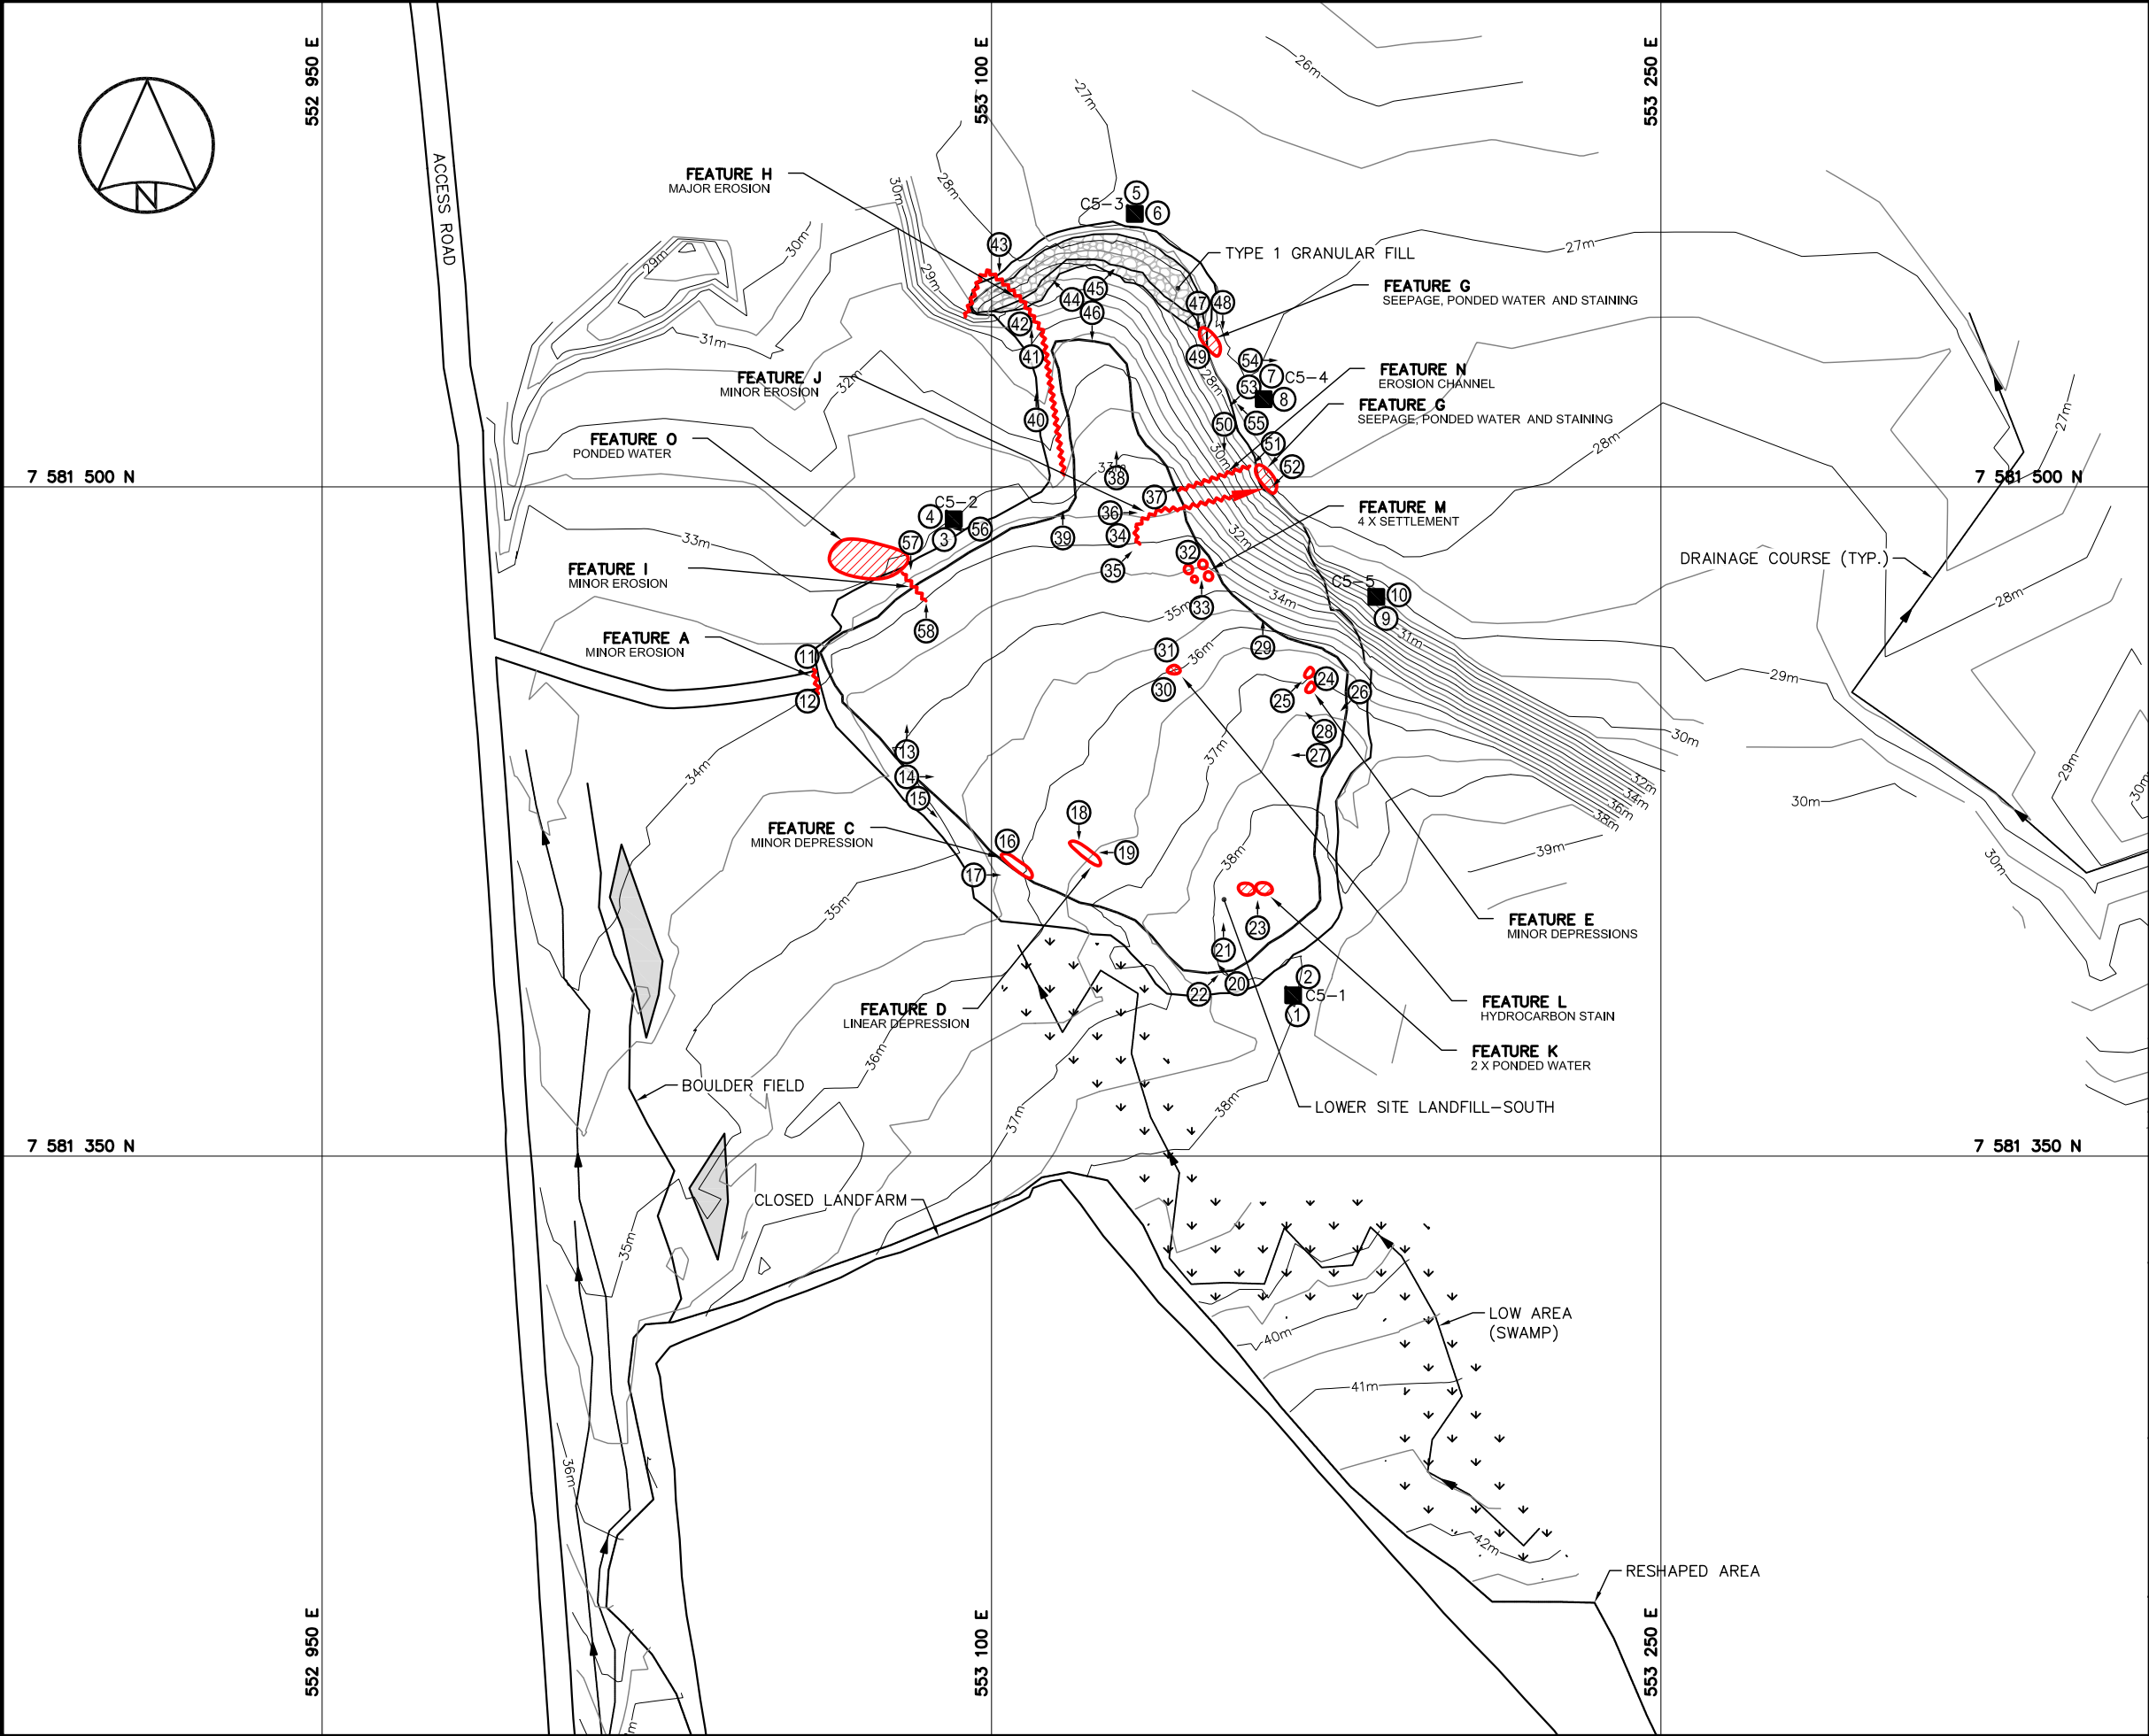

LEGEND

- BODY OF WATER
- SOIL SAMPLE LOCATION (5)
- PHOTOGRAPH LOCATION
- SETTLEMENT (NTS)
- EROSION (NTS)
- STAINING
- PONDING
- SEEPAGE (NTS)

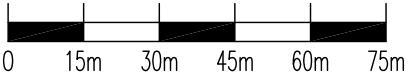

1	FINAL	14-01-08	P.L.	B.M.	AL
NO.	VERSION	DATE	PAR	VERIF.	APPR.



COLLECTION OF LANDFILL MONITORING DATA CAM-5, MACKAR INLET, NUNAVUT LOWER SITE LANDFILL - SOUTH

SITE REMEDIATION SOLUTIONS

Biogenie, a division of EnGlobe Corp.
4495 Wilfrid-Hamel Blvd, Suite 200
Quebec, (Quebec) CANADA G1P 2J7
Phone : 418-653-4422 www.biogenie-env.com



MEASUREMENT UNIT	SCALE:	DATE (month-year):
Meter	1 : 1,500	JANUARY 2014
DRAWN BY:	VERIFIED BY:	APPROVED BY:
P. LÉGARÉ	B. MACKAY	A. LECLAIR P. Eng
PROJECT NO:	DRAWING NO:	PAGE
CD2655_300_303	CD2655_300_303-CAM-5_B	CAM-5.2

FIGURE CAM-5.2