


G:\CD2655\FINAL\CAM-5\2013\CD2655_300_303-CAM-5_C.dwg, CAM-5.3, 2014-01-07 10:28:12

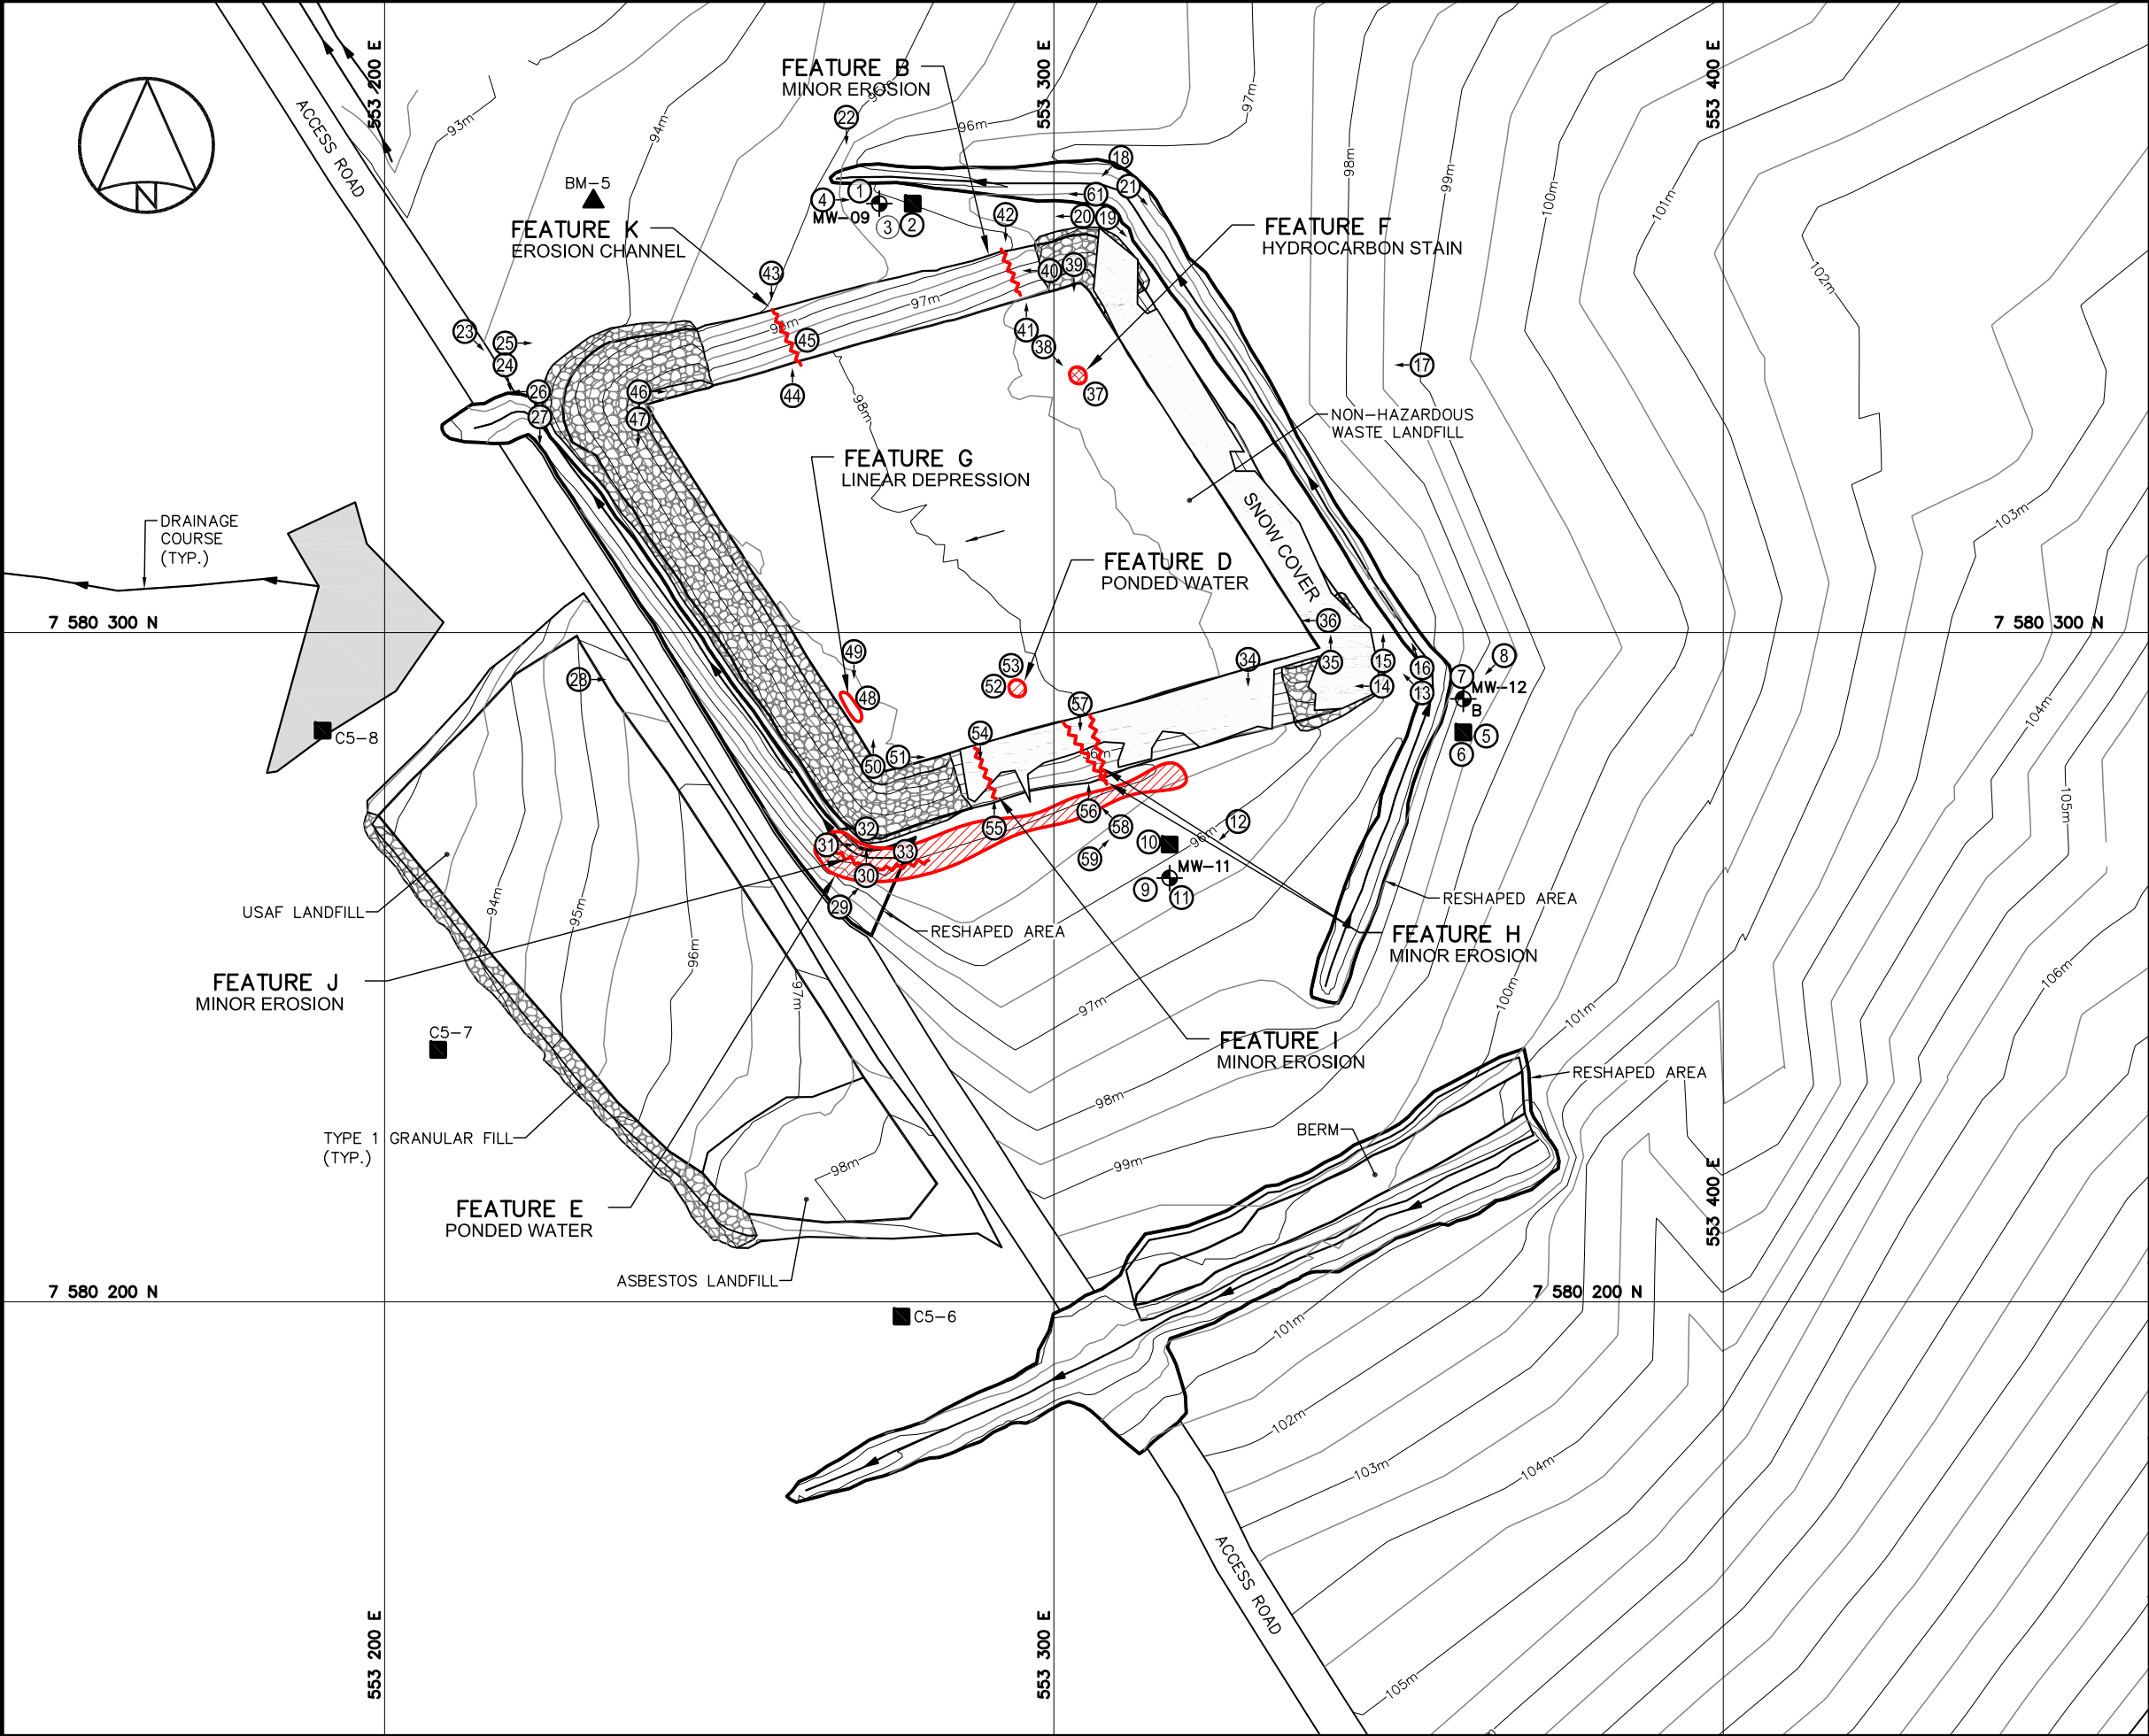

LEGEND

- BODY OF WATER
- BM-6 PERMANENT BENCHMARK LOCATION (1)
- MONITORING WELL LOCATION (2)
- BACKGROUND MONITORING WELL LOCATION (1)
- MONITORING SOIL SAMPLE LOCATION (6)
- PHOTOGRAPH LOCATION
- EROSION (NTS)
- CRACK (NTS)
- PONDING
- STAINING
- SETTLEMENT (NTS)

1	FINAL	14-01-06	P.L.	B.M.	A.L.
NO.	VERSION	DATE	PAR	VERIF.	APPR.



Construction de Défense Canada
Défence Construction Canada

COLLECTION OF
LANDFILL MONITORING DATA
CAM-5, MACKAR INLET, NUNAVUT

NON-HAZARDOUS WASTE LANDFILL

SITE REMEDIATION SOLUTIONS

Biogenie, a division of EnGlobe Corp.
4495 Wilfrid-Hamel Blvd, Suite 200
Quebec, (Quebec) CANADA G1P 2J7
Phone : 418-653-4422 www.biogenie-env.com



MEASUREMENT UNIT Meter	SCALE: 1 : 1,500	DATE (month-year): JANUARY 2014
DRAWN BY: P. LÉGARÉ	VERIFIED BY: B. MACKAY	APPROVED BY: A. LECLAIR P. Eng
PROJECT NO: CD2655_300_303	DRAWING NO: CD2655_300_303-CAM-5_C	PAGE CAM-5.3

FIGURE CAM-5.3