


G:\CD2655\FINAL\CAM-5\2013\CD2655_300_303-CAM-5_D.dwg, CAM-5.4, 2014-01-13 12:48:53 PM

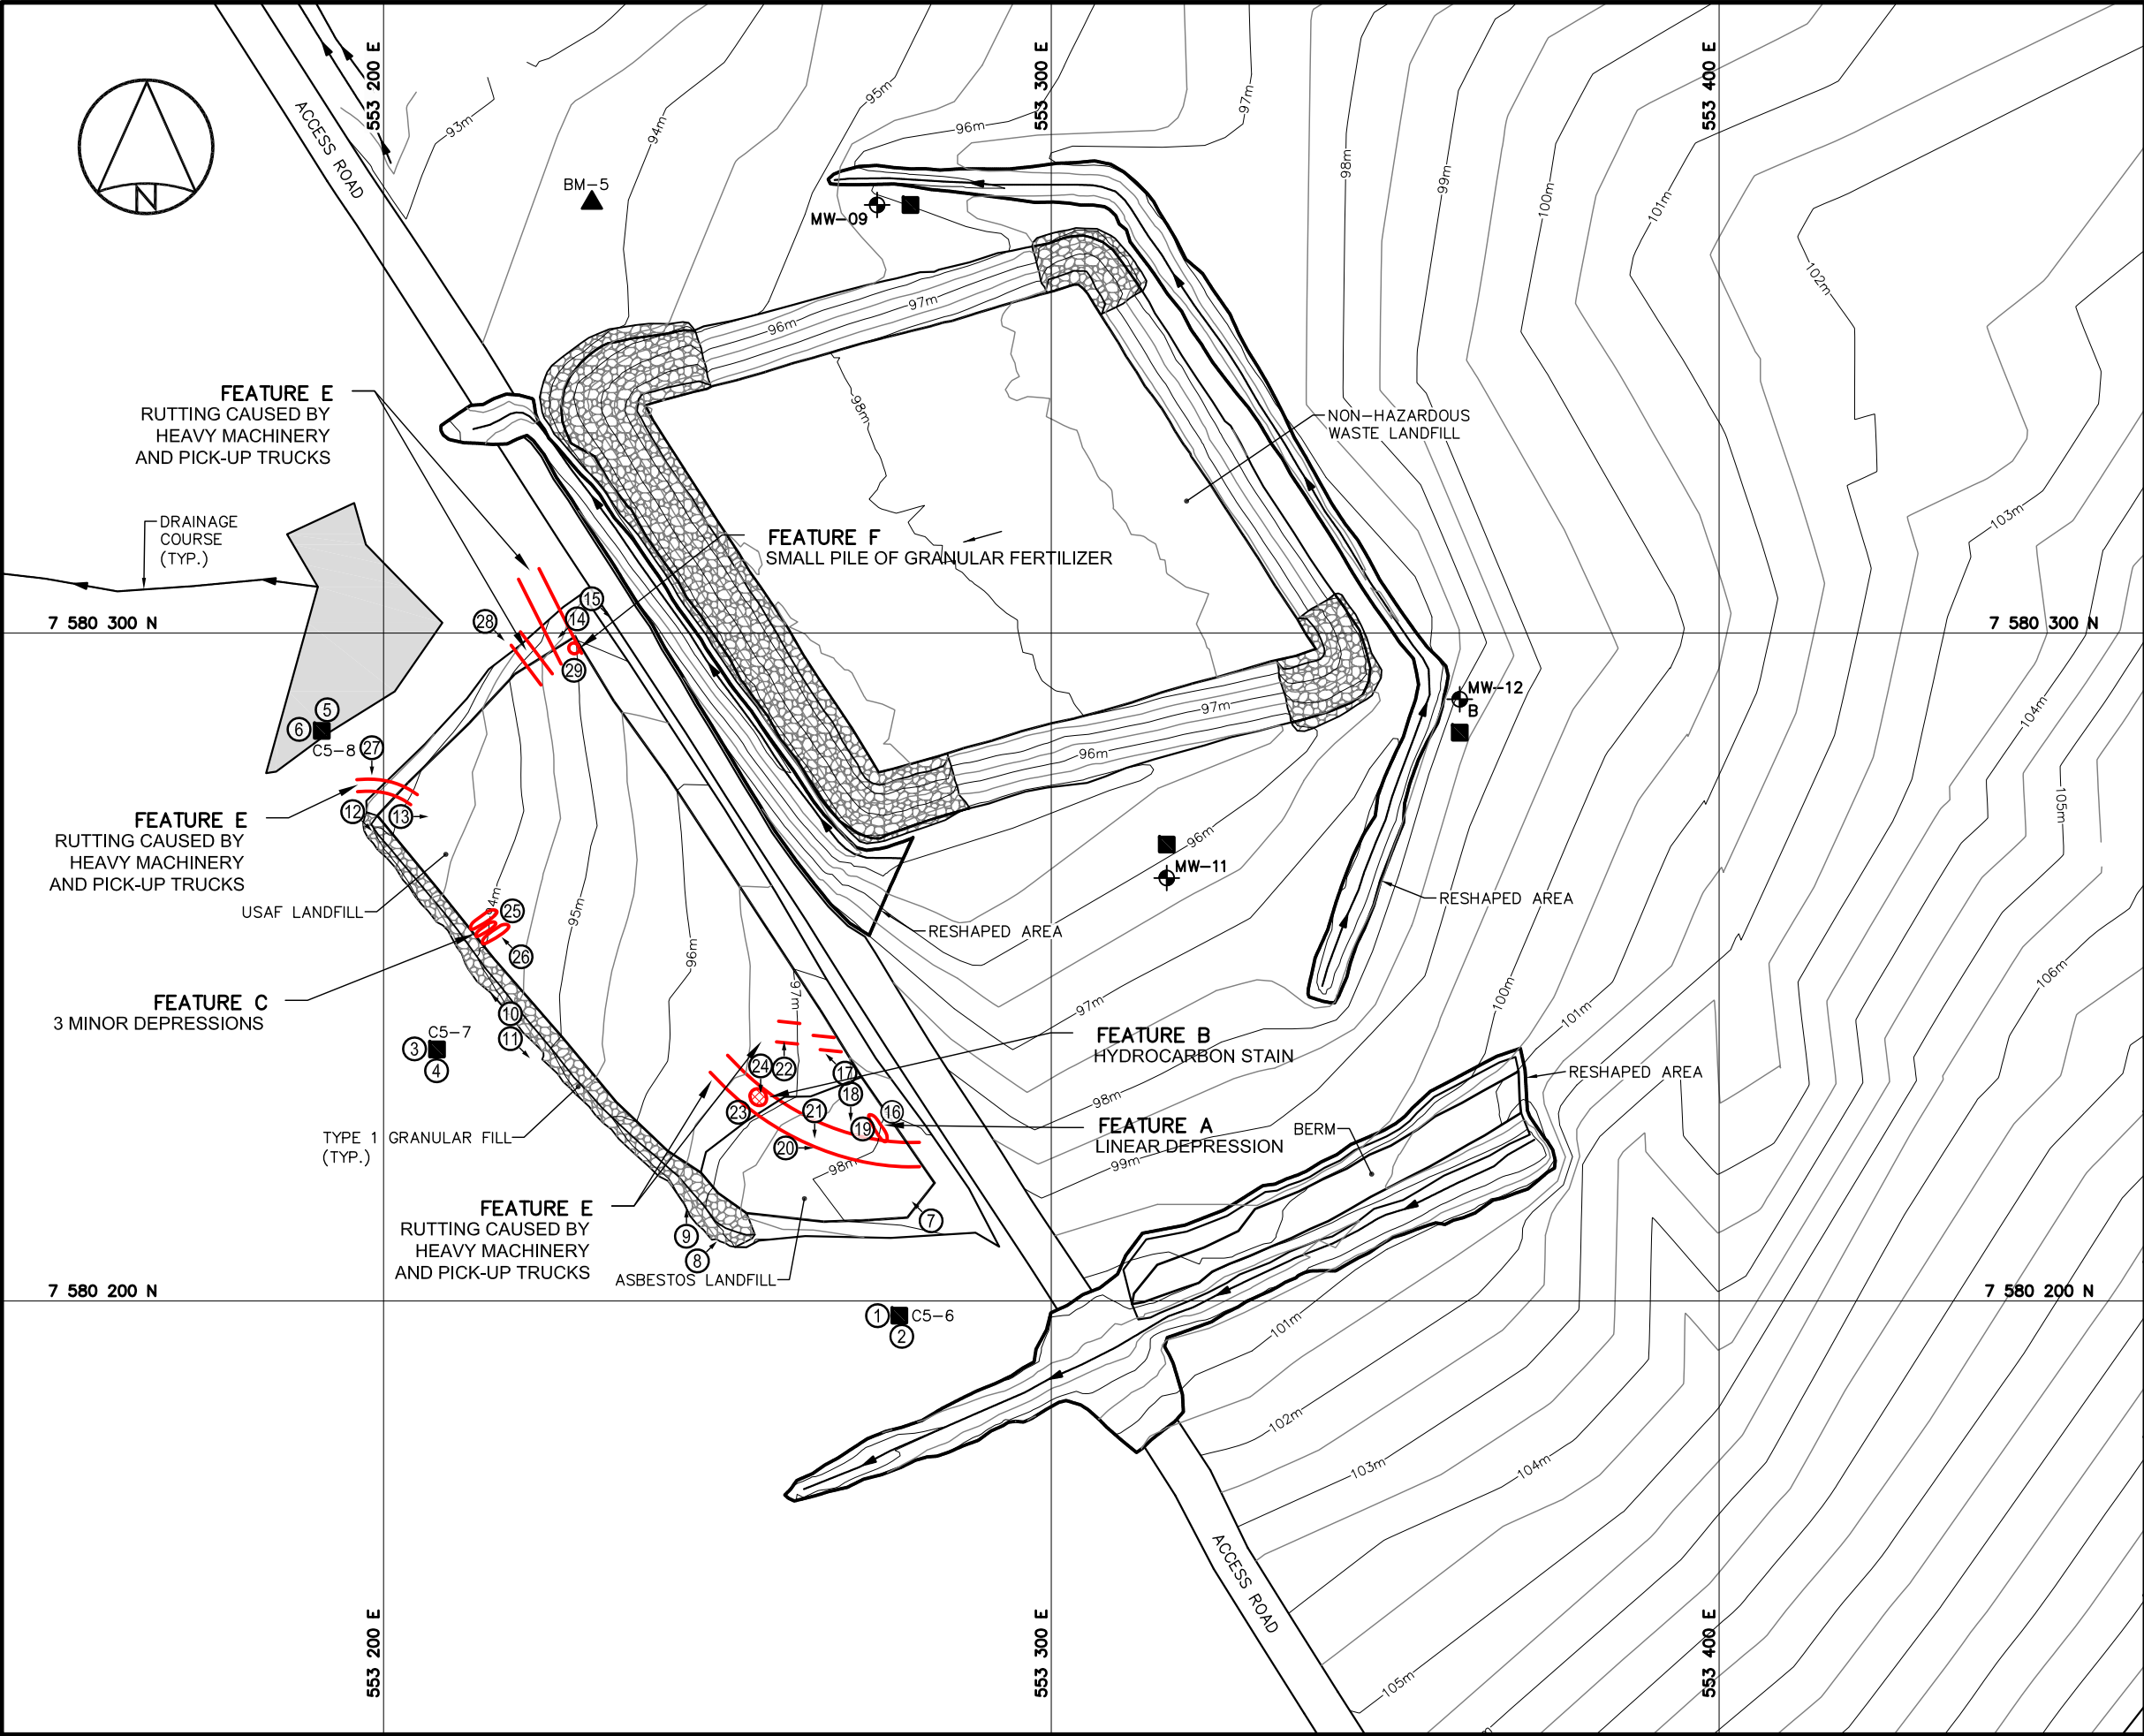

LEGEND

- BODY OF WATER
- BM-6 PERMANENT BENCHMARK LOCATION (1)
- MONITORING WELL LOCATION (2)
- BACKGROUND MONITORING WELL LOCATION (1)
- MONITORING SOIL SAMPLE LOCATION (6)
- PHOTOGRAPH LOCATION
- SETTLEMENT (NTS)
- RUTTING (NTS)
- STAINING

1	FINAL	14-01-06	P.L.	B.M.	A.L.
NO.	VERSION	DATE	PAR	VERIF.	APPR.



COLLECTION OF
LANDFILL MONITORING DATA
CAM-5, MACKAR INLET, NUNAVUT
USAF AND ASBESTOS LANDFILLS

SITE REMEDIATION SOLUTIONS

Biogenie, a division of EnGlobe Corp.
4495 Wilfrid-Hamel Blvd, Suite 200
Quebec, (Quebec) CANADA G1P 2J7
Phone : 418-653-4422 www.biogenie-env.com



MEASUREMENT UNIT	SCALE:	DATE (month-year):
Meter	1 : 1,500	JANUARY 2014
DRAWN BY:	VERIFIED BY:	APPROVED BY:
P. LÉGARÉ	B. MACKAY	A. LECLAIR P. Eng
PROJECT NO:	DRAWING NO:	PAGE
CD2655_300_303	CD2655_300_303-CAM-5_D	CAM-5.4

FIGURE CAM-5.4