



G:\CD2655\FINAL\CAM-5\2013\CD2655_300_303-CAM-5_E.dwg, CAM-5.5, 2014-01-13 12:52:40 PM

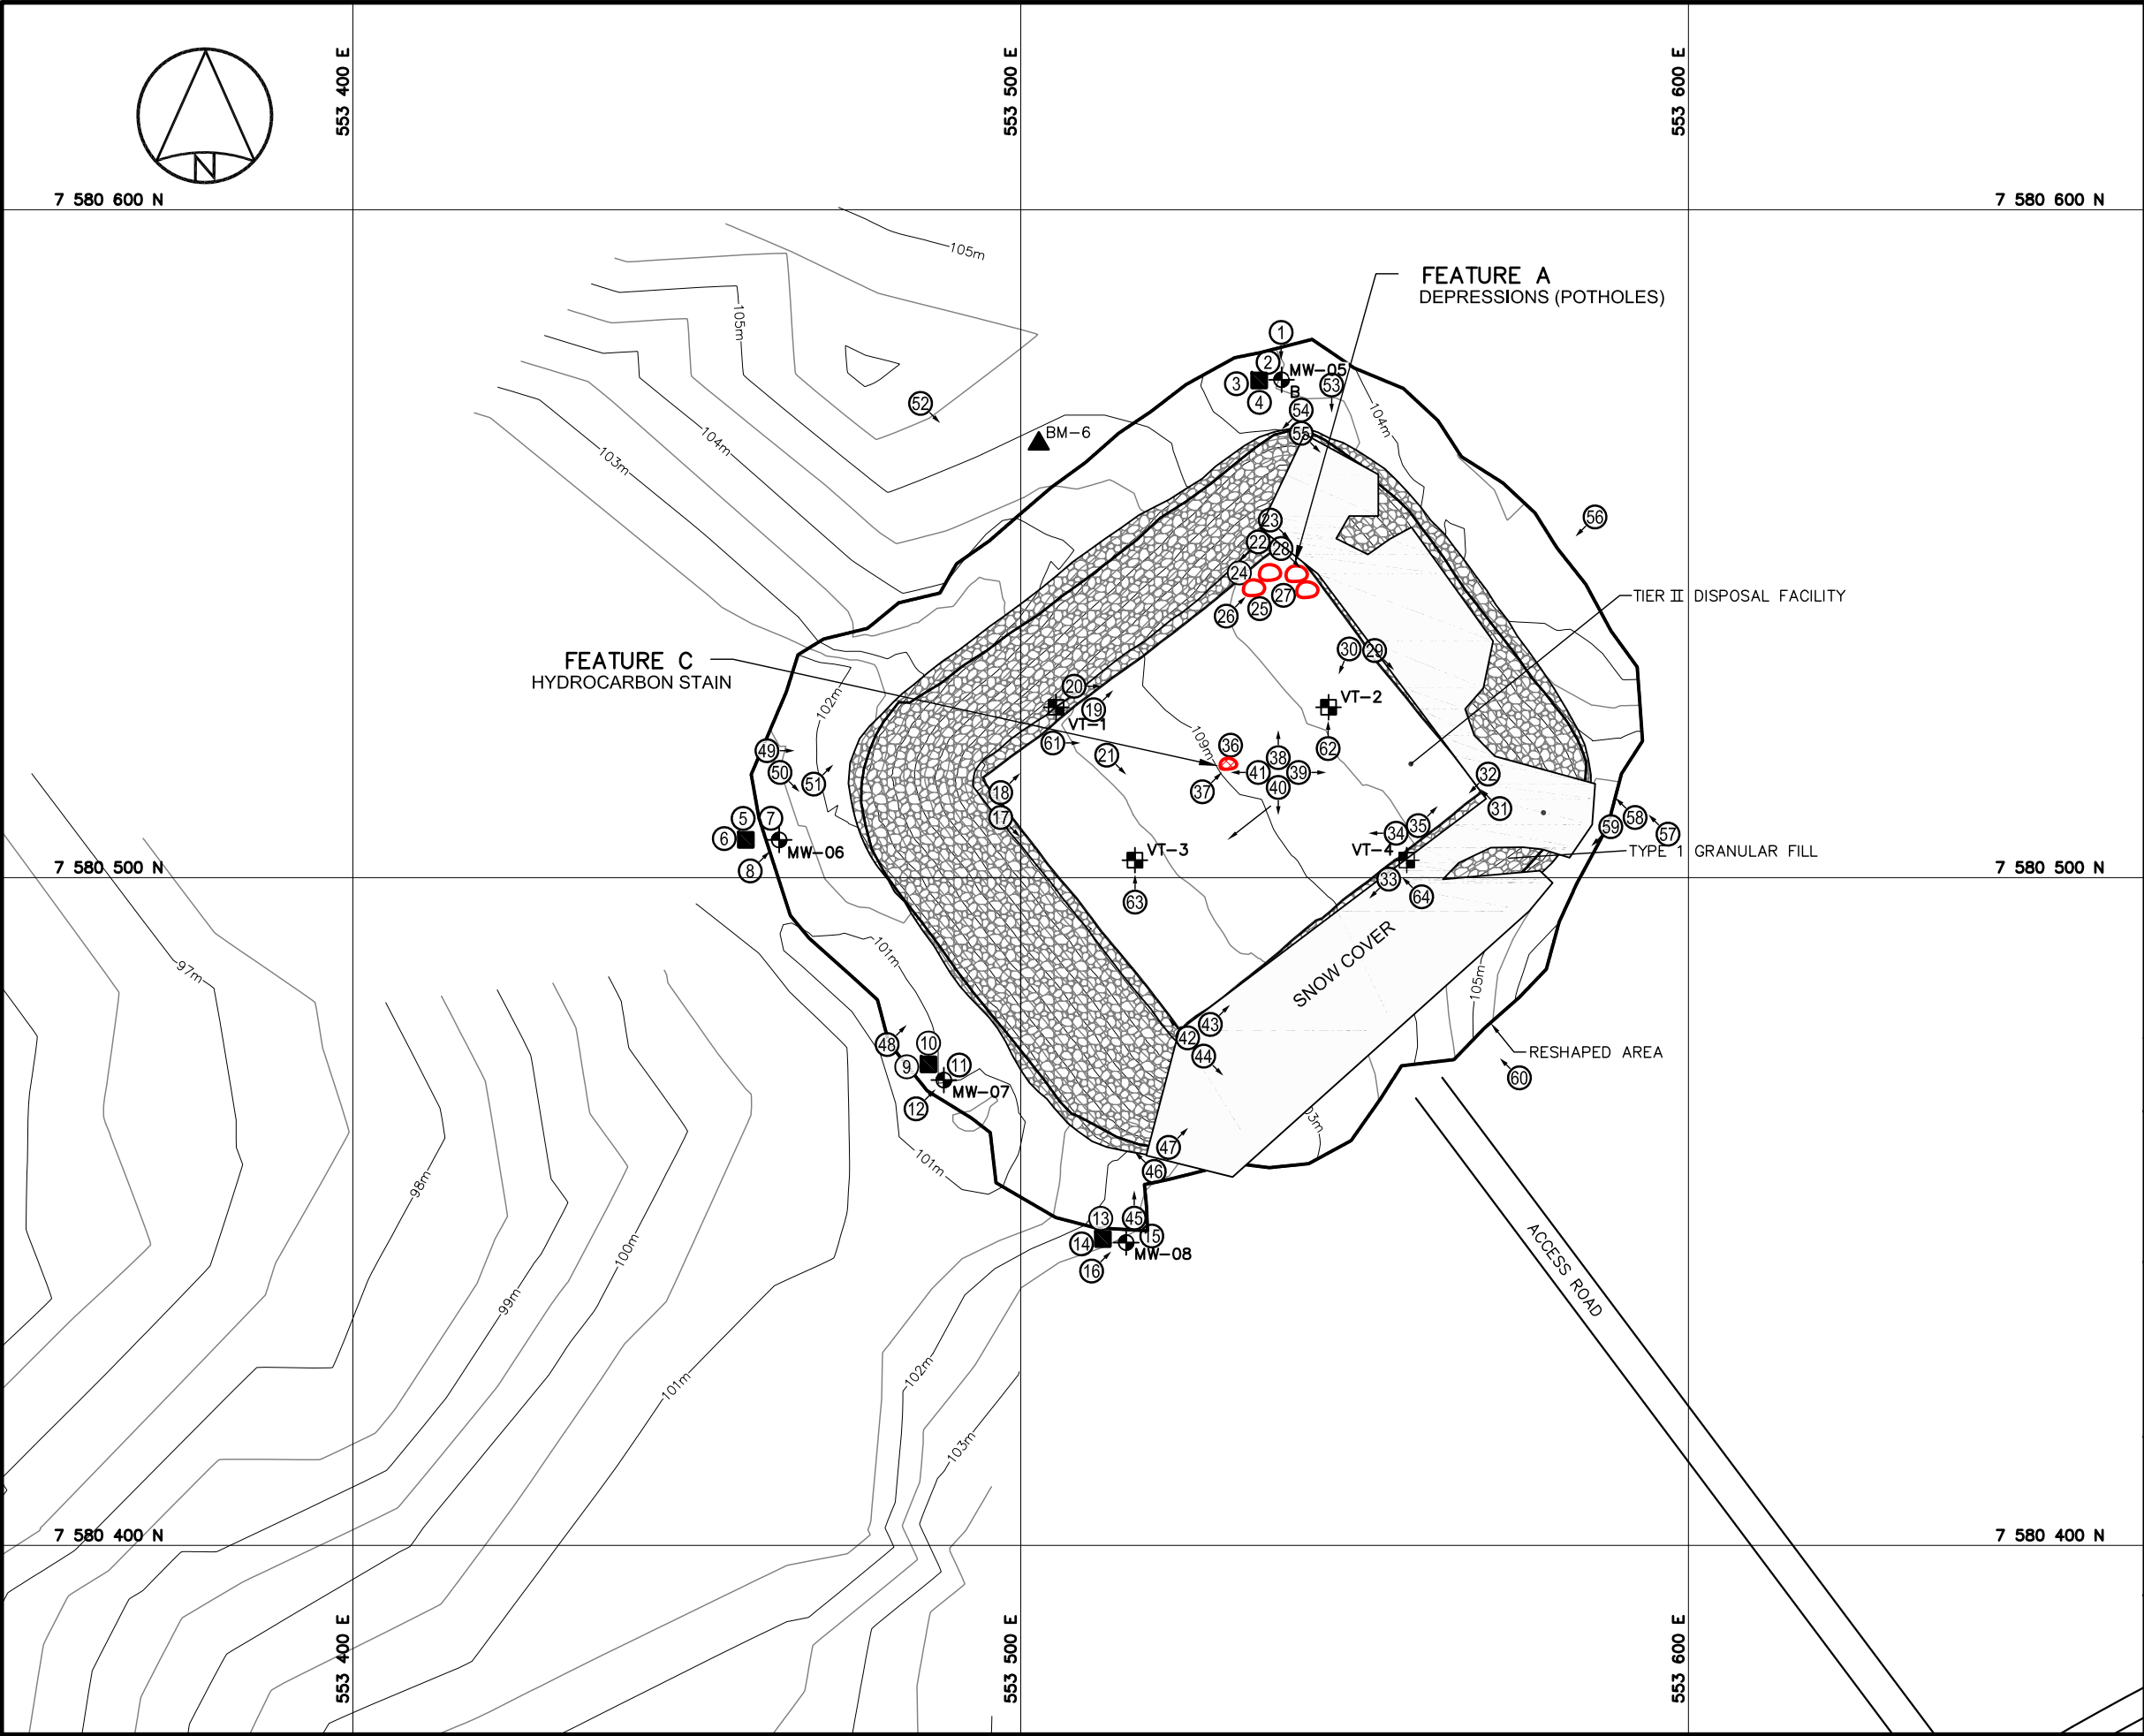

LEGEND

- ▲ BM-6 PERMANENT BENCHMARK LOCATION (1)
- ⊕ MONITORING WELL LOCATION (3)
- ⊕ B BACKGROUND MONITORING WELL LOCATION (1)
- ⊕ GROUND TEMPERATURE CABLE LOCATION (4)
- MONITORING SOIL SAMPLE LOCATION (4)
- ① PHOTOGRAPH LOCATION
- SETTLEMENT (NTS)
- ⊞ STAINING

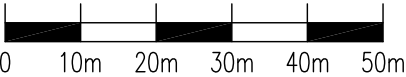

1	FINAL	14-01-09	P.L.	B.M.	A.L.
NO.	VERSION	DATE	PAR	VERIF.	APPR.



COLLECTION OF
LANDFILL MONITORING DATA
CAM-5, MACKAR INLET, NUNAVUT
TIER II DISPOSAL FACILITY

SITE REMEDIATION SOLUTIONS

Biogenie, a division of EnGlobe Corp.
4495 Wilfrid-Hamel Blvd, Suite 200
Quebec, (Quebec) CANADA G1P 2J7
Phone : 418-653-4422 www.biogenie-env.com



MEASUREMENT UNIT Meter	SCALE: 1 : 1,500	DATE (month-year): JANUARY 2014
DRAWN BY: P. LÉGARÉ	VERIFIED BY: B. MACKAY	APPROVED BY: A. LECLAIR P. Eng
PROJECT NO: CD2655_300_303	DRAWING NO: CD2655_300_303-CAM-5_E	PAGE CAM-5.5

FIGURE CAM-5.5