

#### GENERAL NOTES:

- 1 ALL PROPERTY LINE BEARINGS AND DIMENSIONS HAVE BEEN PROVIDED BY THE CITY OF IQALUIT
- 2 CONTRACTOR IS TO REPORT IMMEDIATELY ANY DISCREPANCIES ON THE DRAWINGS TO THE ENGINEER.


#### LEGEND:

PROPERTY LINE



WATER TEST WELLS

ALL SITE INFORMATION TAKEN FROM A TOPOGRAPHIC SURVEY OF:  
LOT 1, BLOCK 229  
SOURCE: CITY OF IQALUIT

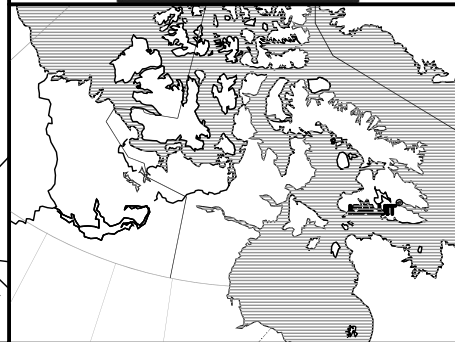

1  
G1

AV PLAN

SCALE: 1:1200

PROJECT:  
SITE SURVEY

CLIENT DEPARTMENT:  
NUNATTA ENVIRONMENTAL INC.


COMMUNITY:  
IQALUIT, NU

LOT 1, BLOCK 229

DATE:  
2012

DRAWN BY:  
T.STOKES

SPG.1

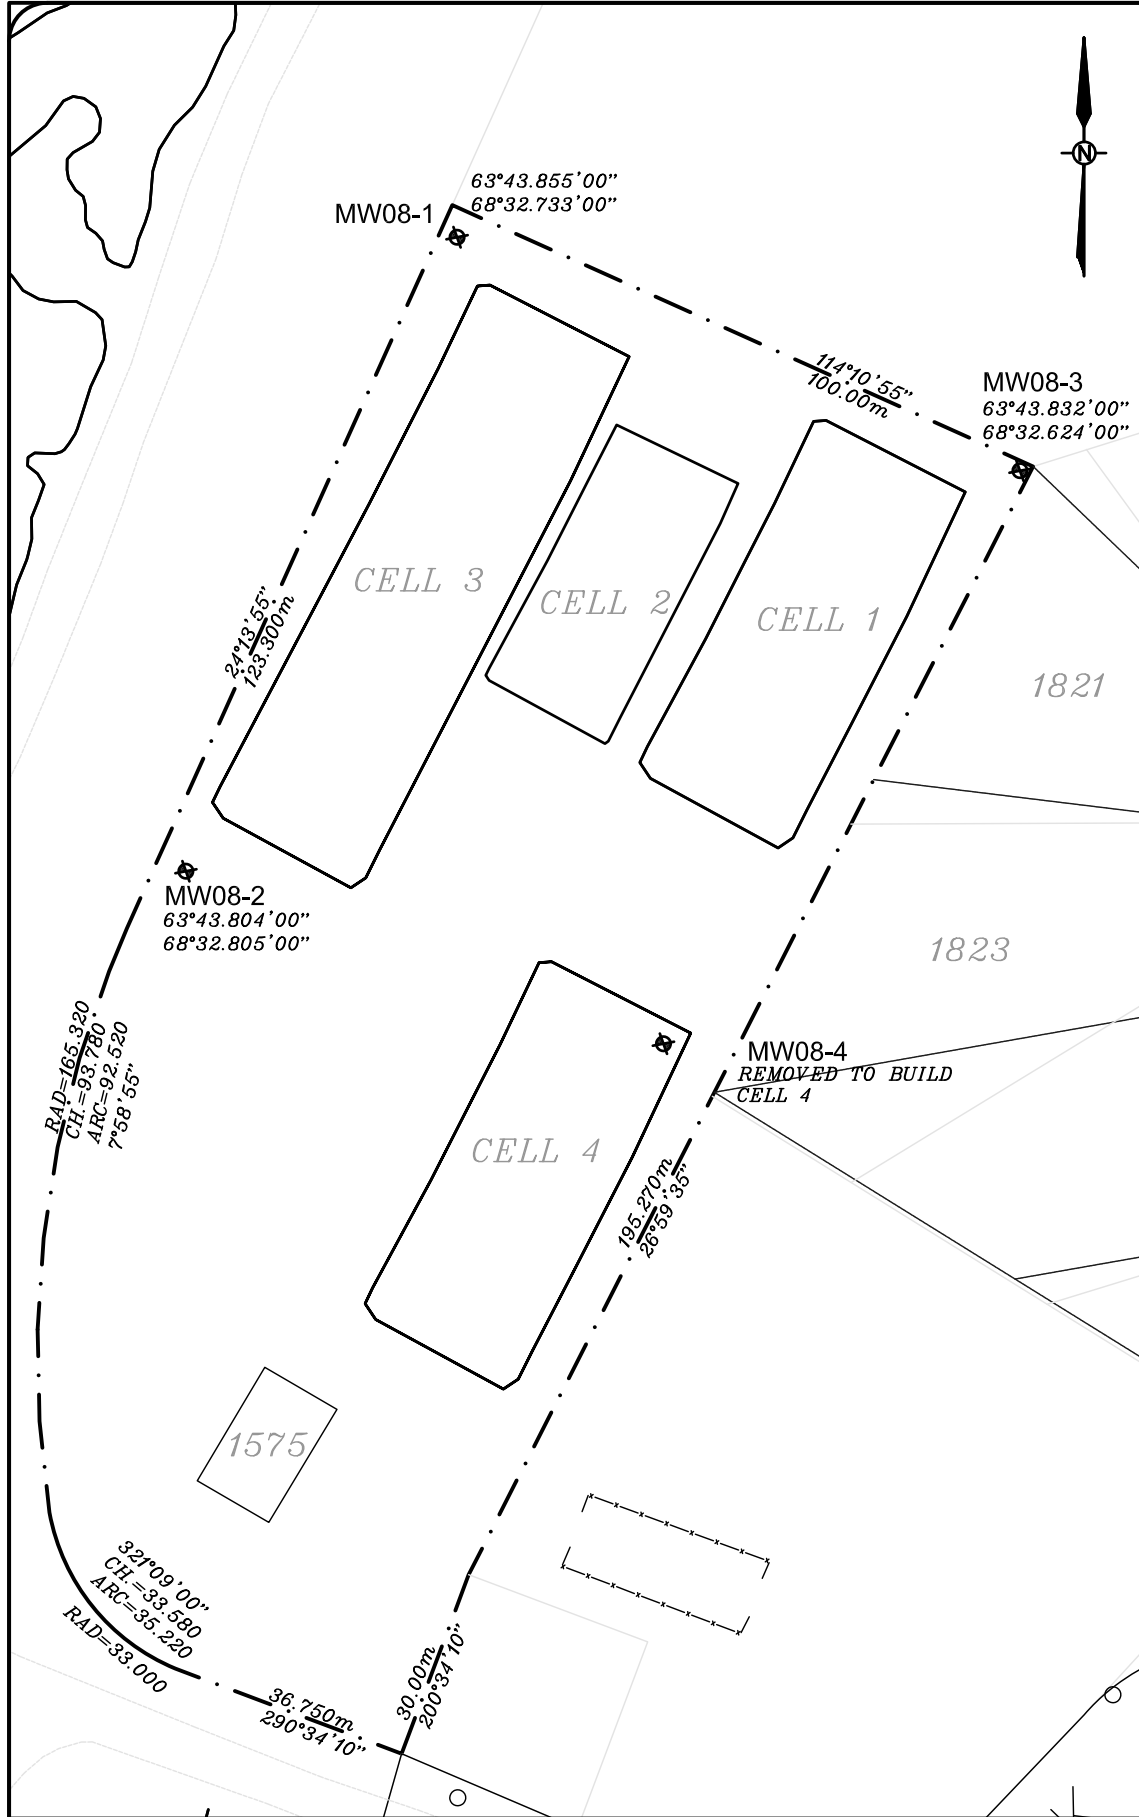

#### GENERAL NOTES:

- 1 ALL PROPERTY LINE BEARINGS AND DIMENSIONS HAVE BEEN PROVIDED BY THE CITY OF IQALUIT
- 2 CONTRACTOR IS TO REPORT IMMEDIATELY ANY DISCREPANCIES ON THE DRAWINGS TO THE ENGINEER.


#### LEGEND:

PROPERTY LINE



WATER TEST WELLS

ALL SITE INFORMATION TAKEN FROM A TOPOGRAPHIC SURVEY OF:  
LOT 1, BLOCK 229  
SOURCE: CITY OF IQALUIT

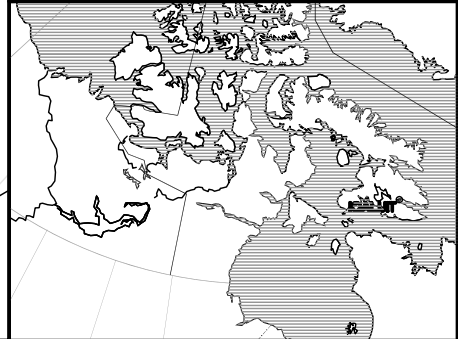

1  
G1

AV PLAN

SCALE: 1:1200

PROJECT:  
SITE SURVEY

CLIENT DEPARTMENT:  
NUNATTA ENVIRONMENTAL INC.


COMMUNITY:  
IQALUIT, NU

LOT 1, BLOCK 229

DATE:  
NEW WELL INSTALLED  
2008 BY FRANZ

DRAWN BY:  
T.STOKES

SPG.2

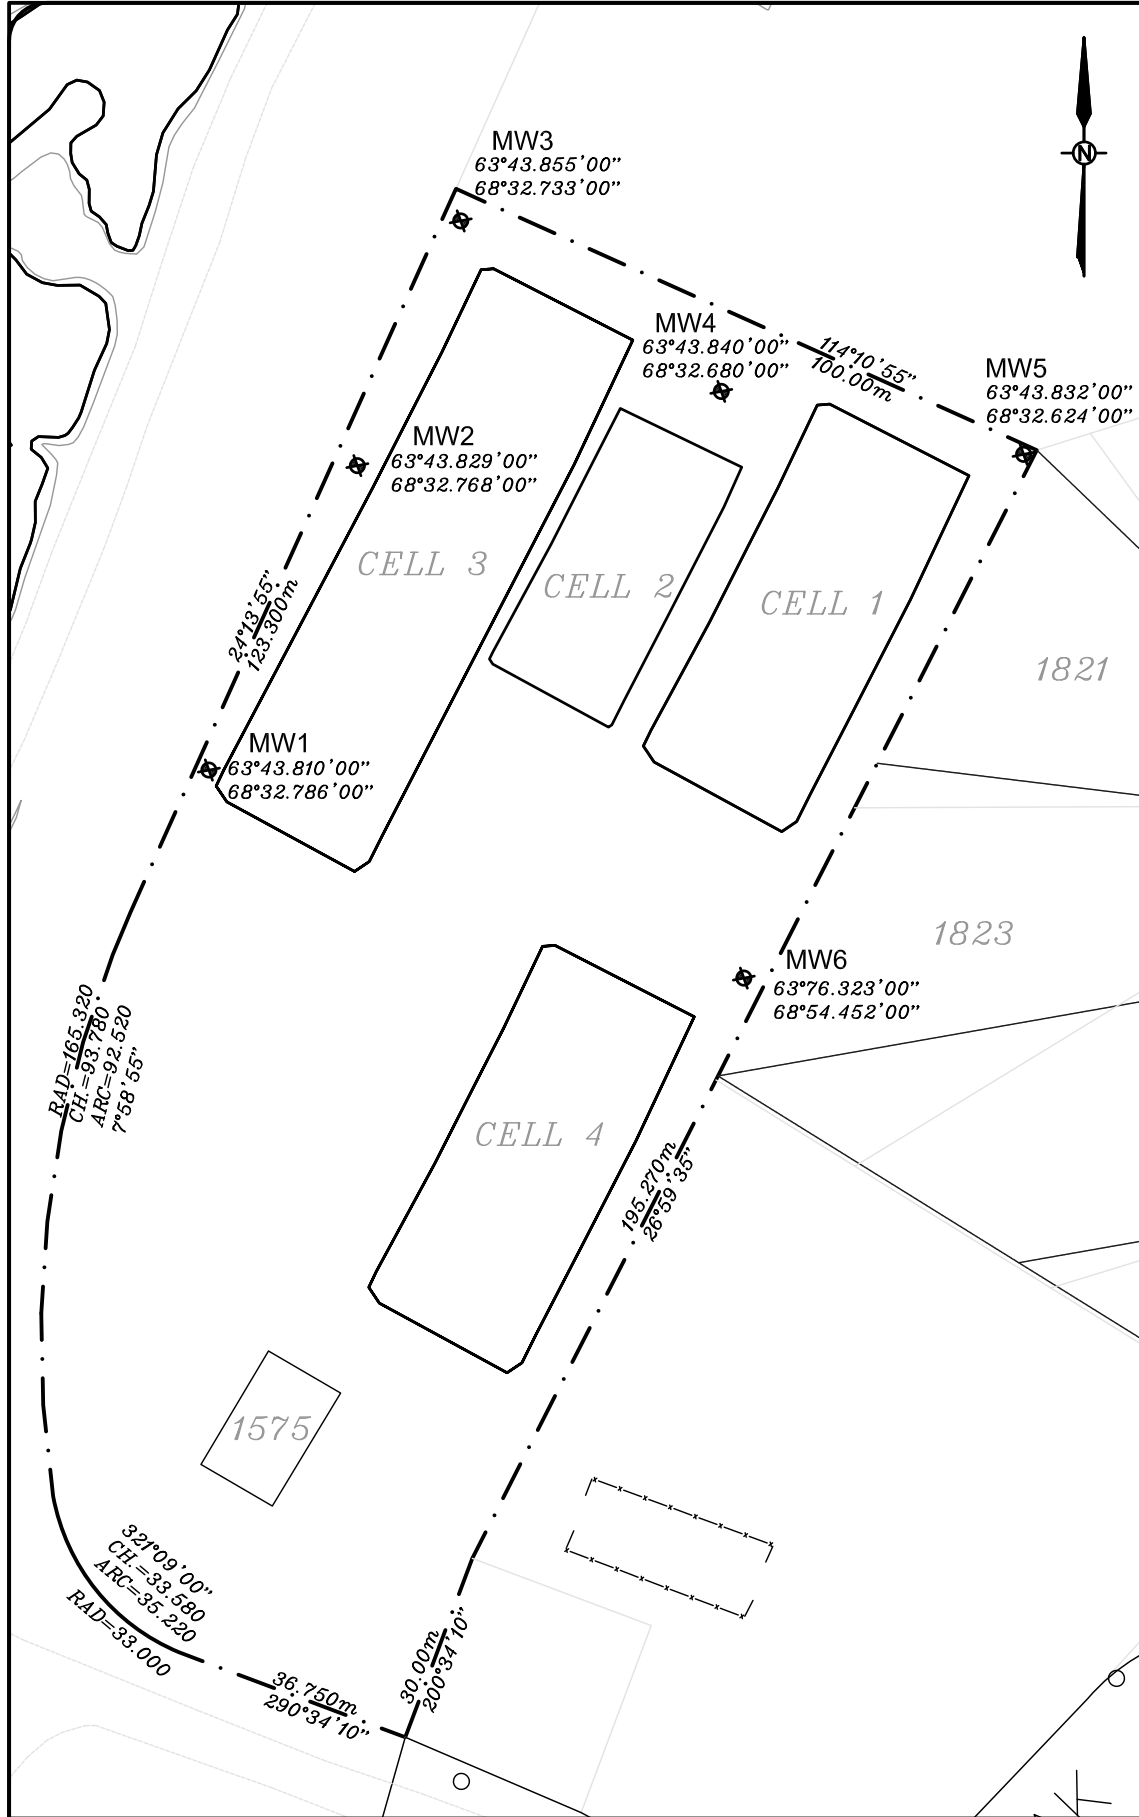

#### GENERAL NOTES:

- 1 ALL PROPERTY LINE BEARINGS AND DIMENSIONS HAVE BEEN PROVIDED BY THE CITY OF IQALUIT
- 2 CONTRACTOR IS TO REPORT IMMEDIATELY ANY DISCREPANCIES ON THE DRAWINGS TO THE ENGINEER.


#### LEGEND:

PROPERTY LINE



WATER TEST WELLS

ALL SITE INFORMATION TAKEN FROM A TOPOGRAPHIC SURVEY OF:  
 LOT 1, BLOCK 229  
 SOURCE: CITY OF IQALUIT

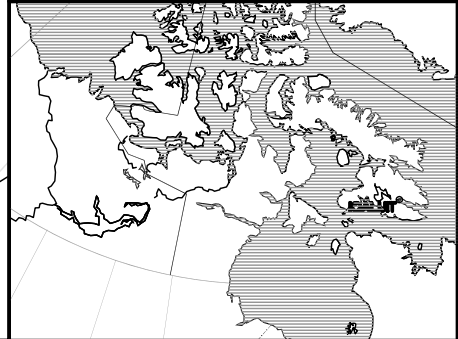

1  
G1

AV PLAN

SCALE: 1:1200

PROJECT:  
SITE SURVEY

CLIENT DEPARTMENT:  
NUNATTA ENVIRONMENTAL INC.

COMMUNITY:  
IQALUIT, NU

LOT 1, BLOCK 229

DATE:  
2004

DRAWN BY:  
T.STOKES

SPG.3

