




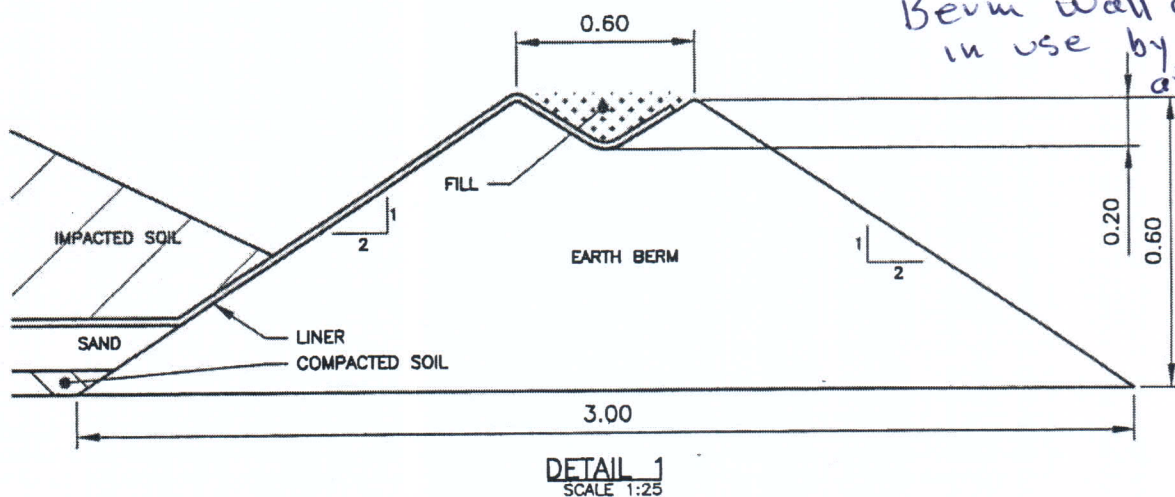

SCALE 1:1500

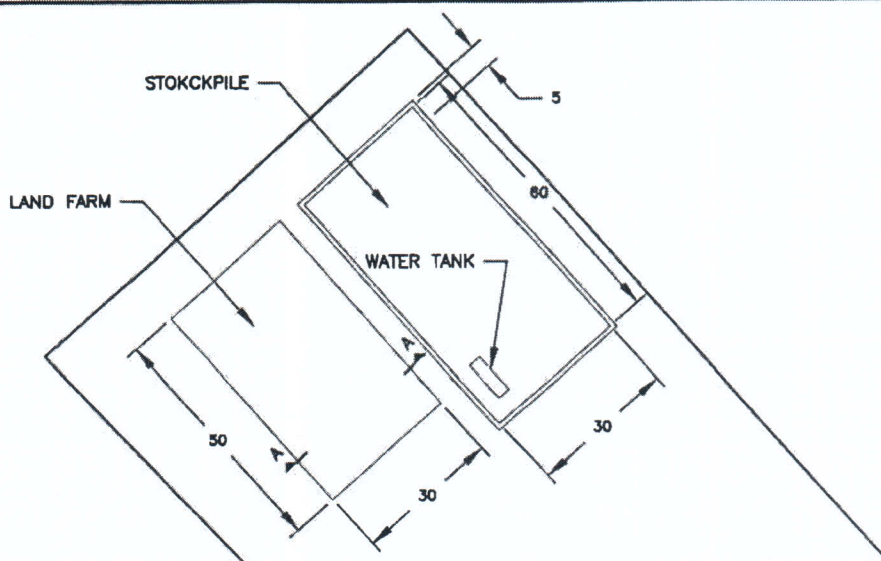

DETAIL 1
SCALE 1:25

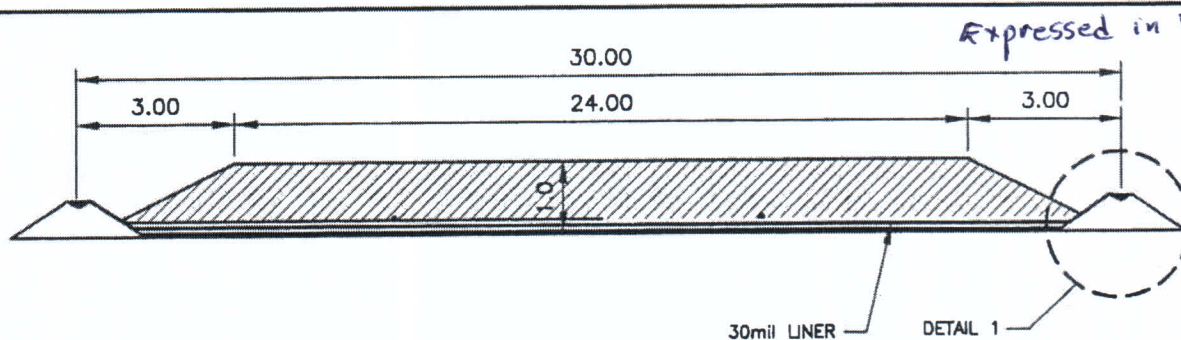

SECTION A-A'
NTS

EDIT DATE: 29/11/00 ACAD FILE: g:\cad\007944\fig2
BASE NAME: a.dwg LOG FILE: na



PROJECT

NORTHERN FUTURES
REMEDIAL ACTION PLAN

TITLE

SITE PLAN, SECTION &
DETAIL FOR LAND FARM

PROJECT NUMBER

00-7944

DATE

NOV 2000

FIGURE NUMBER

FIG 4