


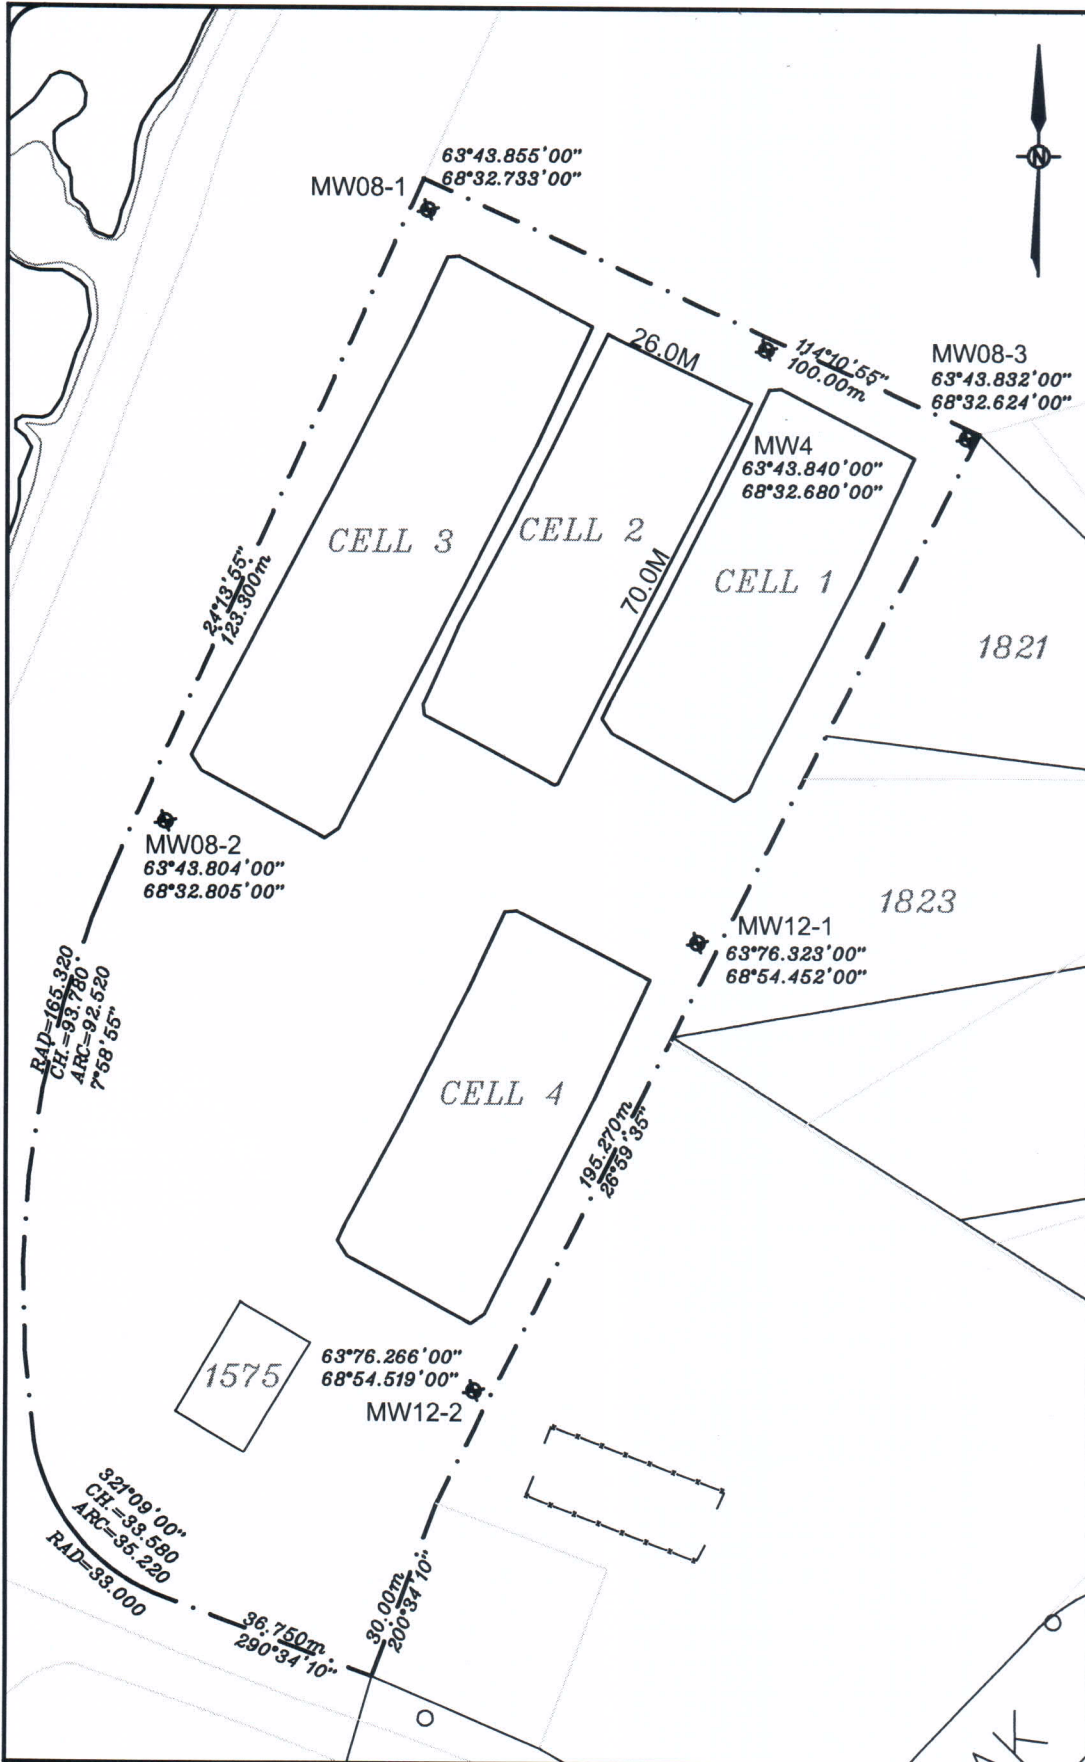

GENERAL NOTES:

- 1 ALL PROPERTY LINE BEARINGS AND DIMENSIONS HAVE BEEN PROVIDED BY THE CITY OF IQALUIT
- 2 CONTRACTOR IS TO REPORT IMMEDIATELY ANY DISCREPANCIES ON THE DRAWINGS TO THE ENGINEER.

LEGEND:


PROPERTY LINE



WATER TEST WELLS

ALL SITE INFORMATION TAKEN FROM A TOPOGRAPHIC SURVEY OF:
LOT 1, BLOCK 229
SOURCE: CITY OF IQALUIT

proposed
change to
land farm
Cell #2
Expansion/
upgrade.

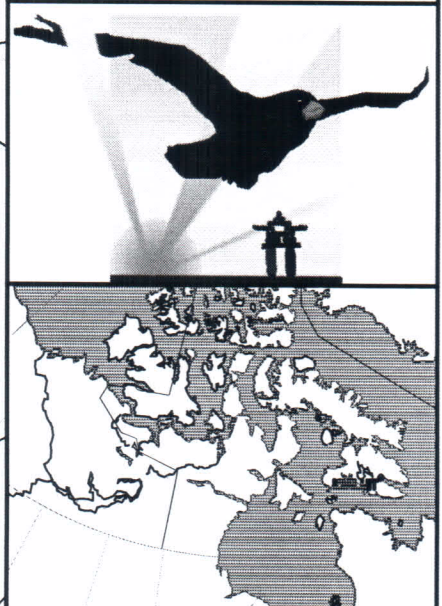

PROJECT:
SITE SURVEY

CLIENT DEPARTMENT:
NUNATTA ENVIRONMENTAL INC.

COMMUNITY:
IQALUIT, NU

LOT 1, BLOCK 229

DATE:
ALL WELLS IN USE AT
NUNATTA 2012

DRAWN BY:
T.STOKES

SPG.1

1
G1

CELL PLAN

SCALE: 1:1200