


- Legend**
- TBM4 □ TEMPORARY BENCHMARK
 - BM-1 ▲ PERMANENT BENCHMARK
 - 101→ COORDINATE POINT
 - C4-MW-1A
C4-MW-1B ■ MONITORING SOIL SAMPLE LOCATION
 - ⊕ MONITORING WELL LOCATION
 - ⊞ VERTICAL THERMISTOR LOCATION
 - ① PHOTOGRAPH LOCATION

RECORD DRAWING
NOT FOR CONSTRUCTION

Map Sources / Notes:
-Source drawing from UMA: C4-RD04.dwg
-Photograph numbers refer to those found in Appendix C2 - Visual Inspection Photographs

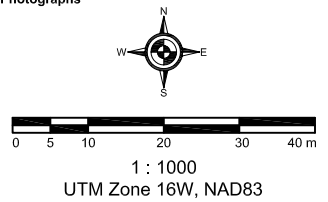

File Name: C4-RD04.dwg
Reviewed by: DCJ
Date Issued: October, 2008
Prepared by: KAB
Project Number: 80-297

Defence Construction Canada
2008 CAM-4 DEW Line Monitoring Program
CAM-4 Kugaaruk
Nunavut Territory

Upper Site Landfill

AECOM

Figure C-1
Version 1