






INDIAN AND NORTHERN AFFAIRS CANADA			
NUNAVUT REGIONAL OFFICE			
General Notes: 1.			
Legend:			
No. DATE REVISION REVISION APPR.	Sinanni		
SCALE - ECHELLE 1:50,000			
PROJECT - PROJET BAF-5 RESOLUTION ISLAND			
© COPYRIGHT HER MAJESTY THE QUEEN IN THE RIGHT OF CANADA 2002, AS REPRESENTED BY INDIAN AND NORTHERN AFFAIRS CANADA			
TRADE - METIER SITING	DATE 2002-11-28		APPR.
SUBJECT - SUJET GENERAL LAYOUT OF THE RADIO HILL AREA			
PRODUCTION DESIGNED ETUDE DRAWN DESSINE CHECKED VERIFIE COORDINATION	CONCURRENCE - ASSENTIMENT P.S. G.J. K.C. REVIEWED - REVU		
DWG. NO. - DESSIN NO. AB-2002-102-05			
Canada			

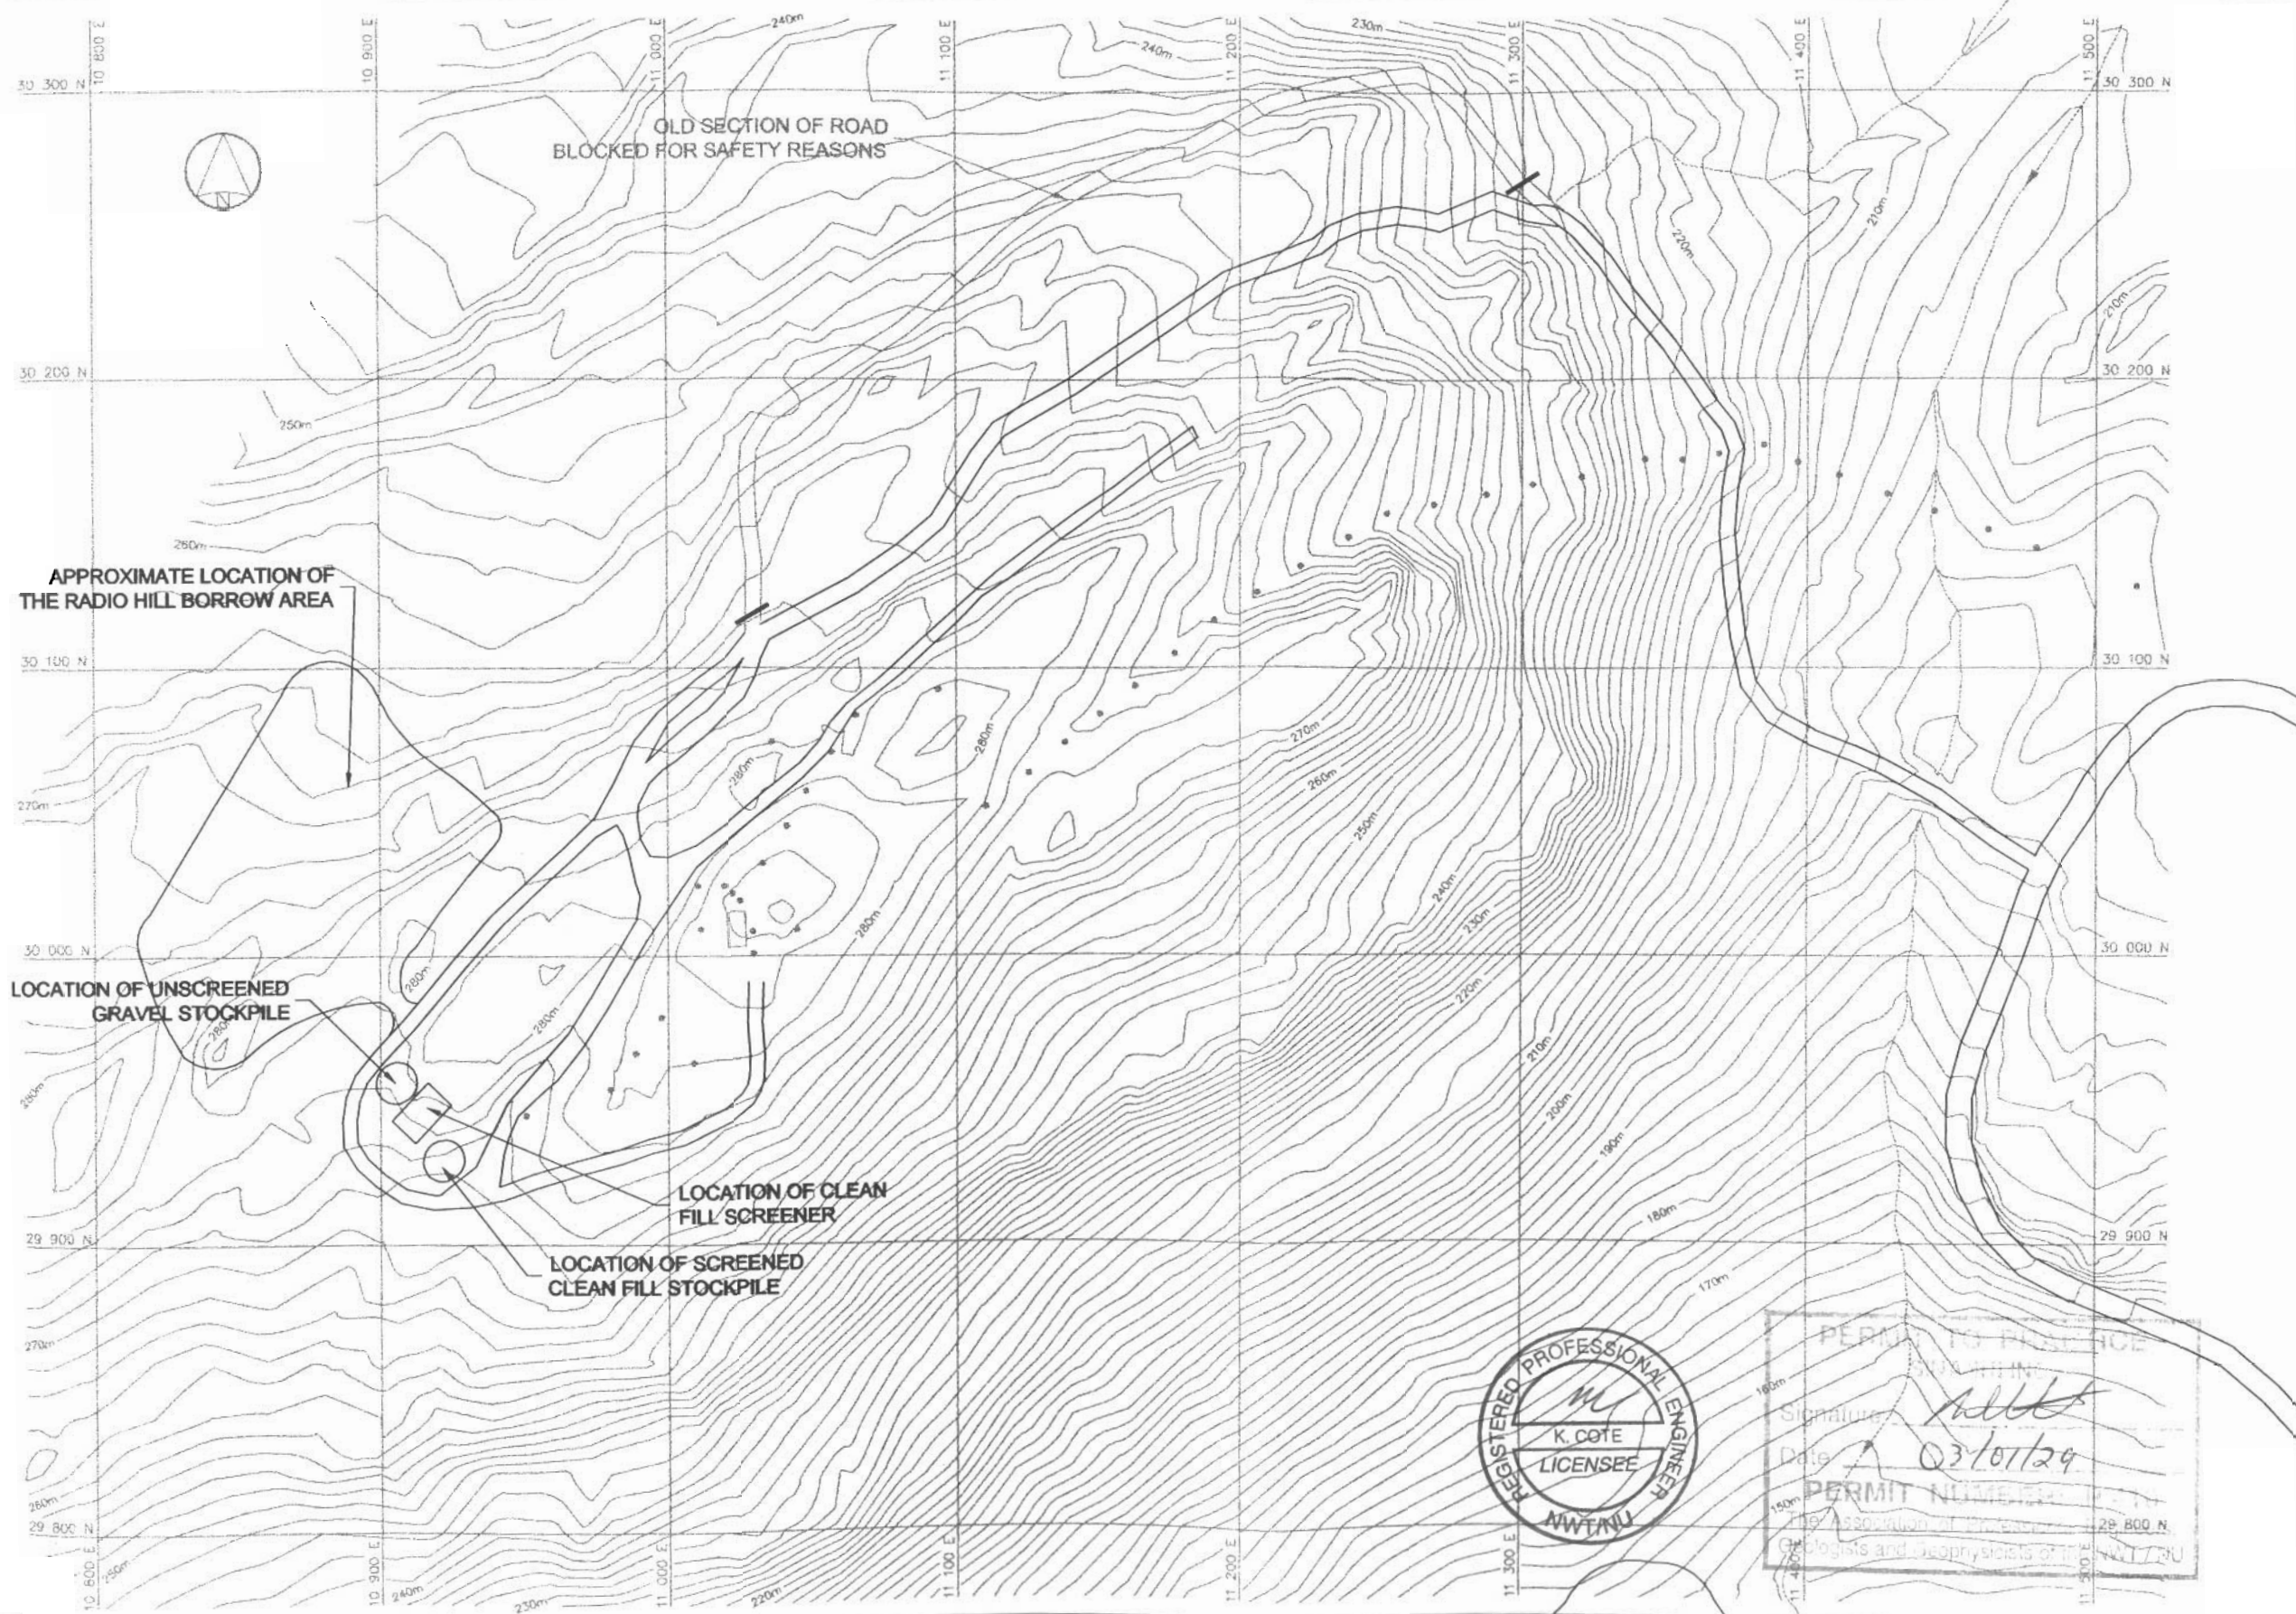


INDIAN AND NORTHERN AFFAIRS CANADA			
NUNAVUT REGIONAL OFFICE			
General Notes:			
Legend: - NON-HAZARDOUS WASTE - ASBESTOS LANDFILL			
Sinanni Inc.			
SCALE - ÉCHELLE: 1:5000			
PROJECT - PROJET: BAF-5 RESOLUTION ISLAND			
© COPYRIGHT HER MAJESTY THE QUEEN IN THE RIGHT OF CANADA 2002, AS REPRESENTED BY INDIAN AND NORTHERN AFFAIRS CANADA			
TRADE - MÉTIER:	SITING	DATE: 2002-11-28	
SUBJECT - SUJET: GENERAL LAYOUT OF, AND MODIFICATIONS MADE TO, THE BEACH AREA			
DESIGNED: ÉTUDE:	CONCURRENCE - ASSENTIMENT: P.S.		
DRAWN: Dessiné:	G.J.		
CHECKED: Vérifié:	K.C.		
COORDINATION:	REVIEWED - REVU:		
DWG. NO. - Dessin NO.: AB-2002-102-05			

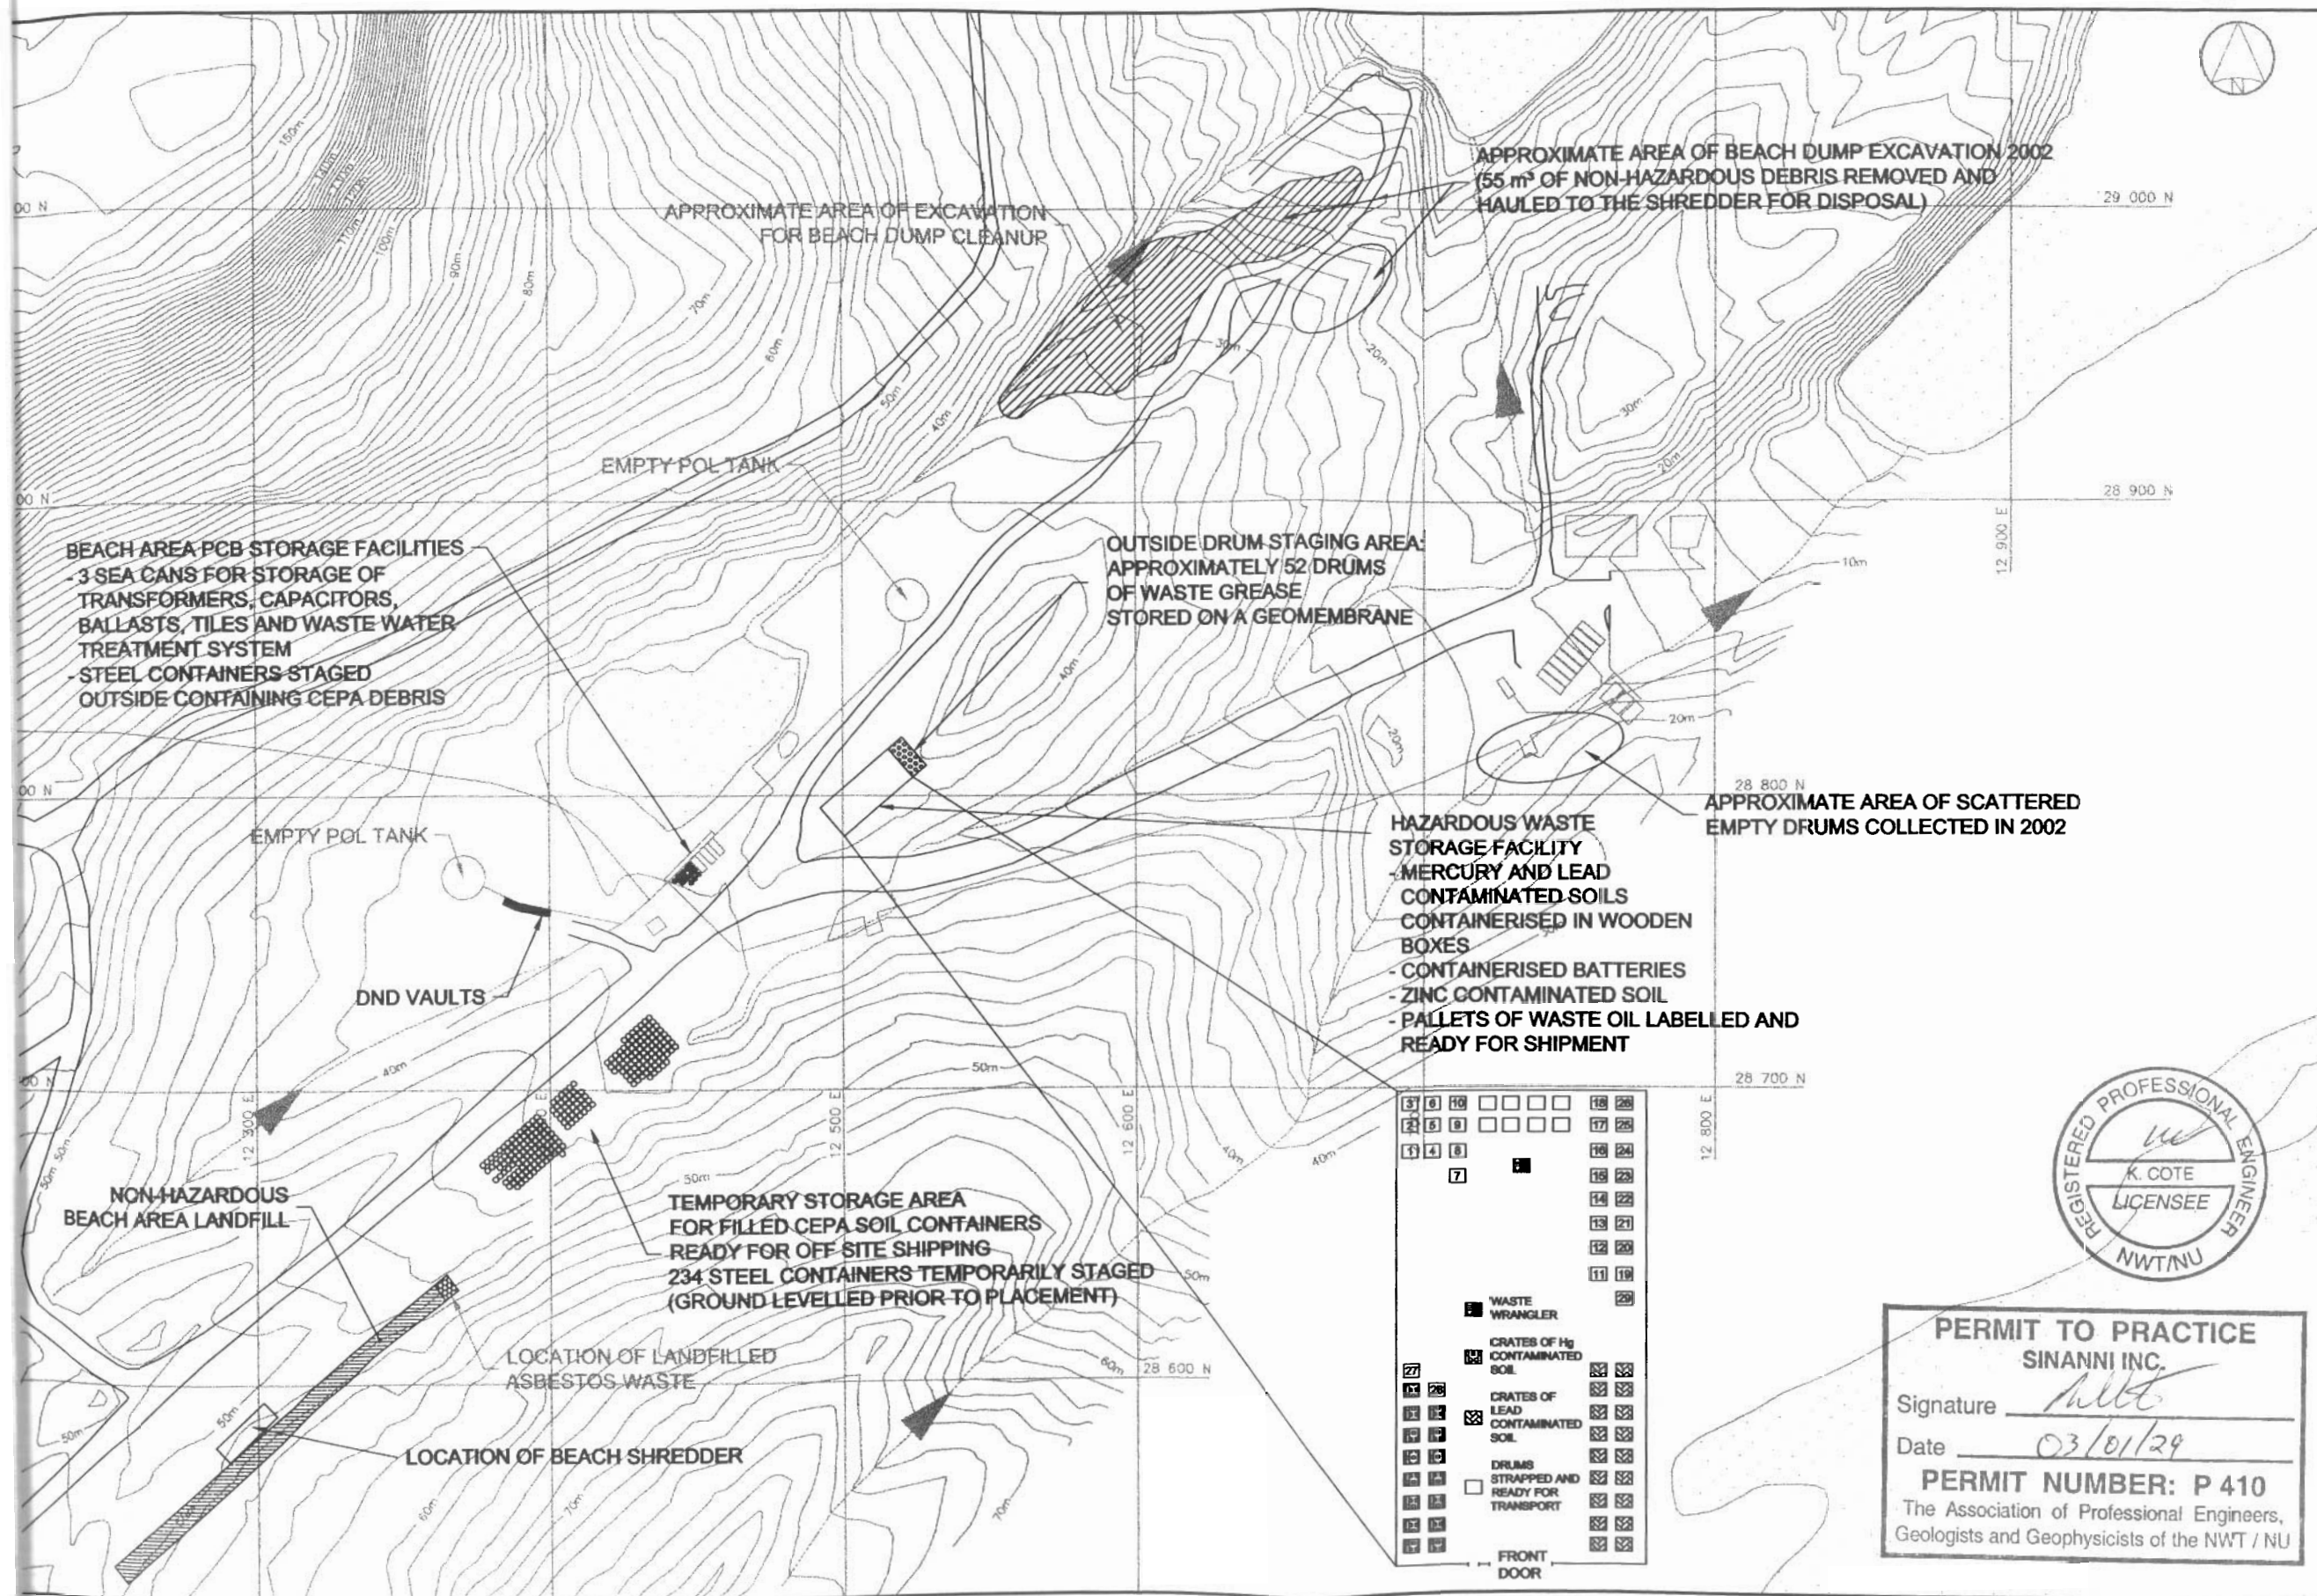


PERMIT TO PRACTICE SINANNI INC.	
Signature	
Date	03/01/29
PERMIT NUMBER: P 410 The Association of Professional Engineers, Geologists and Geophysicists of the NWT / NU	

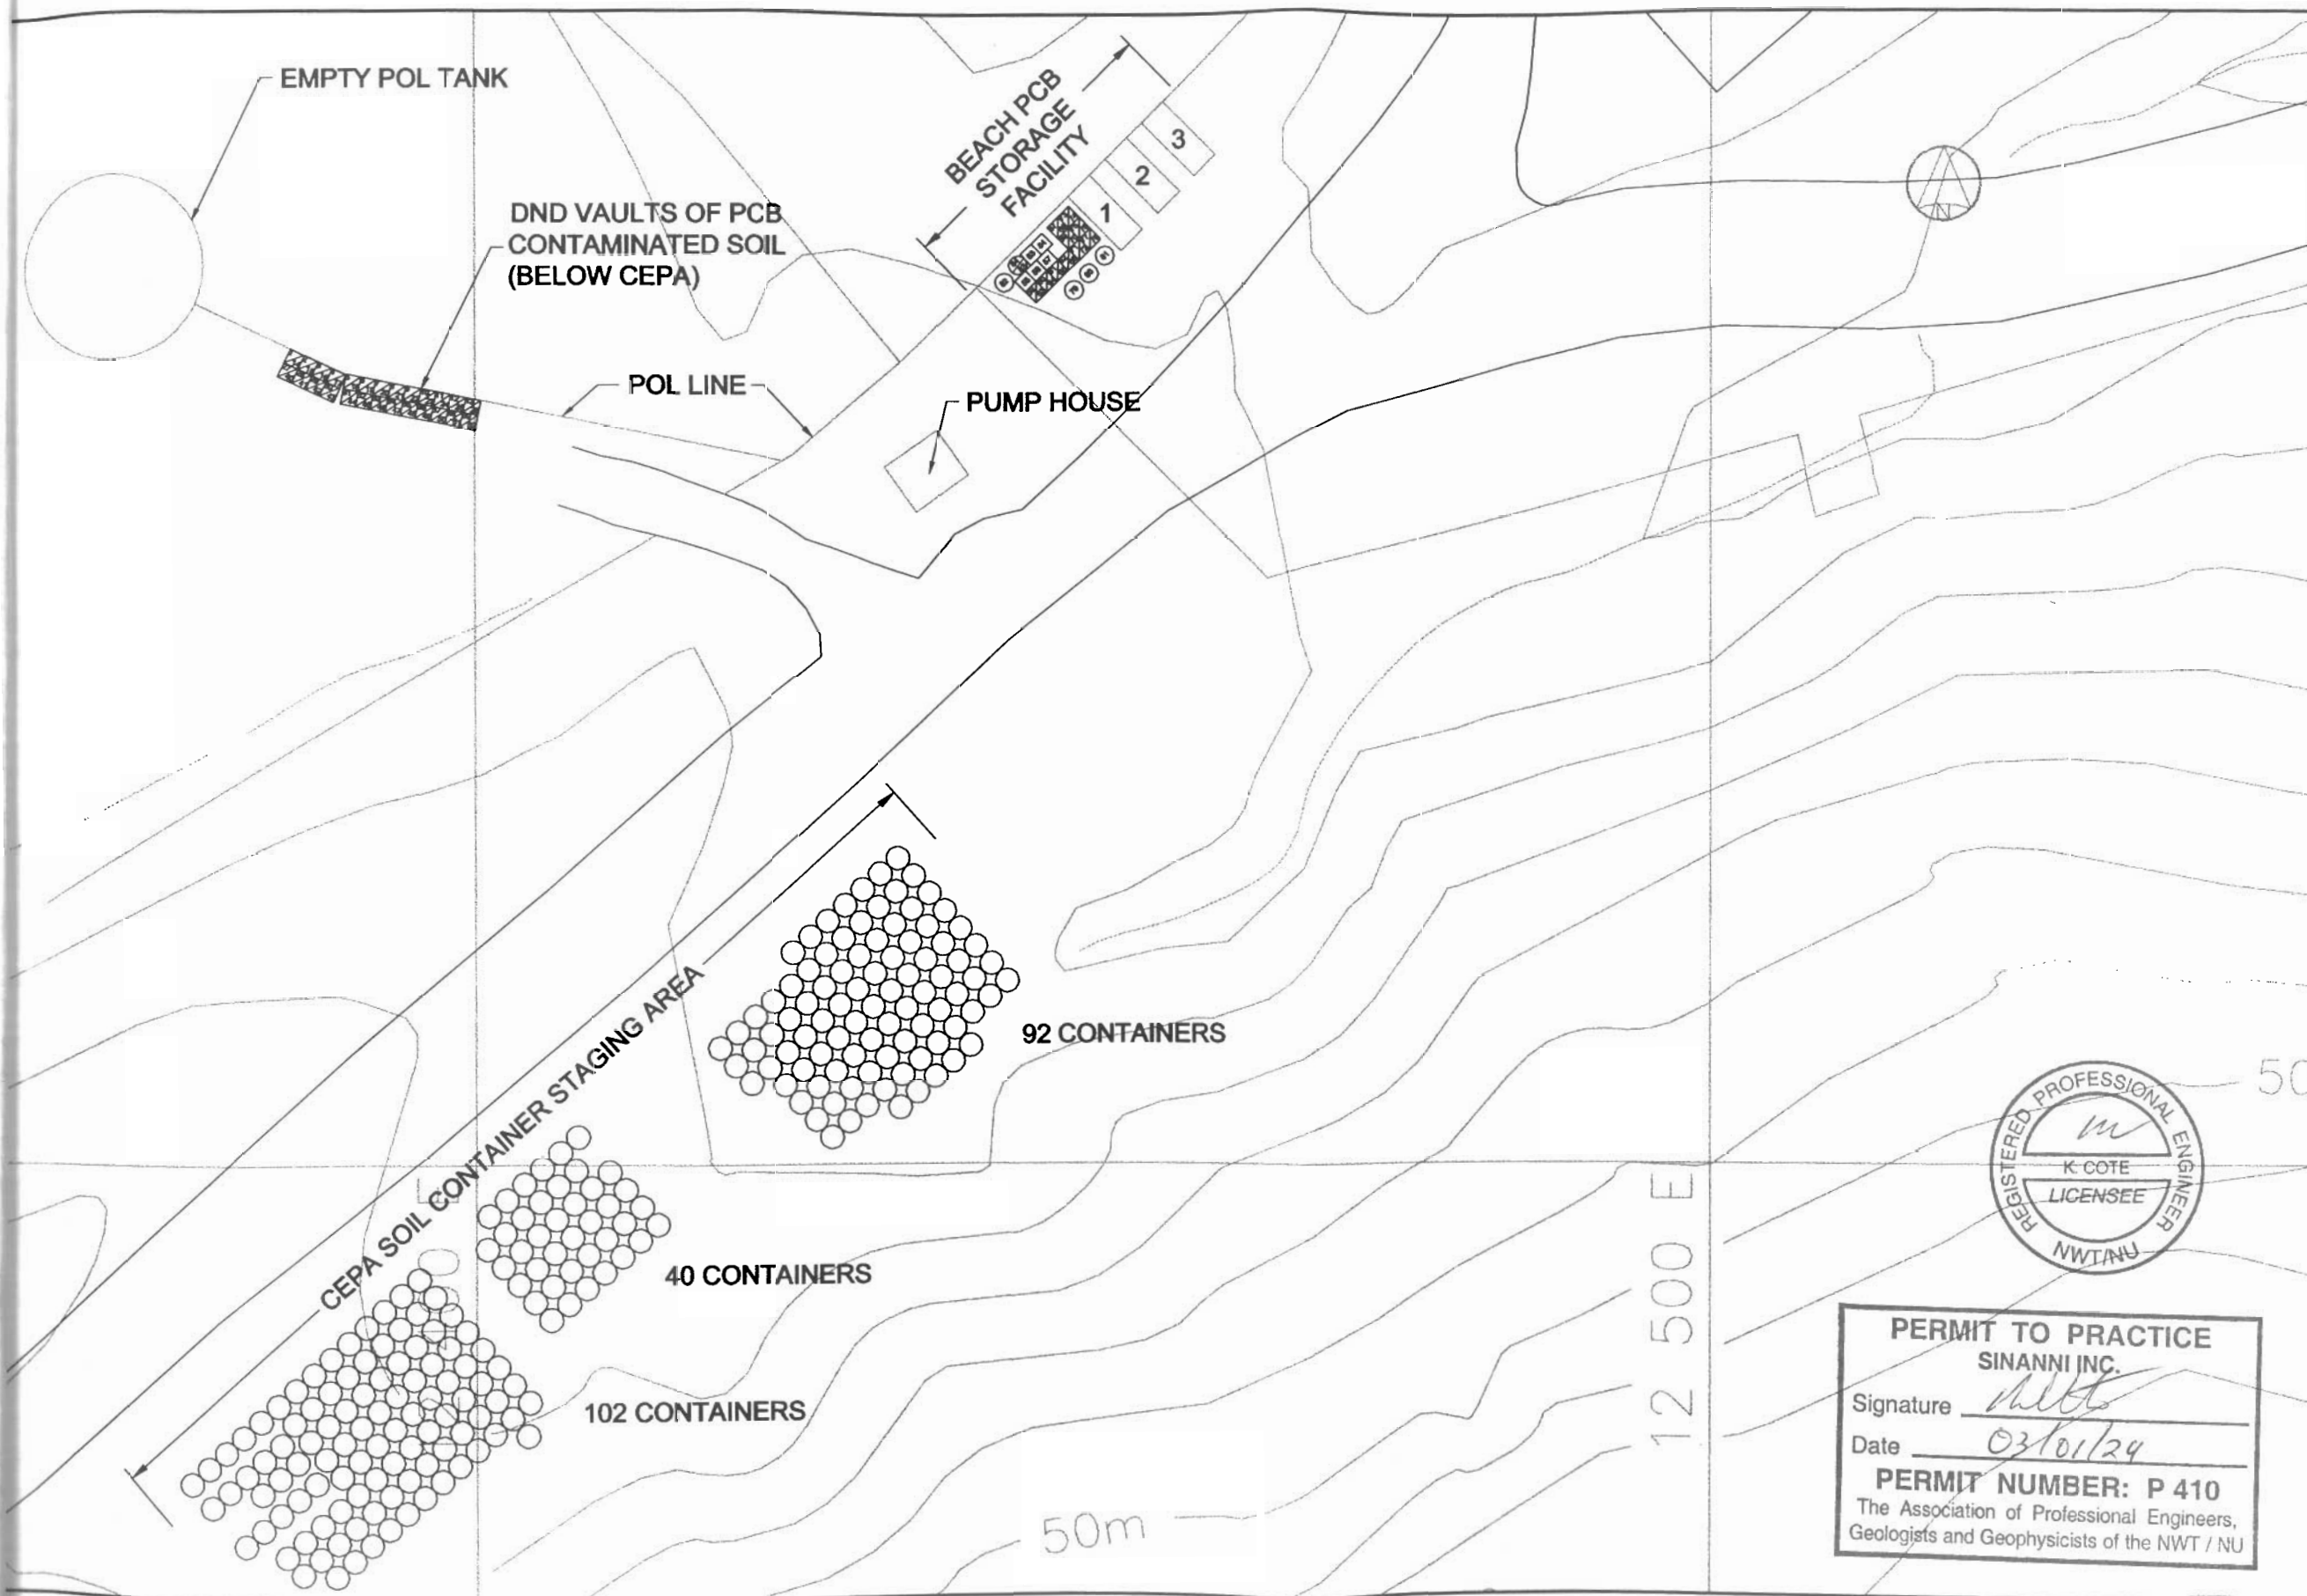


INDIAN AND NORTHERN AFFAIRS CANADA									
NUNAVUT REGIONAL OFFICE									
General Notes:									
Legend:									
<table border="1"> <tr> <th>NO.</th> <th>DATE</th> <th>REVISION</th> <th>APPR.</th> </tr> <tr> <td> </td> <td> </td> <td> </td> <td> </td> </tr> </table>	NO.	DATE	REVISION	APPR.					Sinanni Inc. SCALE - ECHELLE 1:25,000
NO.	DATE	REVISION	APPR.						
PROJECT - PROJET BAF-5 RESOLUTION ISLAND									
© COPYRIGHT HER MAJESTY THE QUEEN IN THE RIGHT OF CANADA 2002, AS REPRESENTED BY INDIAN AND NORTHERN AFFAIRS CANADA									
TRADE - METIER SITING	DATE 2002-11-28								
SUBJECT - SUJET BEACH WASTE STORAGE AND STAGING AREAS									
PRODUCTION DESIGNED DRAWN CHECKED COORDINATION	CONCURRENCE - ASSENTIMENT P.S. G.J. K.C. REVIEWED - REVU								
DWG. NO. - DESIGN NO. AB-2002-102-07									

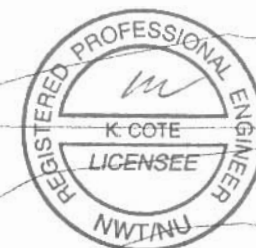


PERMIT TO PRACTICE
SINANNI INC.
 Signature [Signature]
 Date 03/01/24
PERMIT NUMBER: P 410
 The Association of Professional Engineers,
 Geologists and Geophysicists of the NWT / NU

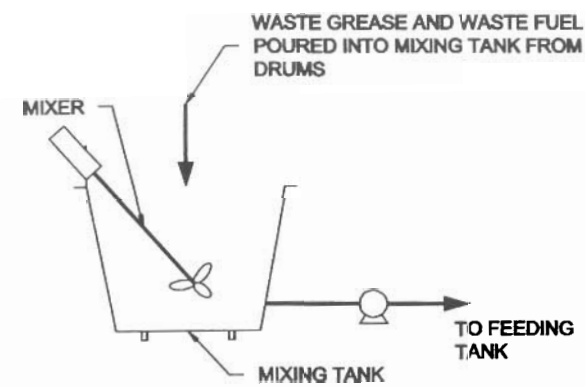


CROSS SECTION C - C'
WASTE GREASE PROCESSING PLATFORM
(NOT TO SCALE)

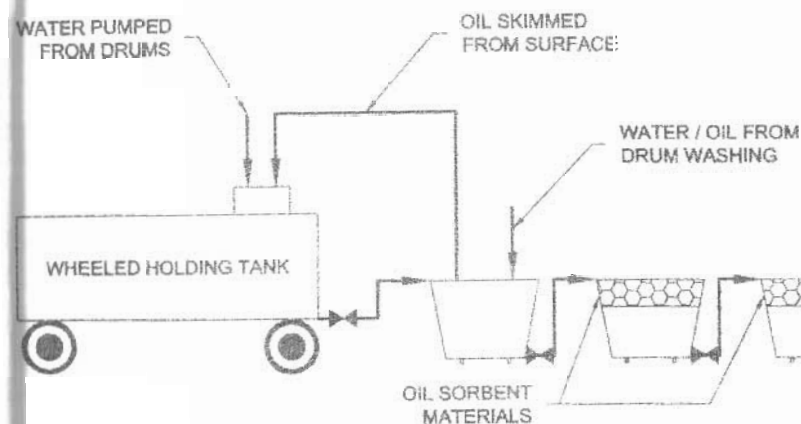

CROSS SECTION A - A'
OIL / WATER SEPARATION SYSTEM
(NOT TO SCALE)

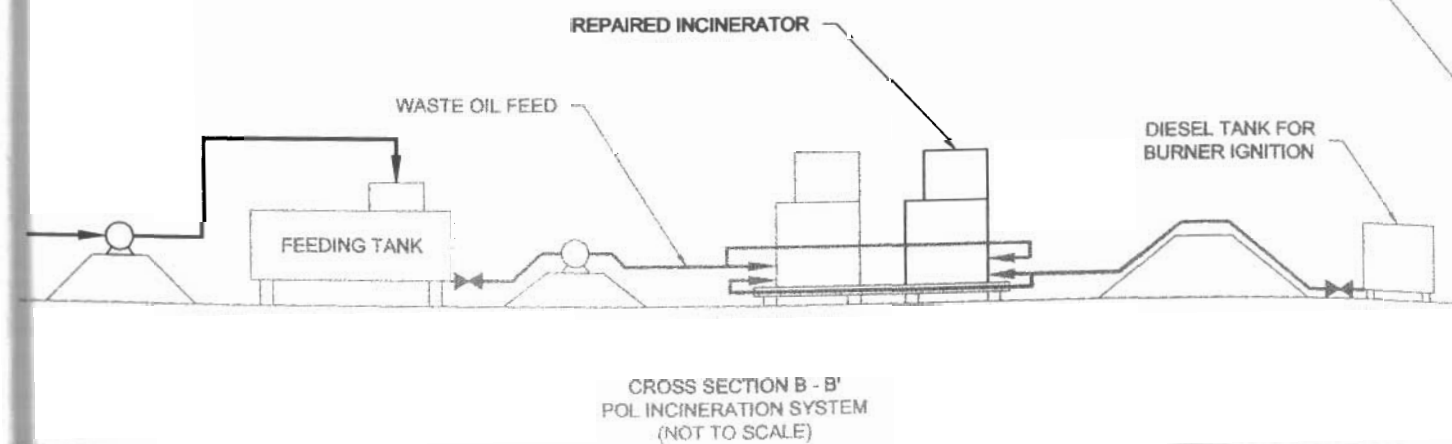

CROSS SECTION B - B'
POL INCINERATION SYSTEM
(NOT TO SCALE)

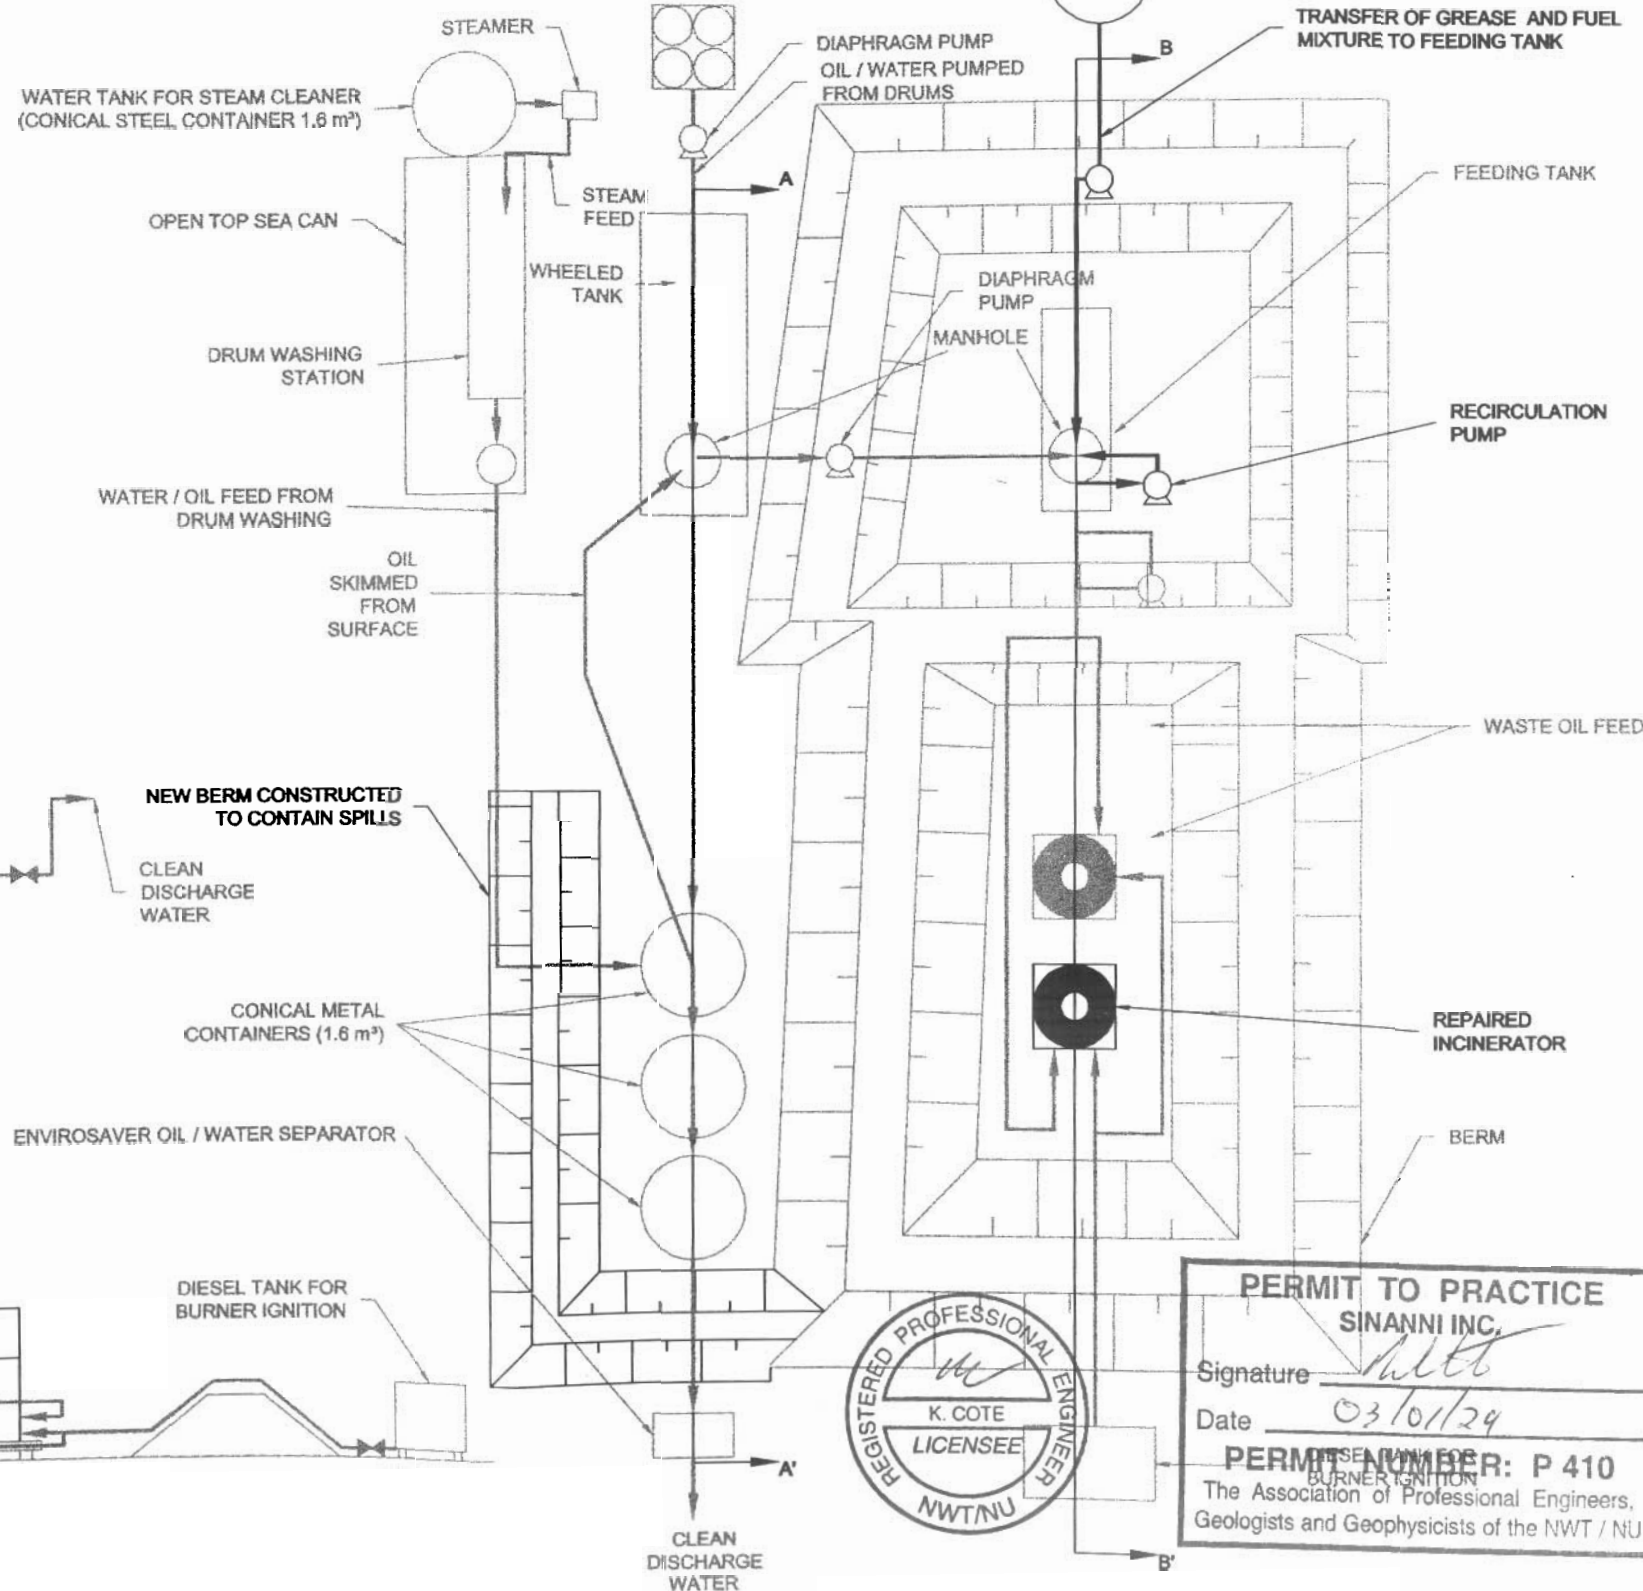

PERMIT TO PRACTICE
SINANNI INC.


Signature *[Signature]*

Date 03/01/24

PERMIT NUMBER: P 410

THE ASSOCIATION OF PROFESSIONAL ENGINEERS,
GEOLOGISTS AND GEOPHYSICISTS OF THE NWT / NU

INDIAN AND NORTHERN AFFAIRS CANADA				
NUNAVUT REGIONAL OFFICE				
General Notes:				
Legend: OIL SORBENT MATERIAL				
Sinanni INC.				
SCALE - SCHÉLLE 				
PROJECT - PROJET BAF-5 RESOLUTION ISLAND				
© COPYRIGHT HER MAJESTY THE QUEEN IN THE RIGHT OF CANADA 2002, AS REPRESENTED BY INDIAN AND NORTHERN AFFAIRS CANADA				
TRACE - METIER SITING	DATE 2002-11-28			APPROVAL
SUBJECT - SUJET MODIFICATIONS MADE TO THE INCINERATION PLATFORM				
PRODUCTION DESIGNED DRAWN CHECKED COORDINATION	CONCURRENCE - ASSENTIMENT P.S. G.J. K.C. REVIEWED - REVU			
DRAFT NO. - DÉSIN NO. AS-2002-102-08				

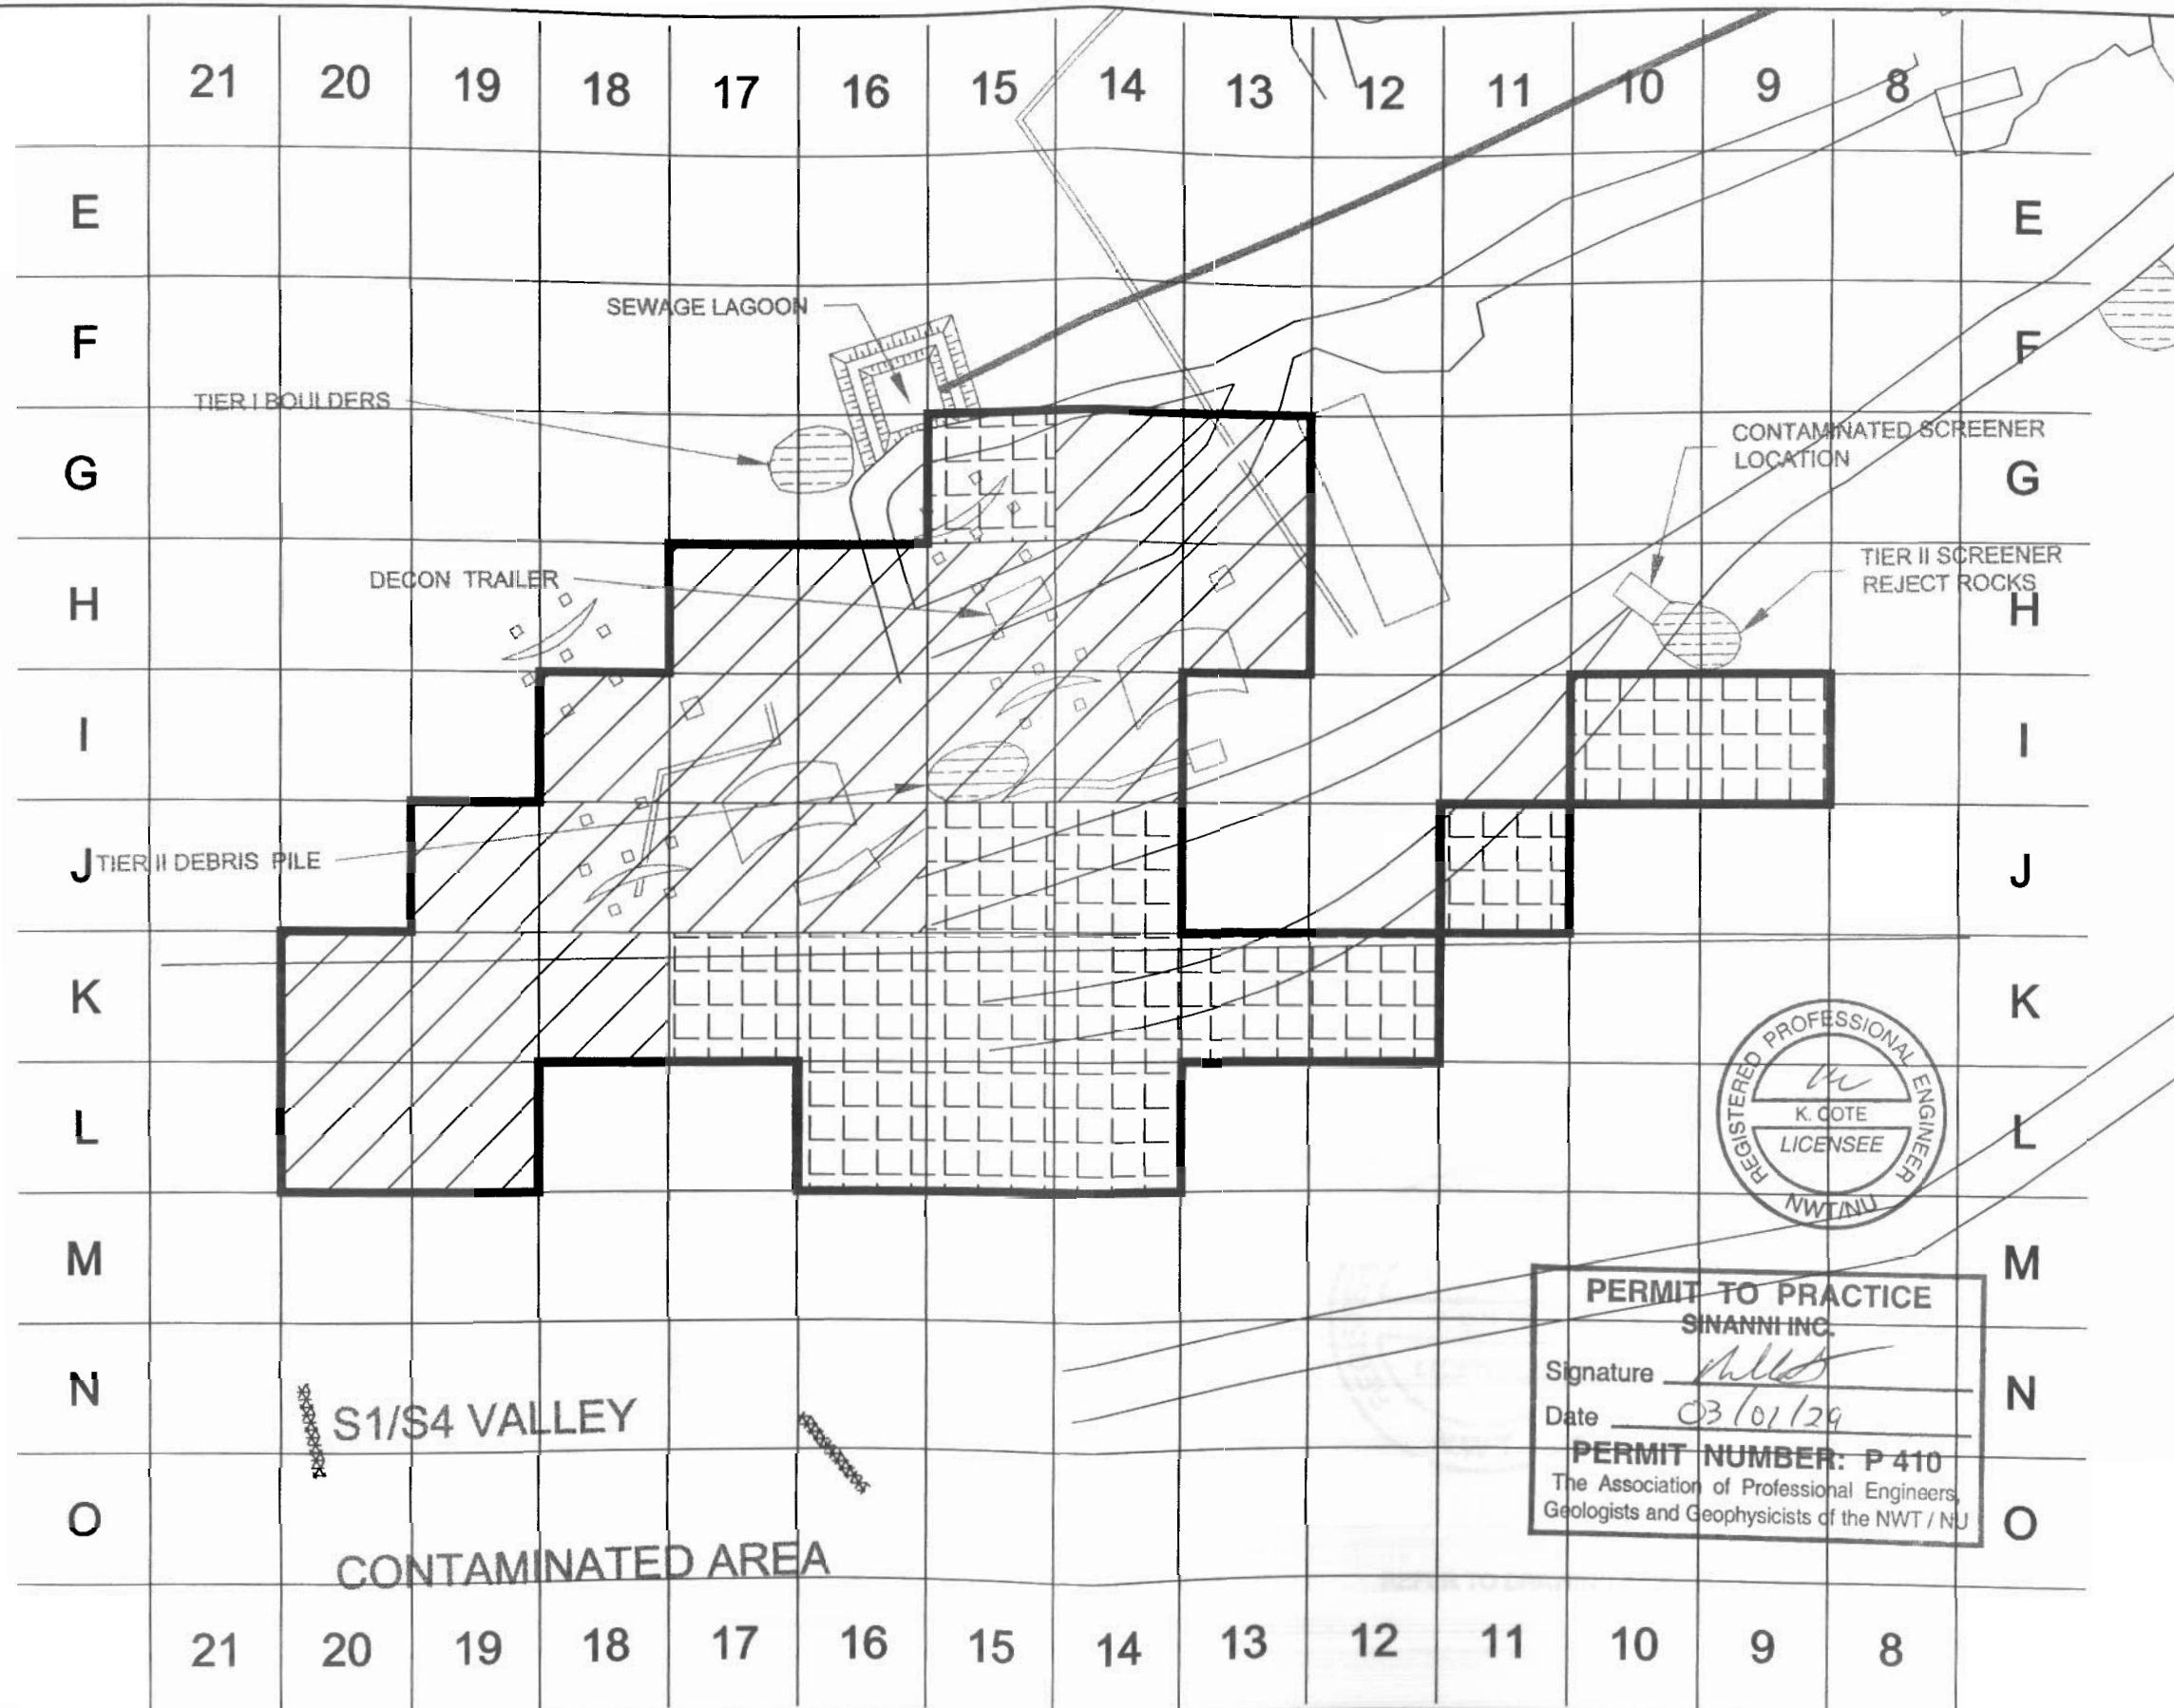

INDIAN AND NORTHERN AFFAIRS CANADA

NUNAVUT REGIONAL OFFICE

GENERAL NOTES:
 1. LOCATION OF CEPA SOILS WITHIN GRIDS IS PRESENTED IN ASU REPORT 2001 & 2002.

LEGEND:

- DECONTAMINATED GRID AREA 2001
- DECONTAMINATED GRID AREA 2002
- CONTAINMENT BARRIER

NO.	DATE	REVISION	REVISION	APPR.
Sinanni Inc.				
PROJECT - PROJECT BAF-5 RESOLUTION ISLAND				
© COPYRIGHT HER MAJESTY THE QUEEN IN THE RIGHT OF CANADA 2002, AS REPRESENTED BY INDIAN AND NORTHERN AFFAIRS CANADA				
TRADE - METTER	SITING		DATE 2002-11-28	
SUBJECT - SUBJECT				
S1/S4 BUILDING AND DRAINAGE AREA GRIDDING SYSTEM				
PRODUCTION		CONCURRENCE - AGREEMENT		
DESIGNED ETUDE	P.S.			
DRAWN DESSINE	G.J.			
CHECKED VERIFIE	K.C.			
COORDINATION	REVIEWED - REVU			
DWG. NO. - DESIGN NO. AB-2002-102-08				

PERMIT TO PRACTICE
SINANNI INC.

Signature [Signature]
 Date 03/01/29

PERMIT NUMBER: P 410
 The Association of Professional Engineers,
 Geologists and Geophysicists of the NWT / NU

