

INDIAN AND NORTHERN AFFAIRS CANADA

NUNAVUT REGIONAL OFFICE

GENERAL NOTES:
1. LOCATION OF CEPA SOILS WITHIN GRIDS IS PRESENTED IN ASU REPORT 2001, 2002 & 2003.

LEGEND:
 DECONTAMINATED GRID AREA 2001
 DECONTAMINATED GRID AREA 2002
 DECONTAMINATED GRID AREA 2003
 CONTAINMENT BARRIER

No.	DATE	REVISION	REVISION	APPR.

Sinanni Inc.
SCALE - ECHELLE 10 5 0 10 20 30 m

PROJECT - PROJET
BAF-5 RESOLUTION ISLAND

© COPYRIGHT HER MAJESTY THE QUEEN IN THE RIGHT OF CANADA 2003, AS REPRESENTED BY INDIAN AND NORTHERN AFFAIRS CANADA


TRADE - METIER	SITING	DATE
		2003-02-02

SUBJECT - SUJET
S1/S4 BUILDING AND DRAINAGE AREA GRIDDING SYSTEM

PRODUCTION	CONCURRENCE - AGREEMENT
DESIGNED ETUDE	P.S.
DRAWN DESSINE	G.J.
CHECKED VERIFIE	K.C.
COORDINATION	REVIEWED - REVU

DWG. NO. - DESIGN NO.
AB-2002-102-08

PERMIT TO PRACTICE
SINANNI INC.
Signature *[Signature]*
Date *04/02/25*
PERMIT NUMBER: P 410
The Association of Professional Engineers, Geologists and Geophysicists of the NWT / NU

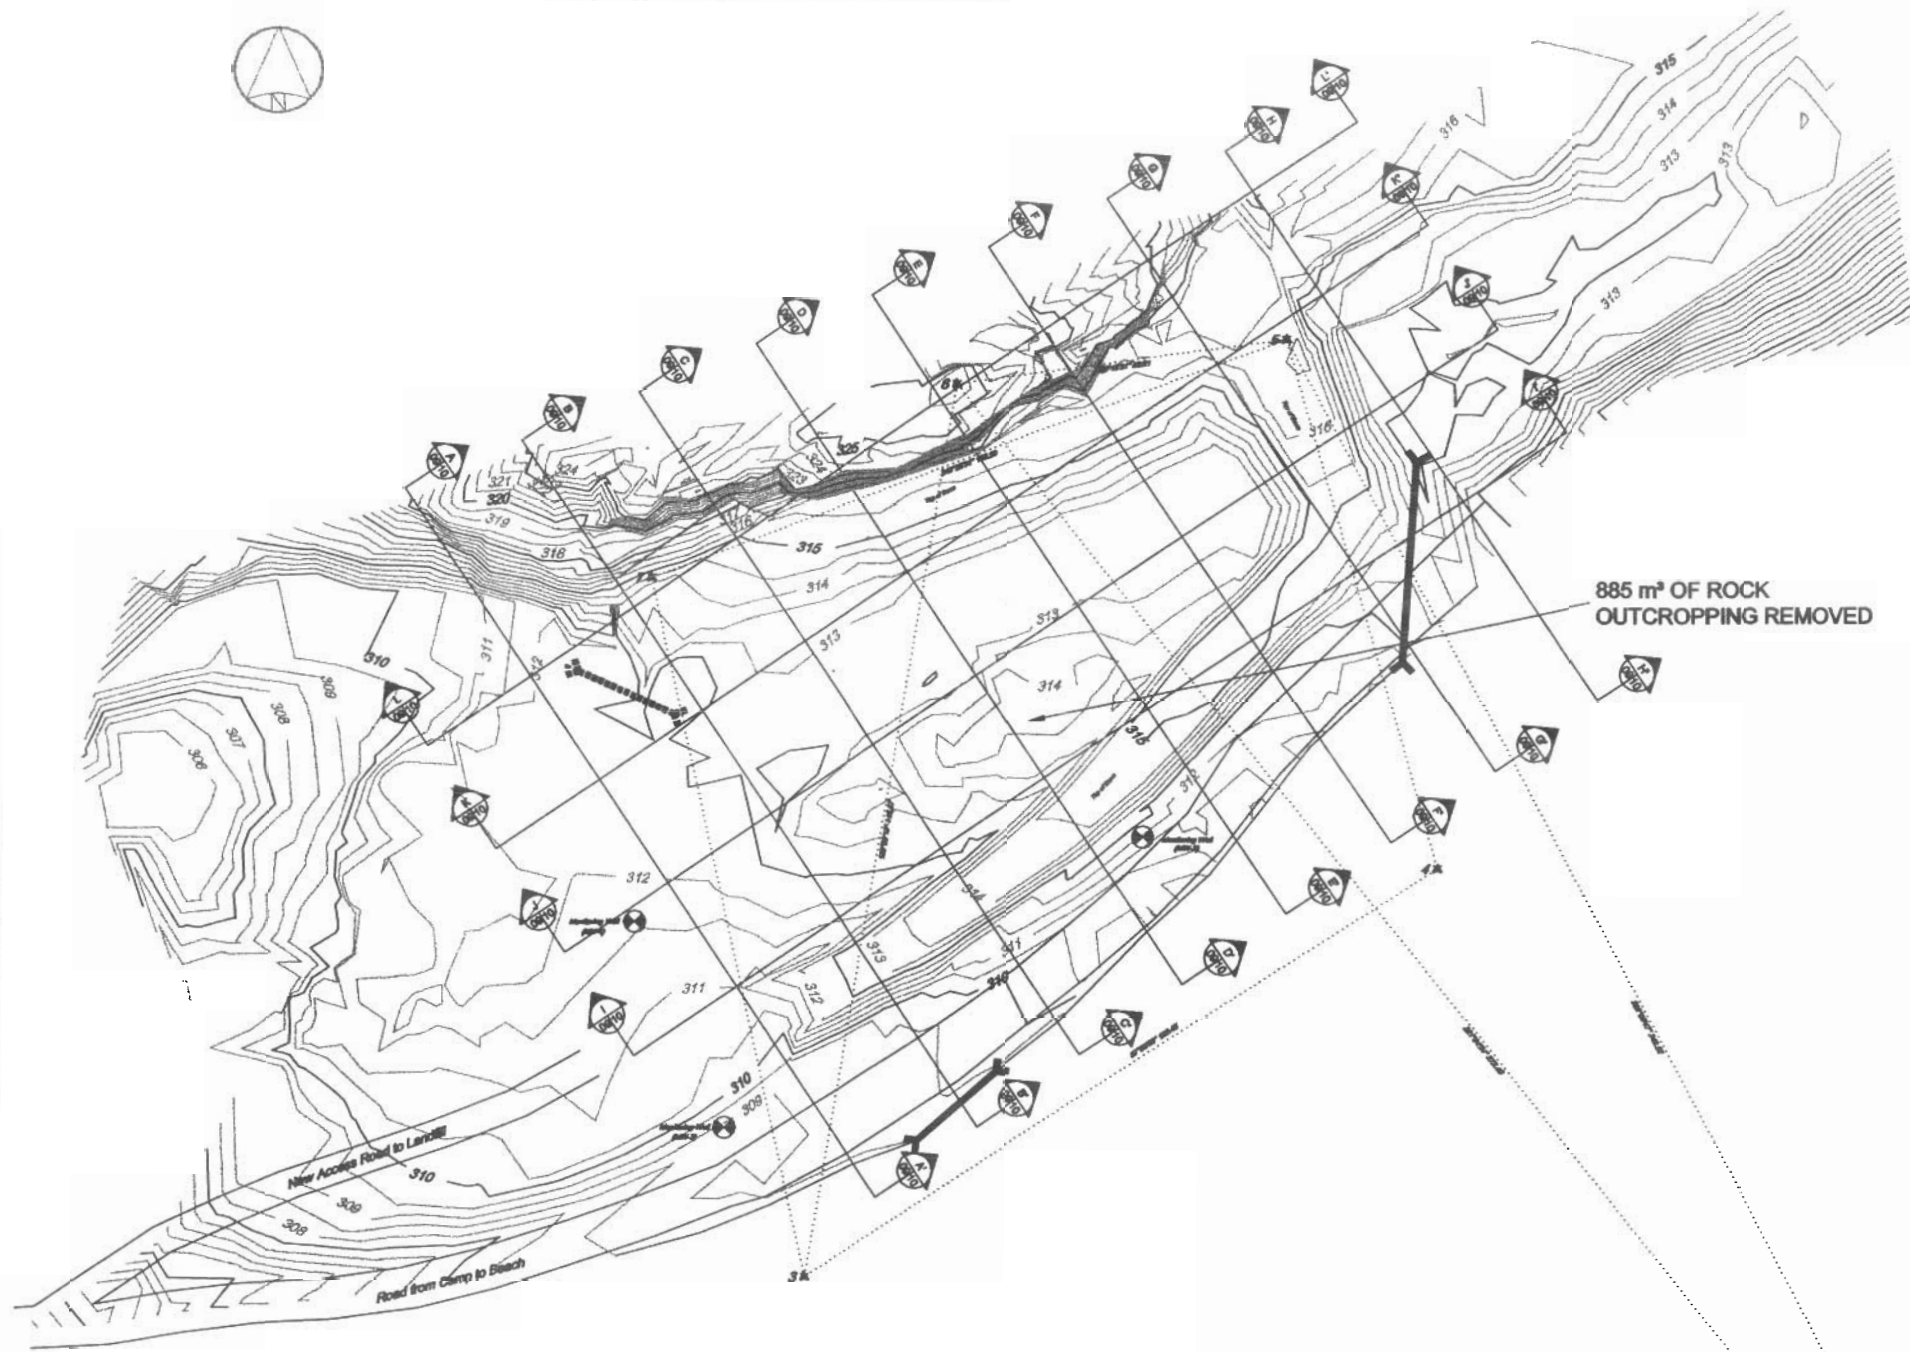

PERMIT TO PRACTICE
SINANNI INC.
Signature [Signature]
Date 04/02/25
PERMIT NUMBER: P 410
The Association of Professional Engineers,
Geologists and Geophysicists of the NWT / NU

INDIAN AND NORTHERN AFFAIRS CANADA

NUNAVUT REGIONAL OFFICE

General Notes:

1. DUE TO DIFFICULTY IN LOCATING ACCURATE BENCH MARK DATA ELEVATIONS AND CO-ORDINATES OF BENCHMARKS AND MONITORING WELLS RELATED TO UTM WILL BE FINALISED DURING THE 2004 WORK SEASON.
2. BENCH MARKS 1 AND 2 ARE MEDALLIONS SET IN BEDROCK.
3. BENCHMARKS 3, 4, 5, 6 AND 7 ARE A CROSS CHISELLED INTO BEDROCK WITH A 3/8 INCH HOLE DRILLED IN THE MIDDLE.

Legend:

- MONITORING WELL LOCATION
- PERMANENT CULVERT
- TEMPORARY CULVERT

NO.	DATE	REVISION	REVISION	APPR.

Sinanni INC.

SCALE - ECHELLE 10 5 0 5 10 20 30 m

PROJECT - PROJET
BAF-5 RESOLUTION ISLAND

© COPYRIGHT HER MAJESTY THE QUEEN
IN THE RIGHT OF CANADA 2004,
AS REPRESENTED BY INDIAN AND
NORTHERN AFFAIRS CANADA


TRADE - METIER	SITING	DATE
		2004-01-30

SUBJECT - SUJET


SURVEYOR DRAWING OF THE TIER II LANDFILL AREA

PRODUCTION	CONCURRENCE - ASSISEMENT
DESIGNED ETUDE	G.J.
DRAWN DESSINE	G.J.
CHECKED VERIFIE	K.C.
COORDINATION	REVIEWED - REVU P.S.


DWG. NO. - DESSIN NO.
AB-2003-102-09

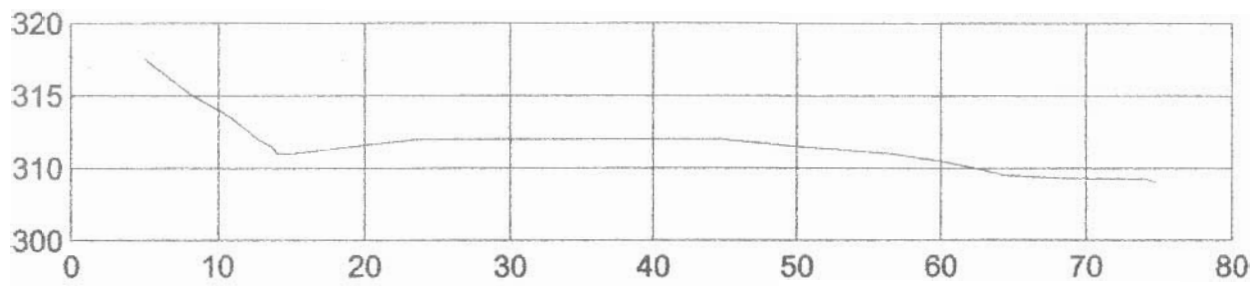


A-A'
09/10

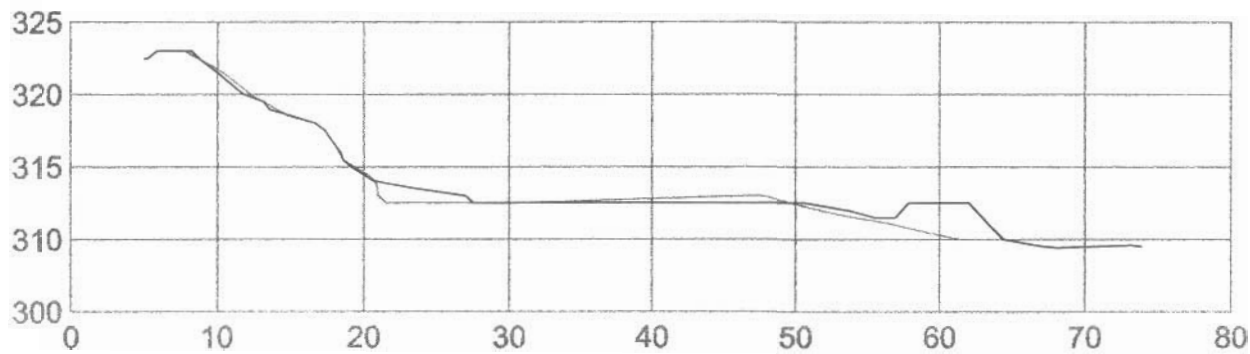


B-B'
09/10

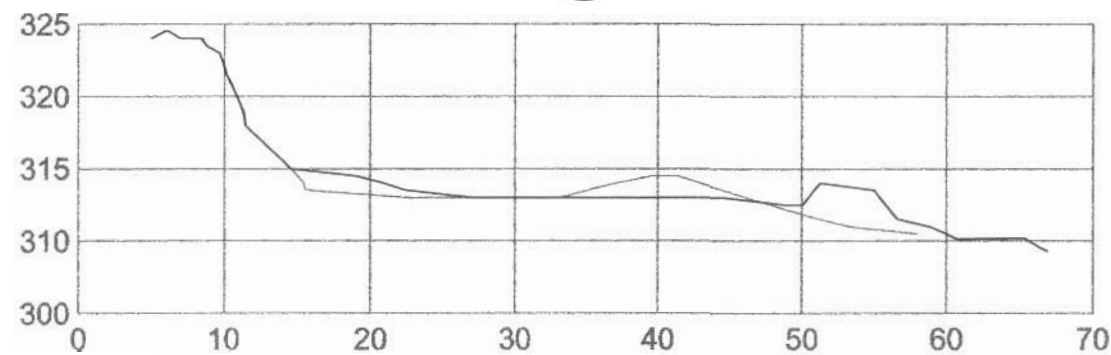


C-C'
09/10

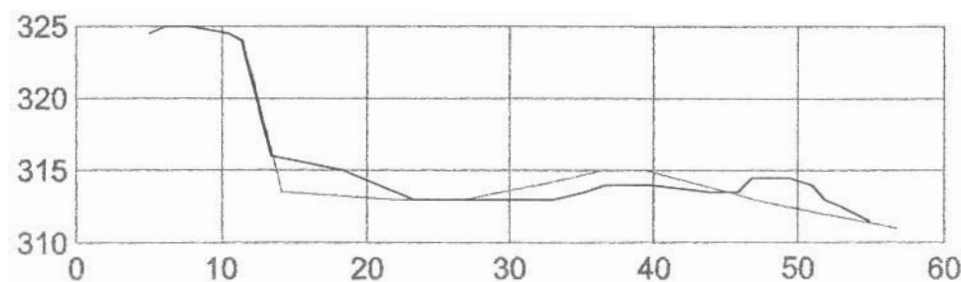


D-D'
09/10

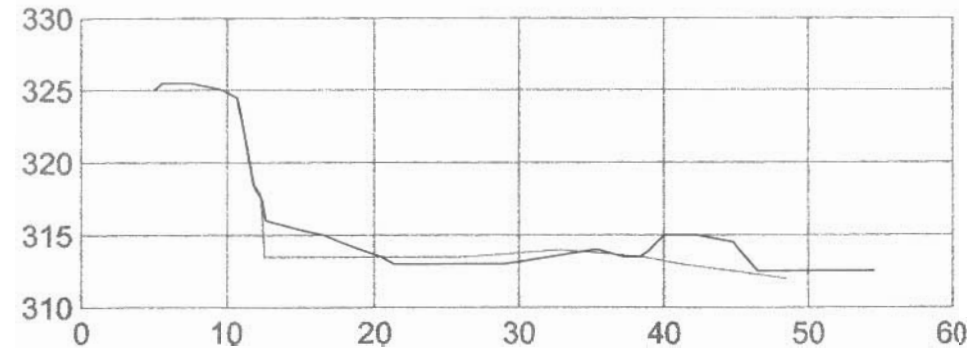


E-E'
09/10

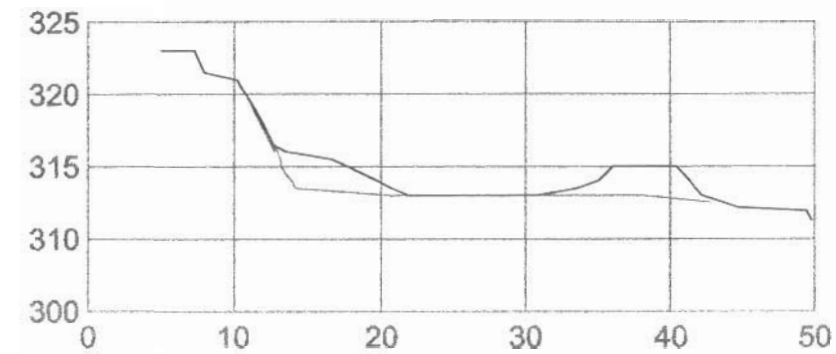

F-F'
09/10

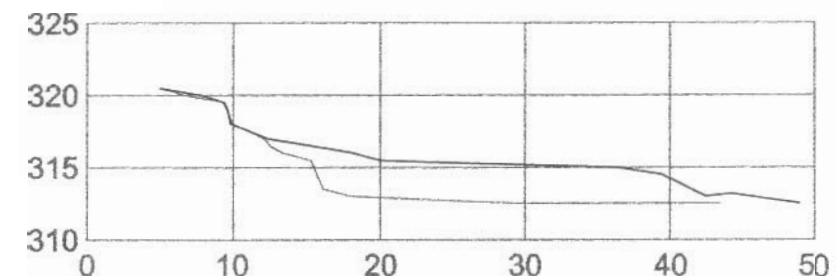

G-G'
09/10

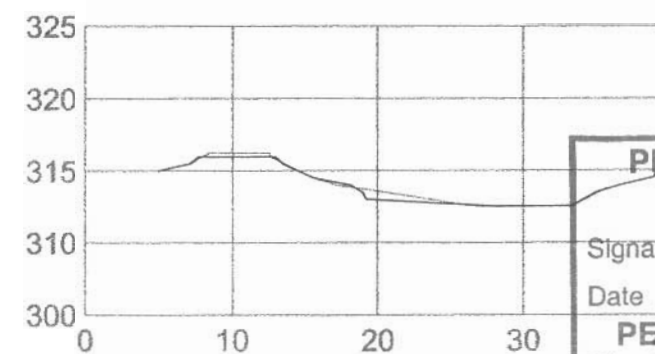

H-H'
09/10



PERMIT TO PRACTICE
SINANNI INC.
Signature *[Signature]*
Date 24/02/25
PERMIT NUMBER: P 410
The Association of Professional Engineers,
Geologists and Geophysicists of the NWT / NU

General Notes:
1. GREY LINES REPRESENT NATURAL GROUND ELEVATION. BLACK LINES REPRESENT THE GROUND ELEVATIONS AT THE END OF THE 2003 WORK SEASON.
2. NO SOIL WAS PLACED ALONG CROSS-SECTION A-A' DURING THE 2003 WORK SEASON, THUS THIS LINE REPRESENTS BOTH THE NATURAL GROUND ELEVATION, AND THE GROUND ELEVATION AT THE END OF THE 2003 WORK SEASON.

Legend:

REV.	DATE	REVISION	REVISION	APPROV.
<div><div>ᑭᑭᑭᑭᑭᑭᑭᑭ ᑭᑭᑭᑭᑭᑭᑭᑭ QRIQTAALLIK CORPORATION</div></div> <div><div>Sinanni Inc.</div></div>				
SCALE - ÉCHELLE AS SHOWN				
PROJECT - PROJET BAF-5 RESOLUTION ISLAND				
© COPYRIGHT HER MAJESTY THE QUEEN IN THE RIGHT OF CANADA 2004, AS REPRESENTED BY INDIAN AND NORTHERN AFFAIRS CANADA				
TRACE - MÉTRER SITING			DATE 2004-01-30	
SUBJECT - SUJET CROSS-SECTIONS OF THE TIER II LANDFILL (DRAWING 1 OF 2)				
PRODUCTION		CONCURRENCE - ASSENTIMENT		
DESIGNED ÉTUDE		G.J.		
DRAWN DESSINE		G.J.		
CHECKED VÉRIFIÉ		K.C.		
COORDINATION		REVIEWED - REVU P.S.		
DWG. NO. - DESSIN NO. AB-2003-102-10				
Canada				





INDIAN AND NORTHERN
AFFAIRS CANADA

NUNAVUT REGIONAL OFFICE

General Notes:
1. GREY LINES REPRESENT NATURAL GROUND
ELEVATION. BLACK LINES REPRESENT THE
GROUND ELEVATIONS AT THE END OF THE 2003
WORK SEASON.

Legend:

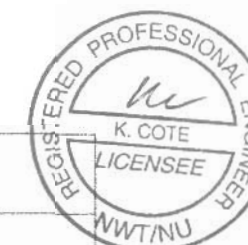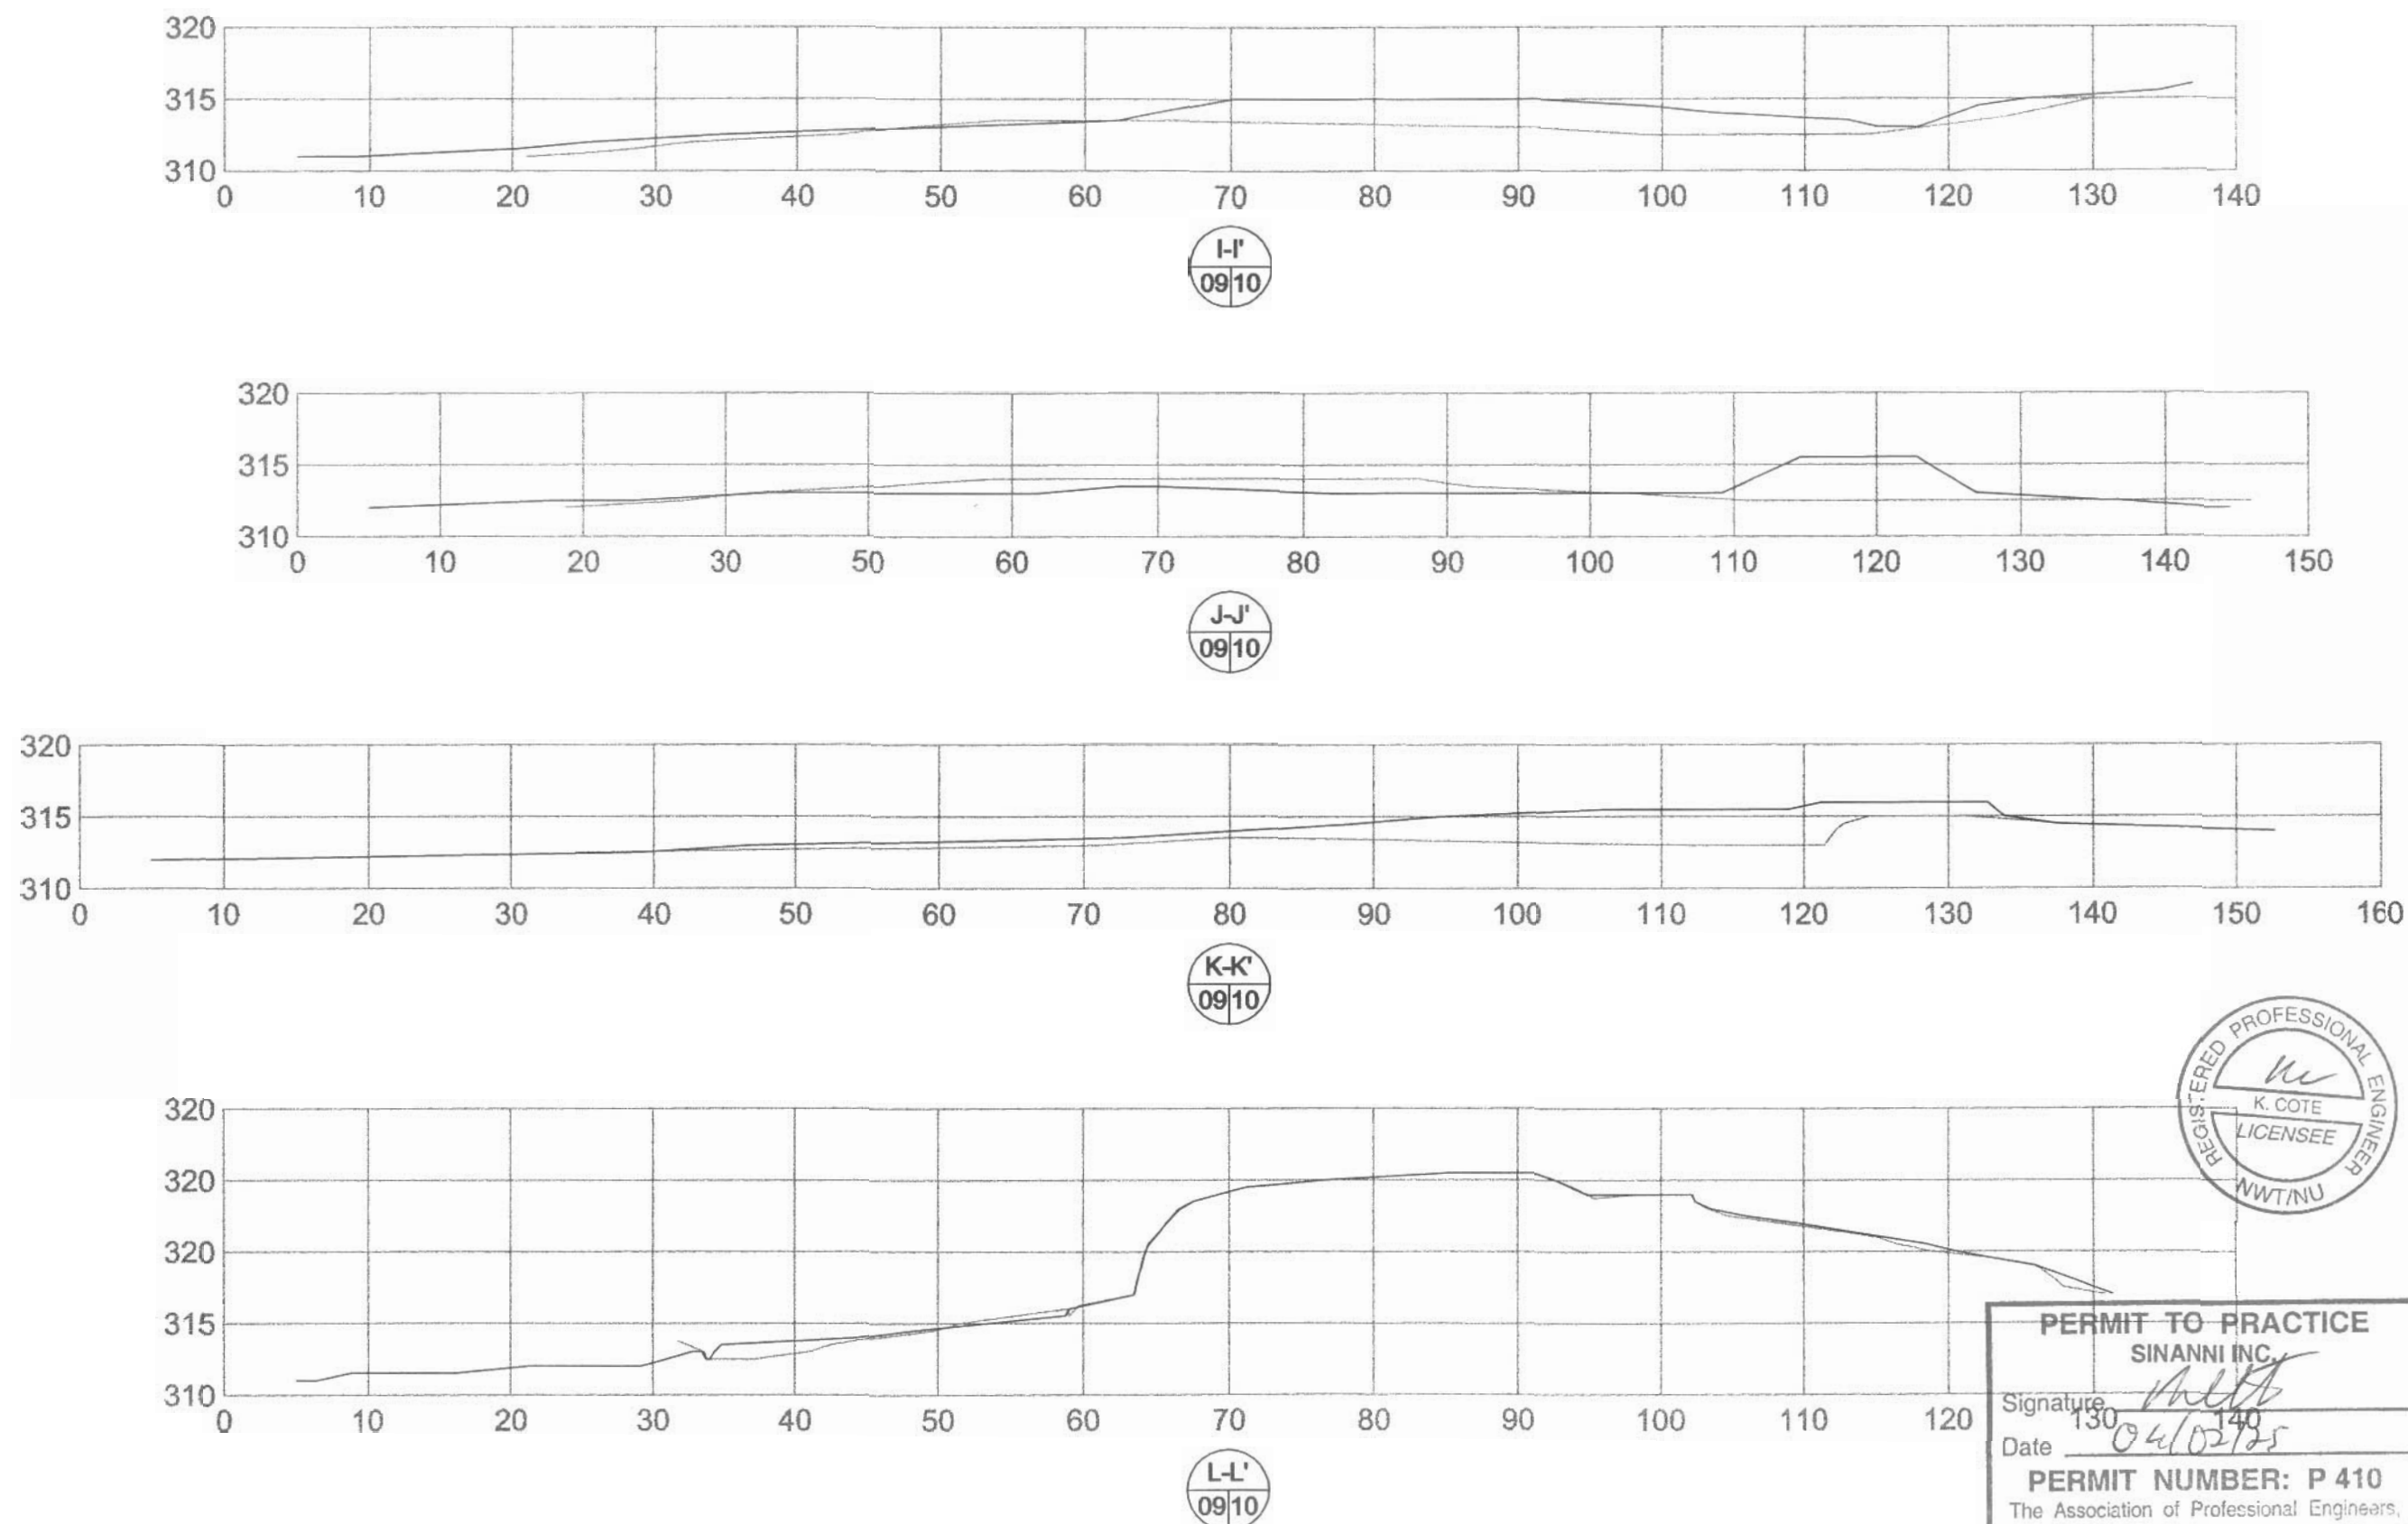

PERMIT TO PRACTICE
SINANNI INC.
Signature *[Signature]*
Date *04/02/25*
PERMIT NUMBER: P 410
The Association of Professional Engineers,
Geologists and Geophysicists of the NWT / NU

NO.	DATE	REVISION	REVISION	APPR.
SCALE - ÉCHELLE AS SHOWN				
PROJECT - PROJET BAF-5 RESOLUTION ISLAND				
© COPYRIGHT HER MAJESTY THE QUEEN IN THE RIGHT OF CANADA 2004, AS REPRESENTED BY INDIAN AND NORTHERN AFFAIRS CANADA				
TRADE - MÉTIER	SITING			DATE 2004-01-30
SUBJECT - SUJET CROSS-SECTIONS OF THE TIER II LANDFILL (DRAWING 2 OF 2)				
PRODUCTION		CONCURRENCE - ASSENTMENT		
DESIGNED ETUDIÉ	G.J.			
DRAWN DRESSÉ	G.J.			
CHECKED VÉRIFIÉ	K.C.			
COORDINATION	REVIEWED - REVU P.S.			
DWG. NO. - DESIGN NO. AS-2003-102-11				
Canada				




INDIAN AND NORTHERN
AFFAIRS CANADA

NUNAVUT REGIONAL OFFICE


General Notes:

1. GREY LINES REPRESENT NATURAL GROUND ELEVATION. BLACK LINES REPRESENT THE GROUND ELEVATIONS AT THE END OF THE 2003 WORK SEASON.


Legend:

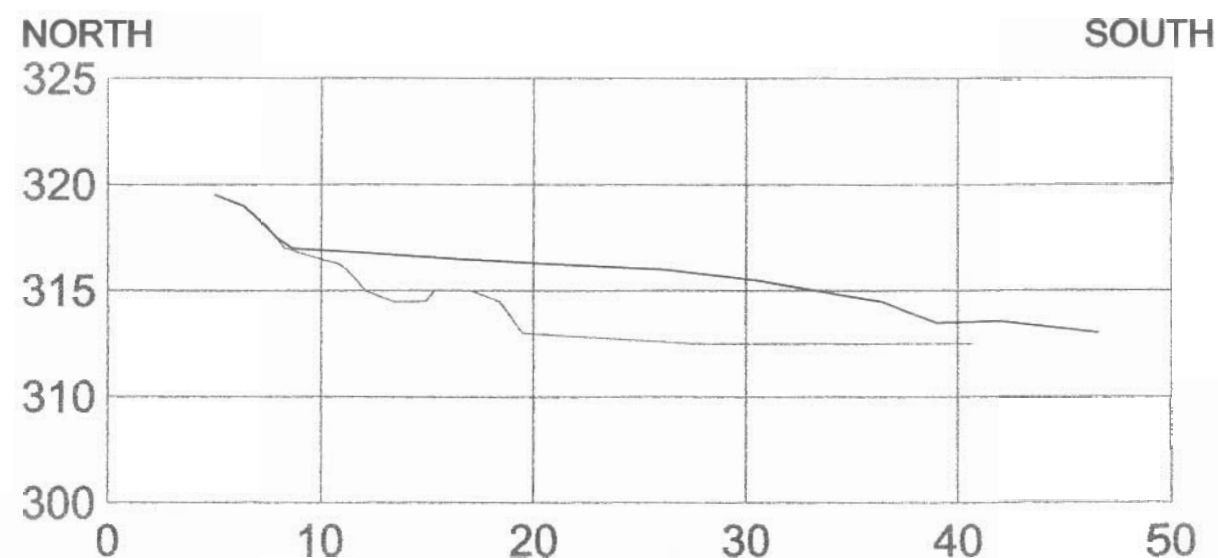

CROSS-SECTION OF EASTERN BERM ALONG THE CENTRE LINE

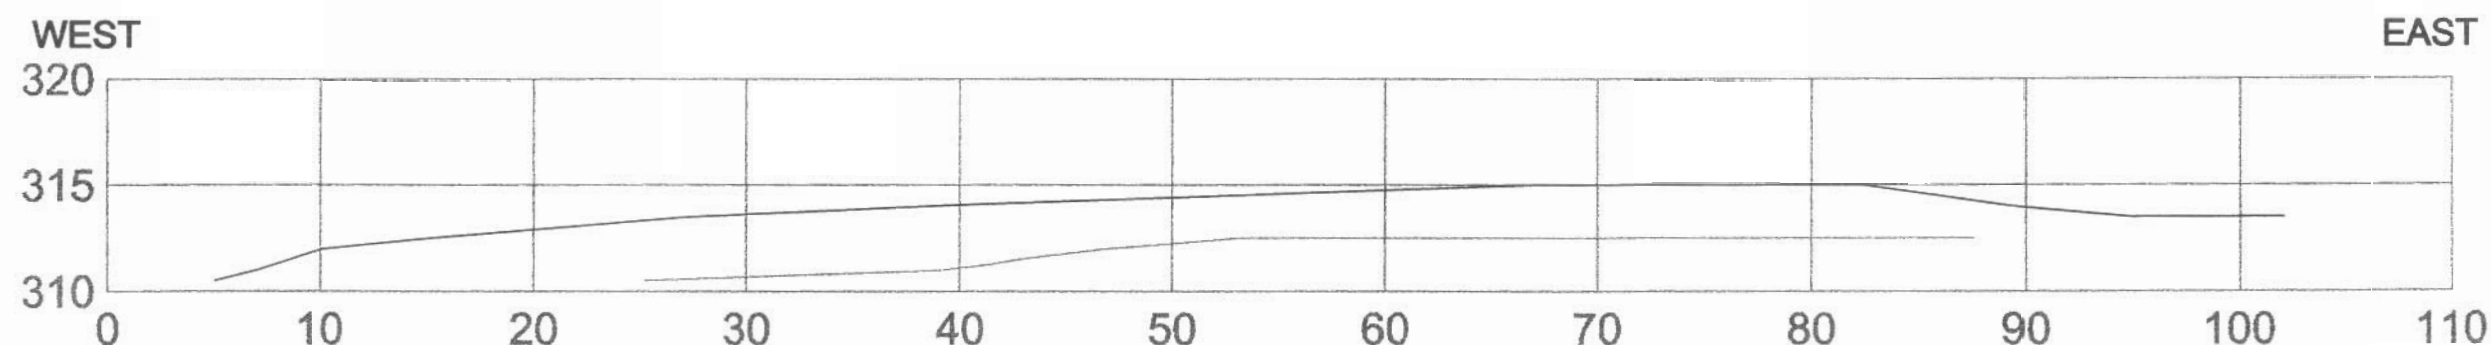

CROSS-SECTION OF SOUTHERN BERM ALONG THE CENTRE LINE

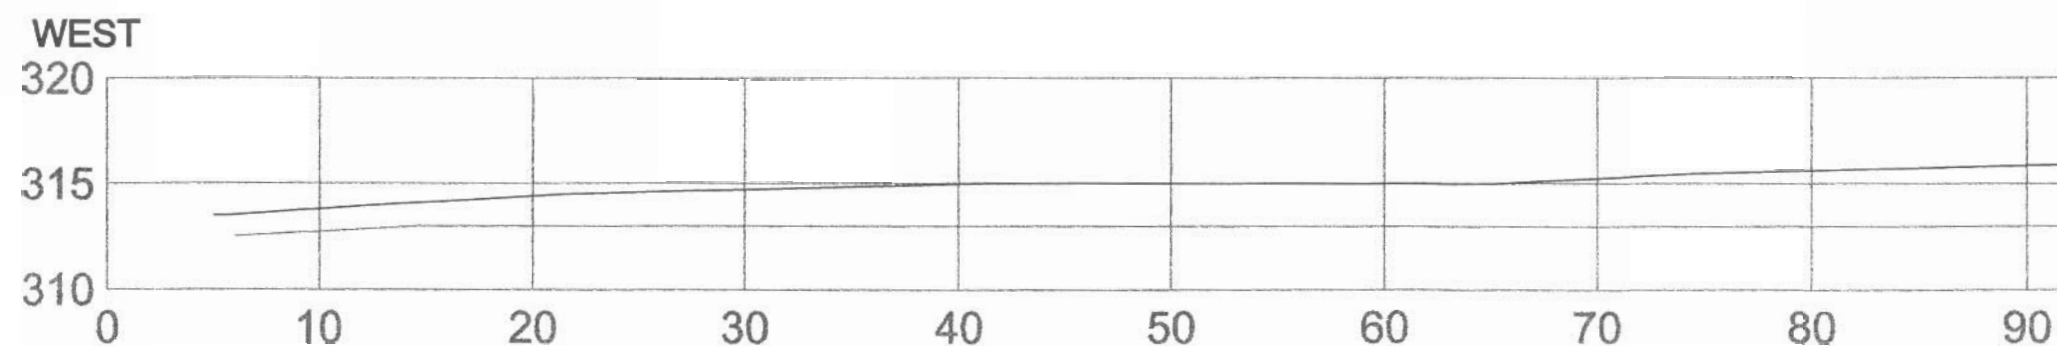


CROSS-SECTION OF THE NORTHERN BERM ALONG THE CENTER LINE




PERMIT TO PRACTICE	
SINANNI INC.	
Signature	<i>[Signature]</i>
Date	04/02/25
PERMIT NUMBER: P 410	
The Association of Professional Engineers, Geologists and Geophysicists of the NWT / NU	

NO.	DATE	REVISION	REVISION	APPR.
SCALE - ÉCHELLE AS SHOWN				
PROJECT - PROJET BAF-5 RESOLUTION ISLAND				
© COPYRIGHT HER MAJESTY THE QUEEN IN THE RIGHT OF CANADA 2004, AS REPRESENTED BY INDIAN AND NORTHERN AFFAIRS CANADA				
TRADE - MÉTIER SITING	DATE 2004-01-30			
SUBJECT - SUJET CROSS-SECTIONS OF THE BERM CORES CONSTRUCTED DURING THE 2003 WORK SEASON				
PRODUCTION	CONCURRENCE - AVOUÉMENT			
DESIGNED ÉTUDE	G.J.			
DRAWN Dessin	G.J.			
CHECKED VÉRIFIÉ	K.C.			
COORDINATION	REVISED - RÉVISÉ P.S.			
DWG. NO. - DESIGN NO. AB-2003-102-12				
Canada				

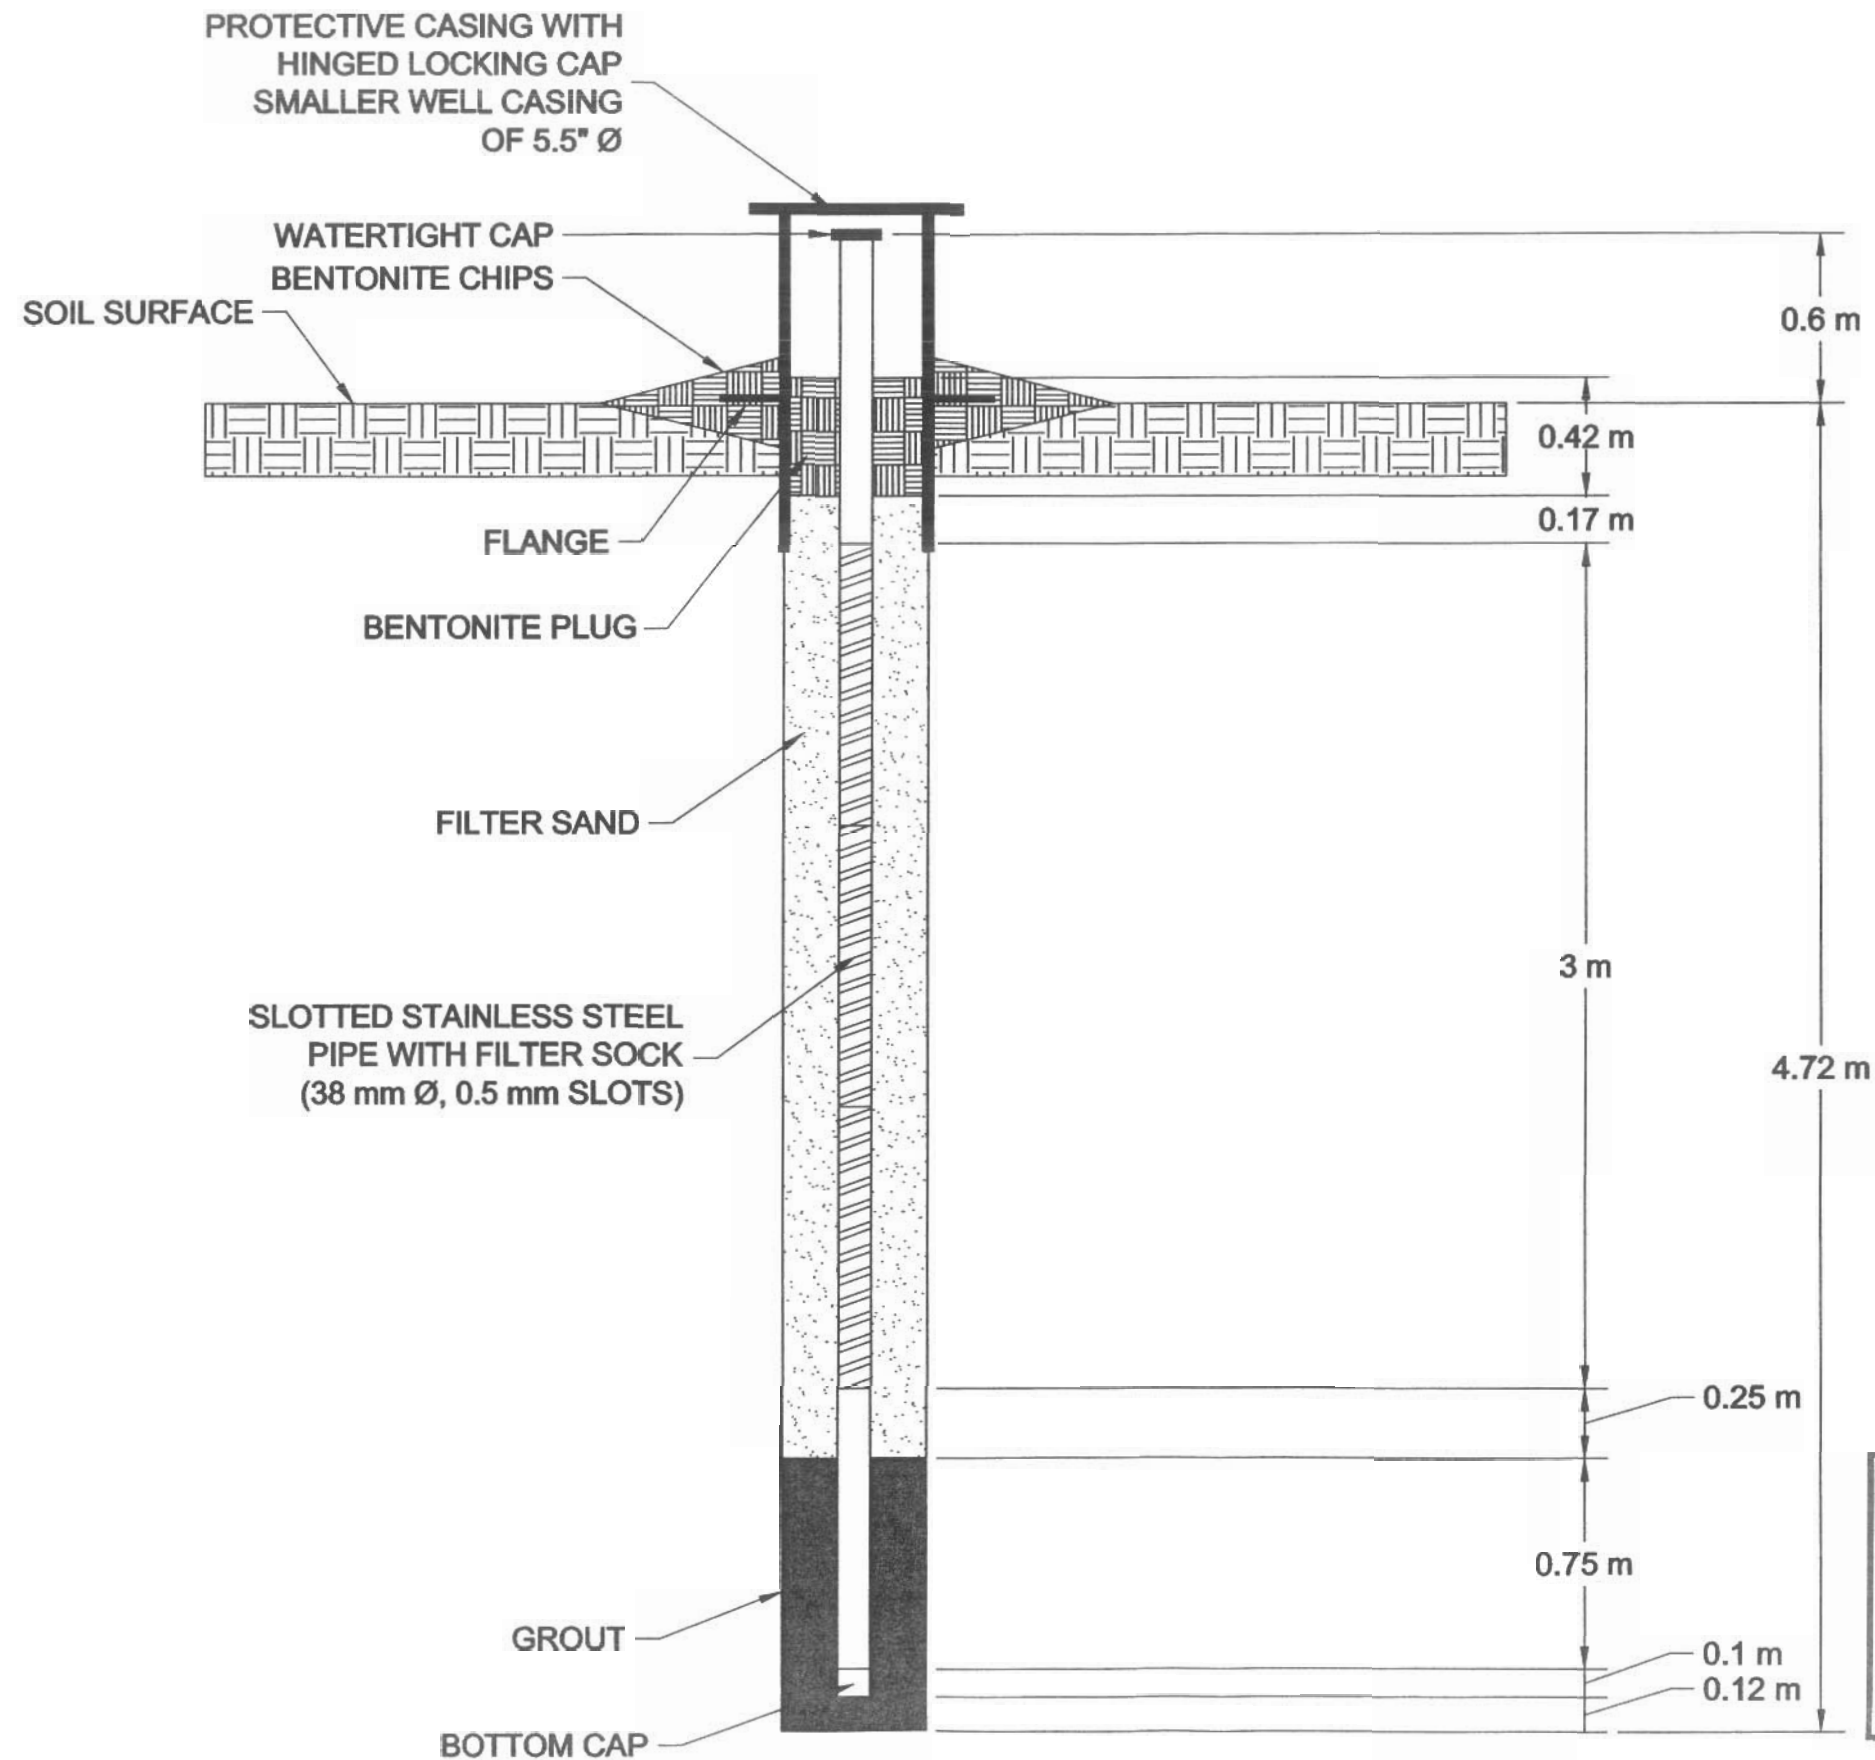

PERMIT TO PRACTICE
SINANNI INC.
Signature [Signature]
Date 04/02/25
PERMIT NUMBER: P 410
The Association of Professional Engineers,
Geologists and Geophysicists of the NWT / NU

INDIAN AND NORTHERN AFFAIRS CANADA				
NUNAVUT REGIONAL OFFICE				
General Notes: 1.				
Legend:				
No.	DATE	REVISION	REVISION	APPR.
Sinanni Inc. NOT TO SCALE				
PROJECT - PROJET BAF-5 RESOLUTION ISLAND				
© COPYRIGHT HER MAJESTY THE QUEEN IN THE RIGHT OF CANADA 2004, AS REPRESENTED BY INDIAN AND NORTHERN AFFAIRS CANADA				
TRADE - MÉTIER	SITING	DATE	2004-01-30	
SUBJECT - SUJET INSTALLATION DETAILS MONITORING WELL NUMBER 2				
DESIGNED ÉTUDE	CONCURRENCE - ASSENTIMENT			
DRAWN Dessin	G.J.			
CHECKED VÉRIFIÉ	G.J.			
COORDINATION	K.C.			
	P.S.			
DWG. NO. - DESIGN NO. AS-2003-102-13				

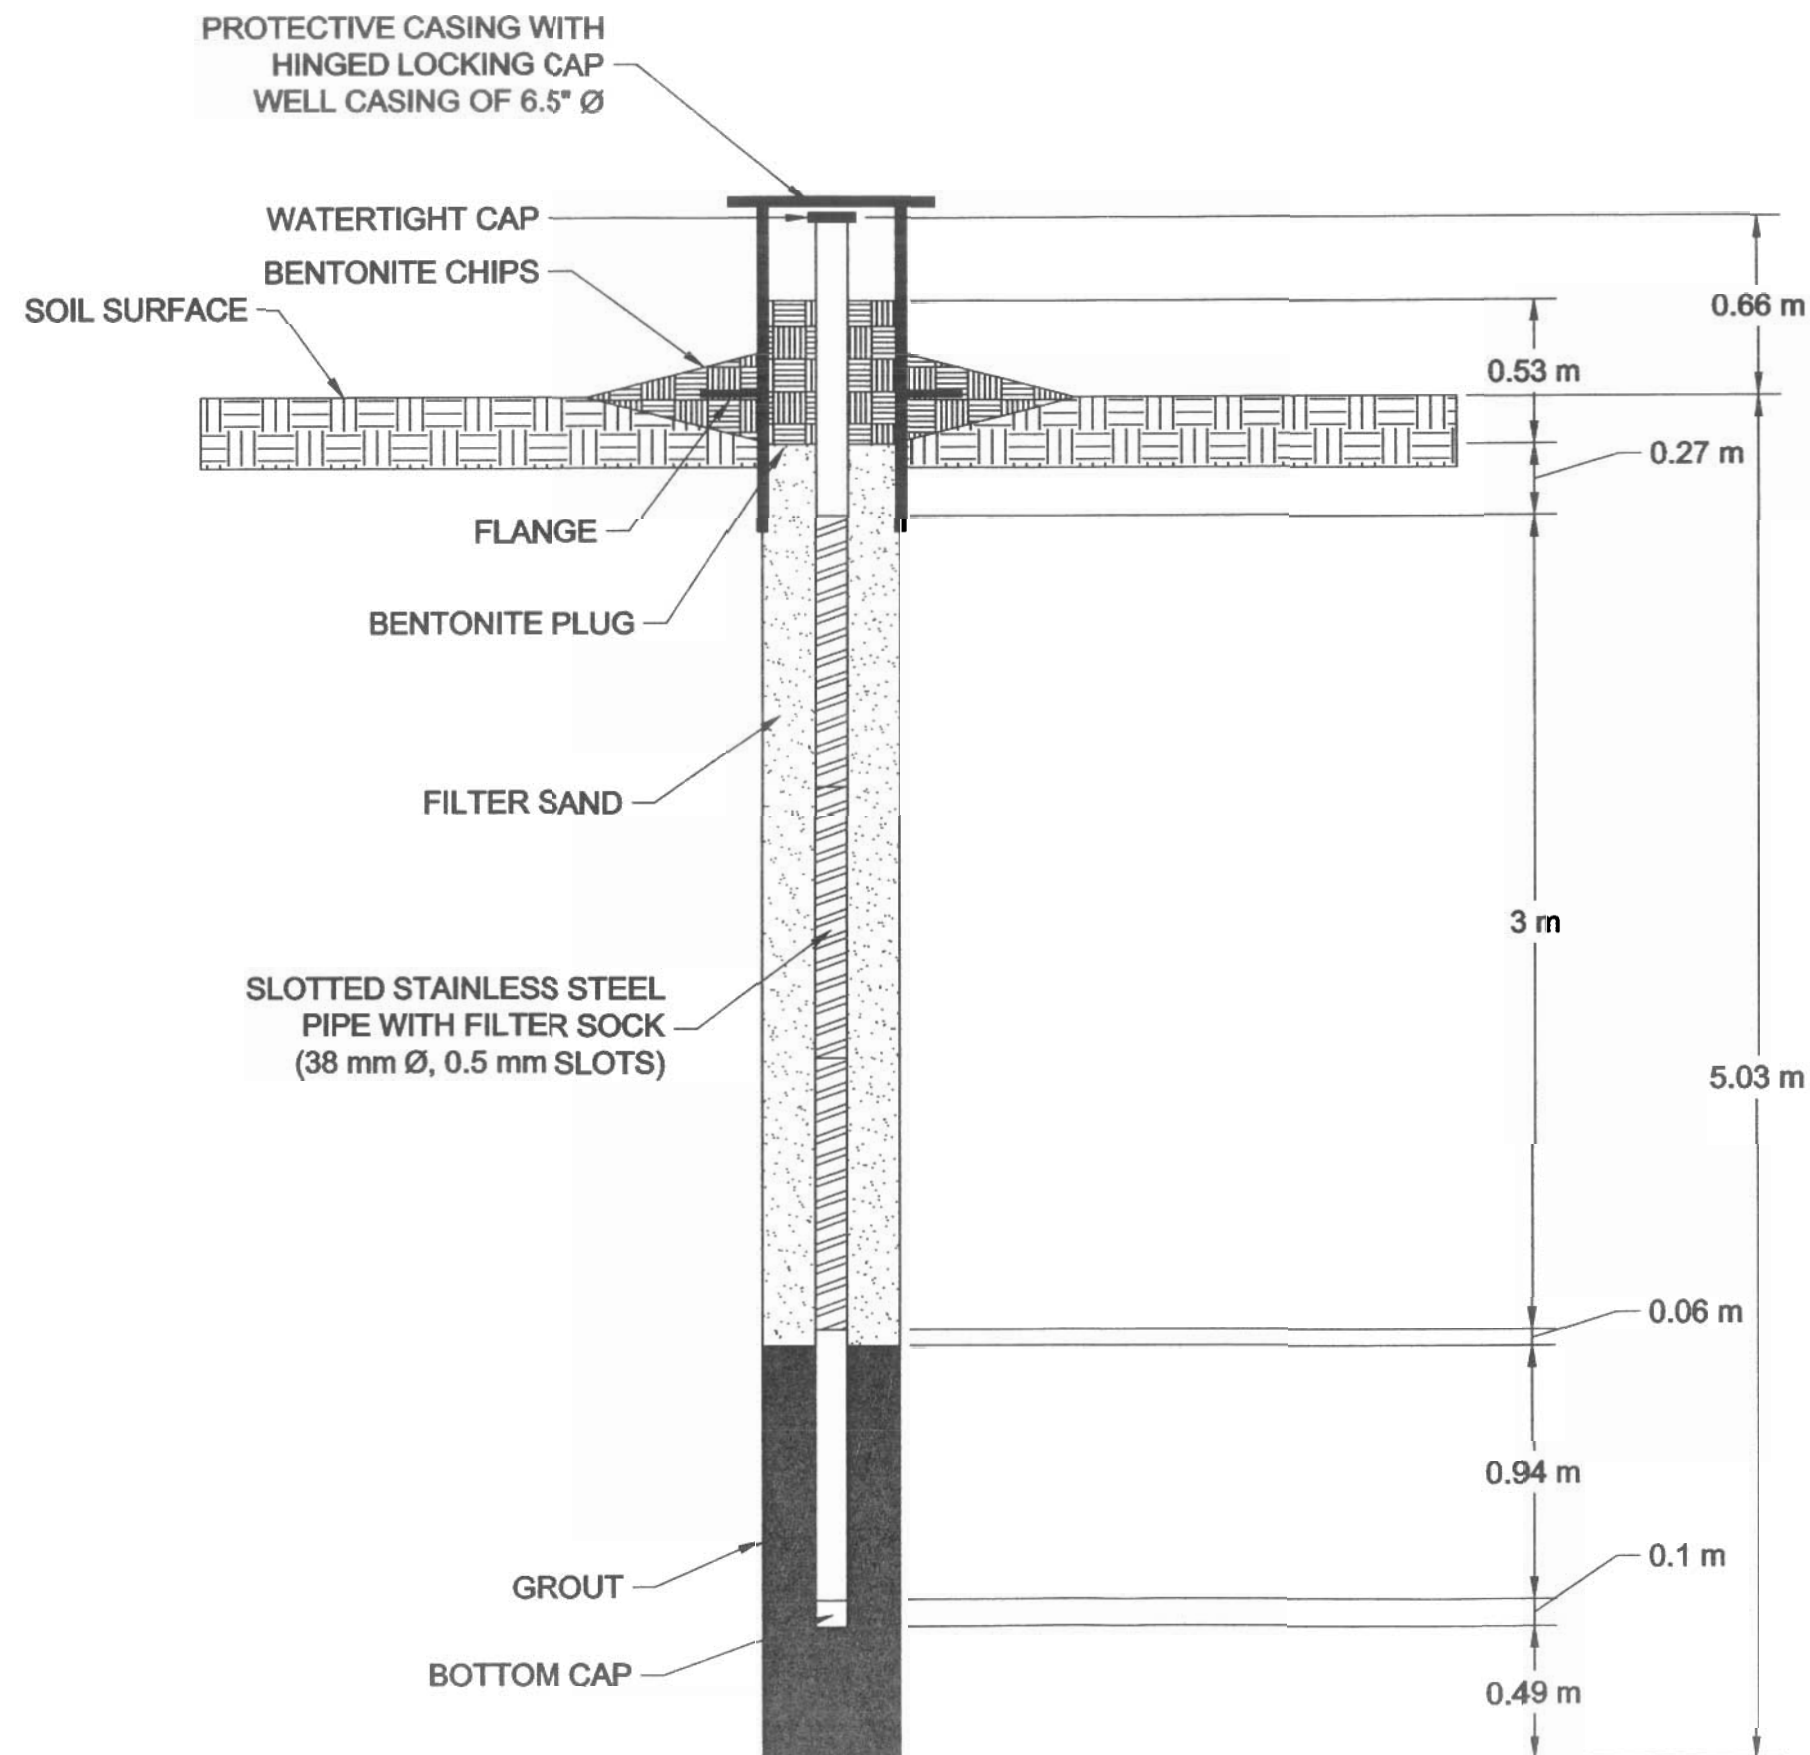

PERMIT TO PRACTICE
SINANNI INC.


Signature [Signature]

Date 04/02/25

PERMIT NUMBER: P 410

The Association of Professional Engineers,
Geologists and Geophysicists of the NWT / NU

INDIAN AND NORTHERN AFFAIRS CANADA				
NUNAVUT REGIONAL OFFICE				
General Notes:				
Legend:				
No.	DATE	REVISION	REVISION	APPR.
Sinanni Inc.				
SCALE - ÉCHELLE NOT TO SCALE				
PROJECT - PROJET BAF-5 RESOLUTION ISLAND				
© COPYRIGHT HER MAJESTY THE QUEEN IN THE RIGHT OF CANADA 2004, AS REPRESENTED BY INDIAN AND NORTHERN AFFAIRS CANADA				
TRADE - MÉTIER	SITING		DATE 2004-01-30	
SUBJECT - SUJET INSTALLATION DETAILS MONITORING WELL NUMBER 3				
PRODUCTION	CONCURRENCE - ASSISEMENT			
DESIGNED ÉTUDE	G.J.			
DRAWN DÉSSINÉ	G.J.			
CHECKED VÉRIFIÉ	K.C.			
COORDINATION	REVISED - RÉVISÉ P.S.			
DWG. NO. - DÉSSIN NO. AB-2003-102-14				

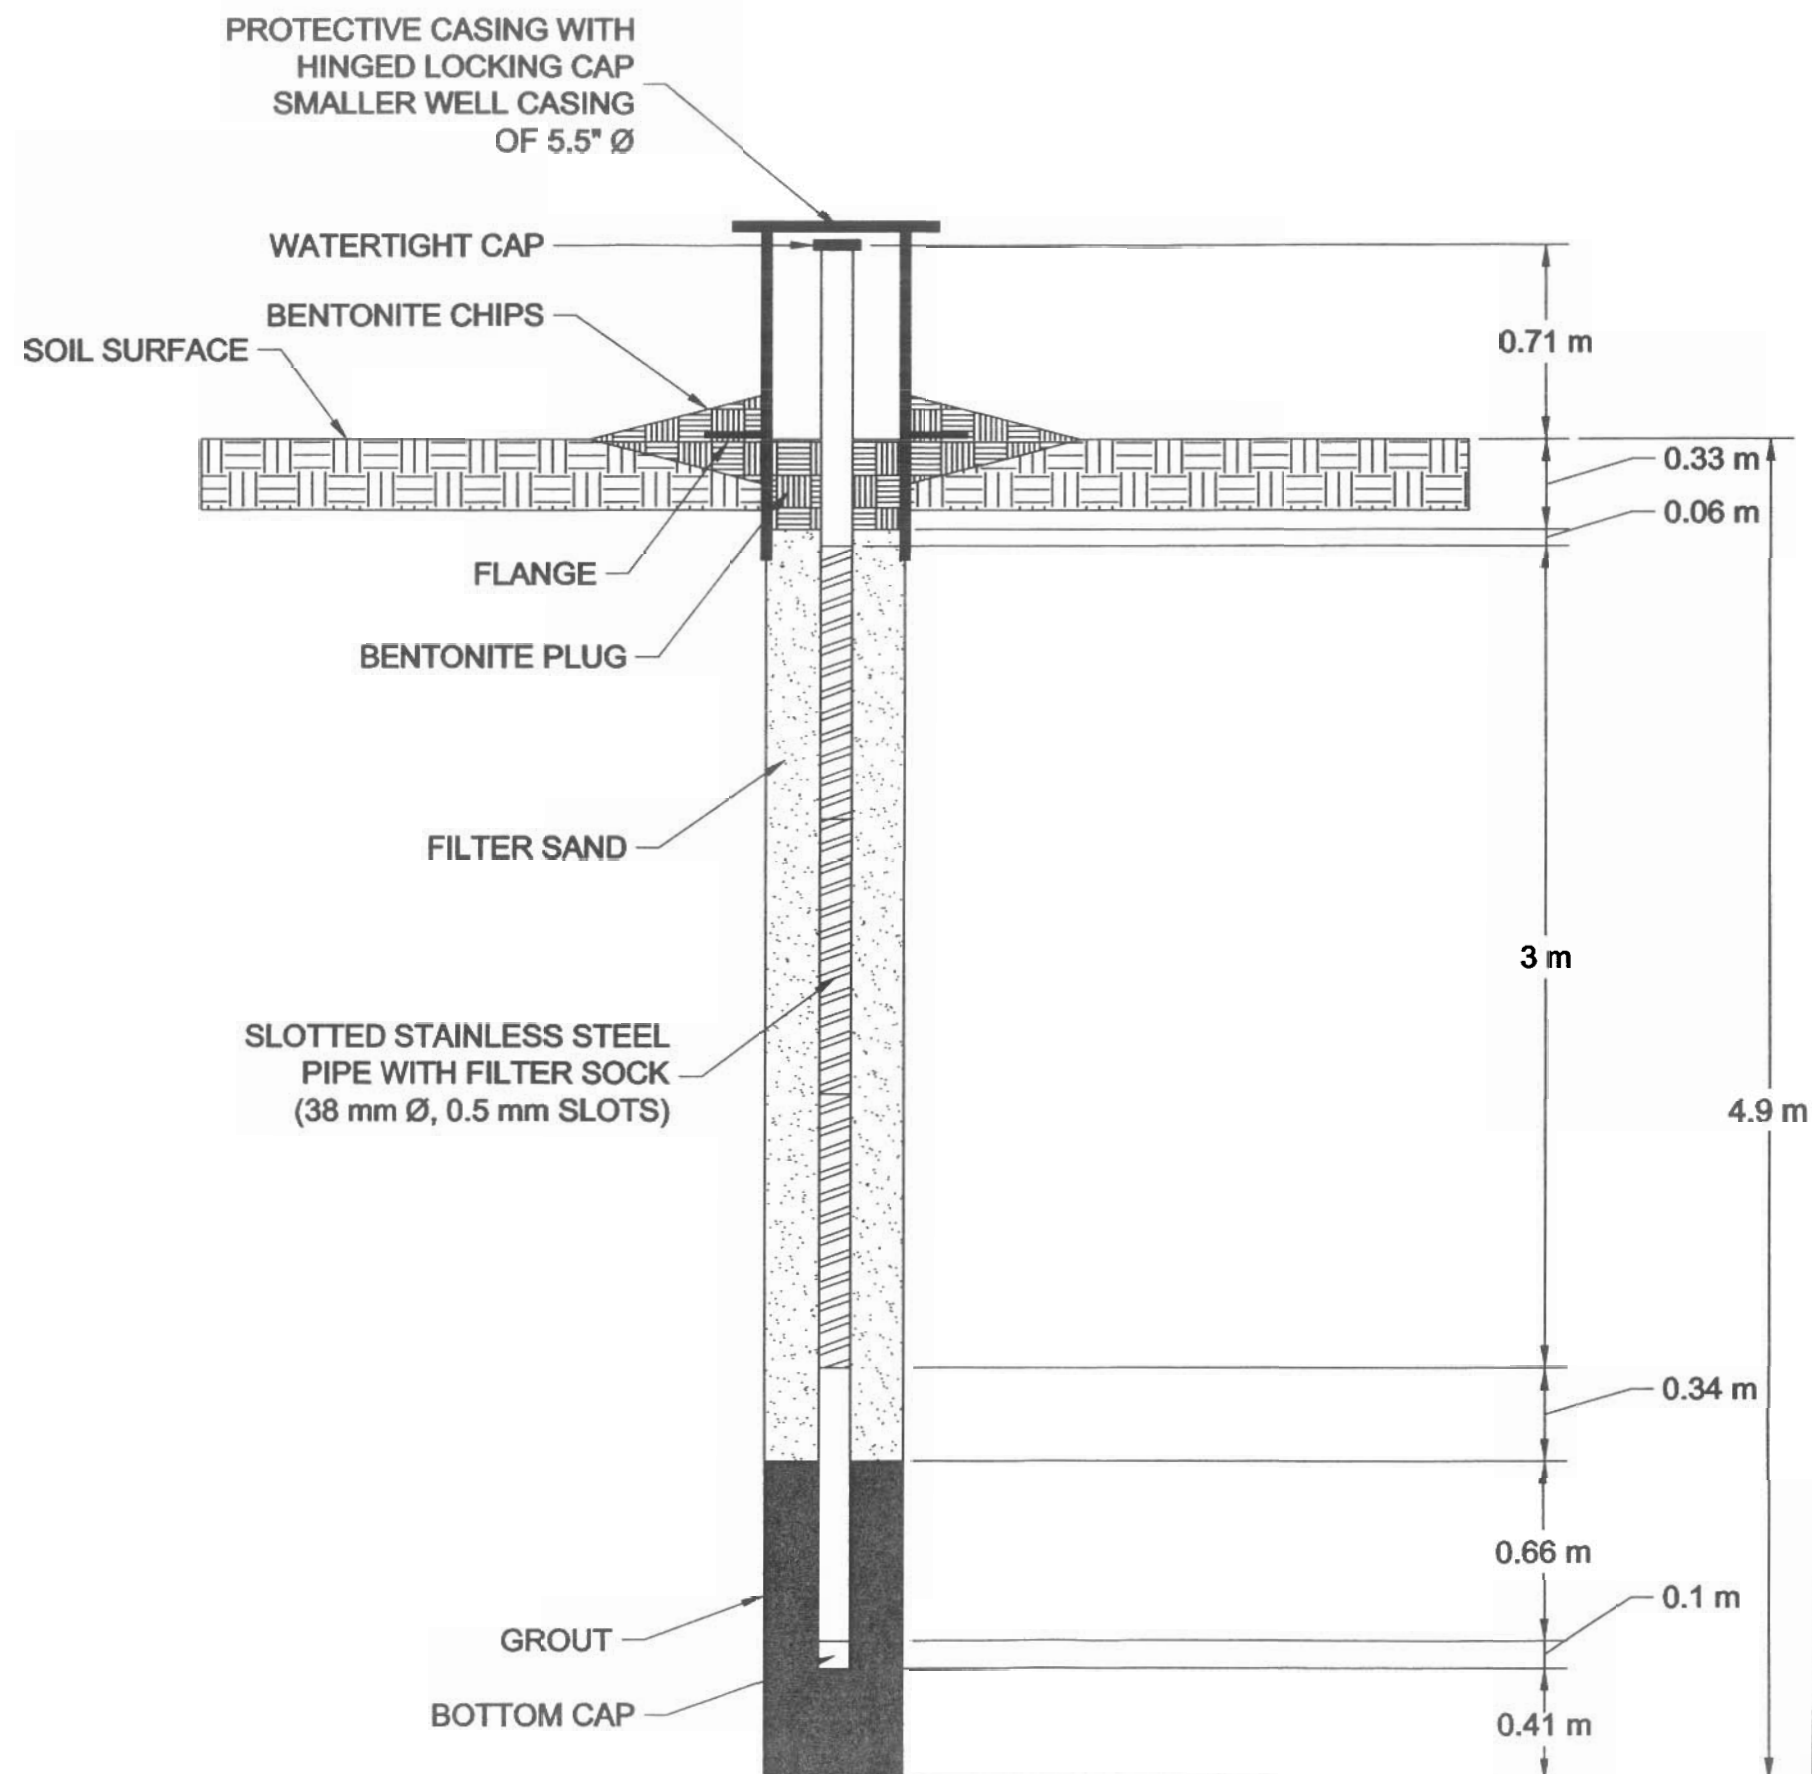

PERMIT TO PRACTICE
SINANNI INC.
 Signature [Signature]
 Date 04/02/25
PERMIT NUMBER: P 410
 The Association of Professional Engineers,
 Geologists and Geophysicists of the NWT / NU

INDIAN AND NORTHERN AFFAIRS CANADA																					
NUNAVUT REGIONAL OFFICE																					
General Notes: 1.																					
Legend:																					
<table border="1"> <thead> <tr> <th>NO.</th> <th>DATE</th> <th>REVISION</th> <th>REVISION</th> <th>APPR.</th> </tr> </thead> <tbody> <tr> <td> </td> <td> </td> <td> </td> <td> </td> <td> </td> </tr> </tbody> </table>	NO.	DATE	REVISION	REVISION	APPR.						<p>Sinanni Inc.</p> <p>SCALE - ÉCHELLE: NOT TO SCALE</p> <p>PROJECT - PROJET: BAF-5 RESOLUTION ISLAND</p> <p>© COPYRIGHT HER MAJESTY THE QUEEN IN THE RIGHT OF CANADA 2004, AS REPRESENTED BY INDIAN AND NORTHERN AFFAIRS CANADA</p> <p>TRADE - MÉTIER: SITING DATE: 2004-01-30</p> <p>SUBJECT - SUJET: INSTALLATION DETAILS MONITORING WELL NUMBER 4</p> <table border="1"> <thead> <tr> <th>PRODUCTION</th> <th>CONCURRENCE - ASSISEMENT</th> </tr> </thead> <tbody> <tr> <td>DESIGNED ETUDE: G.J.</td> <td> </td> </tr> <tr> <td>DRAWN DESSINE: G.J.</td> <td> </td> </tr> <tr> <td>CHECKED VÉRIFIÉ: K.C.</td> <td> </td> </tr> <tr> <td>COORDINATION: P.S.</td> <td> </td> </tr> </tbody> </table> <p>DWG. NO. - DESSIN NO. AS-2003-102-15</p> <p>Canada</p>	PRODUCTION	CONCURRENCE - ASSISEMENT	DESIGNED ETUDE: G.J.		DRAWN DESSINE: G.J.		CHECKED VÉRIFIÉ: K.C.		COORDINATION: P.S.	
NO.	DATE	REVISION	REVISION	APPR.																	
PRODUCTION	CONCURRENCE - ASSISEMENT																				
DESIGNED ETUDE: G.J.																					
DRAWN DESSINE: G.J.																					
CHECKED VÉRIFIÉ: K.C.																					
COORDINATION: P.S.																					