

GRID: 5D

DATE: July 8 7th

INITIALS LM


20 meters

TEXT	Tag or (SN) Sample Number
TEXT	PCB Concentration (ppm)
	TIER I: PCB Concentration
	TIER II: PCB Concentration
	Pink Rope
	Blue Rope
	Road
	Areas Excavated/Vacuumed
	Debris Piles
	Clean Fill on TIER II



Comments:

20 meters

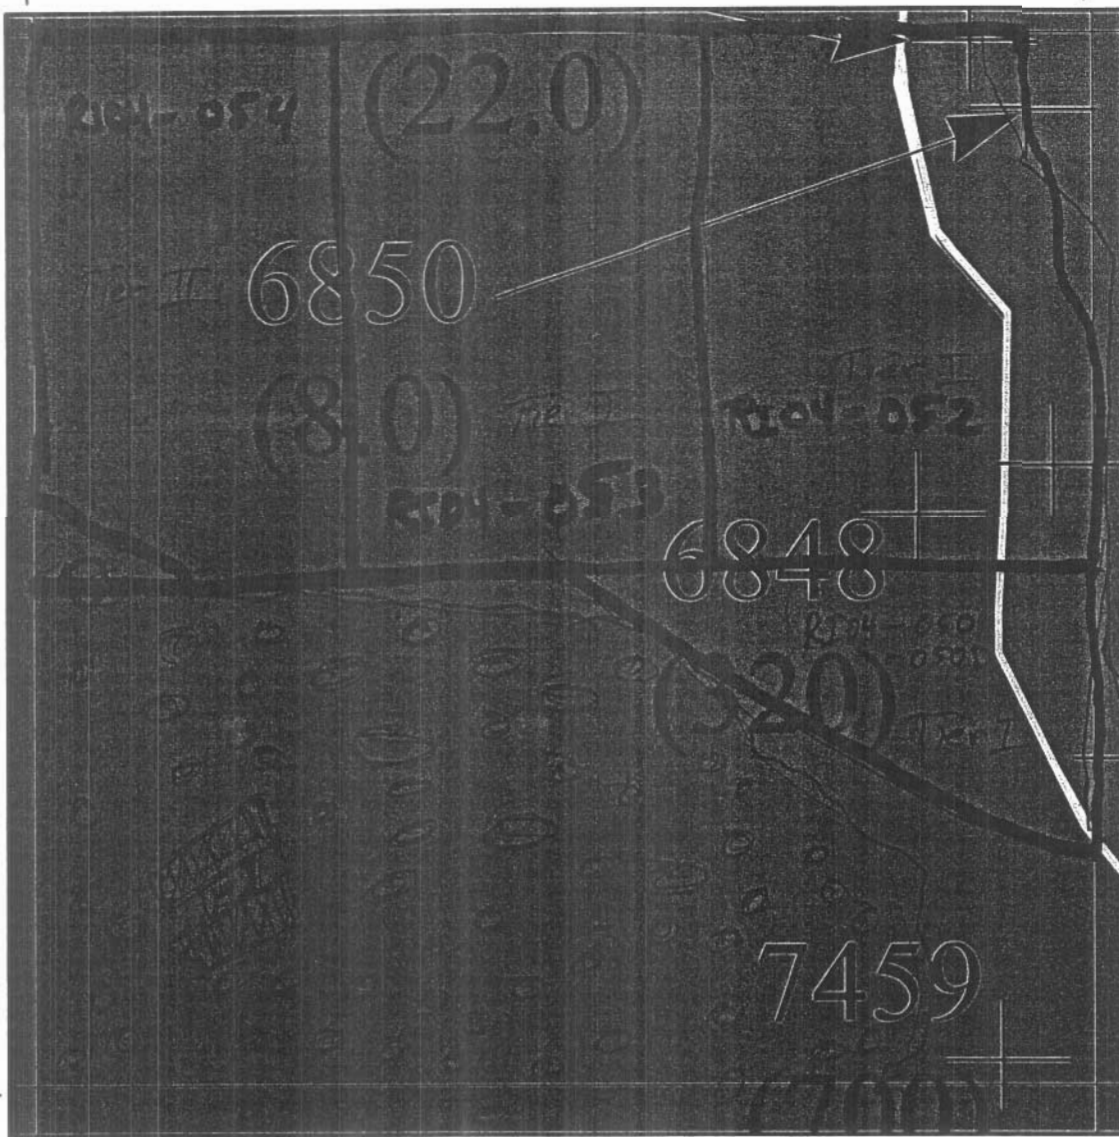

ANALYSIS LOG

Sample (RI04)	Result (ppm)	Comment:
050, 050	3.4, 5.0	Tier I
052	4.4	Tier I
053	3.8	Tier I
054	10.4	Tier II

EXCAVATION:

Excavation of the upper half of 5D on 6th July; lower half covered with CEPA stock-piles.

GRID: 5D

DATE: July 6th 2001

INITIALS

EAH

20 meters


TEXT	Tag or (SN) Sample Number
TEXT	PCB Concentration (ppm)
	TIER I: PCB Concentration
	TIER II: PCB Concentration
	Pink Rope
	Blue Rope
	Road
	Areas Excavated/Vacuumed
	Debris Piles
	Clean Fill on TIER II



Comments:

Yetto

20 meters

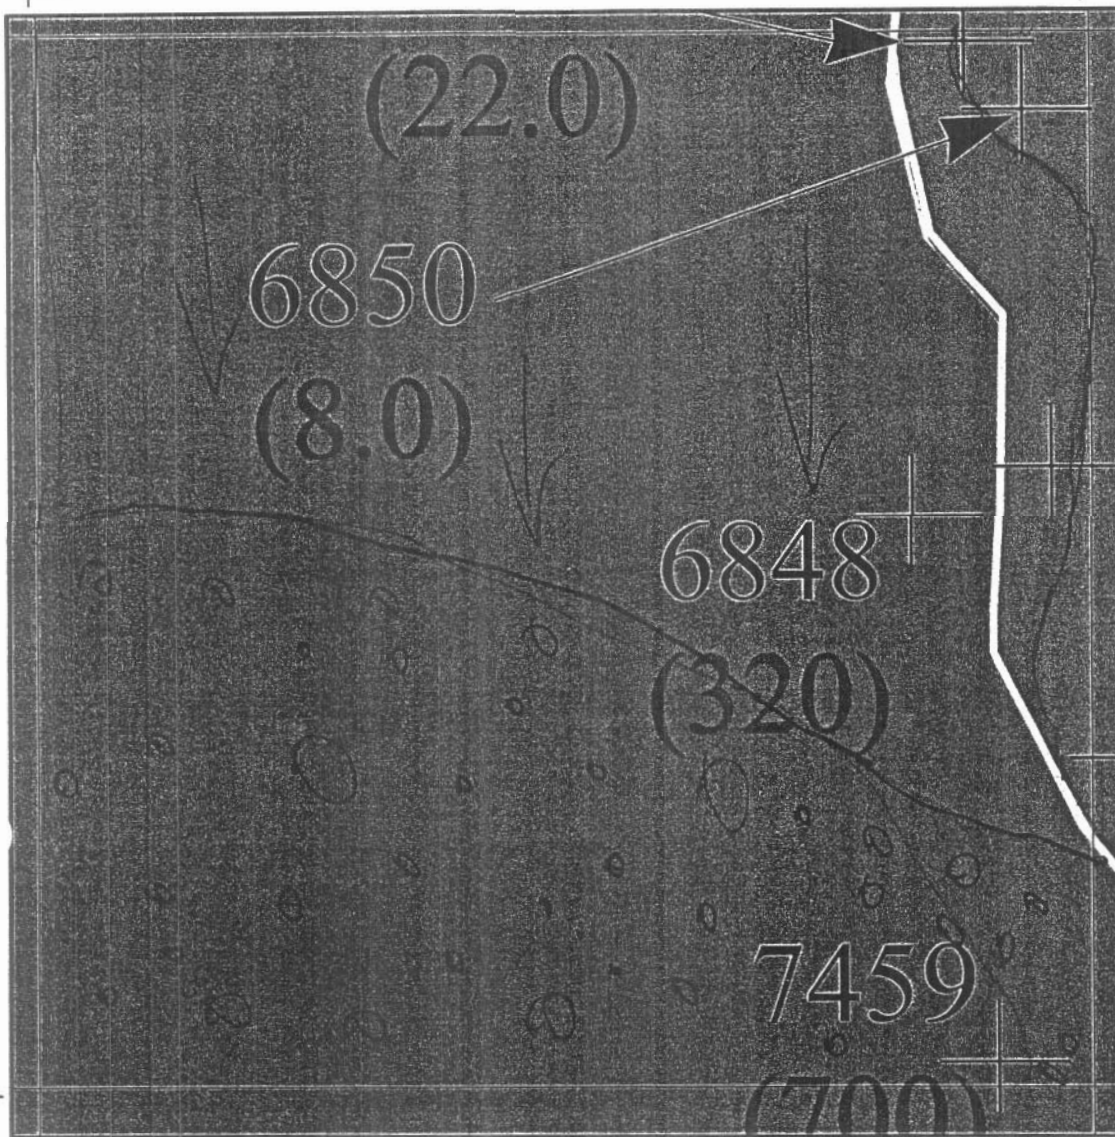

ANALYSIS LOG

Sample (RI04)	Result (ppm)	Comment:

EXCAVATION:

Began on 6th (at top of East Giff ramp) (40) feet
scraped down slope; excavated ~ half the 5D area.

GRID: 5D

DATE: July 1

INITIALS

ASW

20 meters


TEXT	Tag or (SN) Sample Number
TEXT	PCB Concentration (ppm)
	TIER I: PCB Concentration
	TIER II: PCB Concentration
	Pink Rope
	Blue Rope
	Road
	Areas Excavated/Vacuumed
	Debris Piles
	Clean Fill on TIER II



Comments:

Allison +
Kevin moved
the yellow
rope after
contaminated
sampling.

20 meters

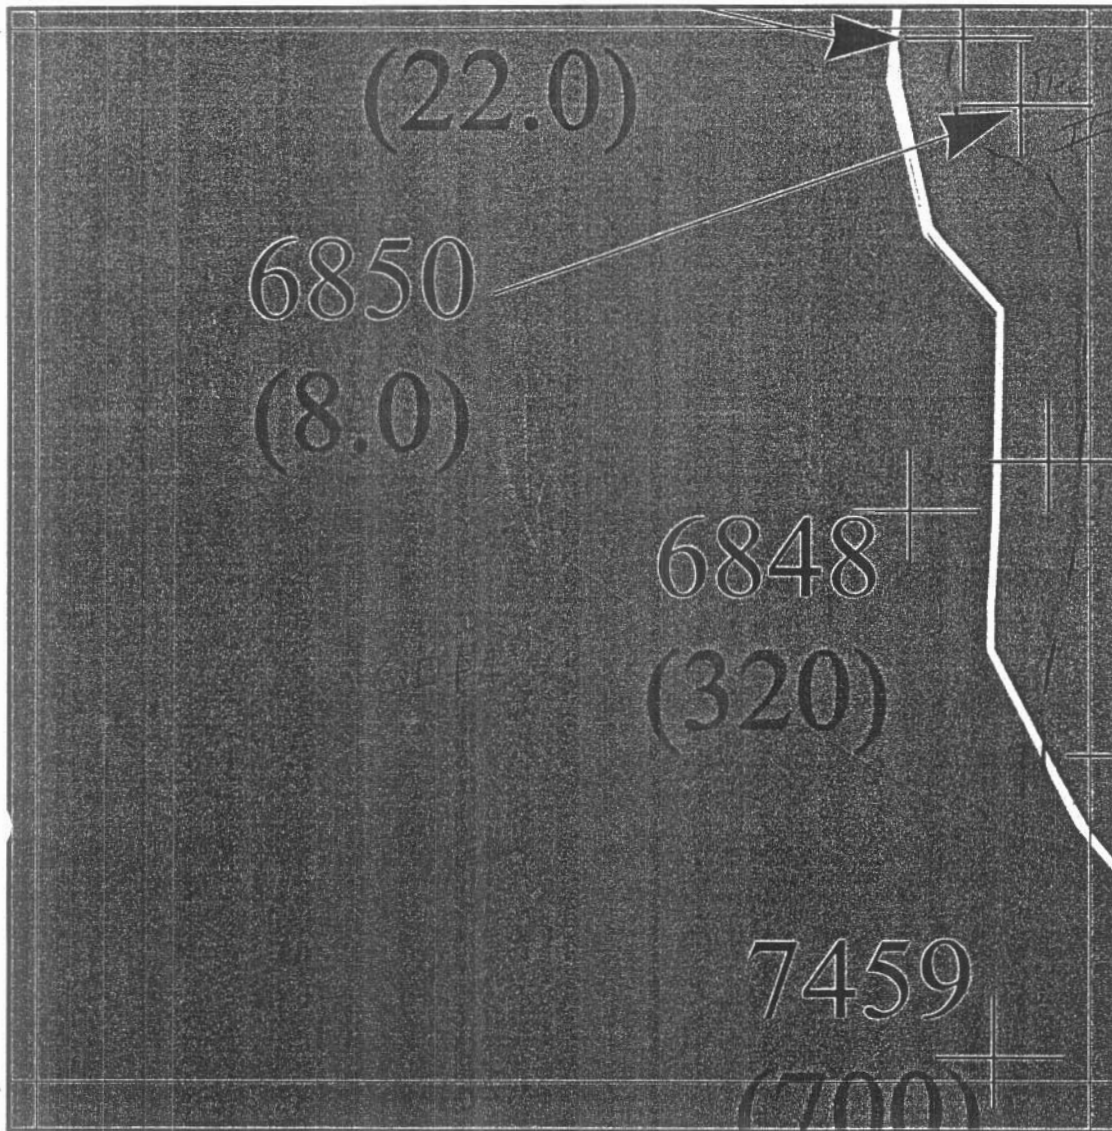

ANALYSIS LOG

Sample (RI04)	Result (ppm)	Comment:

EXCAVATION:

DESCRIPTION OF QUADRANT / ADDITIONAL INFORMATION

RI 2004 Field Season

5C

EXCAVATION LOG

	Date	Type*	Location	Material #	Depth	Comments
	July 5th	H	North edge	CEPA	N/A	Platform/Stockpile enters grid
	July 6th	H	Northern area	CEPA	30cm	Excavation of top area begins
	July 9th	H	Upper half of CEPA area	CEPA	30cm	Further excavation down slope
	Aug 17th	H	Lower section CEPA pile	CEPA	N/A	CEPA stockpile removal begins
	Aug 20th	H	"	CEPA	30cm	Stockpile removed; excavation of first 30cm with grapple

* H Heavy Equipment, M Manual, V Vacuum

>2000 ppm, CEPA, Tier II, Tier I.

ANALYSIS LOG:

	Date	Sample [△]	Type [◇]	Results (ppm)	Comments
	July 3	004	S	19	Confirming sample TIER II delineated
	July 10	106	S	29	} TIER II remains
	July 10	107	S	24	
	Aug 25	628	S	27	TIER II remains
					All CEPA removed from Grid

△ Prefix RI04-

◇ S Soil, W Wood, M Metal, O Other

CERTIFICATION THAT ALL SOIL CONTAINING > 50 PPM PCBs IS REMOVED FROM QUADRANT

Queen's Representative

07 Sept 04
Date

Engineer Representative

09 Sept 04
Date

QC Representative

Sept 9/04
Date

GRID: 5C

DATE: Sept 2nd 2004

INITIALS

BAH

20 meters


TEXT	Tag or (SN) Sample Number
TEXT	PCB Concentration (ppm)
	TIER I: PCB Concentration
	TIER II: PCB Concentration
	Pink Rope
	Blue Rope
	Road
	Areas Excavated/Vacuumed
	Debris Piles
	Clean Fill on TIER II



Comments:

Final Map

20 meters

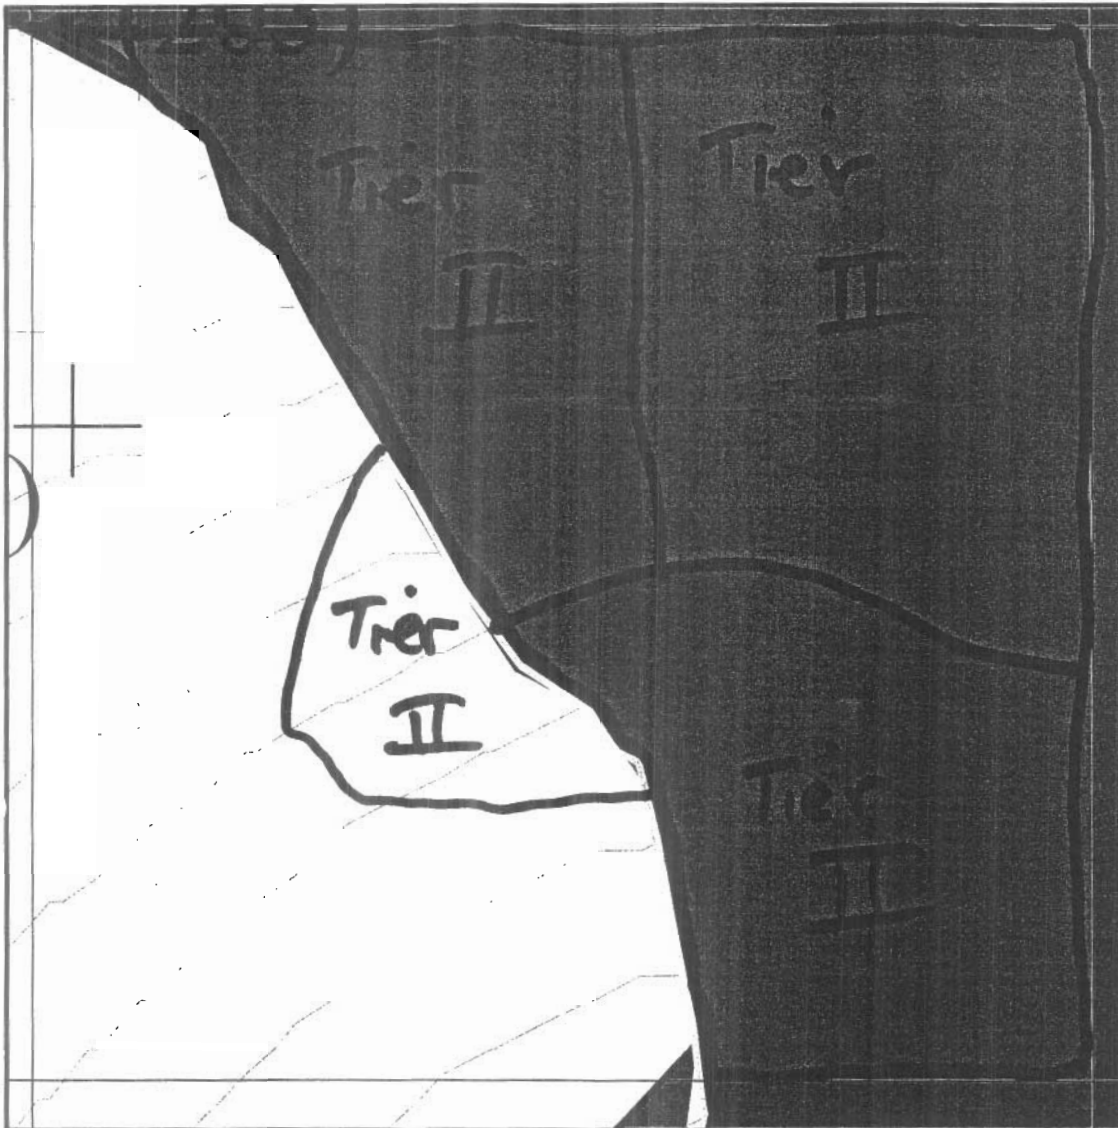

ANALYSIS LOG

Sample (RI04)	Result (ppm)	Comment:

EXCAVATION:

GRID: 5C

DATE: 25 Aug 2004

INITIALS

KLM

20 meters


TEXT	Tag or (SN) Sample Number
TIER I	PCB Concentration (ppm)
TIER I	PCB Concentration
TIER II	PCB Concentration
	Pink Rope
	Blue Rope
	Road
	Areas Excavated/Vacuumed
	Debris Piles
	Clean Fill on TIER II



Comments:

Removed with
Grapple, saw was
to be down
at least 30cm

20 meters

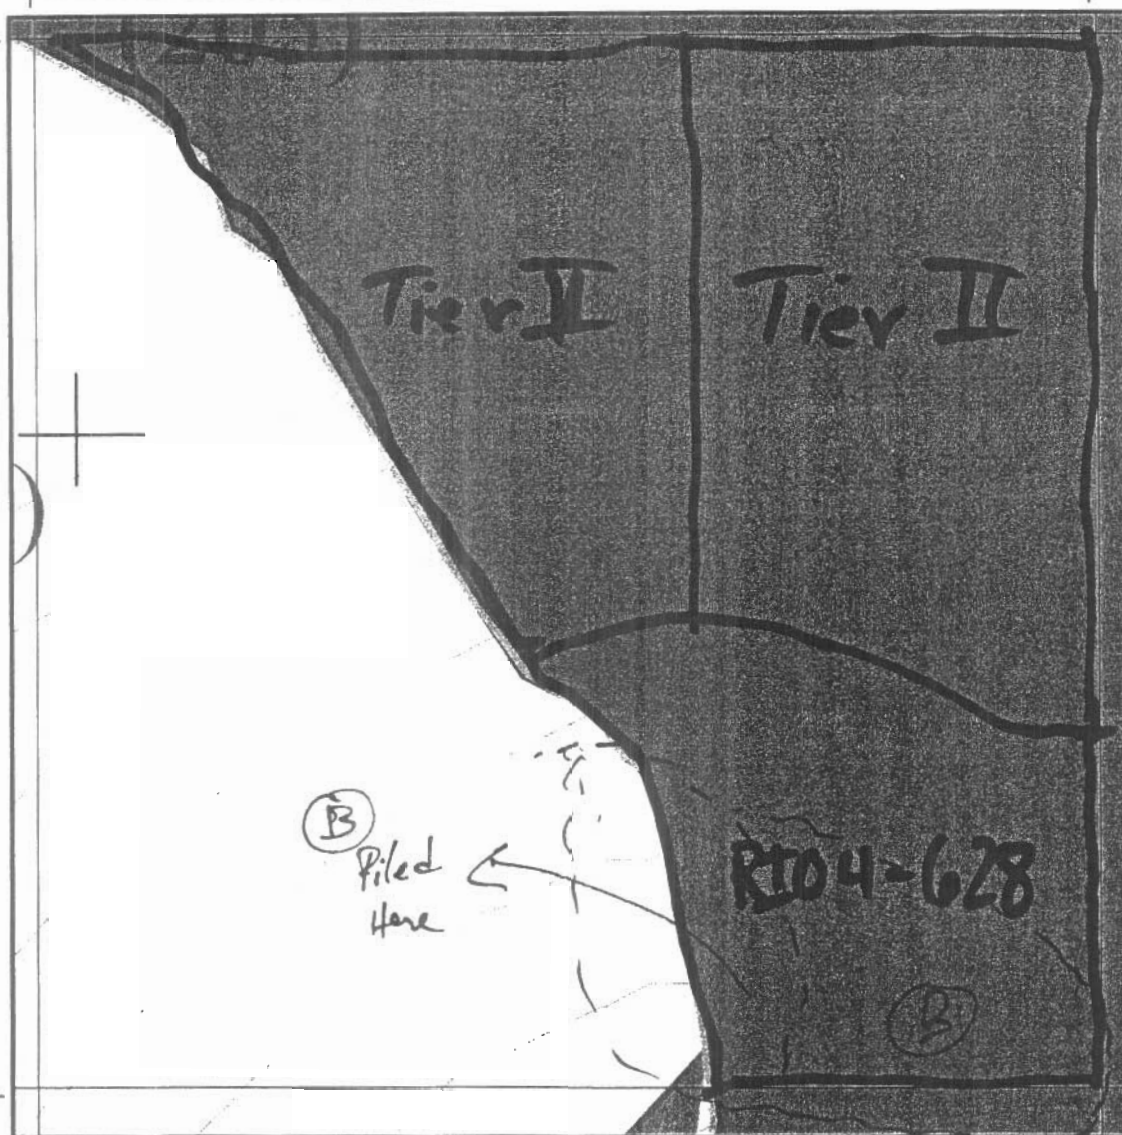

ANALYSIS LOG

Sample (RI04)	Result (ppm)	Comment:
RI04-628	26.6*	Composite Tier II ; ready for sign off
		* Average of duplicate results (laboratory)

EXCAVATION:

Boulders were cleaned away

GRID: 5C

DATE: ^{KZM} Aug 17th, 2004

INITIALS

KZM

20 meters

TEXT	Tag or (SN) Sample Number
TEXT	PCB Concentration (ppm)
TEXT	TIER I: PCB Concentration
TEXT	TIER II: PCB Concentration
TEXT	Pink Rope
TEXT	Blue Rope
TEXT	Road
TEXT	Area Excavated/Vacuumed
TEXT	Debris Piles
TEXT	Clean Fill on TIER II



Comments:

Removal of
CEPA stock
pile has begun
Exact date
uncertain.
Hauling to B2
stockpile
Jonathan F.
operating grapple

ANALYSIS LOG

Sample (RI04)	Result (ppm)	Comment:

EXCAVATION:

GRID: 5C

DATE: July 10, 2024

INITIALS

KM

20 meters

TEXT Tag or (SN) Sample Number
TEXT PCB Concentration (ppm)
TIER I: PCB Concentration
TIER II: PCB Concentration
Pink Rope
Blue Rope
Road
Areas Excavated/Vacuumed
Debris Piles
Clean Fill on TIER II



Comments:

Sample
areas extended
down hill to
the edge of
the CFA
stockpile

ANALYSIS LOG

Sample (RI04)	Result (ppm)	Comment:
106	28.9	S
107	24.4	Average of duplicate results

EXCAVATION:

Dave pushed the stock pile further down the slope
on July 9th.

GRID: 5C

DATE: July 6th

INITIALS _____

20 meters

TEXT	Tag or (SN) Sample Number
TEXT	PCB Concentration (ppm)
	TIER I: PCB Concentration
	TIER II: PCB Concentration
	Pink Rope
	Blue Rope
	Road
	Areas Excavated/Vacuumed
	Debris Piles
	Clean Fill on TIER II



Comments:

Top Quarter
of grid CEPA
has been
scraped.
Sampling held
off pending
further movement
of stock pile/
platform.

ANALYSIS LOG

Sample (RI04)	Result (ppm)	Comment:

EXCAVATION:

The upper portion (1/4) of Grid 5C has
been scraped to 30 cm and incorporated into
the CEPA pile centered on grid marker 5C

GRID: 5C

DATE:

^{KM}
July 8^{5th} 2004

INITIALS

KM

20 meters

TEXT	Tag or (SN) Sample Number
TEXT	PCB Concentration (ppm)
TEXT	TIER I: PCB Concentration
TEXT	TIER II: PCB Concentration
TEXT	Pink Rope
TEXT	Blue Rope
TEXT	Road
TEXT	Areas Excavated/Vacuumed
TEXT	Debris Piles
TEXT	Clean Fill on TIER II



Comments:

Dive's

Excavation

platform has
entered 5C.

20 meters

ANALYSIS LOG

Sample (R104)	Result (ppm)	Comment:

EXCAVATION:

GRID: 5C

DATE: July 3rd 04

INITIALS

RNL


20 meters

TEXT	Tag or (SN) Sample Number
TEXT	PCB Concentration (ppm)
	TIER I: PCB Concentration
	TIER II: PCB Concentration
	Pink Rope
	Blue Rope
	Road
	Areas Excavated/Vacuumed
	Debris Piles
	Clean Fill on TIER II



Comments:

20 meters

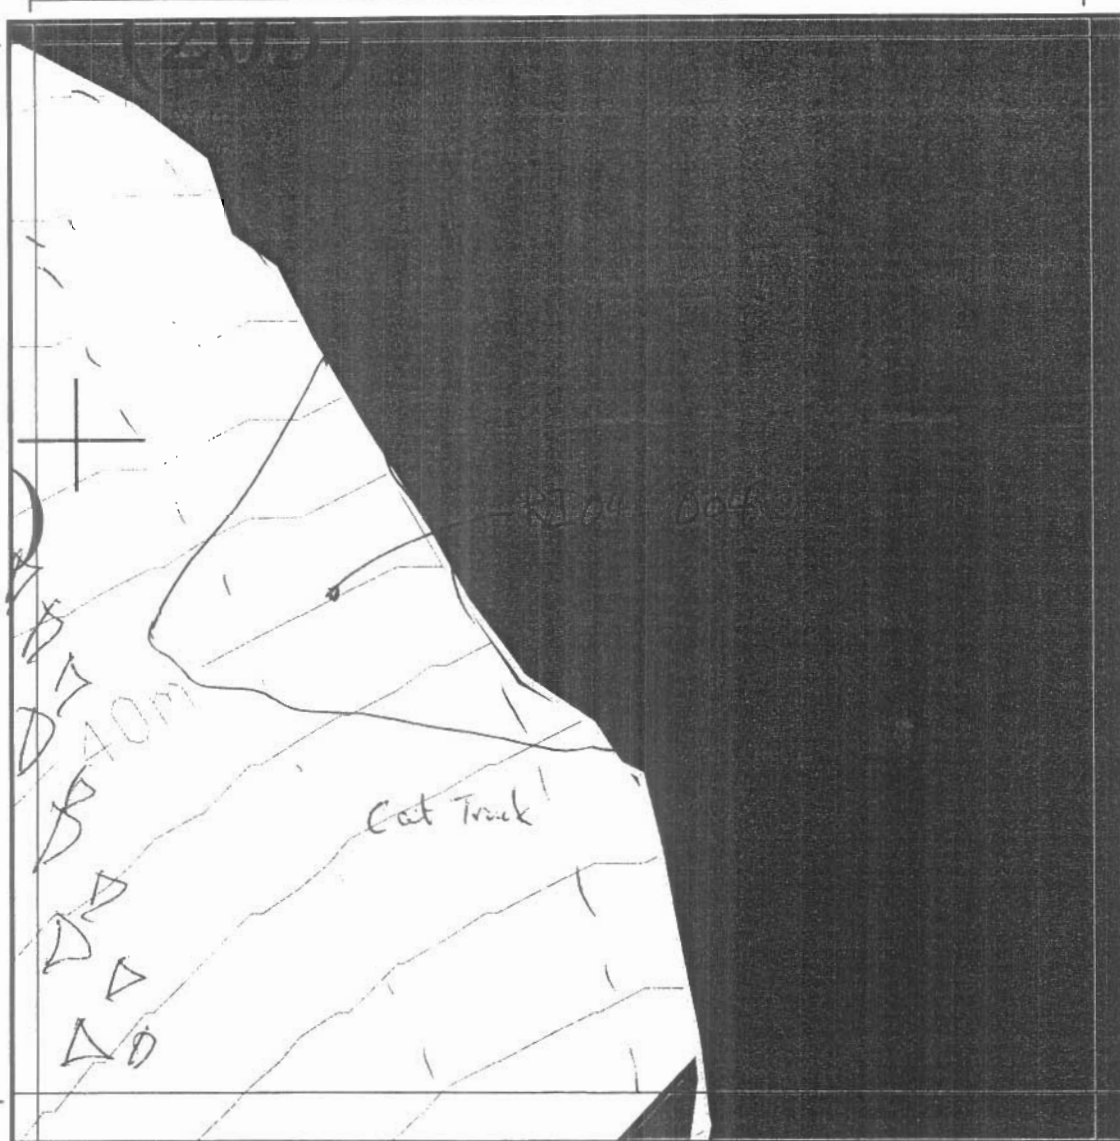

ANALYSIS LOG

Sample (RI04)	Result (ppm)	Comment:
RI04-004	19	Confirmatory Sample - Area Tier II

EXCAVATION:

A cat track was created by removing boulders (Δ) from the west edge of the yellow rope.


GRID: 5C

DATE: _____

INITIALS _____

20 meters

20 meters

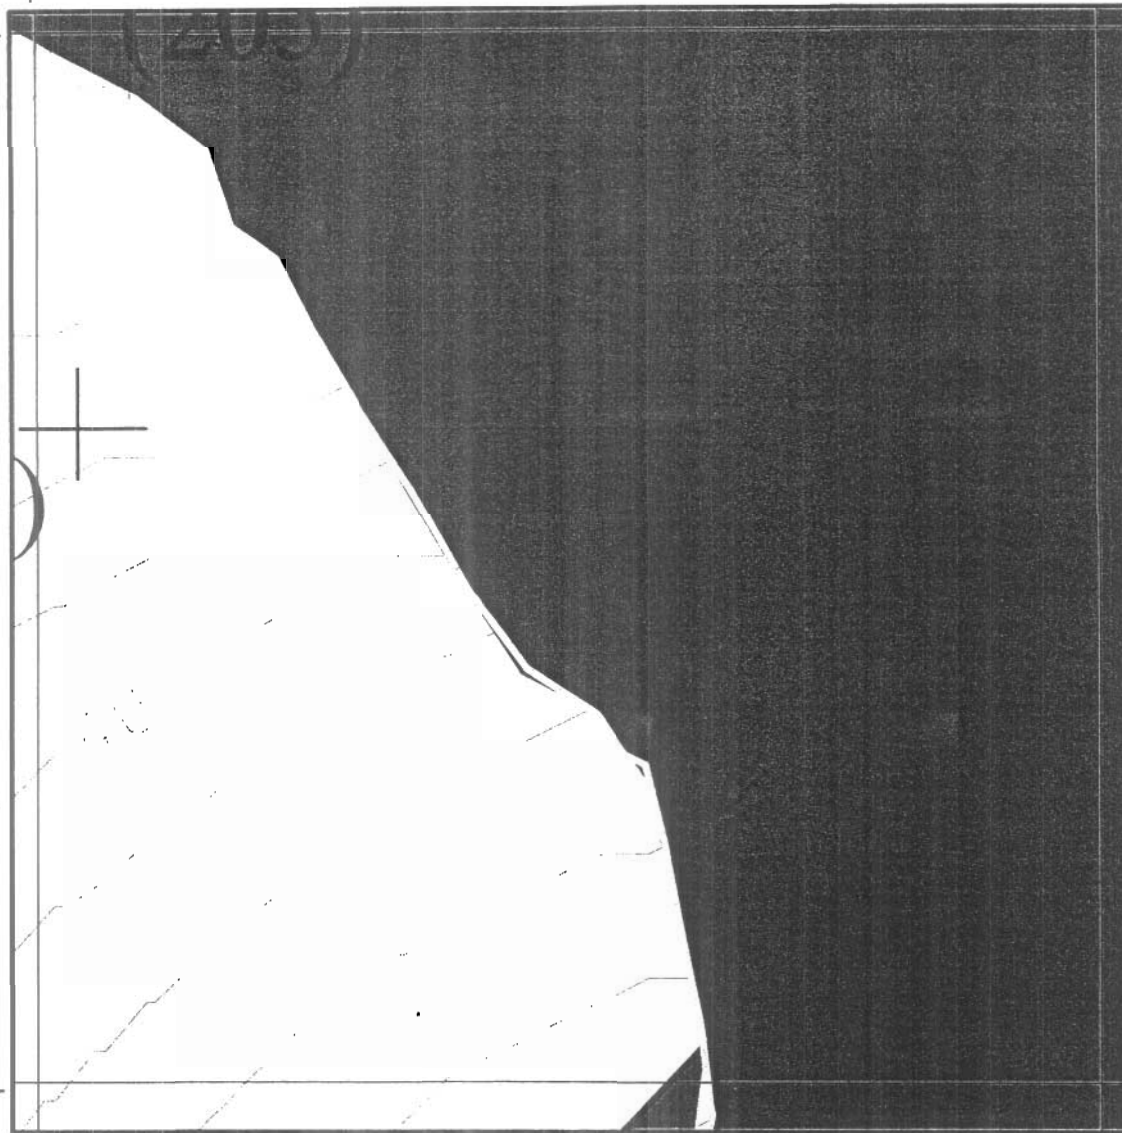

TEXT	Tag or (SN) Sample Number
TEXT	PCB Concentration (ppm)
TEXT	TIER I: PCB Concentration
TEXT	TIER II: PCB Concentration
TEXT	Pink Rope
TEXT	Blue Rope
TEXT	Road
TEXT	Areas Excavated/Vacuumed
TEXT	Debris Piles
TEXT	Clean Fill on TIER II



Comments:

ANALYSIS LOG

Sample (RI04)	Result (ppm)	Comment:

EXCAVATION:
