


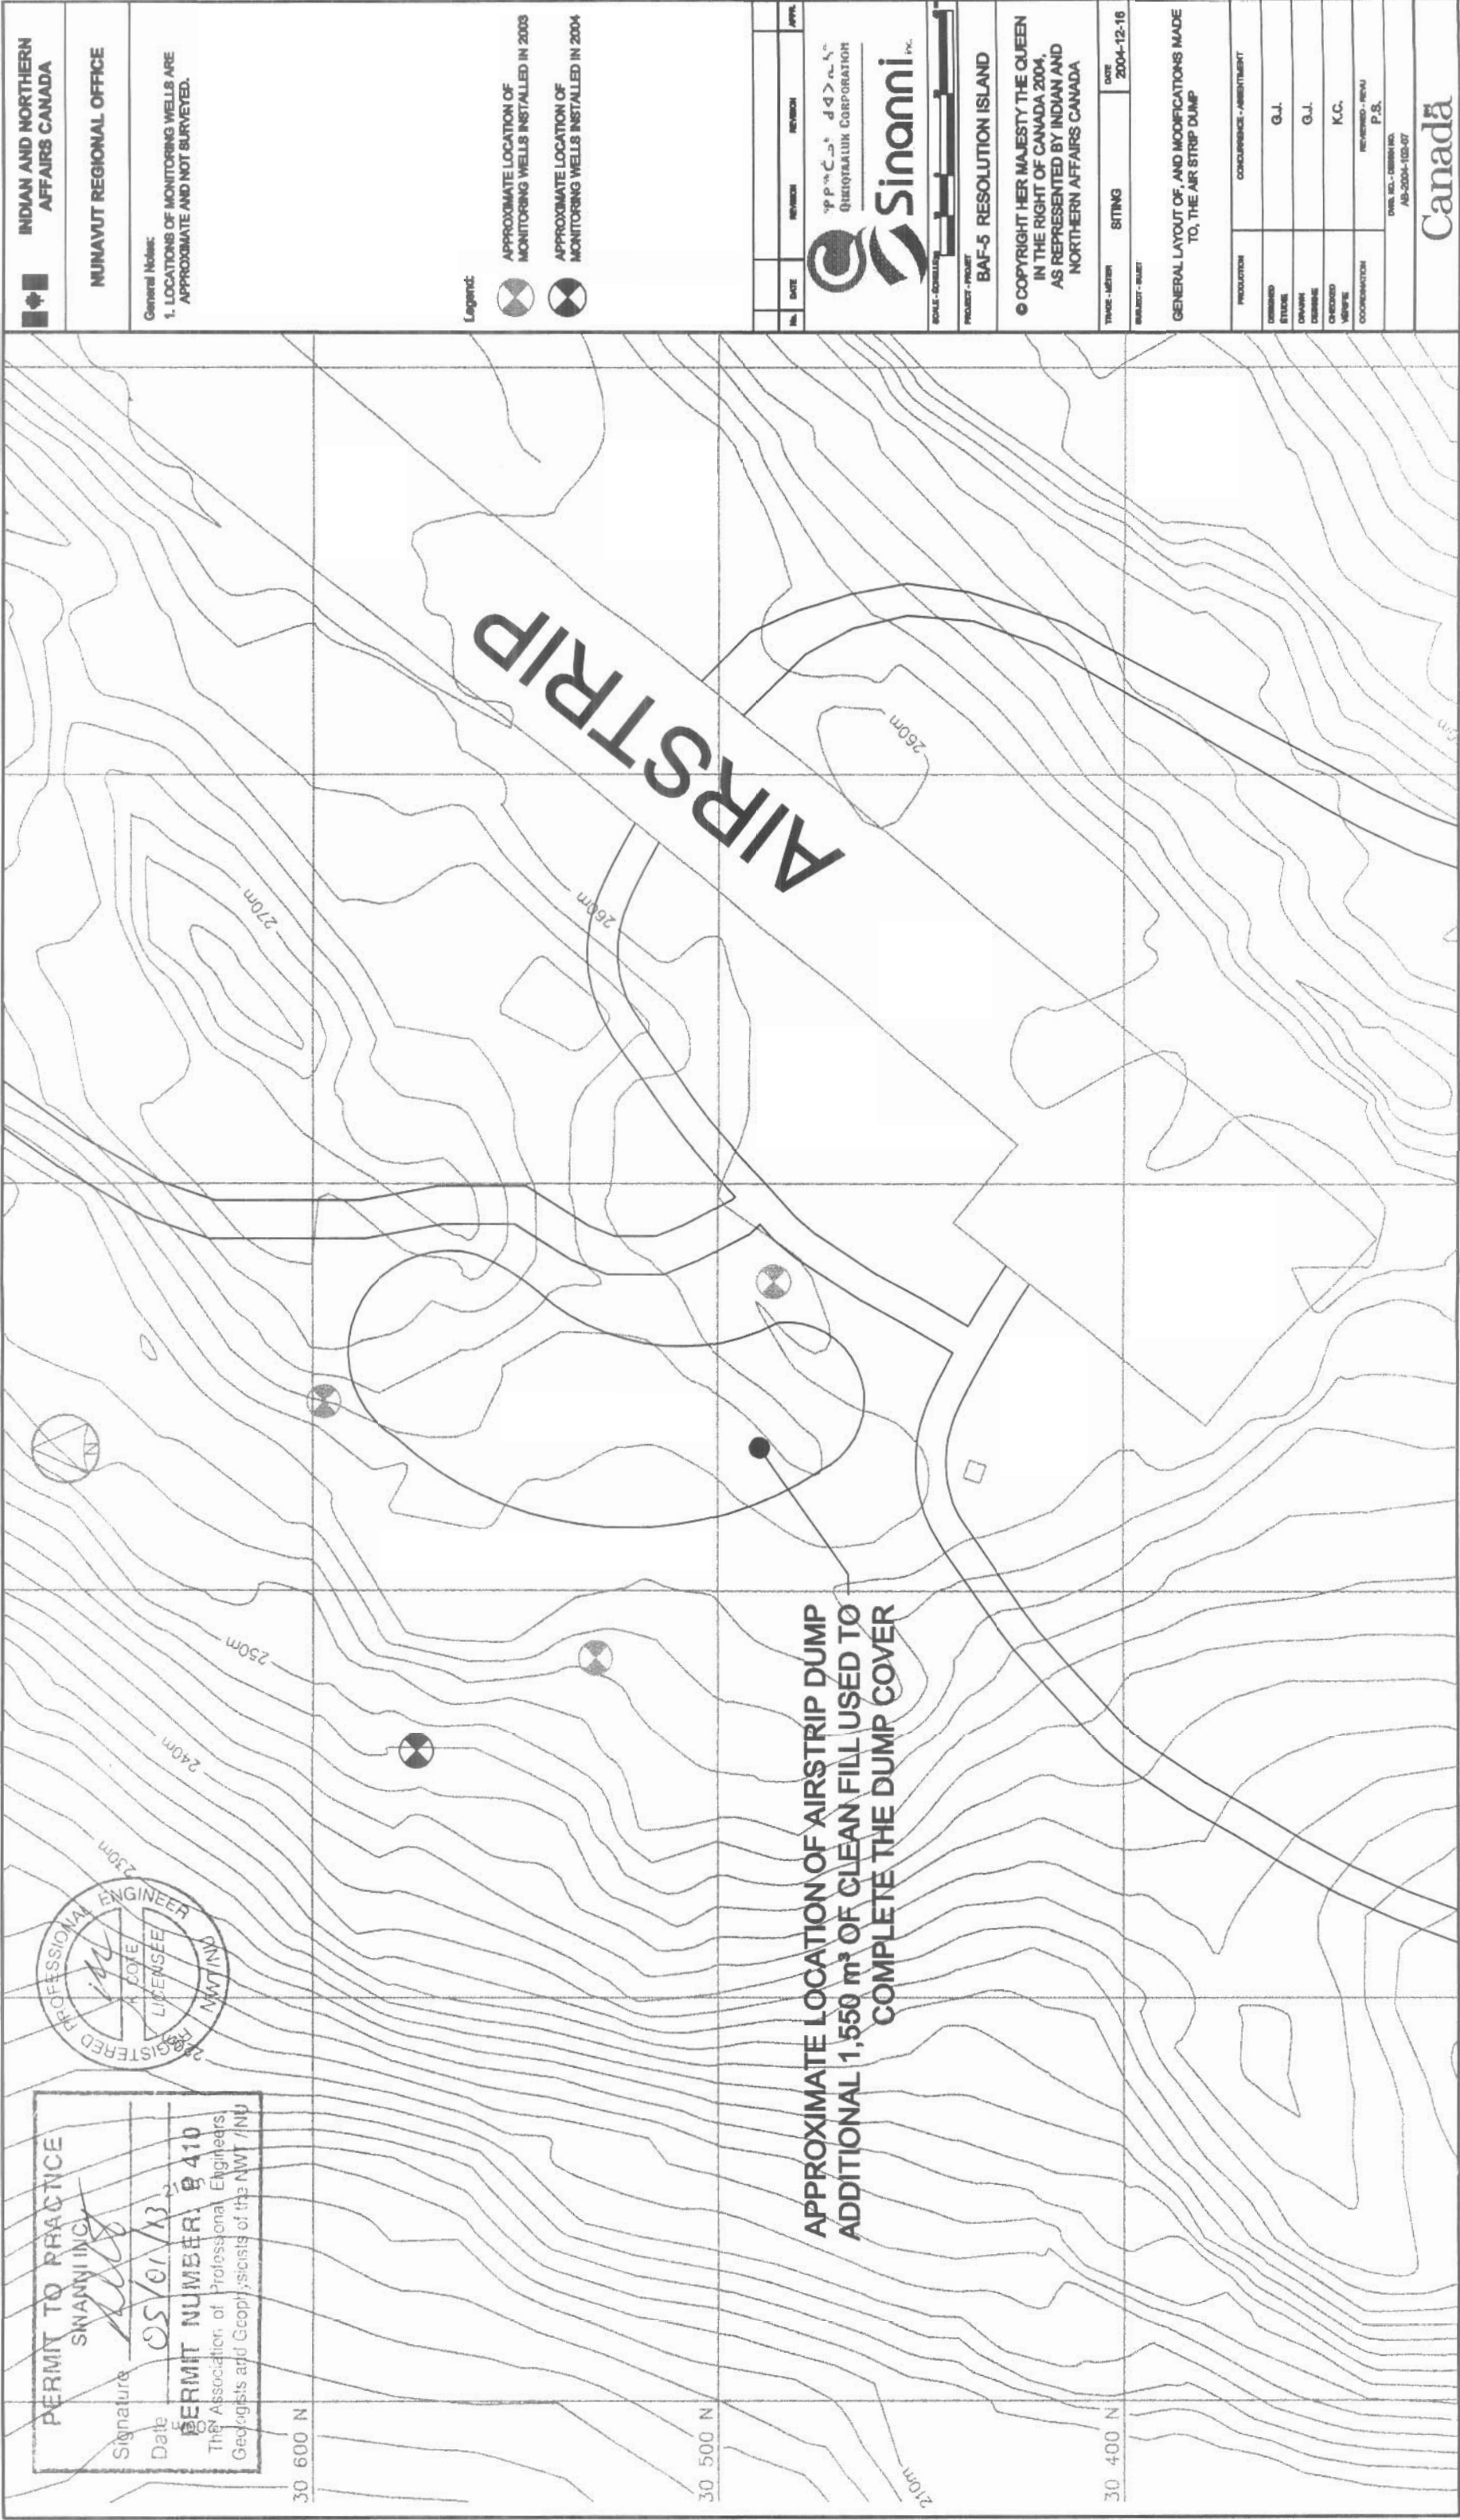

PERMIT TO PRACTICE
SWANNI INC.

Signature: *[Signature]*
Date: 05/01/13
PERMIT NUMBER: 0410
The Association of Professional Engineers,
Geologists and Geophysicists of the NWT / INU



INDIAN AND NORTHERN
AFFAIRS CANADA

NUNAVUT REGIONAL OFFICE

General Notes:
1. LOCATIONS OF MONITORING WELLS ARE
APPROXIMATE AND NOT SURVEYED.

Legend:
APPROXIMATE LOCATION OF
MONITORING WELLS INSTALLED IN 2003
APPROXIMATE LOCATION OF
MONITORING WELLS INSTALLED IN 2004

NO.	DATE	REVISION	REVISION	APPROVED

Queqtaaluk Corporation
Sinanni INC.

SCALE - GRAPHIC

PROJECT - RESOLUTION ISLAND

© COPYRIGHT HER MAJESTY THE QUEEN
IN THE RIGHT OF CANADA 2004,
AS REPRESENTED BY INDIAN AND
NORTHERN AFFAIRS CANADA

TRACED - METRE
SITING
DATE
2004-12-16

GENERAL LAYOUT OF, AND MODIFICATIONS MADE
TO, THE AIR STRIP DUMP

PRODUCTION	CORRESPONDENCE - AMENDMENT
DESIGNED BY: G.J.	
DRAWN BY: G.J.	
CHECKED BY: K.C.	
COORDINATOR NAME: P.S.	

OVERALL NO. - 000001
AB-2004-102-07

Canada

- General Notes:
1. THE DRAWING IS NOW ORIENTED ACCURATELY TO MAGNETIC GRID NORTH BUT MAY BE SEVERAL METERS OFF IN POSITION. UTM WILL BE FINALISED DURING THE 2005 WORK SEASON.
 2. BENCH MARKS 1 AND 2 ARE MEDALLIONS SET IN BEDROCK (NOT SHOWN).
 3. BENCHMARKS 4 AND 6 ARE A CROSS CHISELLED INTO BEDROCK WITH A 3/8 INCH HOLE DRILLED IN THE MIDDLE.
 4. BENCHMARKS 5, 7 WERE COVERED DURING THE LANDFILL CONSTRUCTION.
 5. BENCHMARK 3 WAS COVERED DURING THE CONSTRUCTION OF THE LAND FARM.
 6. MONITORING WELLS INSTALLED DURING THE 2004 SEASON WILL BE SURVEYED IN 2005.

- Legend:
- MONITORING WELL LOCATION
 - PERMANENT CULVERT

NO.	DATE	REVISION	APPROVED


SINANNI INC.
QULIQTALUK CORPORATION




PROJECT - RESOLUTION ISLAND

© COPYRIGHT HER MAJESTY THE QUEEN
IN THE RIGHT OF CANADA 2004,
AS REPRESENTED BY INDIAN AND
NORTHERN AFFAIRS CANADA

TRADE - METRIC	SITING	DATE
2004-12-15		

SURVEYED DRAWING OF THE TIER II LANDFILL AREA

PRODUCTION	CONCURRENCE - AMENDMENT
DESIGNED	G.J.
DRAWN	G.J.
CHECKED	K.C.
COORDINATION	REVIEWED - NEW P.S.

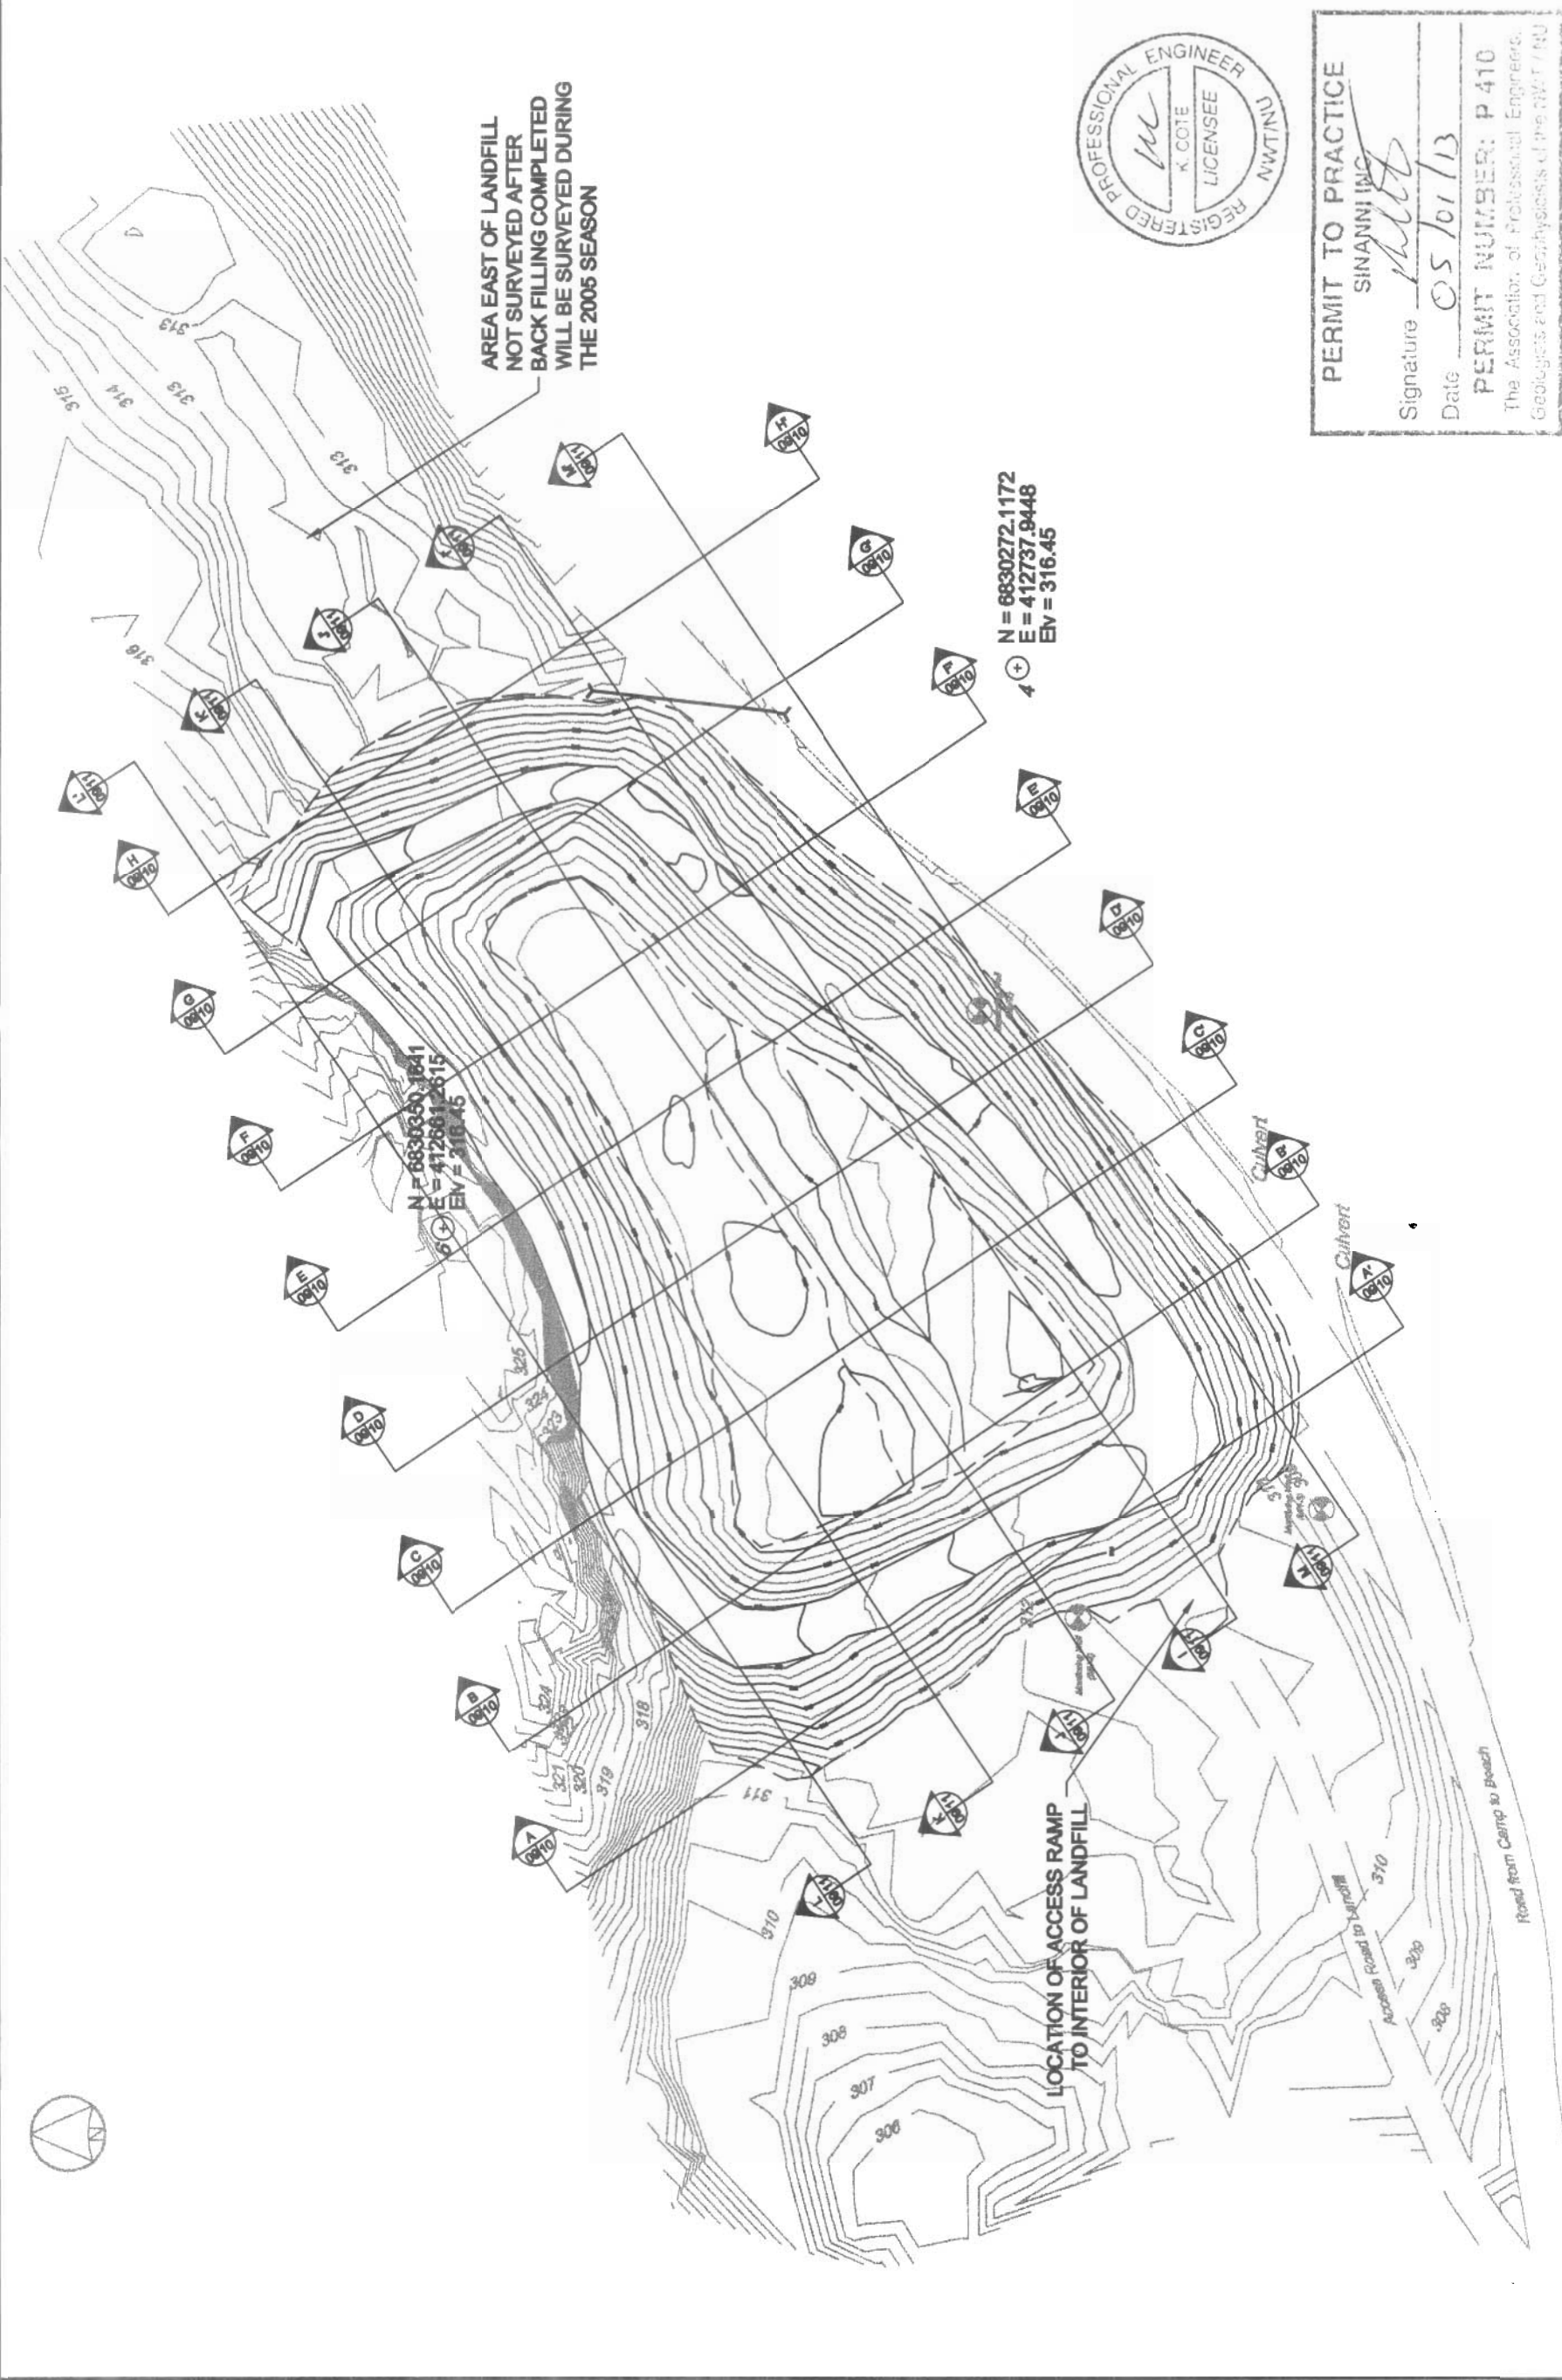

PERMIT TO PRACTICE
SINANNI INC.
Signature: *[Signature]*
Date: 05/01/13
PERMIT NUMBER: P 410
The Association of Professional Engineers,
Geologists and Geophysicists of the NWT / NNU

General Notes:
1. GREY LINES REPRESENT NATURAL GROUND ELEVATION. BLACK LINES REPRESENT THE GROUND ELEVATIONS AT THE END OF THE 2004 WORK SEASON.

Legend:

NO.	DATE	REVISION	REVISION	APPROVAL


Sinanni INC.

AS SHOWN

PROJECT - PROJECT
BAF-5 RESOLUTION ISLAND


© COPYRIGHT HER MAJESTY THE QUEEN
IN THE RIGHT OF CANADA 2004.
AS REPRESENTED BY INDIAN AND
NORTHERN AFFAIRS CANADA

TRACER - METER	SITING	DATE
		2004-12-16

CROSS-SECTIONS OF THE TIER II LANDFILL
(DRAWING 1 OF 2)

PRODUCTION	CONCURRENCE - ASSIGNMENT
DRAWN BY: G.J.	G.J.
CHECKED BY: G.J.	G.J.
VERIFIED BY: K.C.	K.C.
COORDINATION	REVIEWED - N/A


DRAWN BY: G.J.
P.S.
AB-3204-102-10

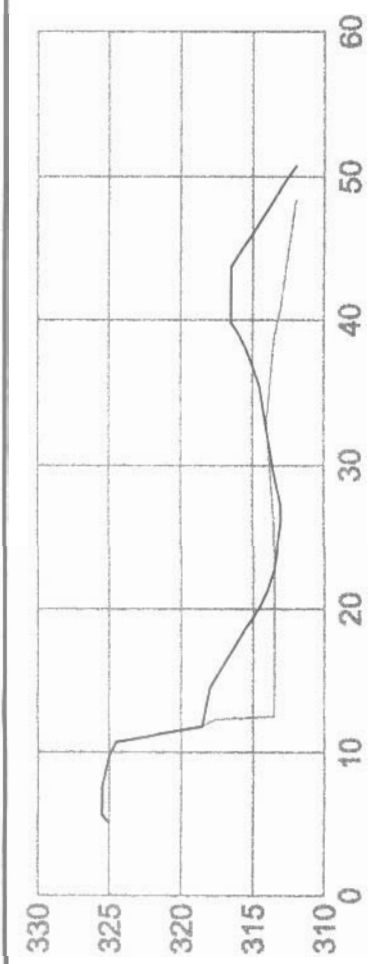

A-A'
09/10




E-E'
09/10

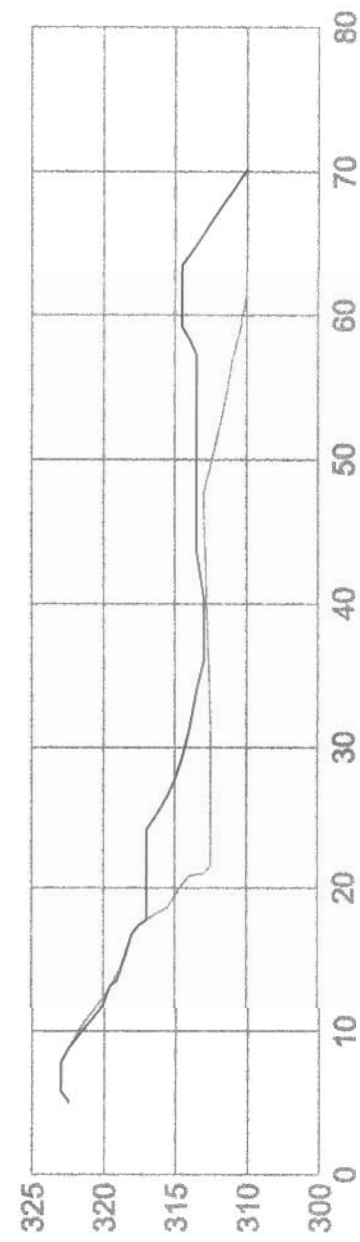


B-B'
09/10


F-F'
09/10

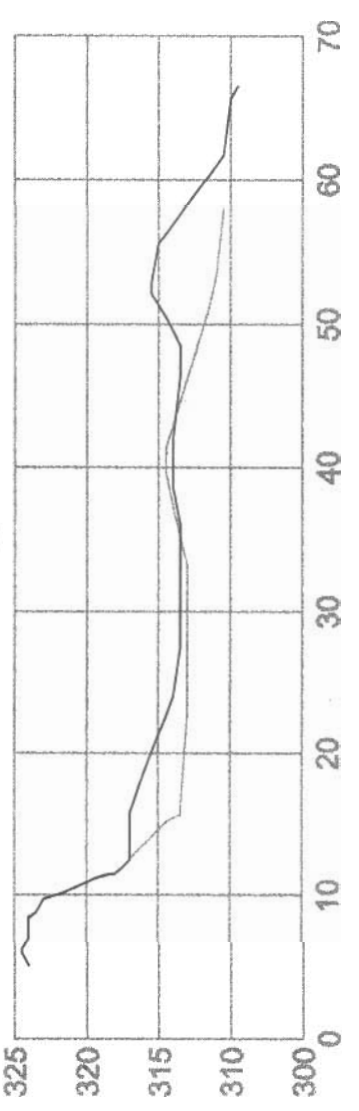


C-C'
09/10

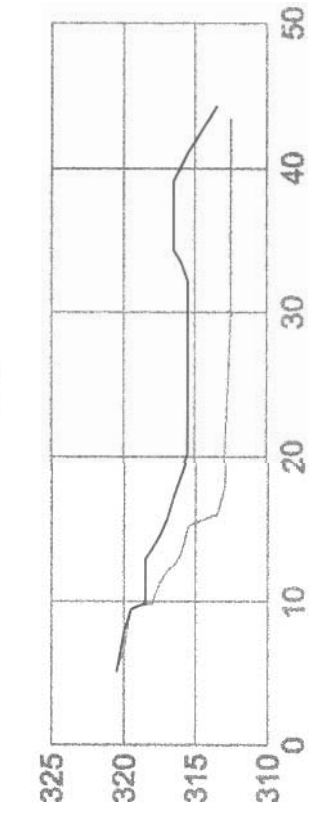

G-G'
09/10

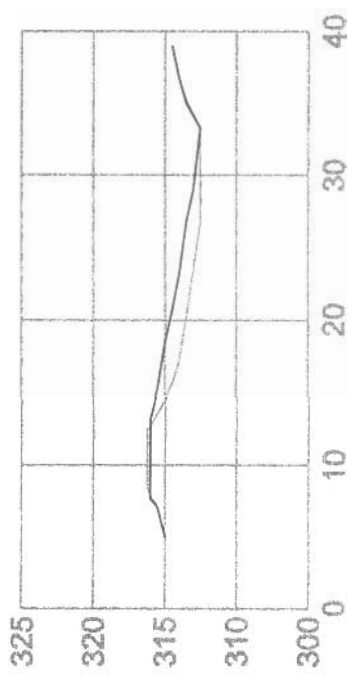

H-H'
09/10

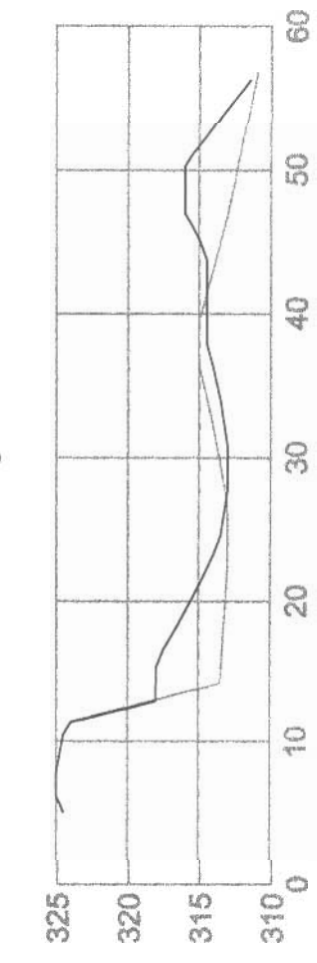


D-D'
09/10




PERMIT TO PRACTICE
SINANNI INC.

Signature: *K. Cote*
Date: 05/01/13


PERMIT NUMBER: P 410
The Association of Professional Engineers,
Geologists and Geophysicists of the NWT / NLU

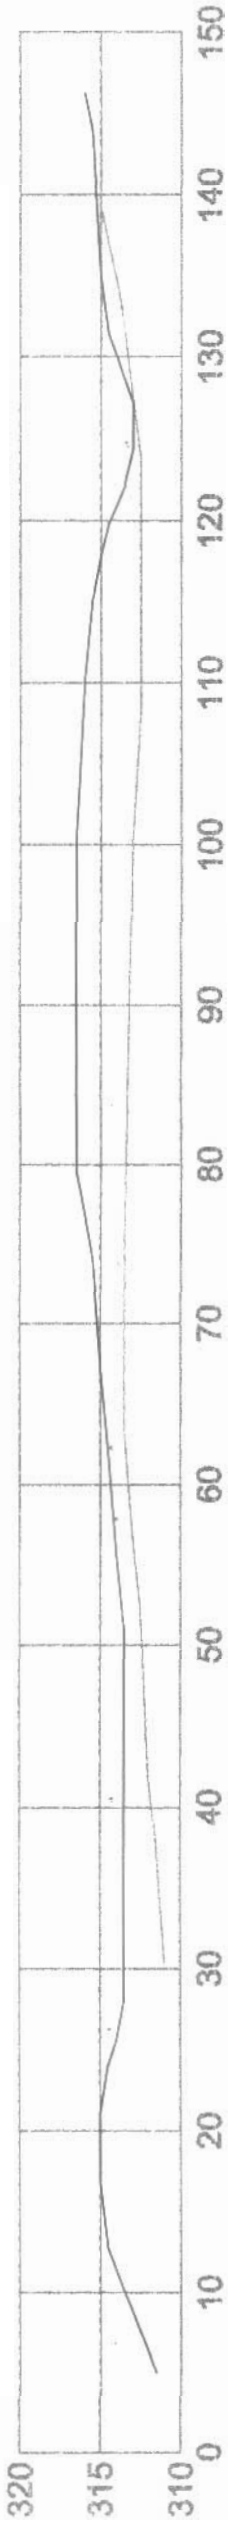


I-I'
09/11

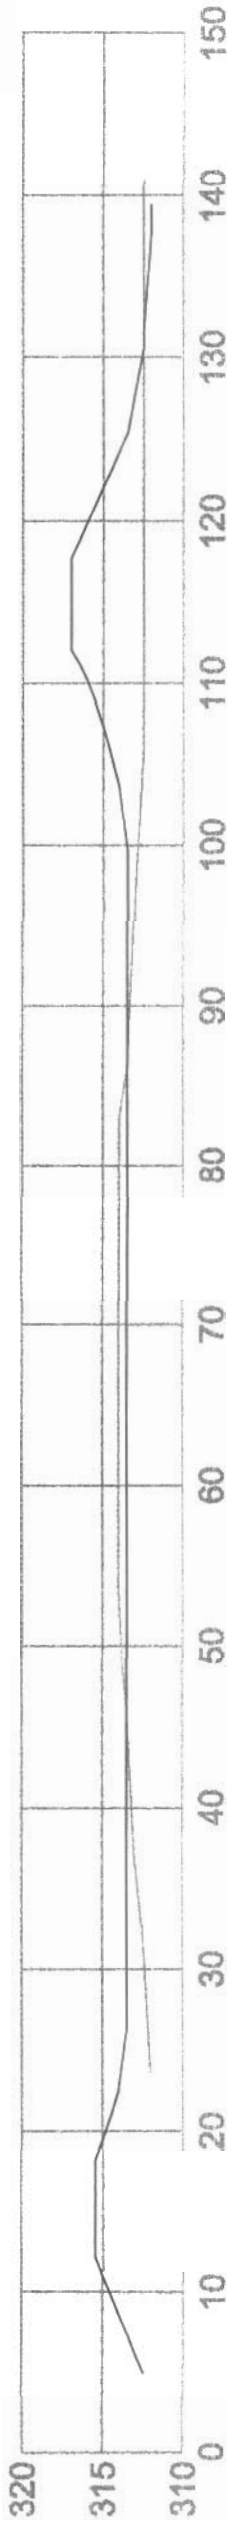


J-J'
09/11

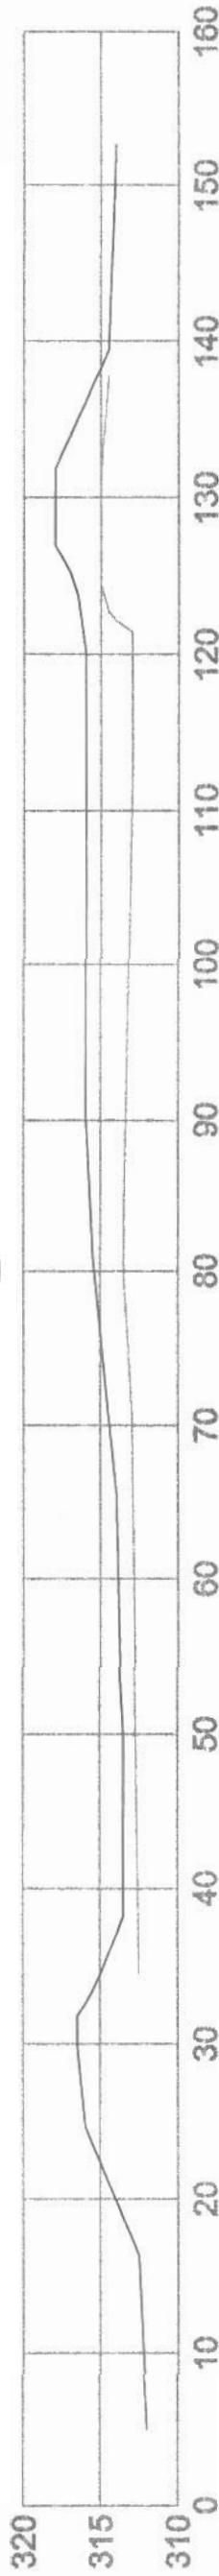

K-K'
09/11

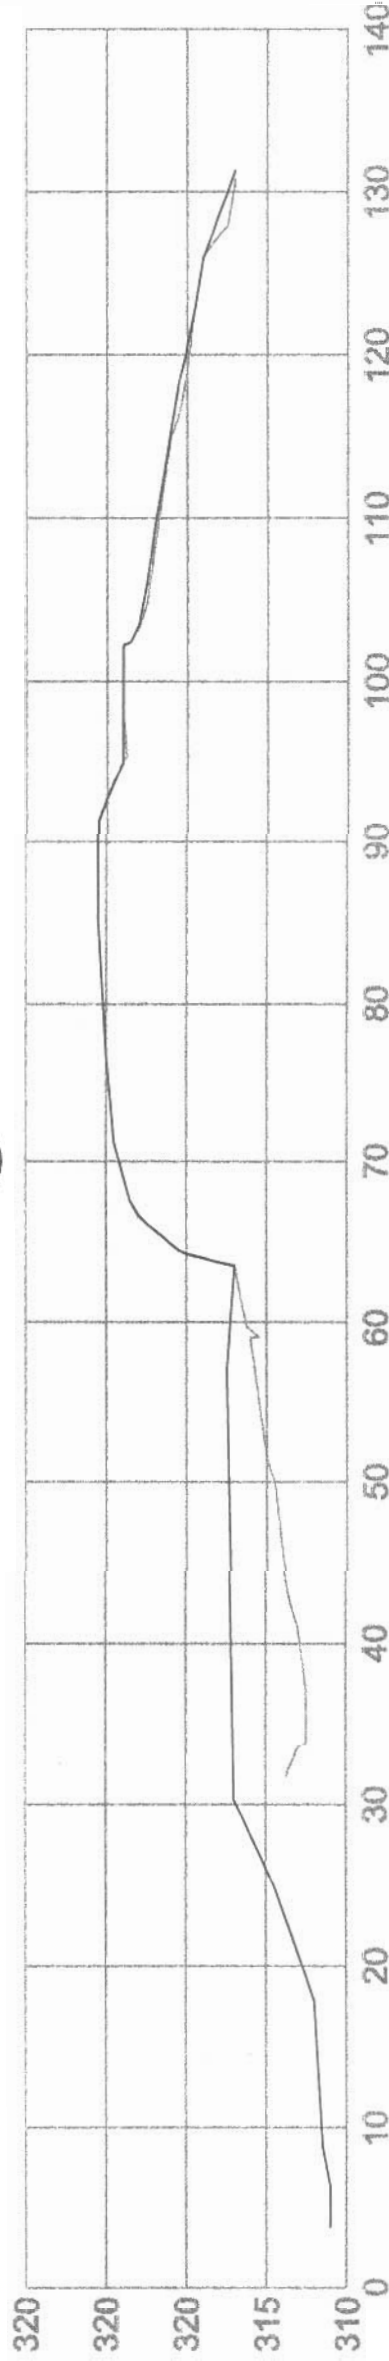

L-L'
09/11

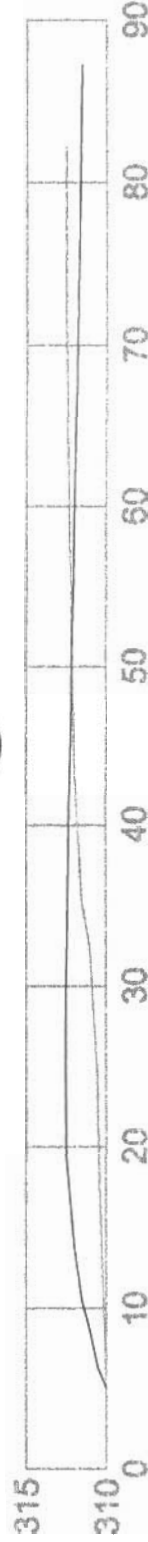

M-M'
09/11

PERMIT TO PRACTICE
SINANNI INC.
Signature *[Signature]*
Date 05/01/13
PERMIT NUMBER: P410
The Association of Professional Engineers,
Geotechnical and Geophysics Division

**INDIAN AND NORTHERN AFFAIRS CANADA**

NUNAVUT REGIONAL OFFICE

General Notes:
1. GREY LINES REPRESENT NATURAL GROUND ELEVATION. BLACK LINES REPRESENT THE GROUND ELEVATIONS AT THE END OF THE 2004 WORK SEASON.

NO.	DATE	REVISION	REVISION	APPROVED
1				

**Sinanni Inc.**
QINNIQAATUK CORPORATION

SCALE: AS SHOWN

PROJECT: BAF-5 RESOLUTION ISLAND

© COPYRIGHT HER MAJESTY THE QUEEN IN THE RIGHT OF CANADA 2004, AS REPRESENTED BY INDIAN AND NORTHERN AFFAIRS CANADA

TIME - SET	STING	DATE
		2004-12-18

CROSS-SECTIONS OF THE TIER II LANDFILL (DRAWING 2 OF 2)

PRODUCTION	CONCURRENCE - AMENDMENT
DRAWING	G.J.
DESIGN	G.J.
COORDINATION	K.C.
REVIEWED - NEW	P.S.

DATE: 05-01-13
P.S.

Canada

