






Appendix B: Non-Hazardous Waste Landfill Location Map

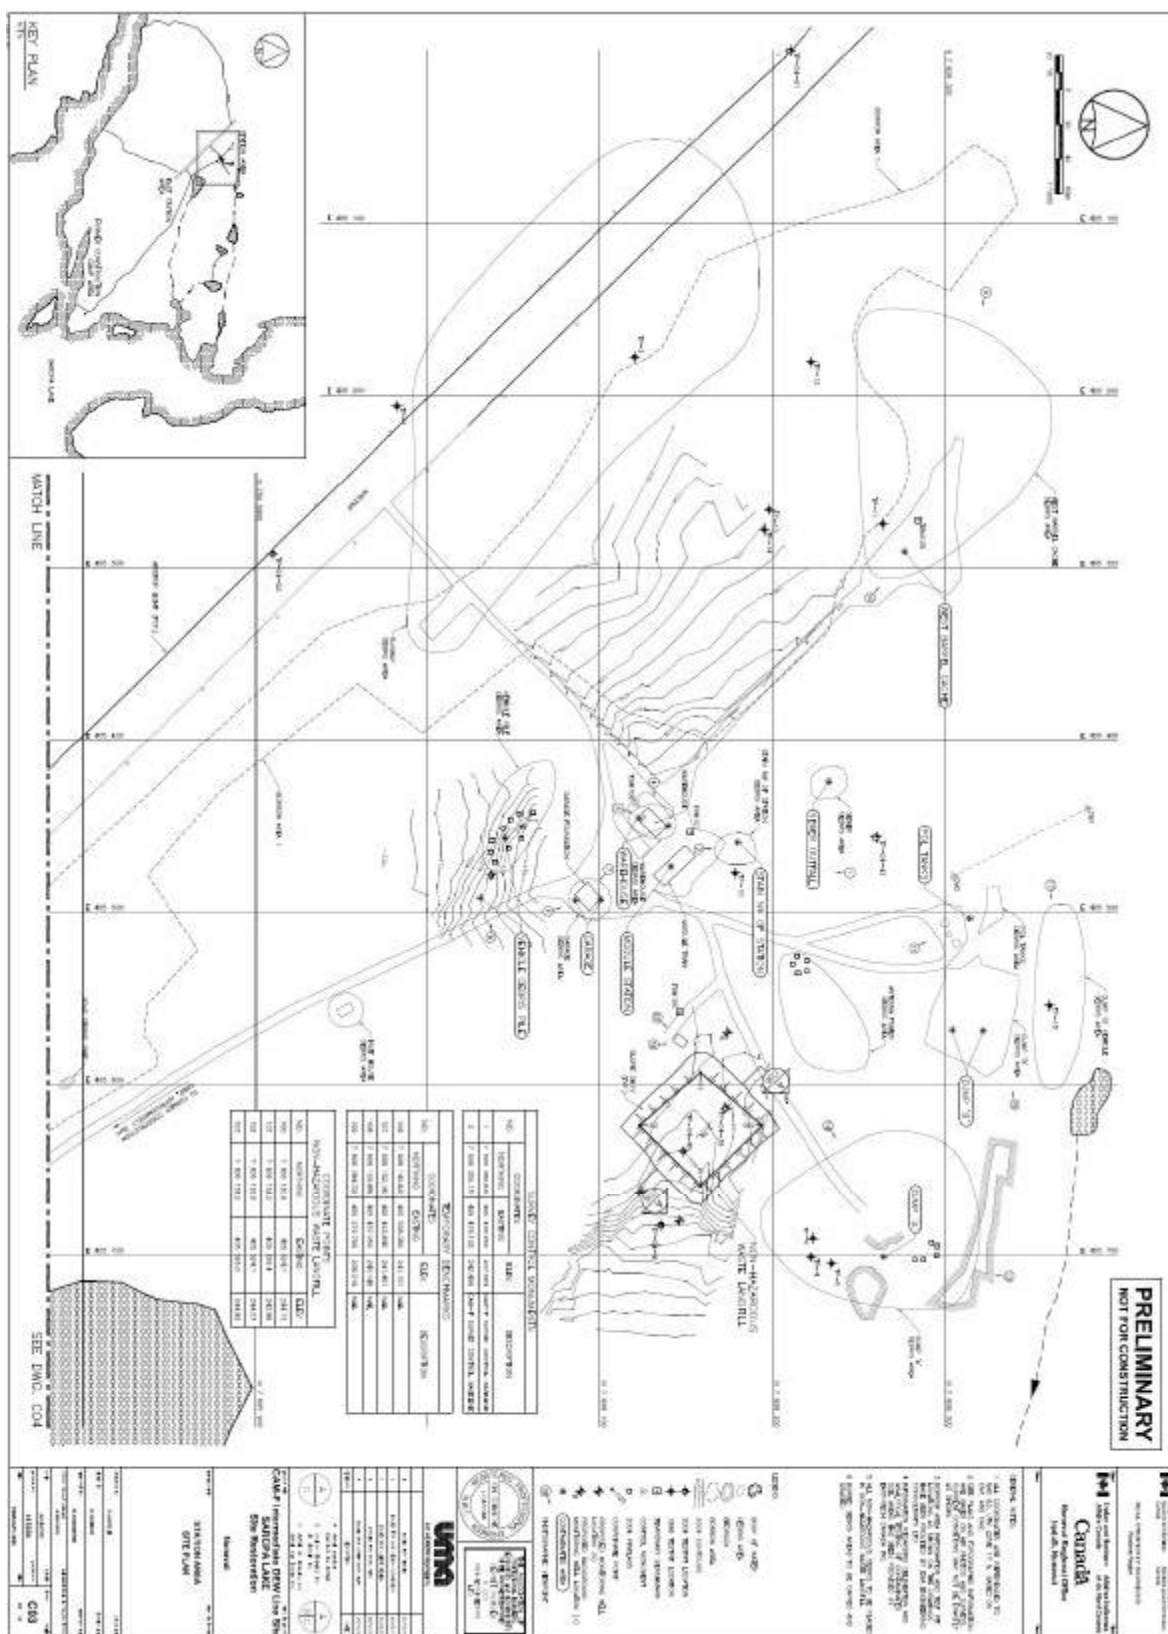



Appendix C: Non-Hazardous Waste Landfill As-Built Drawings

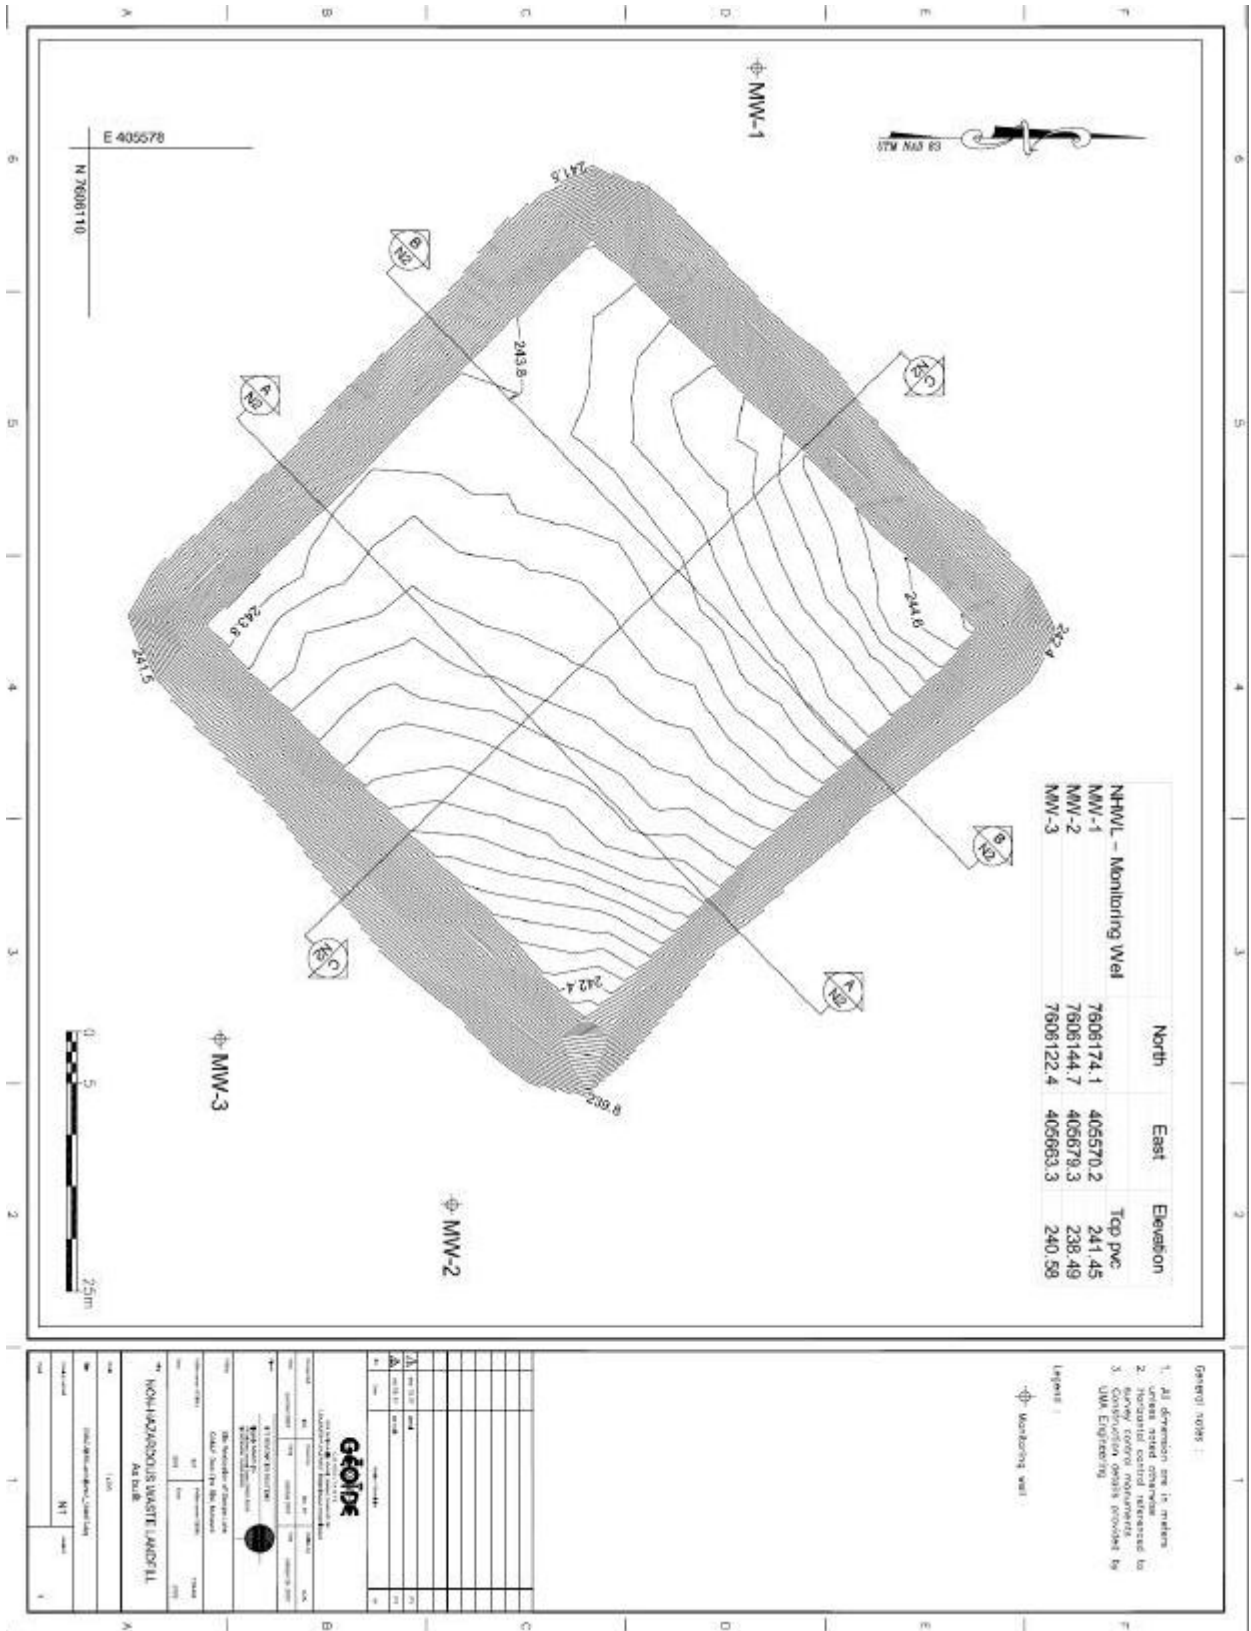

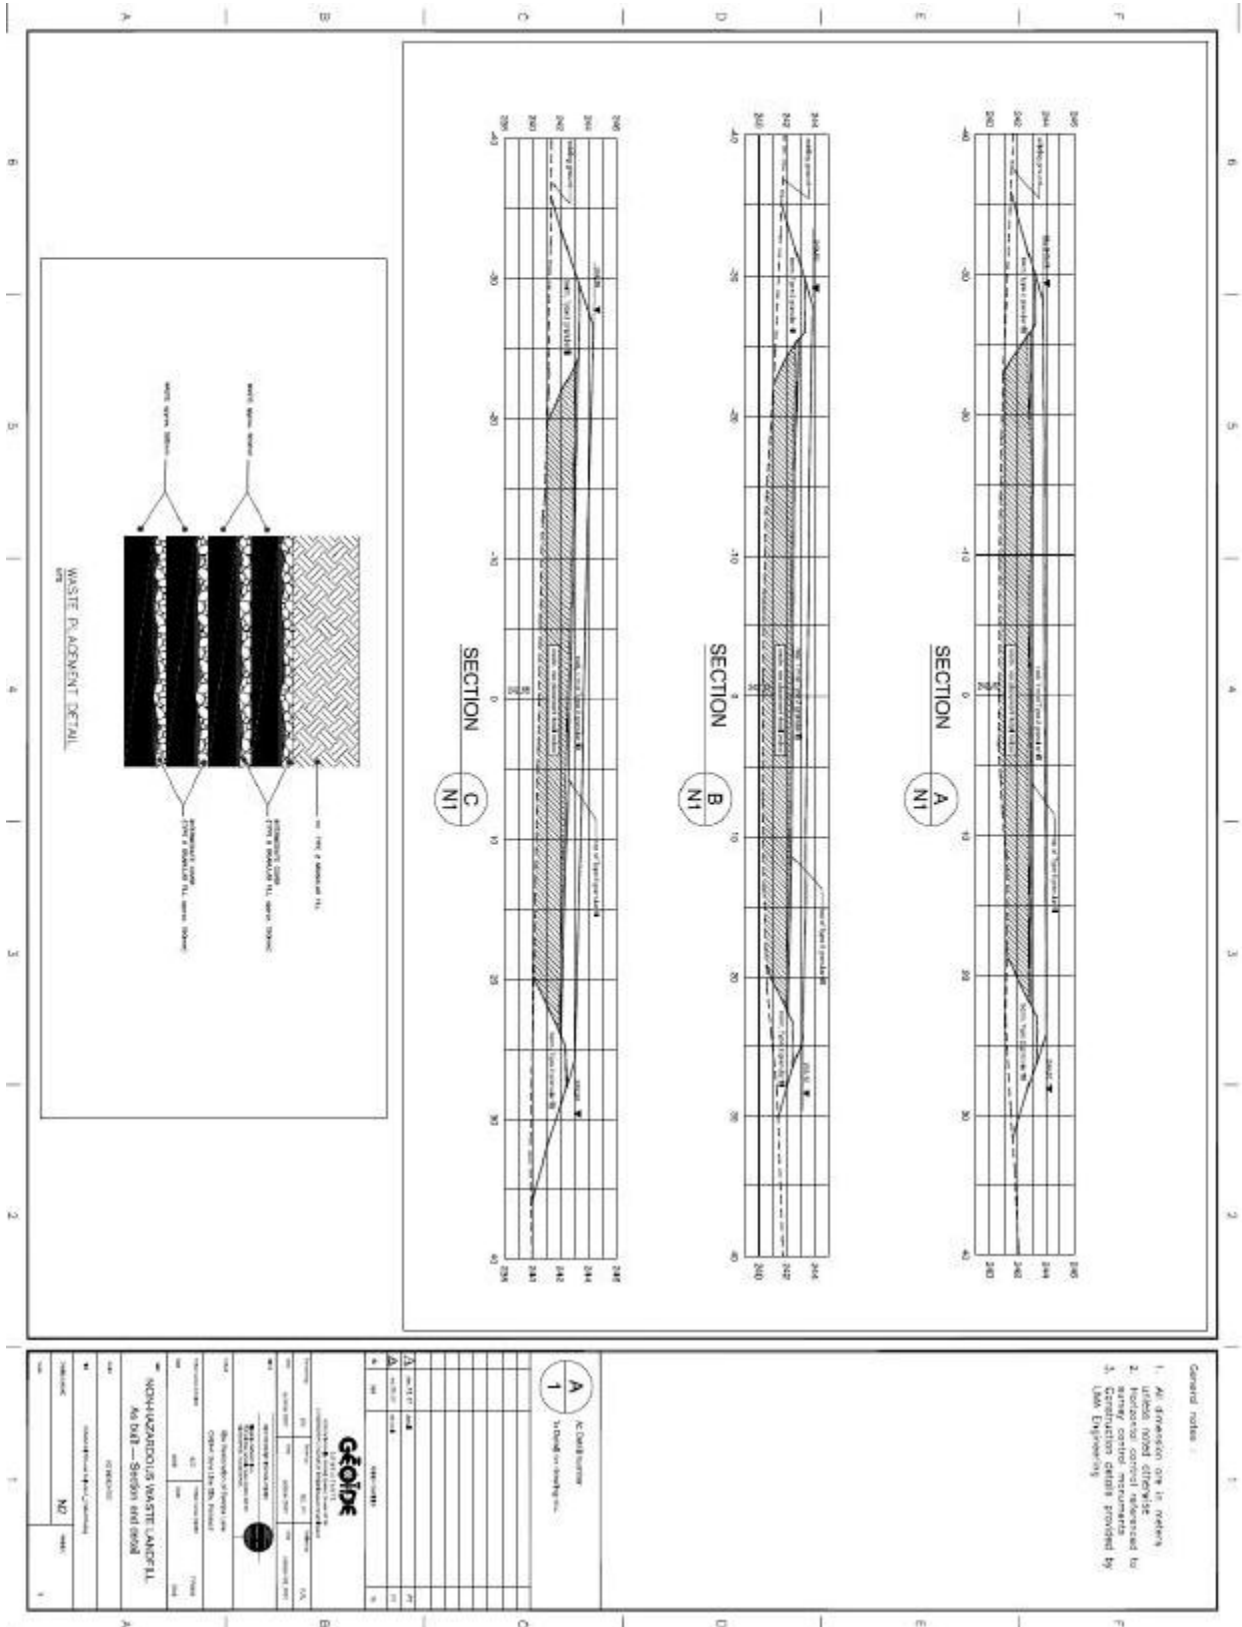



Appendix D: Visual Monitoring Checklist



CAM-F SARCPA LAKE VISUAL MONITORING CHECKLIST

Date:	
Landfill:	
<i>Visually assess the landfill for the following items & provide a photograph record</i>	
1. Erosion	Answer
a) Is erosion occurring on the surface or berms of the landfill?	
i) Are there preferred drainage channels?	
ii) Is there sloughing of material?	
b) What is the extent of the erosion? <i>(percentage of surface area)</i>	
i) Is it localized or continuous?	
c) Where is the erosion occurring? <i>(i.e. along the toe, on the surface, through the berms)</i>	
d) Explanation: <i>(i.e. evidence of significant surface water run-off, poor material)</i>	
2. Settlement	Answer
a) Is there differential settlement occurring on the surface?	
i) Are there low areas or depressions?	
ii) Are voids forming?	
b) What is the extent of the settlement? <i>(percentage of surface area)</i>	
i) Is it localized or continuous?	
ii) How deep is it?	
c) Where is the settlement occurring? <i>(i.e. near berms, near the centre of the facility)</i>	
d) Explanation: <i>(i.e. evidence of significant surface infiltration, water ponding, snow drifting)</i>	
3. Frost Action	Answer
a) Is there frost action/damage to the landfill?	
i) Is there exposed debris due to uplift?	
ii) Is there tension cracking along the berms?	
iii) Is there sorting of granular fill?	
b) What is the extent of the frost action? <i>(percentage of surface area)</i>	
i) Is it localized or continuous?	
c) Where is the heaving/cracking occurring? <i>(i.e. along the toe, on the surface, through the berms)</i>	
d) Explanation: <i>(i.e. poor material, poor compaction, high water/silt content in cover material)</i>	
4. Monitoring Instruments	
a) What is the condition of the monitoring wells and thermistor strings <i>(if applicable)</i> ?	




5. Sketch

6. General Comments




Appendix E: Secure Soil Disposal Facility Location Map

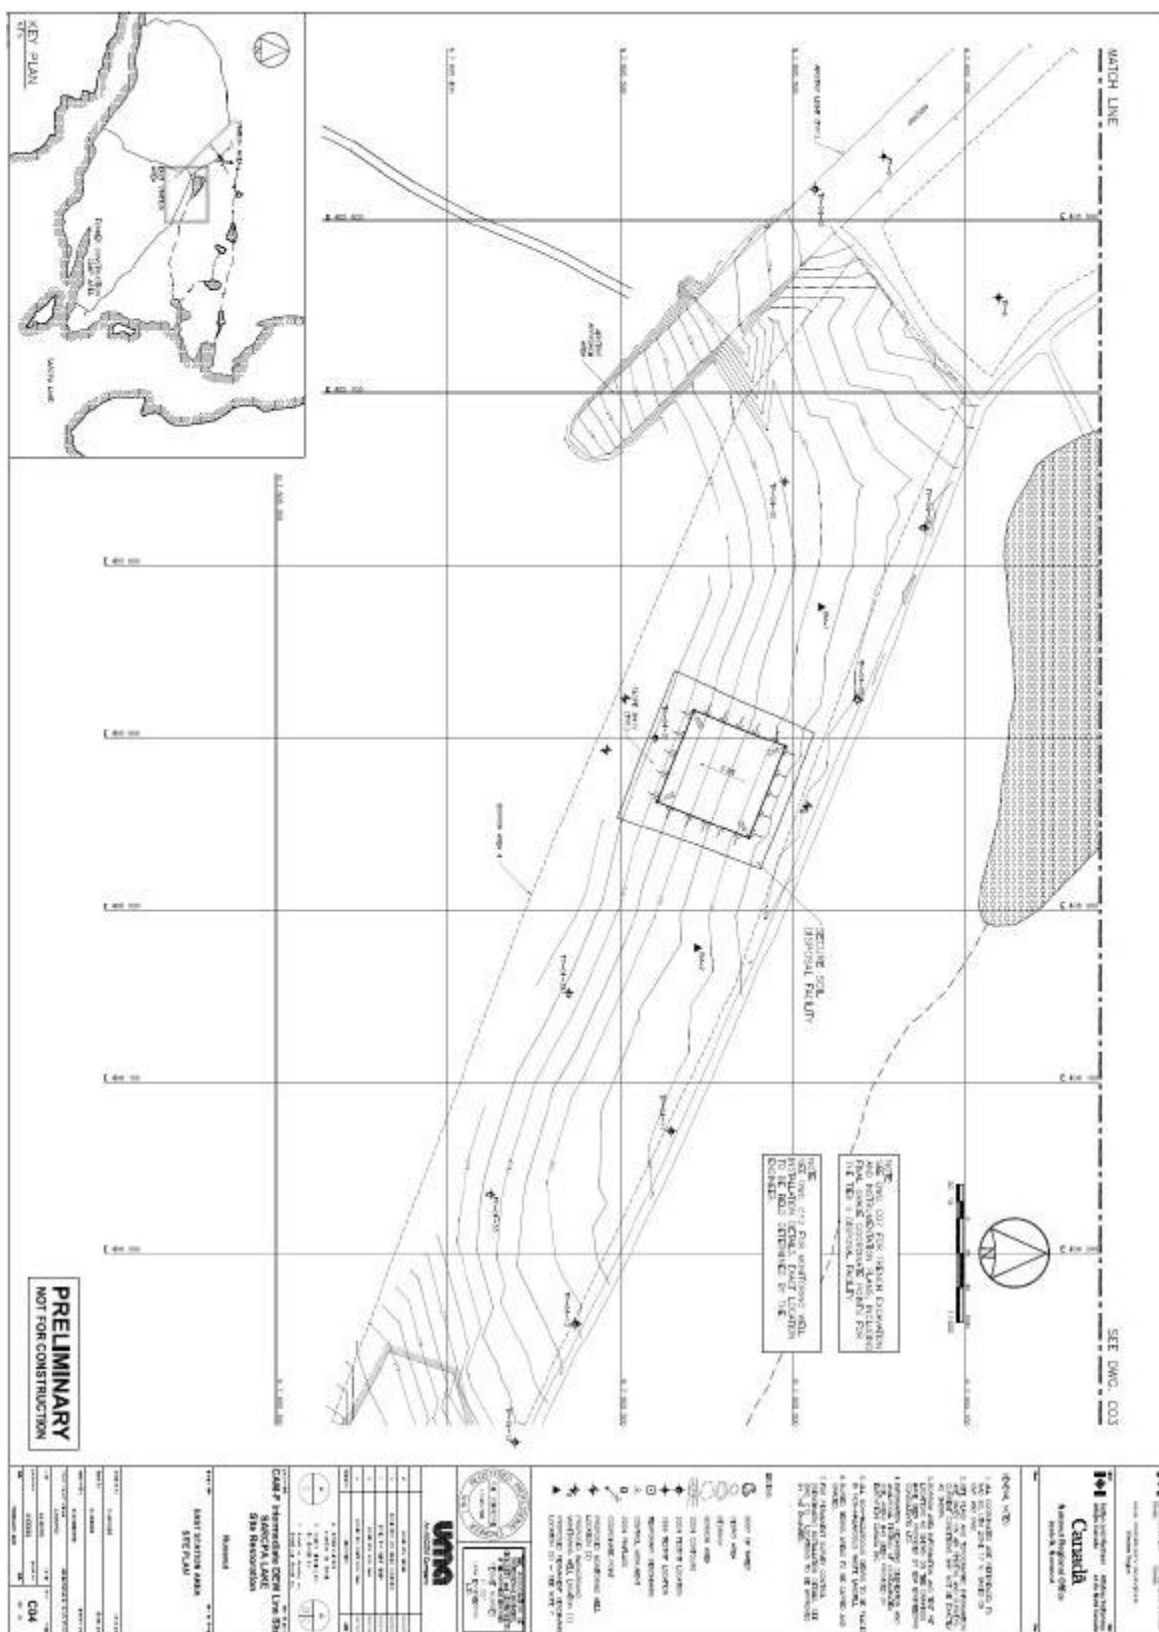



Appendix F: Secure Soil Disposal Facility As-Built Drawing

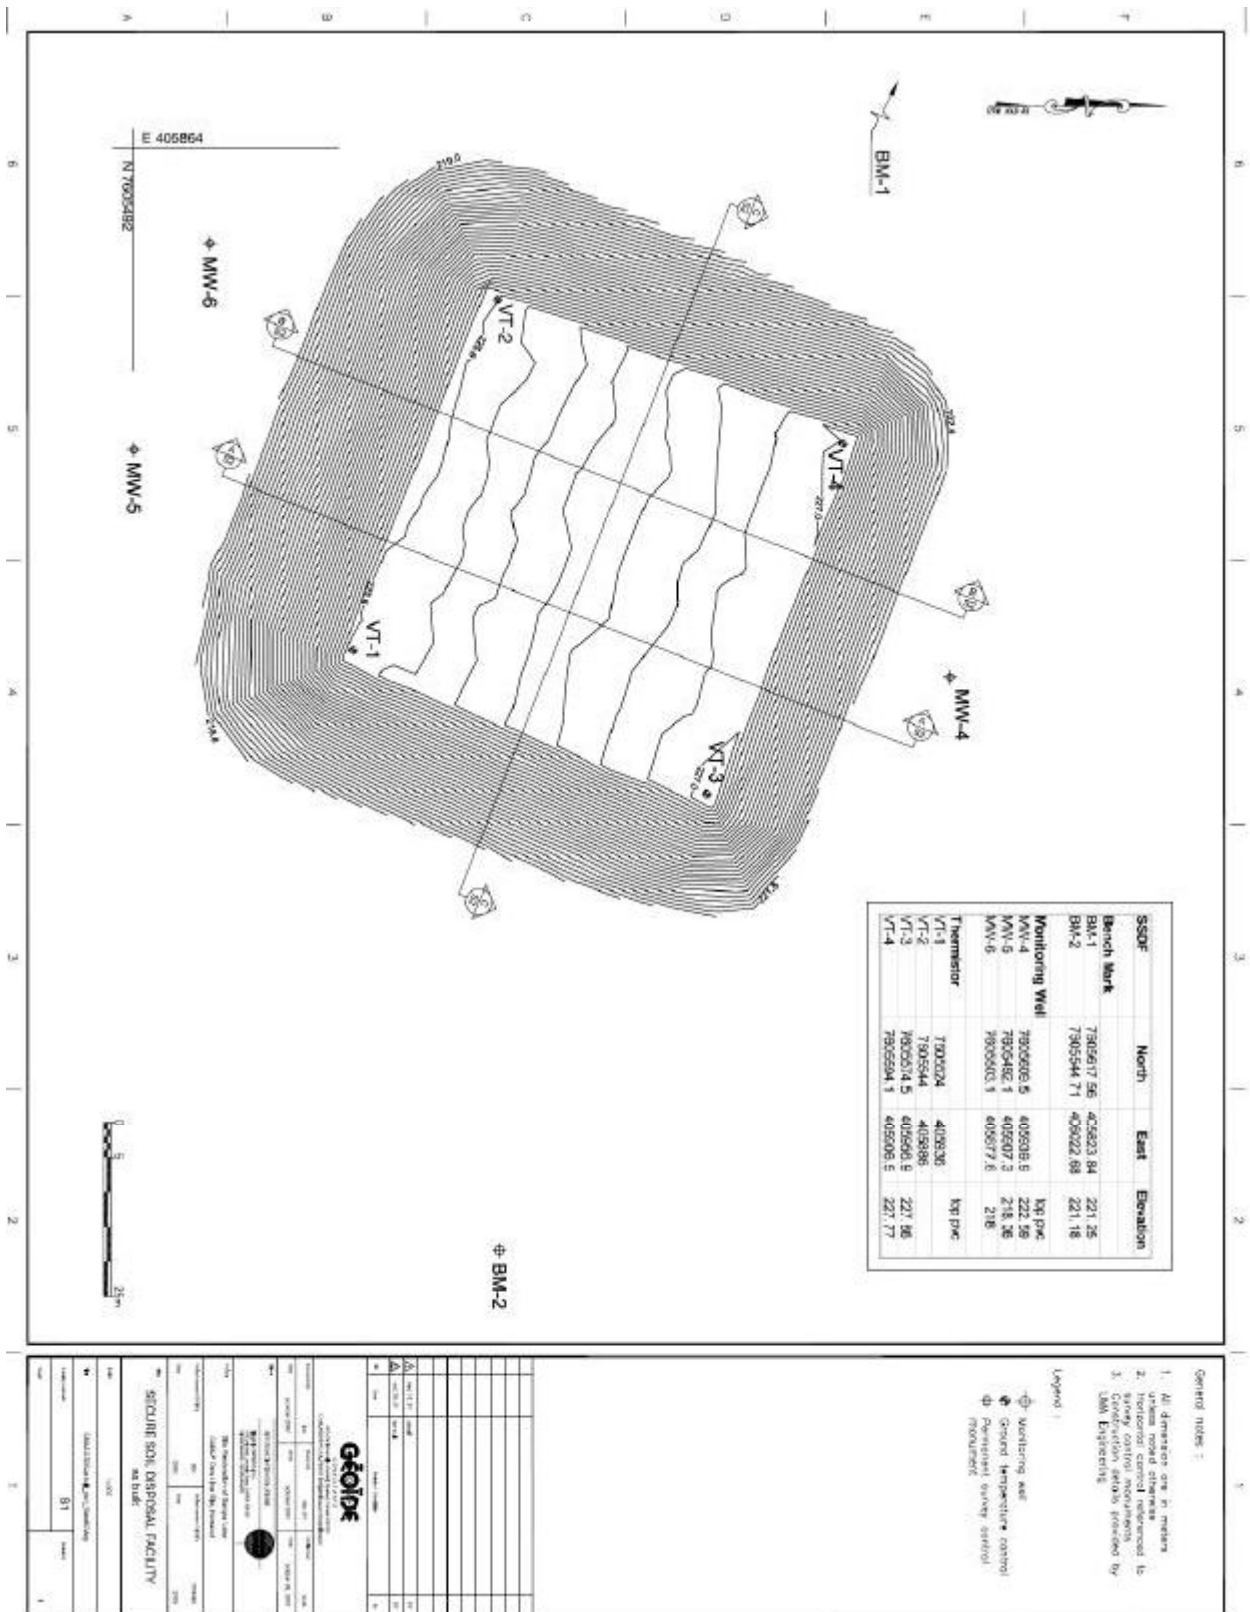




Appendix G: Thermistor (Ground Temperature Cable) Installation Reports



CAM-F DEW LINE CLEAN UP PROJECT
GROUND TEMPERATURE CABLE INSTALLATION REPORT


SITE: SSDF SE & SW CORNERS	CABLE INSTALLATION NO.: 3
LOCATION NORTHING: -	CABLE SERIAL NO.: CAMF VTO1
GROUND ELEVATION: -	EASTING: -
CABLE LENGTH: 7.8 m	DATE: SEPT. 2007
CABLE LENGTH ABOVE GROUND: 3.0 m	LEAD LENGTH: 3.0 m
NUMBER OF BEADS: 11	FIRST BEAD ELEVATION: 0 m BOG
	HOLE DEPTH: 4.8 m
	VT01 STICKUP: 76 cm

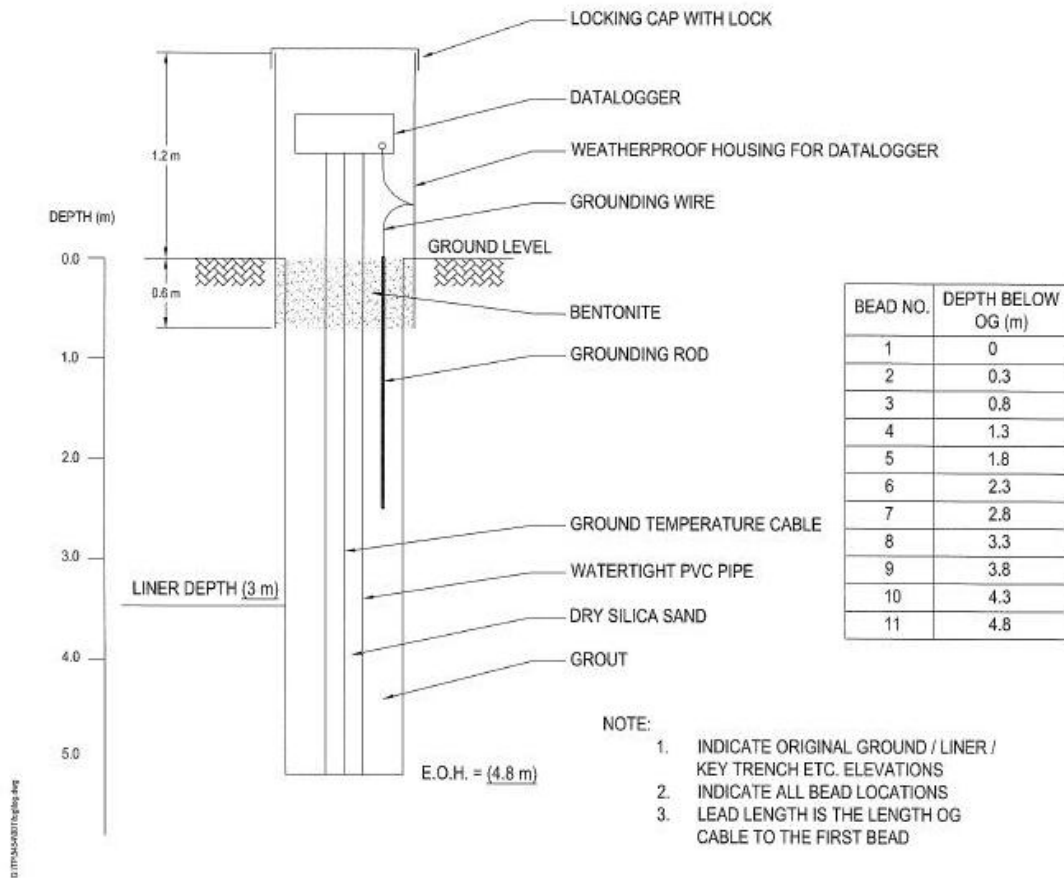



CAM-F DEW LINE CLEAN UP PROJECT
GROUND TEMPERATURE CABLE INSTALLATION REPORT


SITE: SSDF SE & SW CORNERS	CABLE INSTALLATION NO.: 4
LOCATION NORTHING: -	CABLE SERIAL NO.: CAMF VT02
GROUND ELEVATION: -	EASTING: -
CABLE LENGTH: 7.8 m	DATE: SEPT. 2007
CABLE LENGTH ABOVE GROUND: 3.0 m	LEAD LENGTH: 3.0 m
NUMBER OF BEADS: 11	FIRST BEAD ELEVATION: 0 m BOG
	HOLE DEPTH: 4.8 m
	VT02 STICKUP: 90 cm

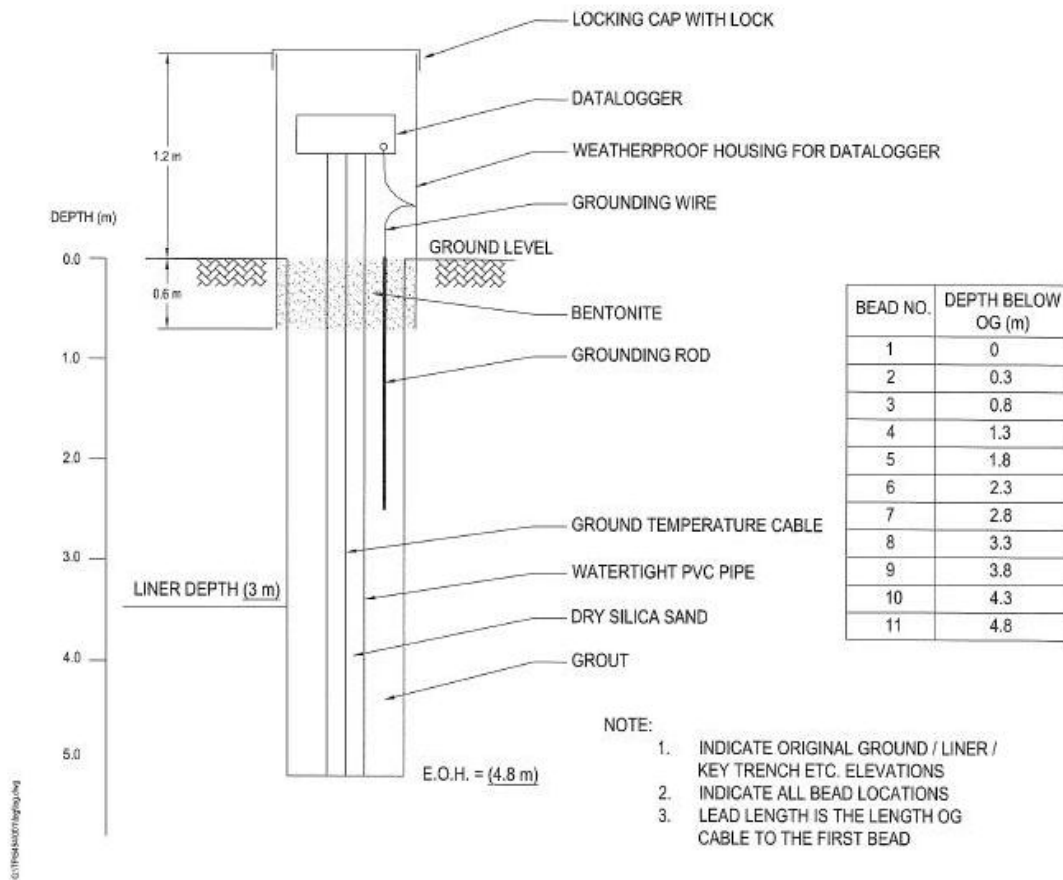



CAM-F DEW LINE CLEAN UP PROJECT
GROUND TEMPERATURE CABLE INSTALLATION REPORT

SITE: SSDF NE & NW CORNERS	CABLE INSTALLATION NO.: 1
LOCATION NORTHING: -	CABLE SERIAL NO.: CAMF VT03
GROUND ELEVATION: -	EASTING: -
CABLE LENGTH: 8.4 m	DATE: SEPT. 2007
CABLE LENGTH ABOVE GROUND: 1.5 m	LEAD LENGTH: 3.0 m
NUMBER OF BEADS: 12	FIRST BEAD ELEVATION: 1.5 m
	HOLE DEPTH: 6.9 m
	VT03 STICKUP: 76 cm

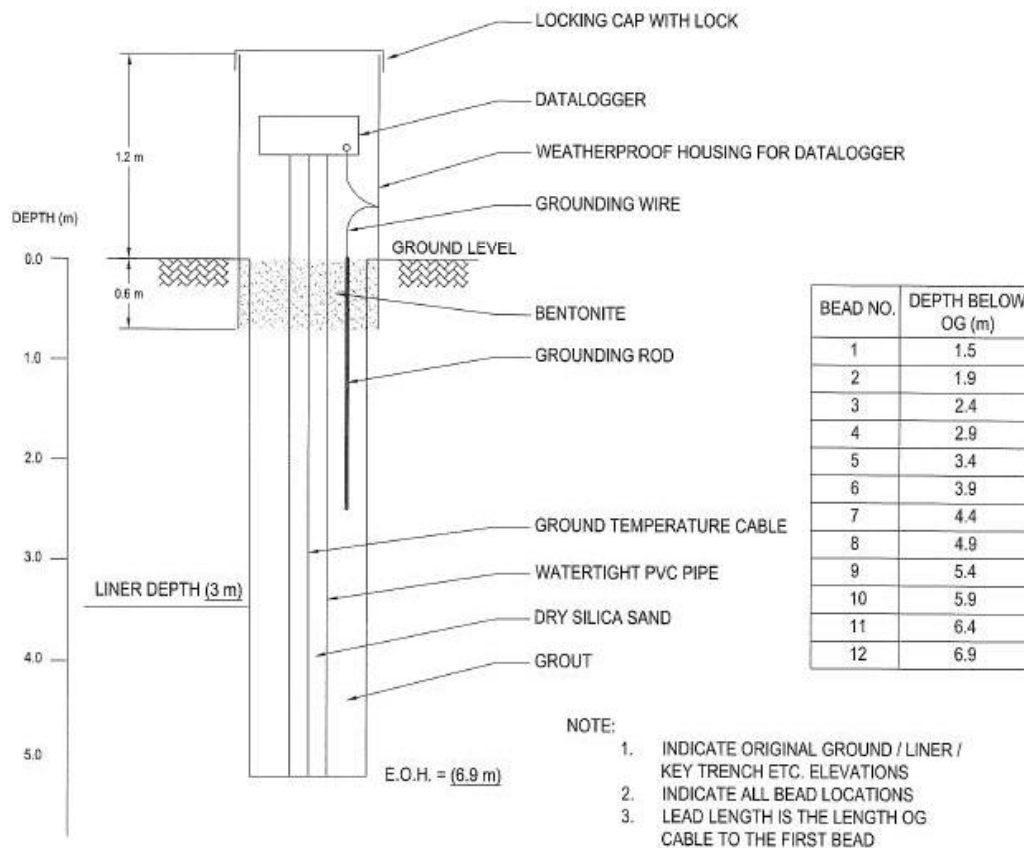



CAM-F DEW LINE CLEAN UP PROJECT
GROUND TEMPERATURE CABLE INSTALLATION REPORT

SITE: SSDF NE & NW CORNERS
LOCATION NORTHING: -
GROUND ELEVATION: -
CABLE LENGTH: 8.4 m
CABLE LENGTH ABOVE GROUND: 1.5 m
NUMBER OF BEADS: 12

CABLE INSTALLATION NO.: 2
CABLE SERIAL NO.: CAMF VTO4
EASTING: -
DATE: SEPT. 2007
LEAD LENGTH: 3.0 m
FIRST BEAD ELEVATION: 1.5 m BOG
HOLE DEPTH: 6.9 m
VT04 STICKUP: 73 cm

