


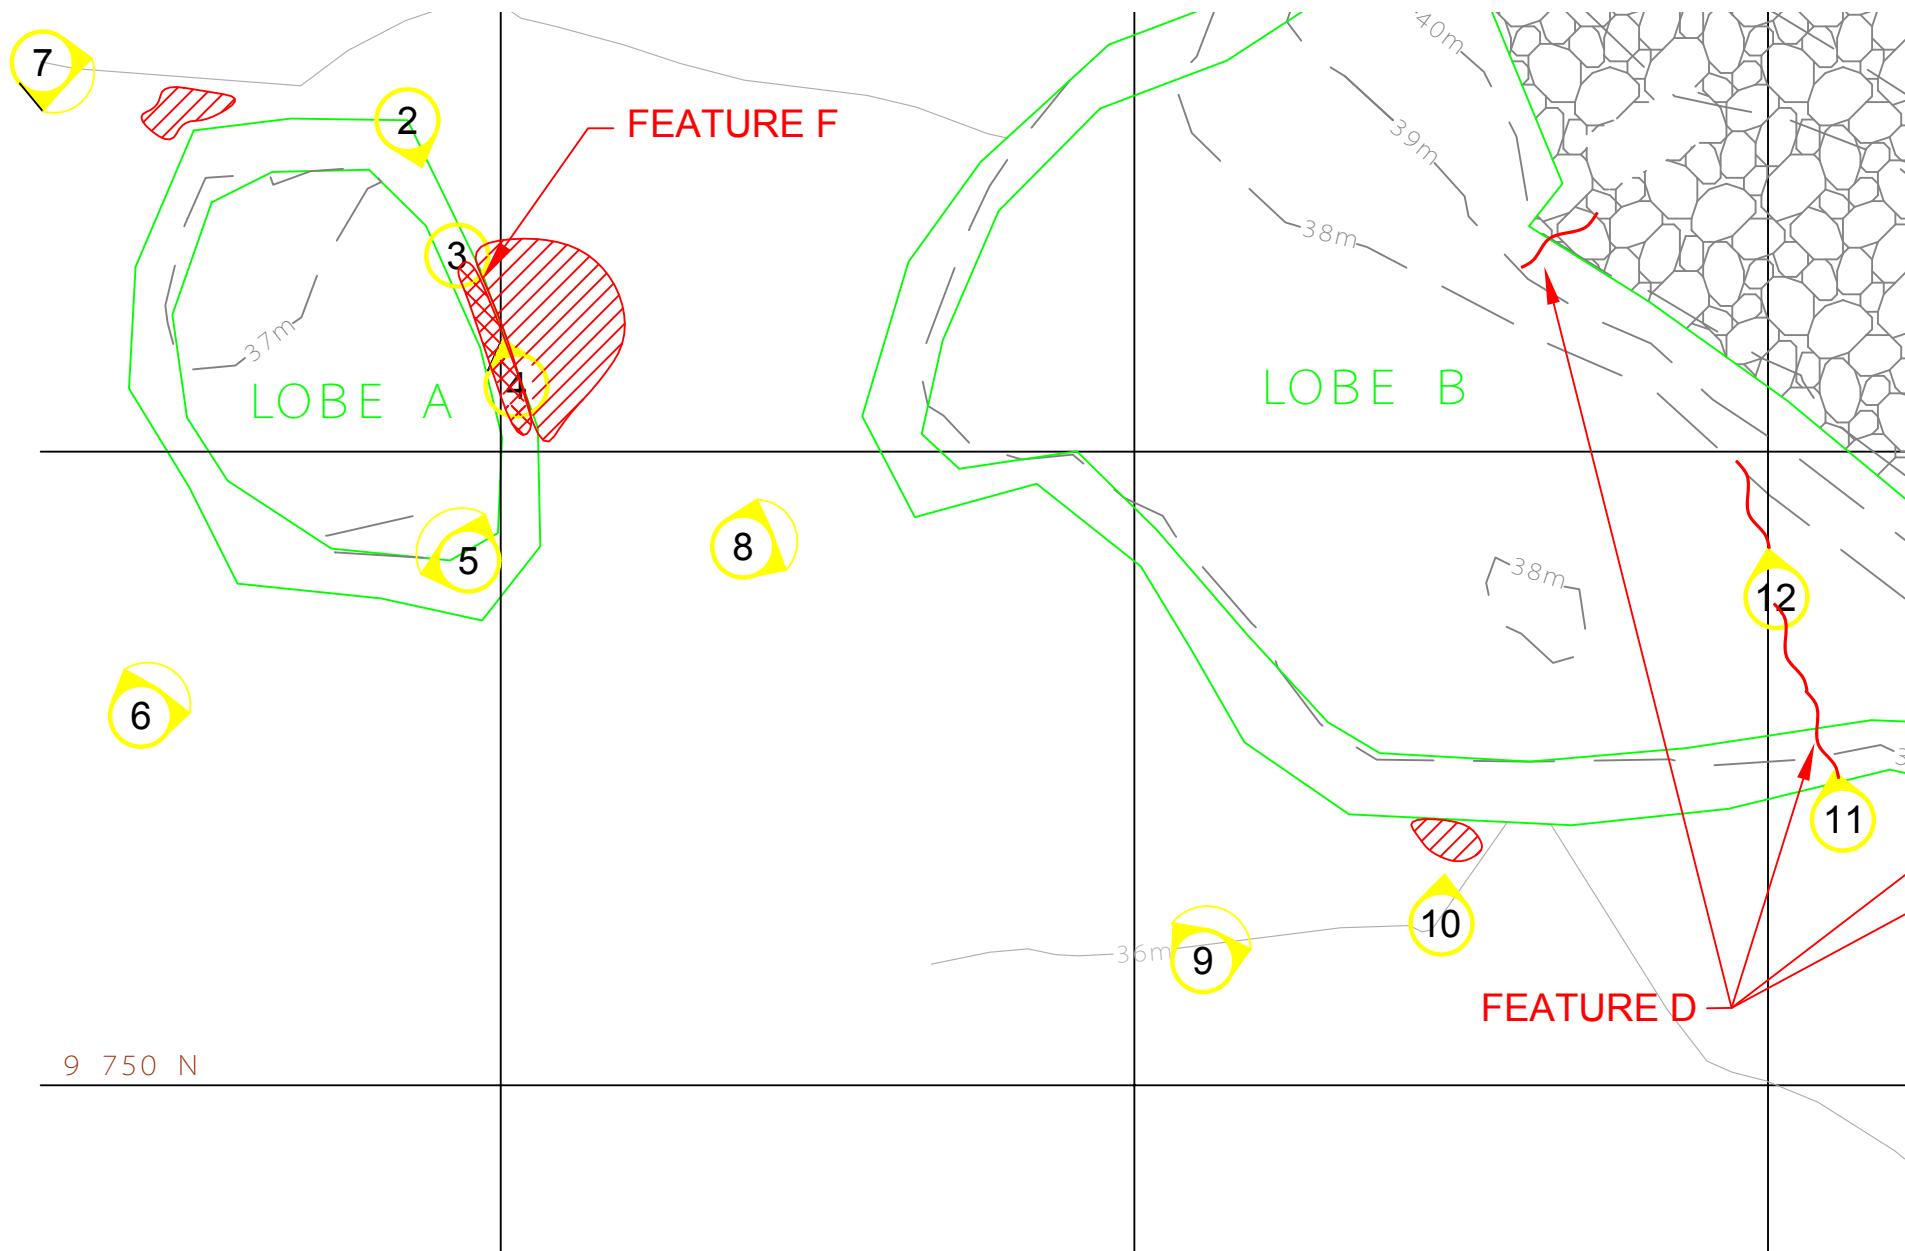


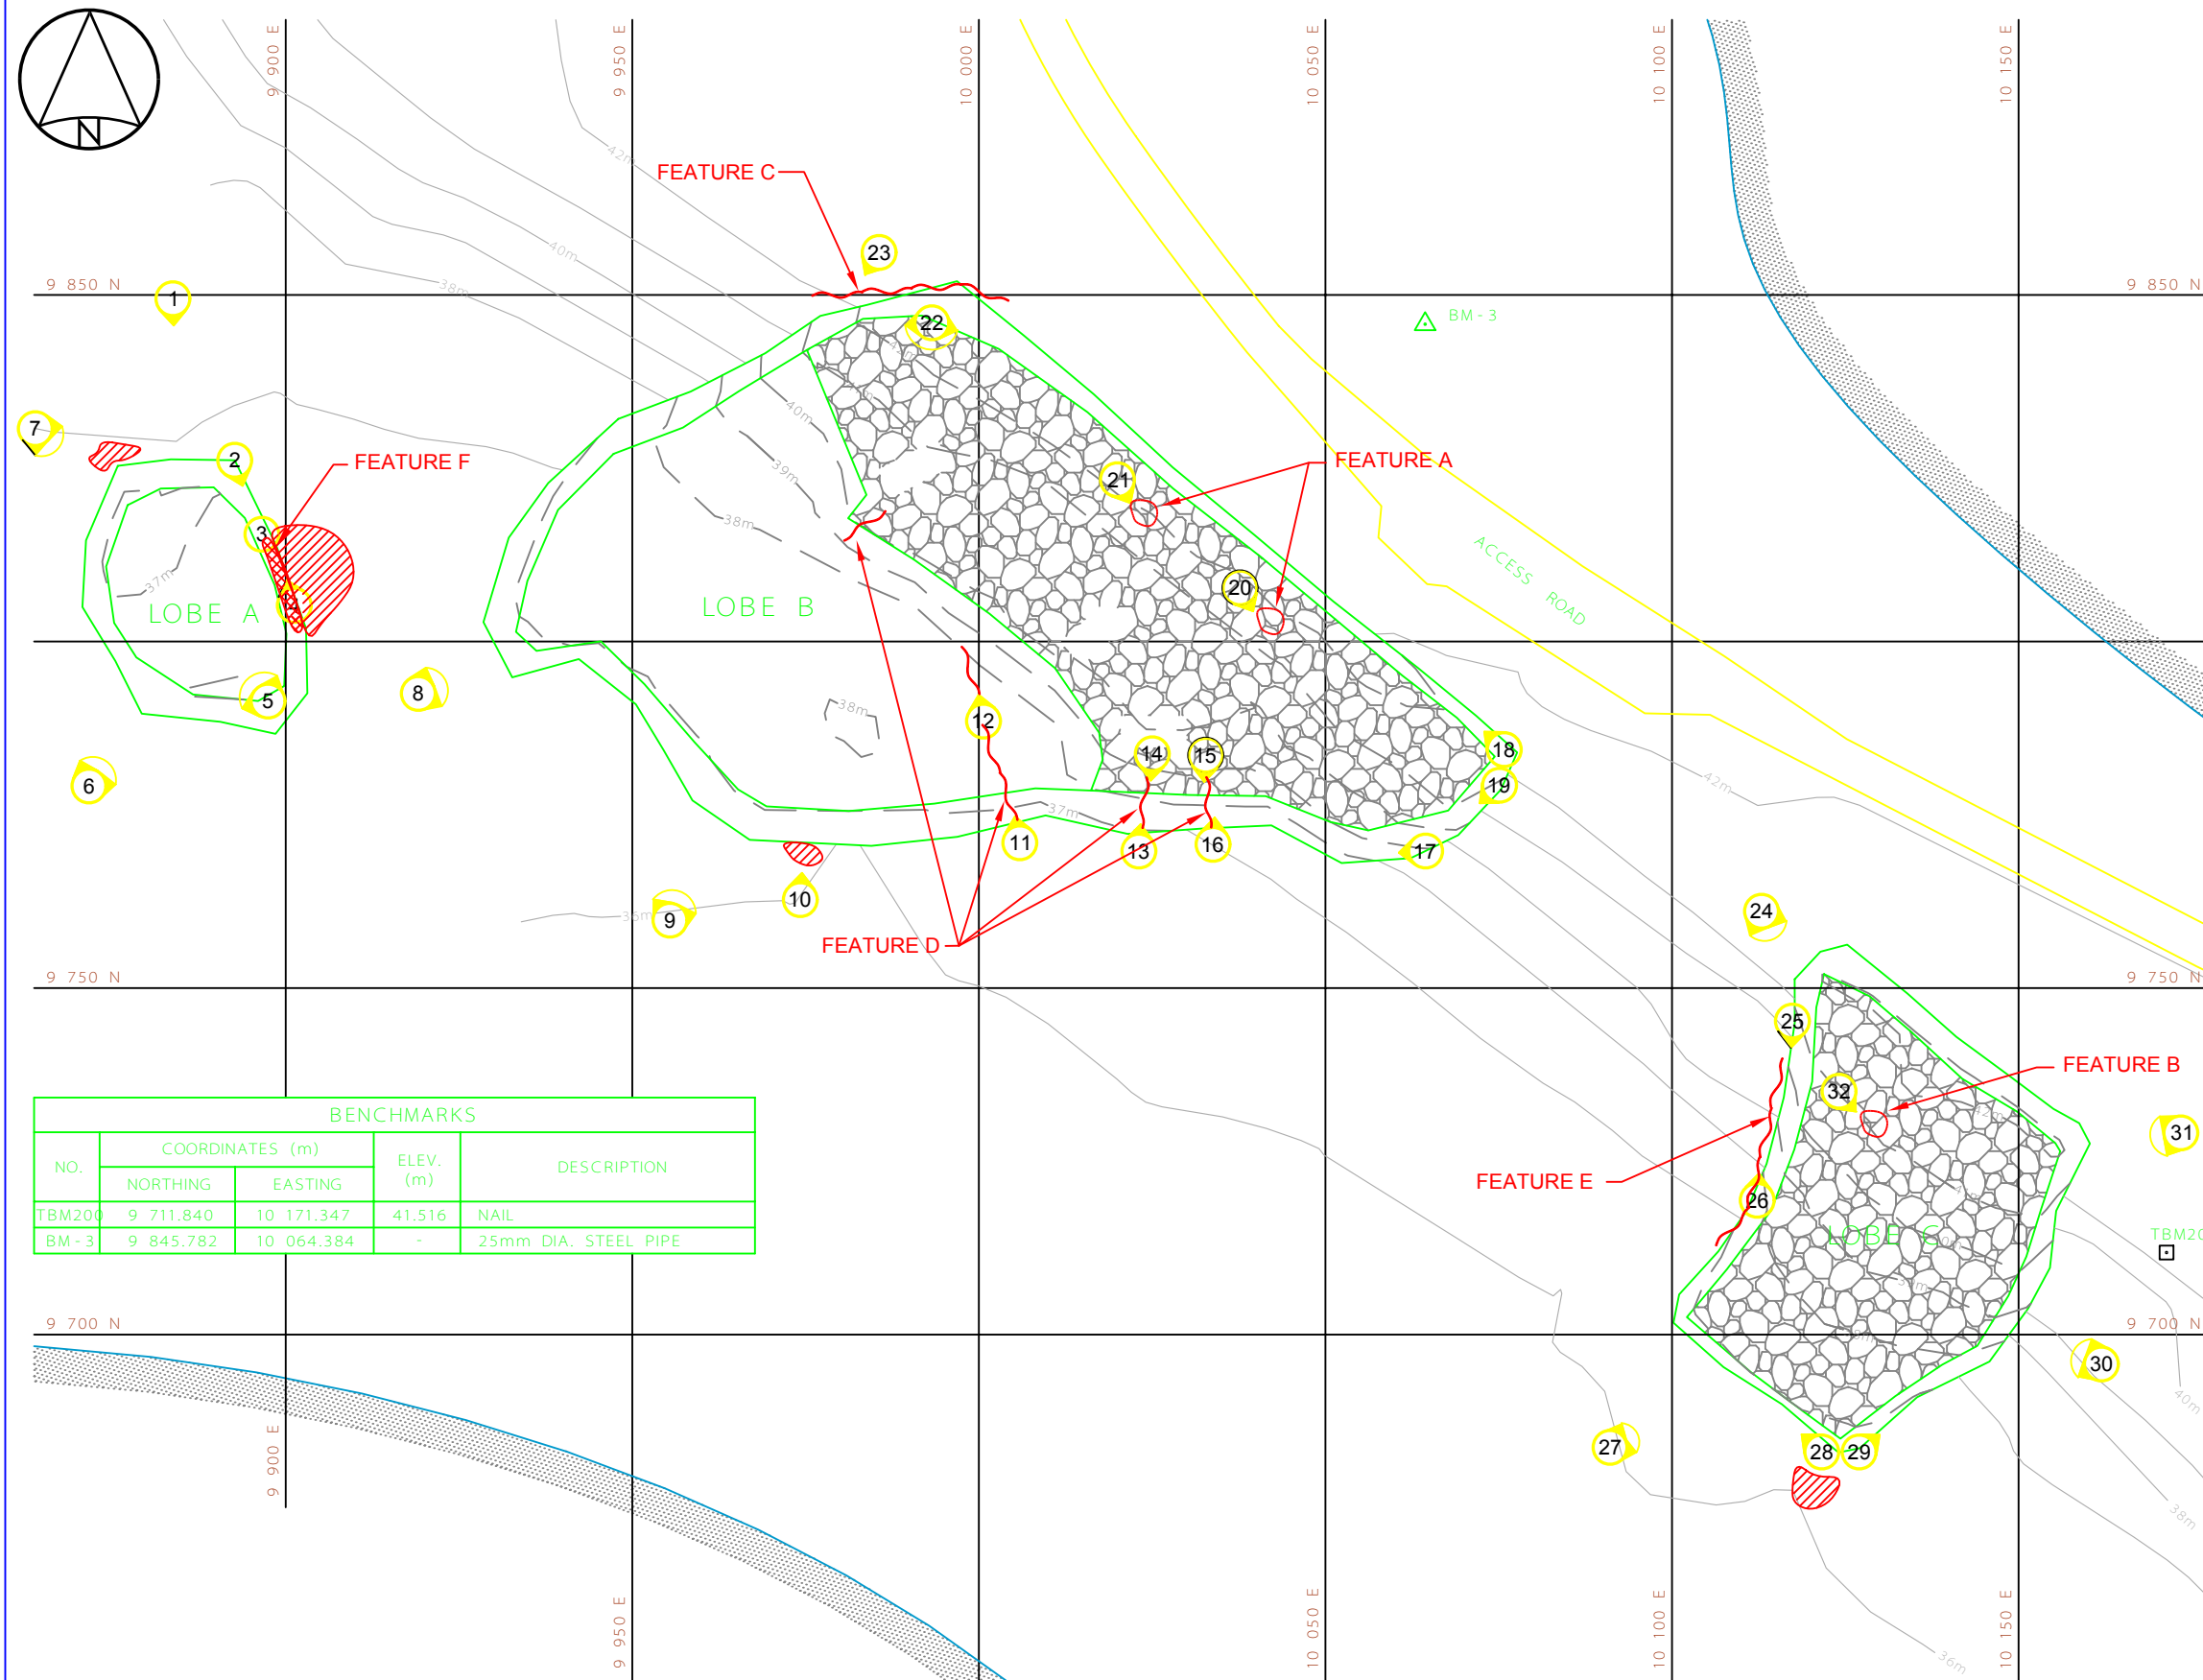

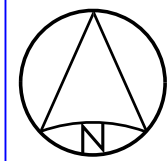

LEGEND

- PICTURE NUMBER VIEWPOINT
- SURVEY CONTROL MONUMENT
- TEMPORARY BENCHMARK
- EROSION
- SETTLEMENT
- PONDING
- STAINING

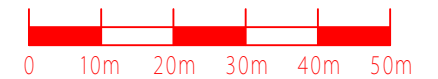

A	FINAL VERSION	10-02-26	P.L.	A.P.	J.P.P.
NO.	VERSION	DATE	BY	VERIF.	APPR.

FINAL REPORT COLLECTION OF LANDFILL MONITORING DATA CAM-3, SHEPHERD BAY, NUNAVUT

STATION LANDFILL

SITE REMEDIATION SOLUTIONS

Biogenie, a division of EnGlobe Corp.
4495 Wilfrid-Hamel Blvd., Suite 200
Quebec (Quebec) CANADA G1P 2J7
Phone: (418) 653-4422 Fax: (418) 653-3583



MEASUREMENT UNIT	SCALE:	DATE (month-year):
Meter	1 : 1,000	FEBRUARY 2010
DRAWN BY:	VERIFIED BY:	APPROVED BY:
P. LÉGARÉ	A. PASSALIS	J. - P. PELLETIER
PROJECT NO:	DRAWING NO:	PAGE:
CD9229_001_160	CD9229_001_160-CAM-3_4	PL

FIGURE CAM-3.4