




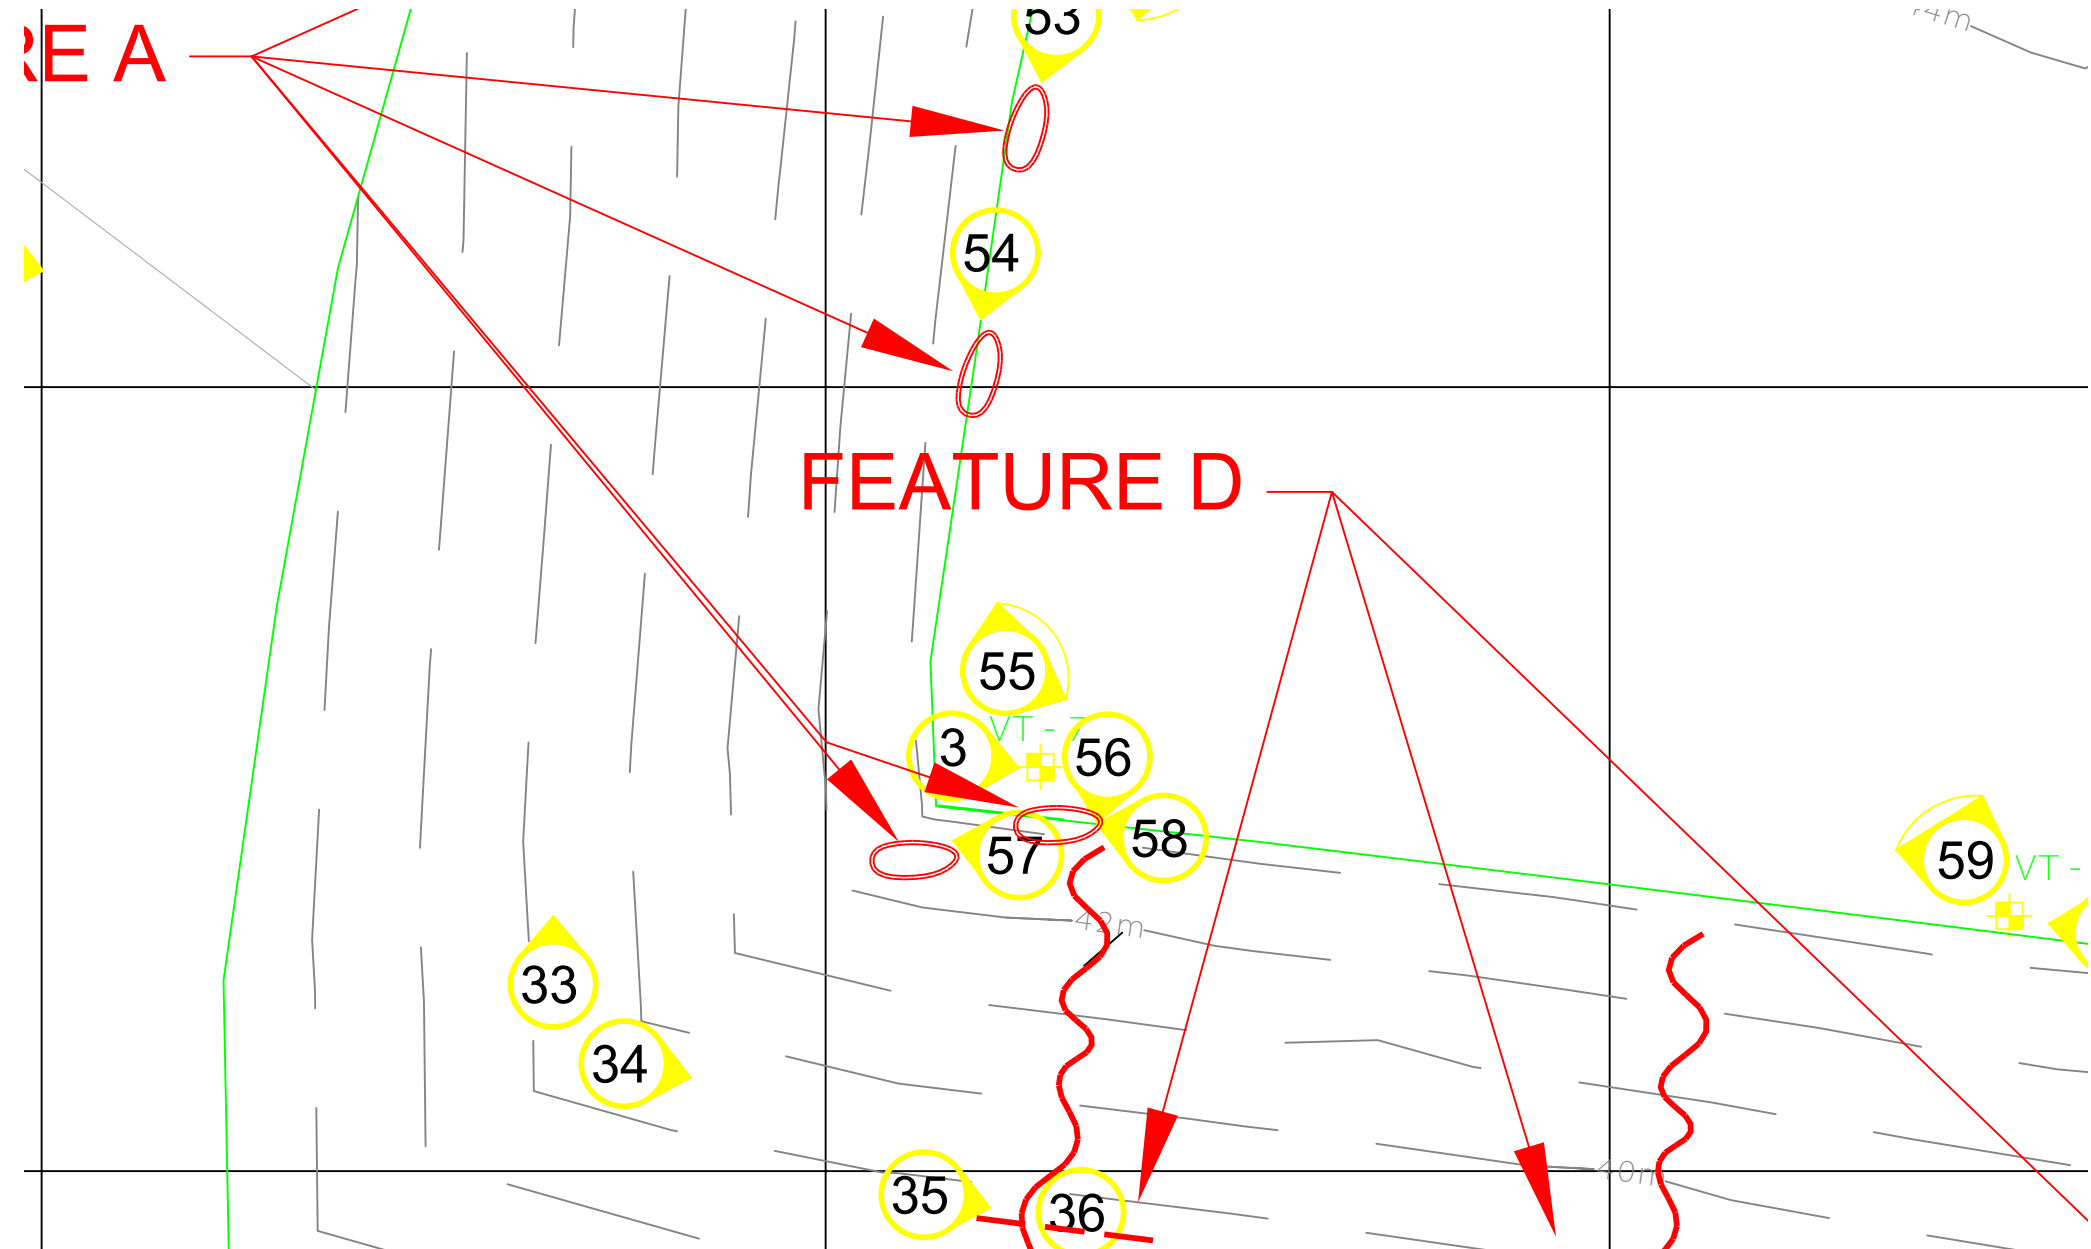

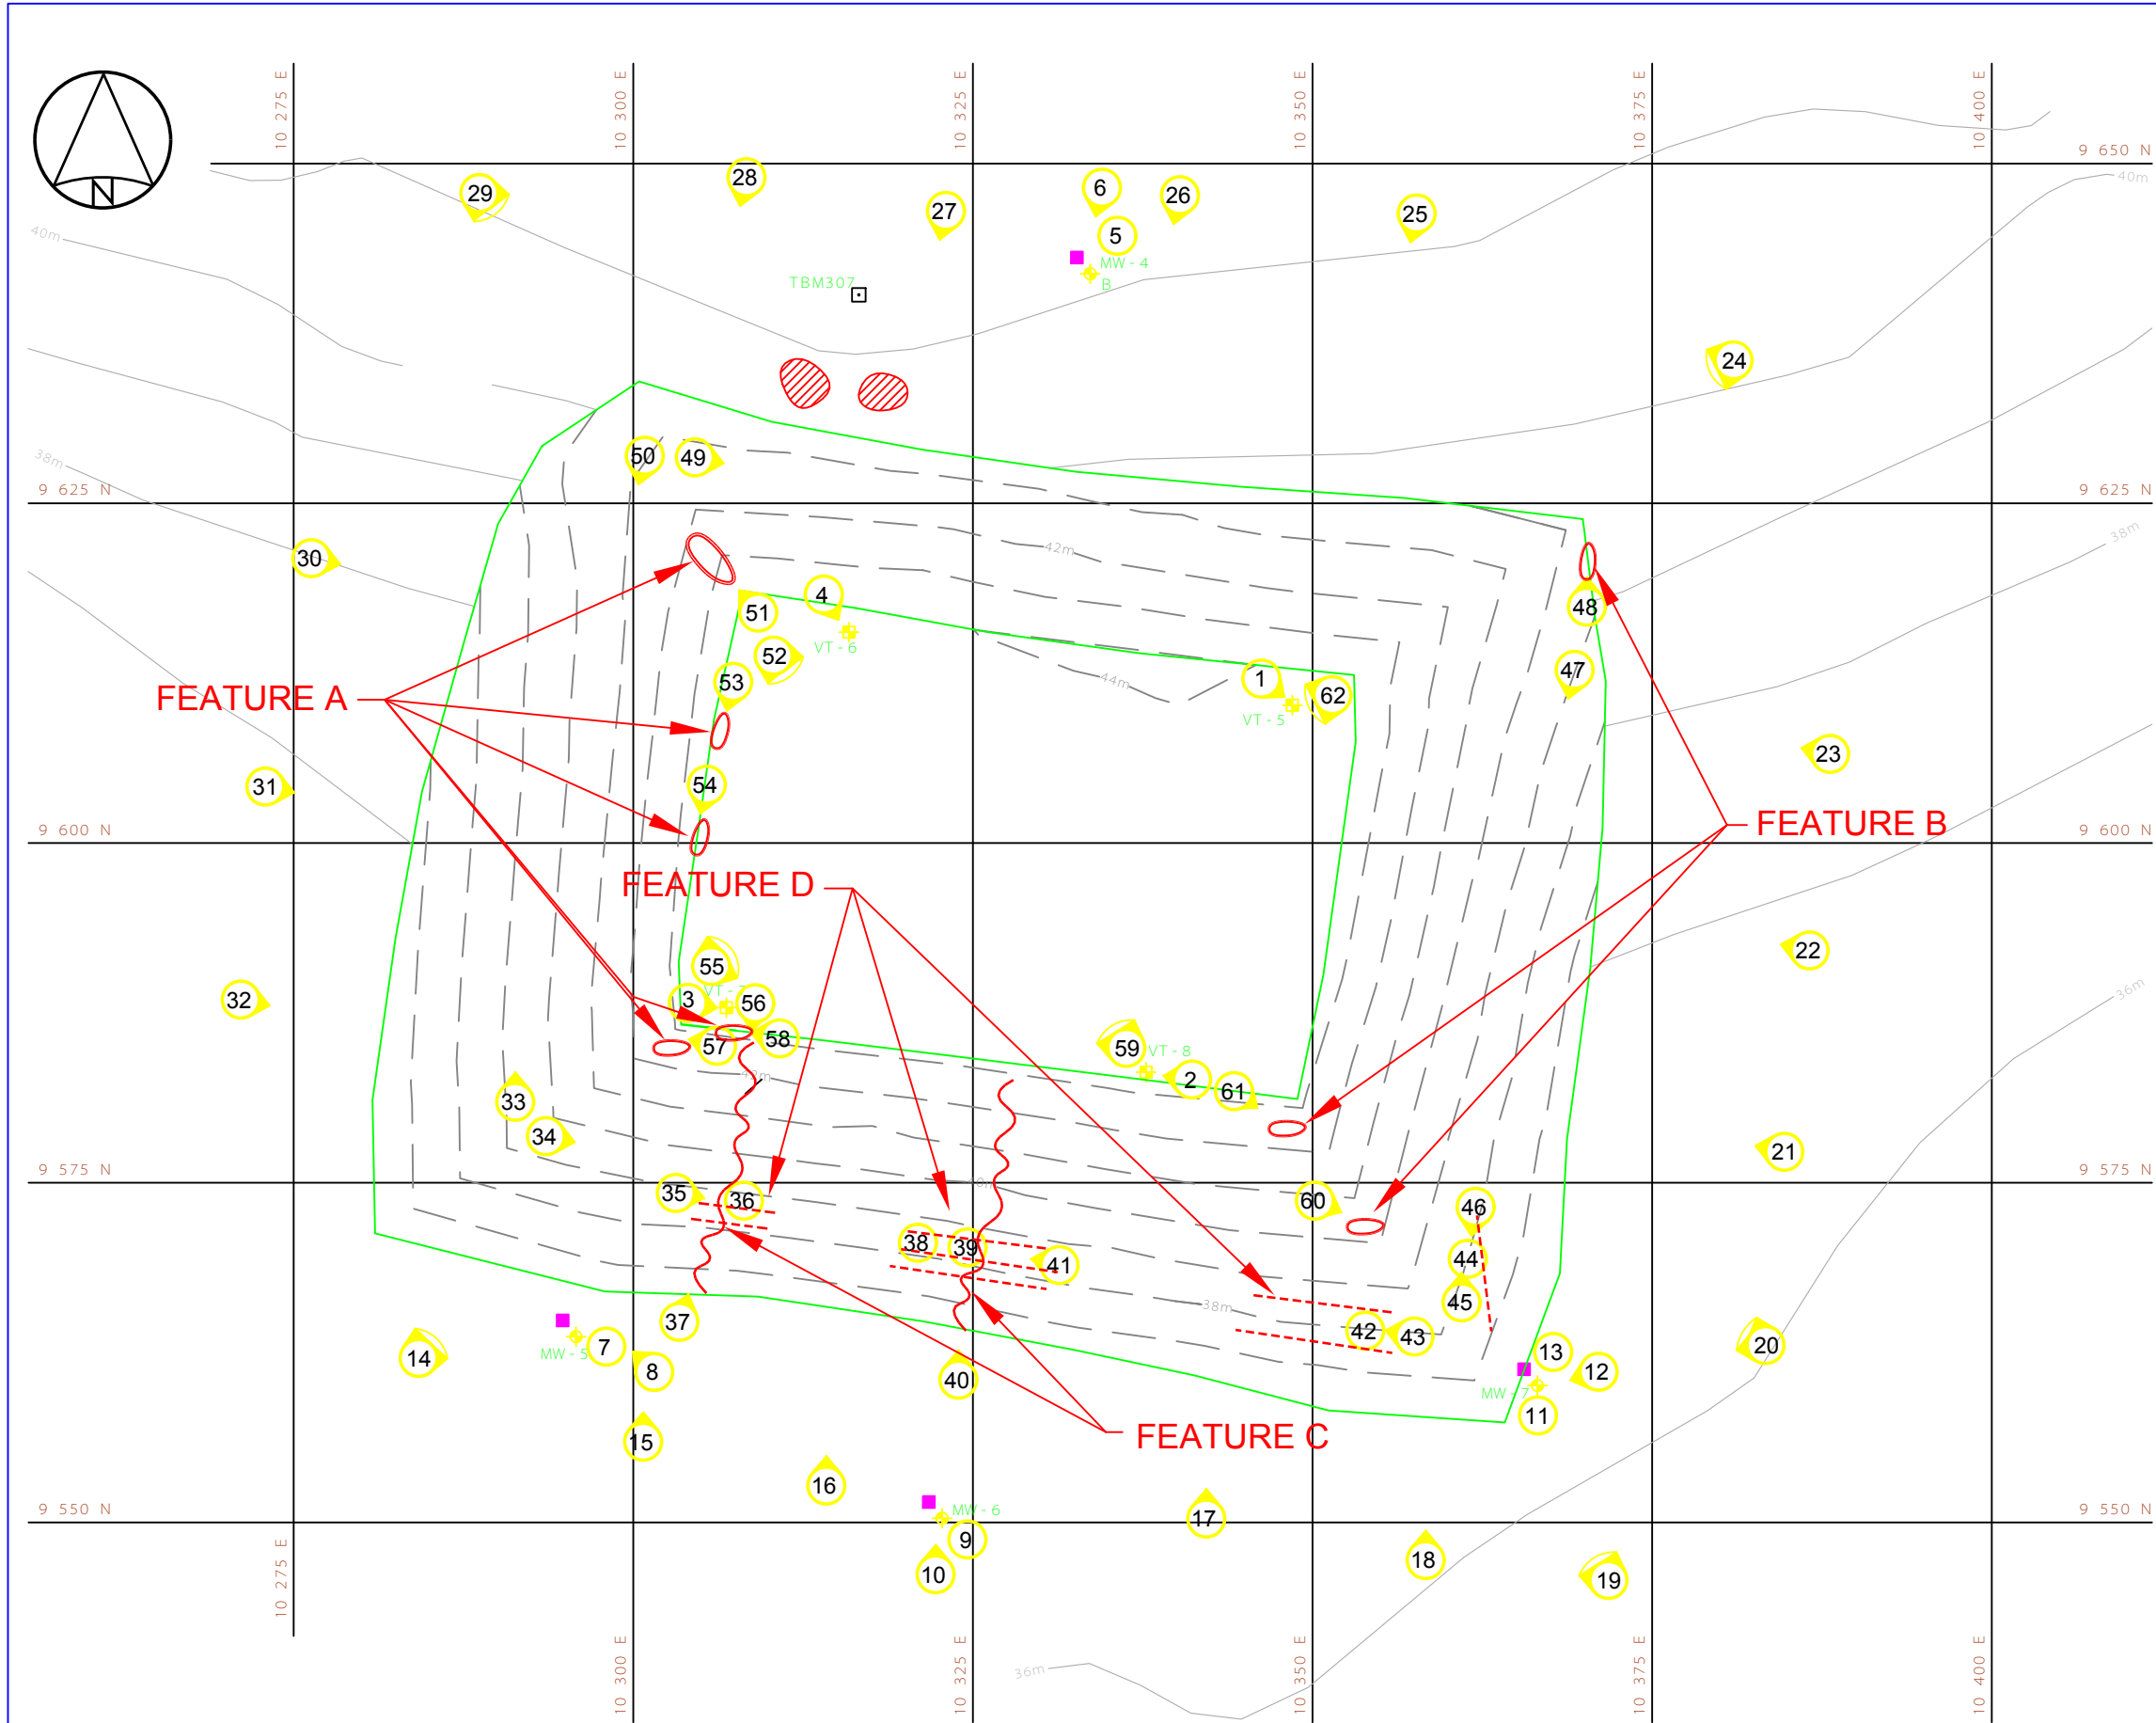

LEGEND

- 1 PICTURE NUMBER VIEWPOINT
- TBM20 TEMPORARY BENCHMARK
- Monitoring Well Location
- VT- VERTICAL THERMISTOR
- Monitoring Soil Sample Location
- Settlement (NTS)
- Erosion (NTS)
- Cracks (NTS)
- Ponding

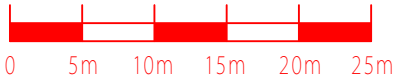

A	FINAL VERSION	10-02-26	P.L.	A.P.	J.P.P.
NO.	VERSION	DATE	BY	VERIF.	APPR.

FINAL REPORT
COLLECTION OF LANDFILL MONITORING DATA
CAM-3, SHEPHERD BAY, NUNAVUT
TIER II DISPOSAL FACILITY

SITE REMEDIATION SOLUTIONS
Biogenie, a division of EnGlobe Corp.
4495 Wilfrid-Hamel Blvd., Suite 200
Quebec (Quebec) CANADA G1P 2J7
Phone: (418) 653-4422 Fax: (418) 653-3583



MEASUREMENT UNIT	SCALE	DATE (month-year)
Meter	1 : 500	FEBRUARY 2010
DRAWN BY	VERIFIED BY	APPROVED BY
P. LÉGARÉ	A. PASSALIS	J. - P. PELLETIER
PROJECT NO.	DRAWING NO.	PAGE
CD9229_001_160	CD9229_001_160-CAM-3_5	PL

FIGURE CAM-3.5